
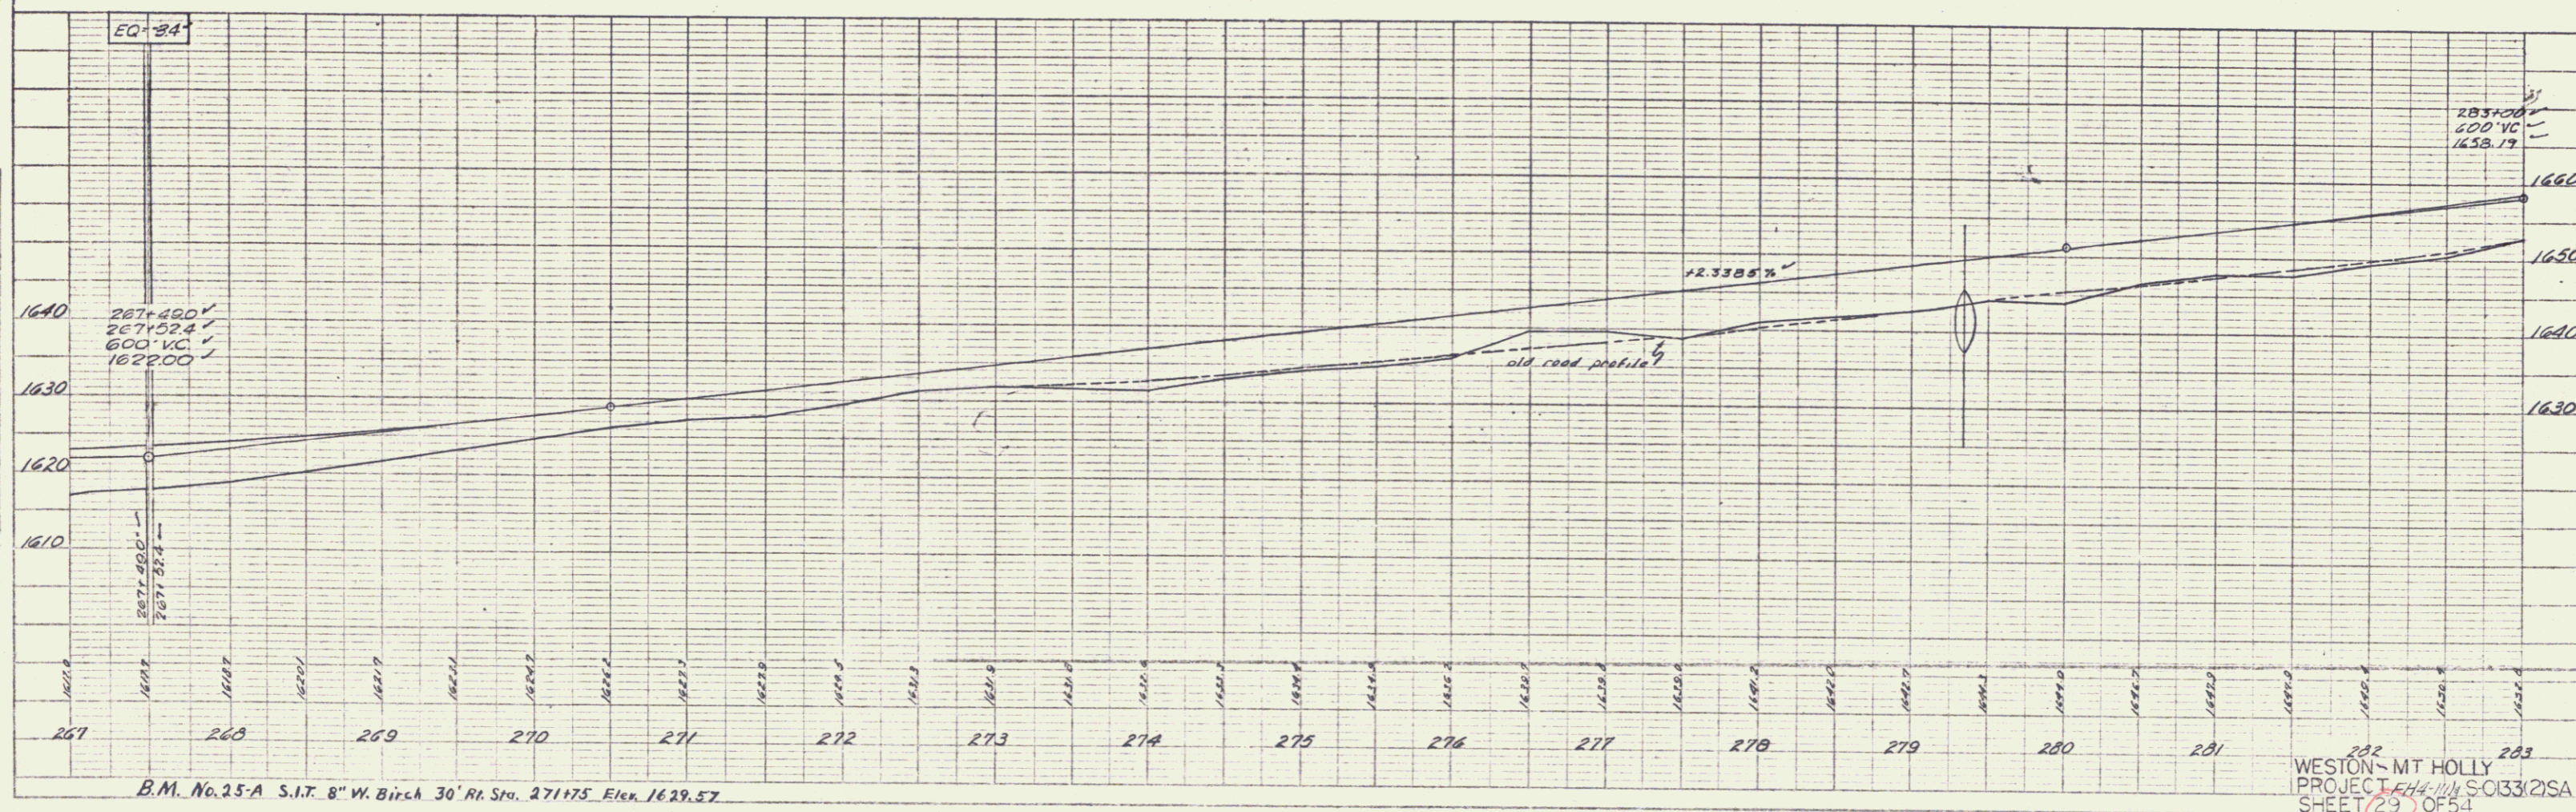


PLAN
 PROJECT: *Weston-Mt Holly*
 DRAWING NO.: *218*
 DATE: *1/18*
 SCALE: *1" = 40'*
 CHECKED BY: *Tracy*
 DESIGNED BY: *Tracy*

PROFILE
 SCALE: *1" = 10'*
 CHECKED BY: *Tracy*
 DESIGNED BY: *Tracy*

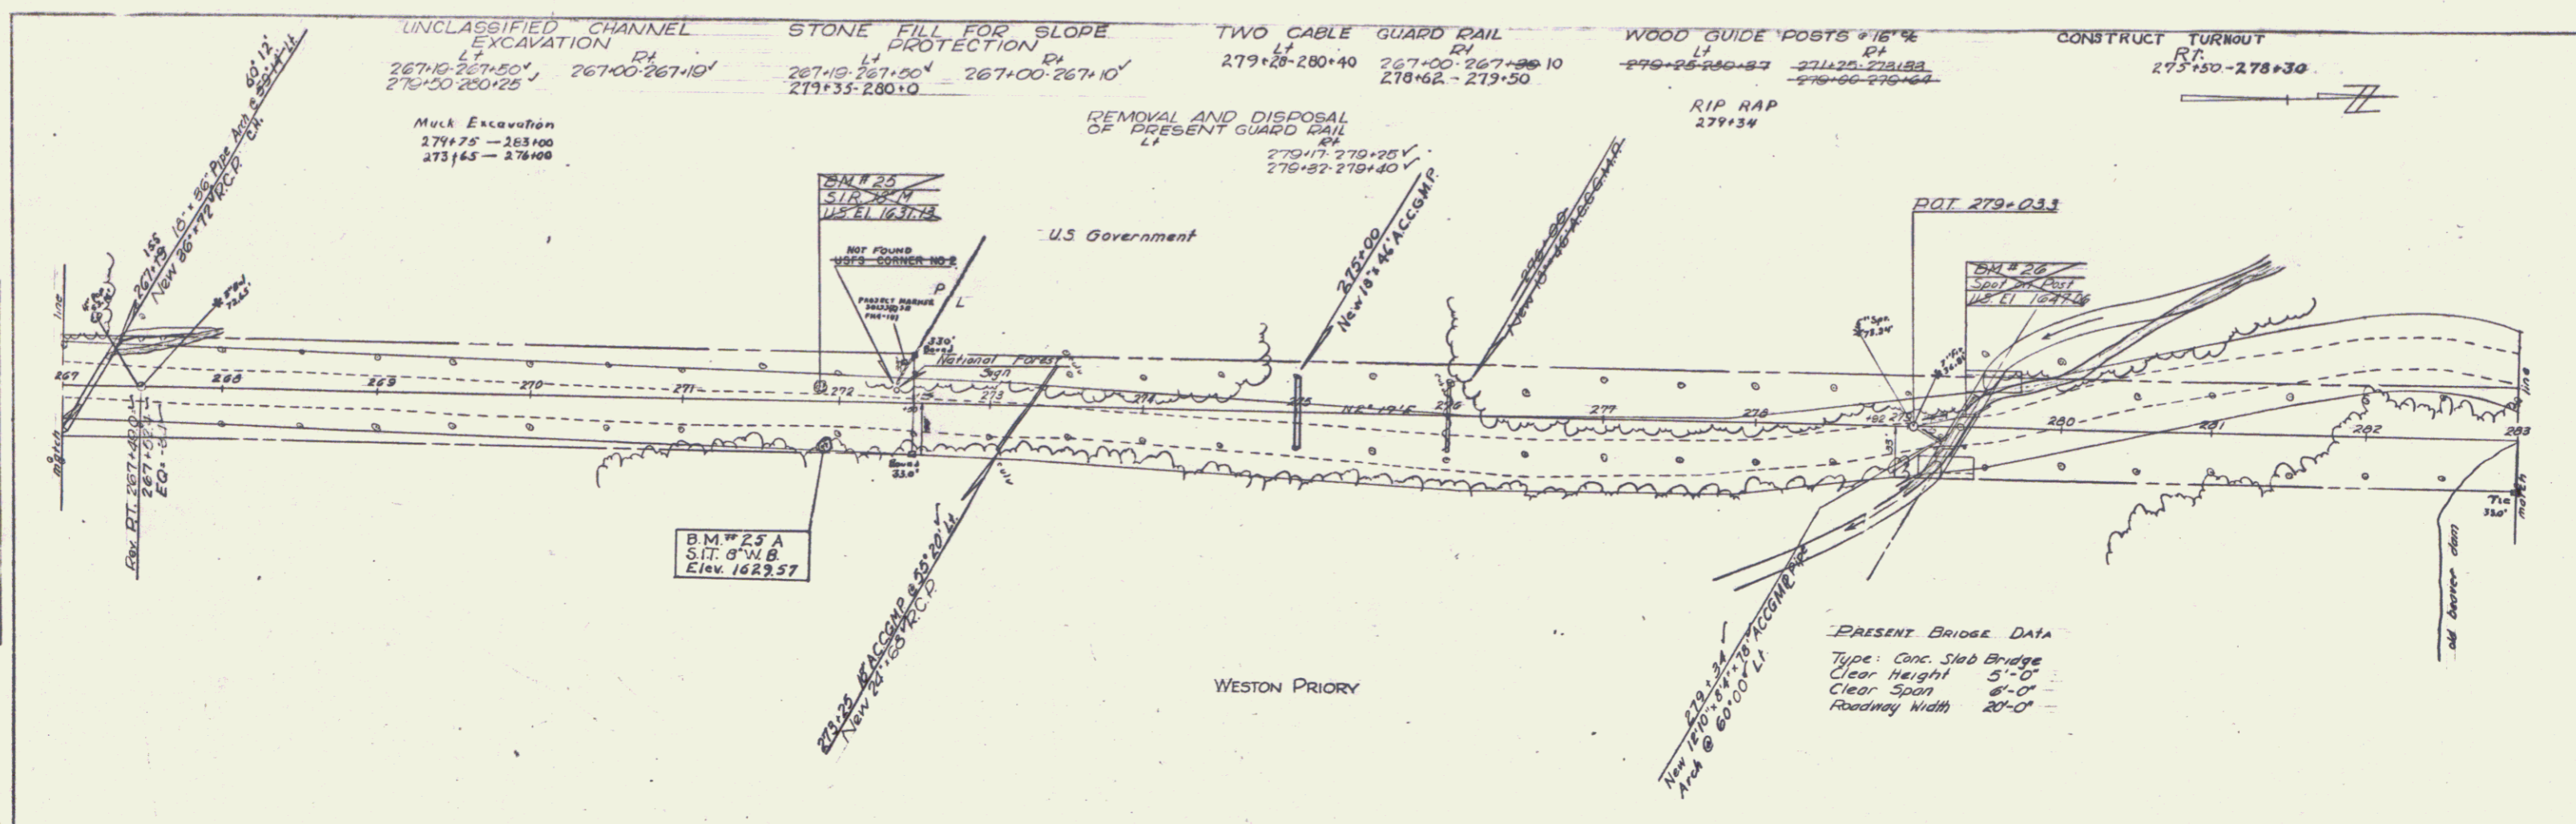

PLANS, PROFILES, AND ELEVATIONS
 SHALL BE IN ACCORDANCE WITH THE
 STANDARD SPECIFICATIONS FOR
 HIGHWAY CONSTRUCTION