



PLAN  
 DATE: 11/15/11  
 DRAWN BY: [Name]  
 CHECKED BY: [Name]  
 PROJECT: [Name]  
 SHEET: 31 OF 54

PROFILE  
 DATE: 11/15/11  
 DRAWN BY: [Name]  
 CHECKED BY: [Name]  
 PROJECT: [Name]  
 SHEET: 31 OF 54

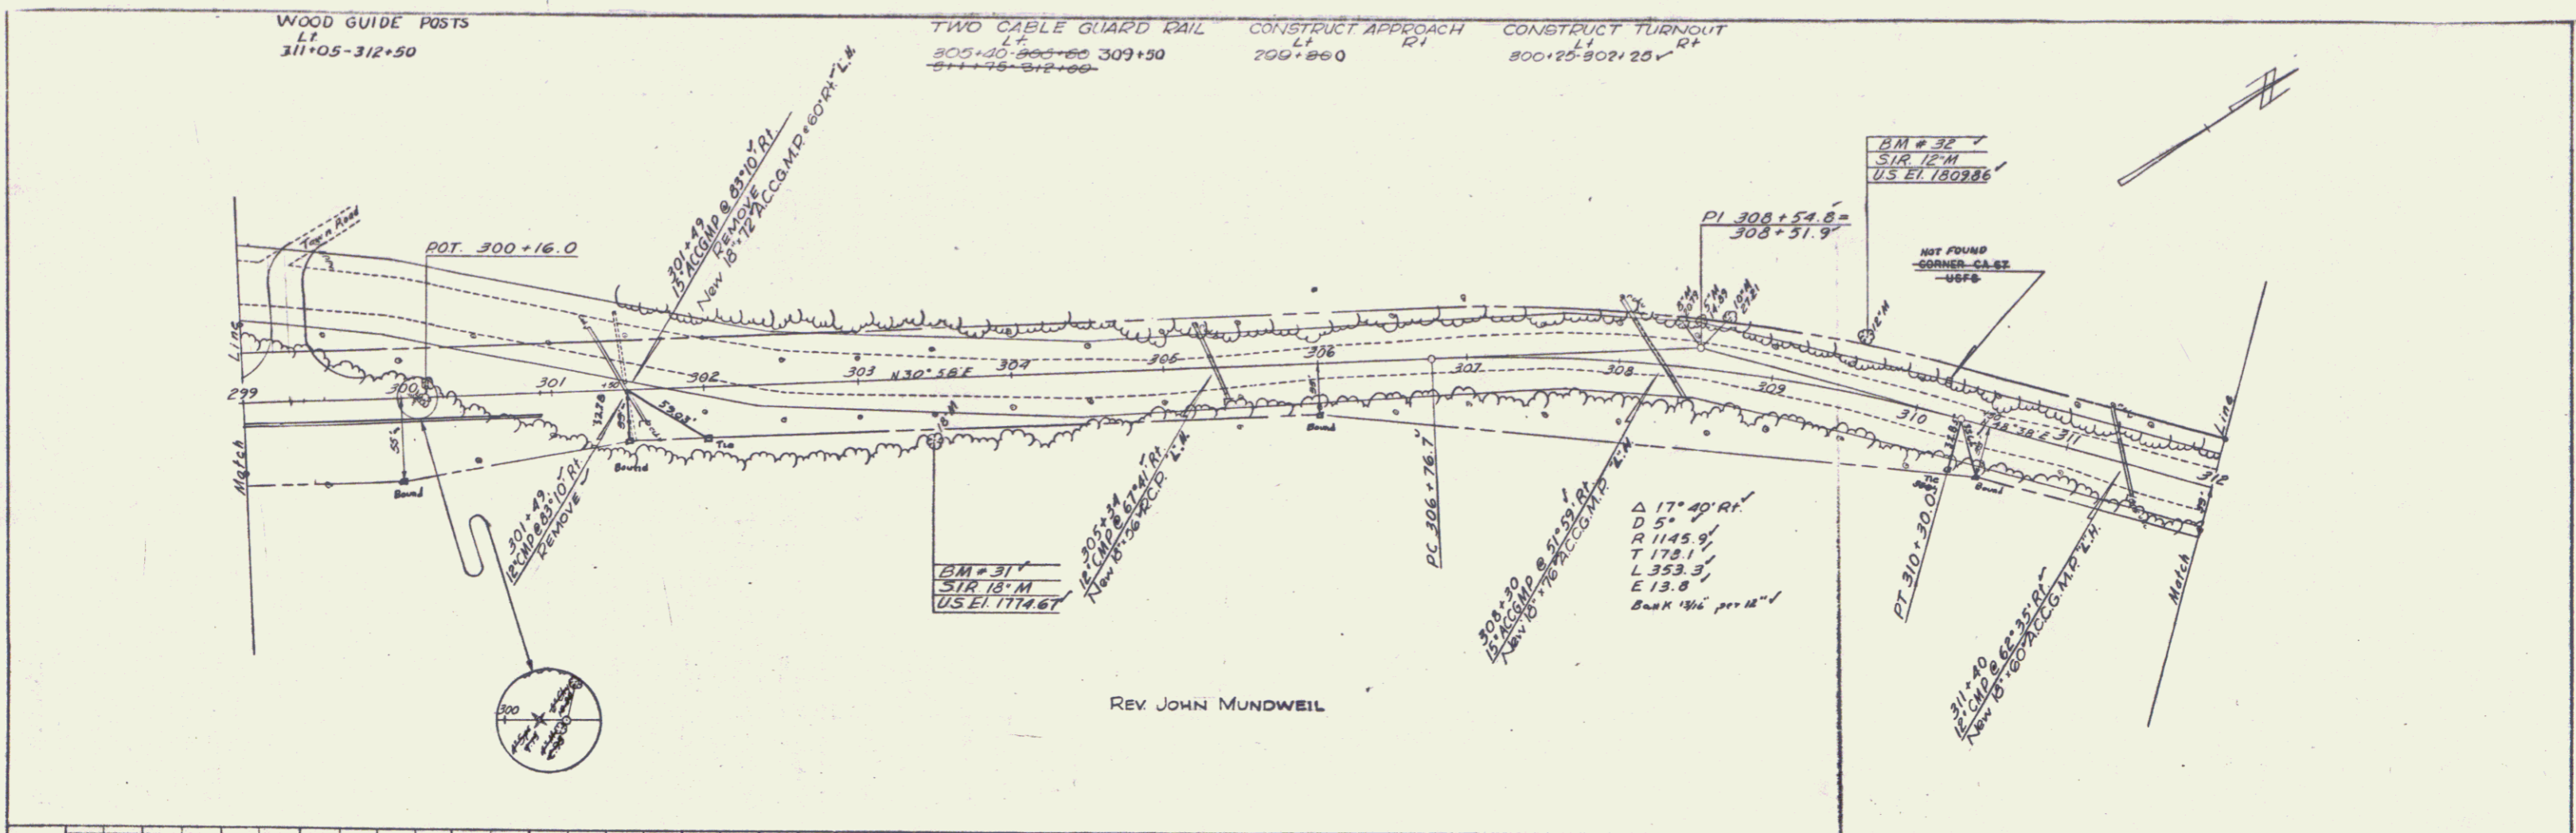

REV. JOHN MUNDWEIL

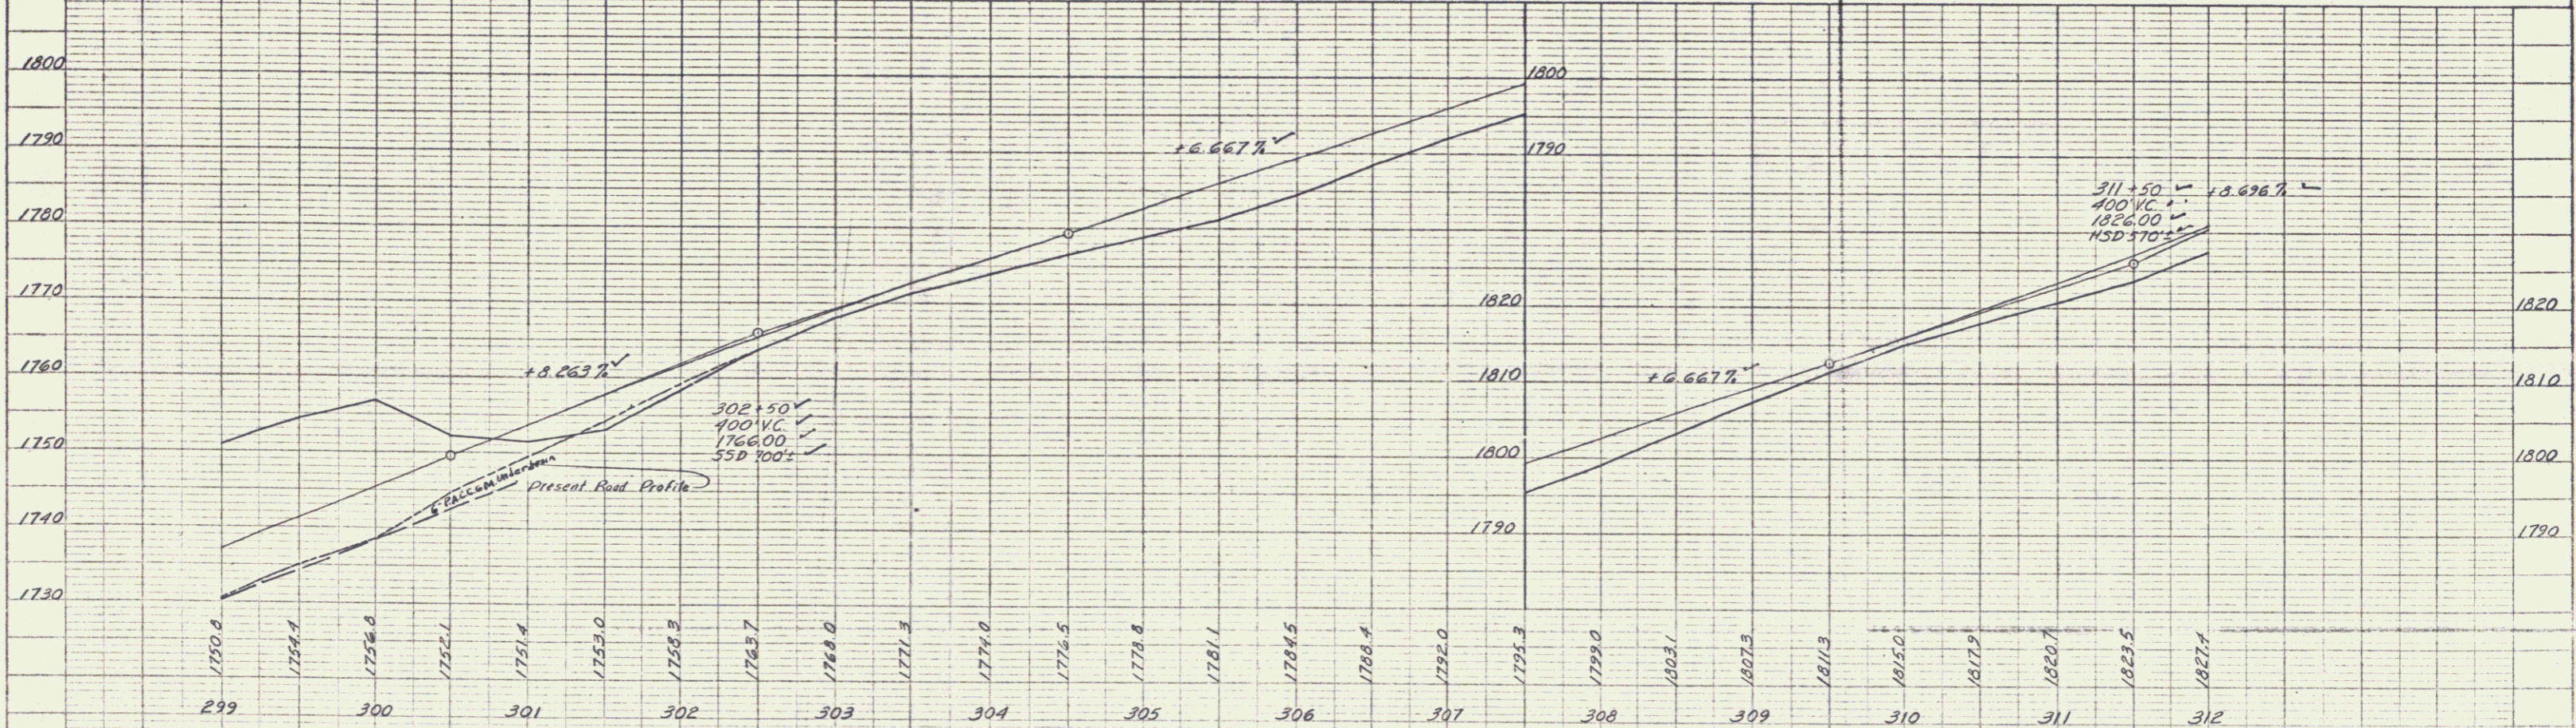

B.M. No. 31 S.I.R. 18' Maple 38' Rt. Sta. 303+50 Elev. 1774.67  
 B.M. No. 32 S.I.R. 12' Maple 36' Lt. Sta. 309+50 Elev. 1809.86

WESTON - MT HOLLY  
 PROJECT E.H. 110 S-0133(2)SA  
 SHEET 31 OF 54