



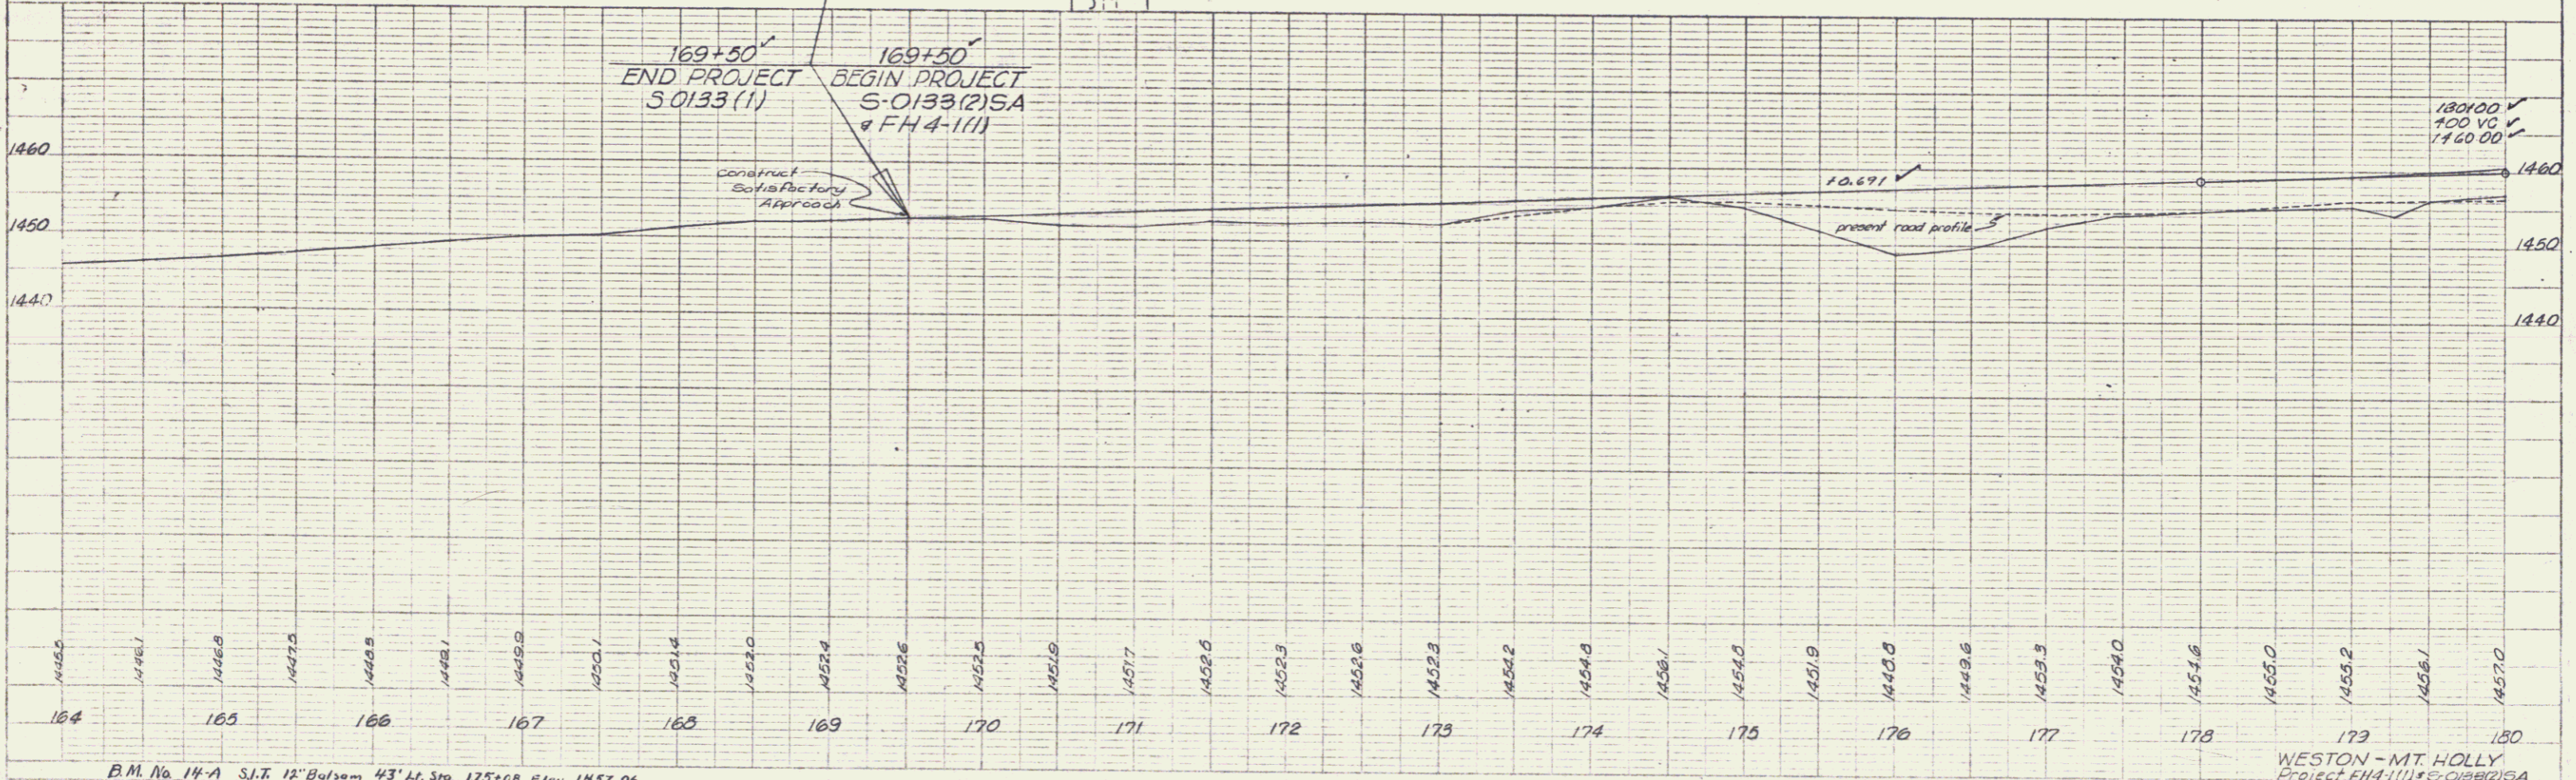

PLAN  
 DATE: 1/18/88  
 DRAWN BY: M. J. O'Connell  
 CHECKED BY: G. E. H.  
 NO. 4140

PROFILE  
 DATE: 1/18/88  
 DRAWN BY: M. J. O'Connell  
 CHECKED BY: G. E. H.  
 NO. 4140

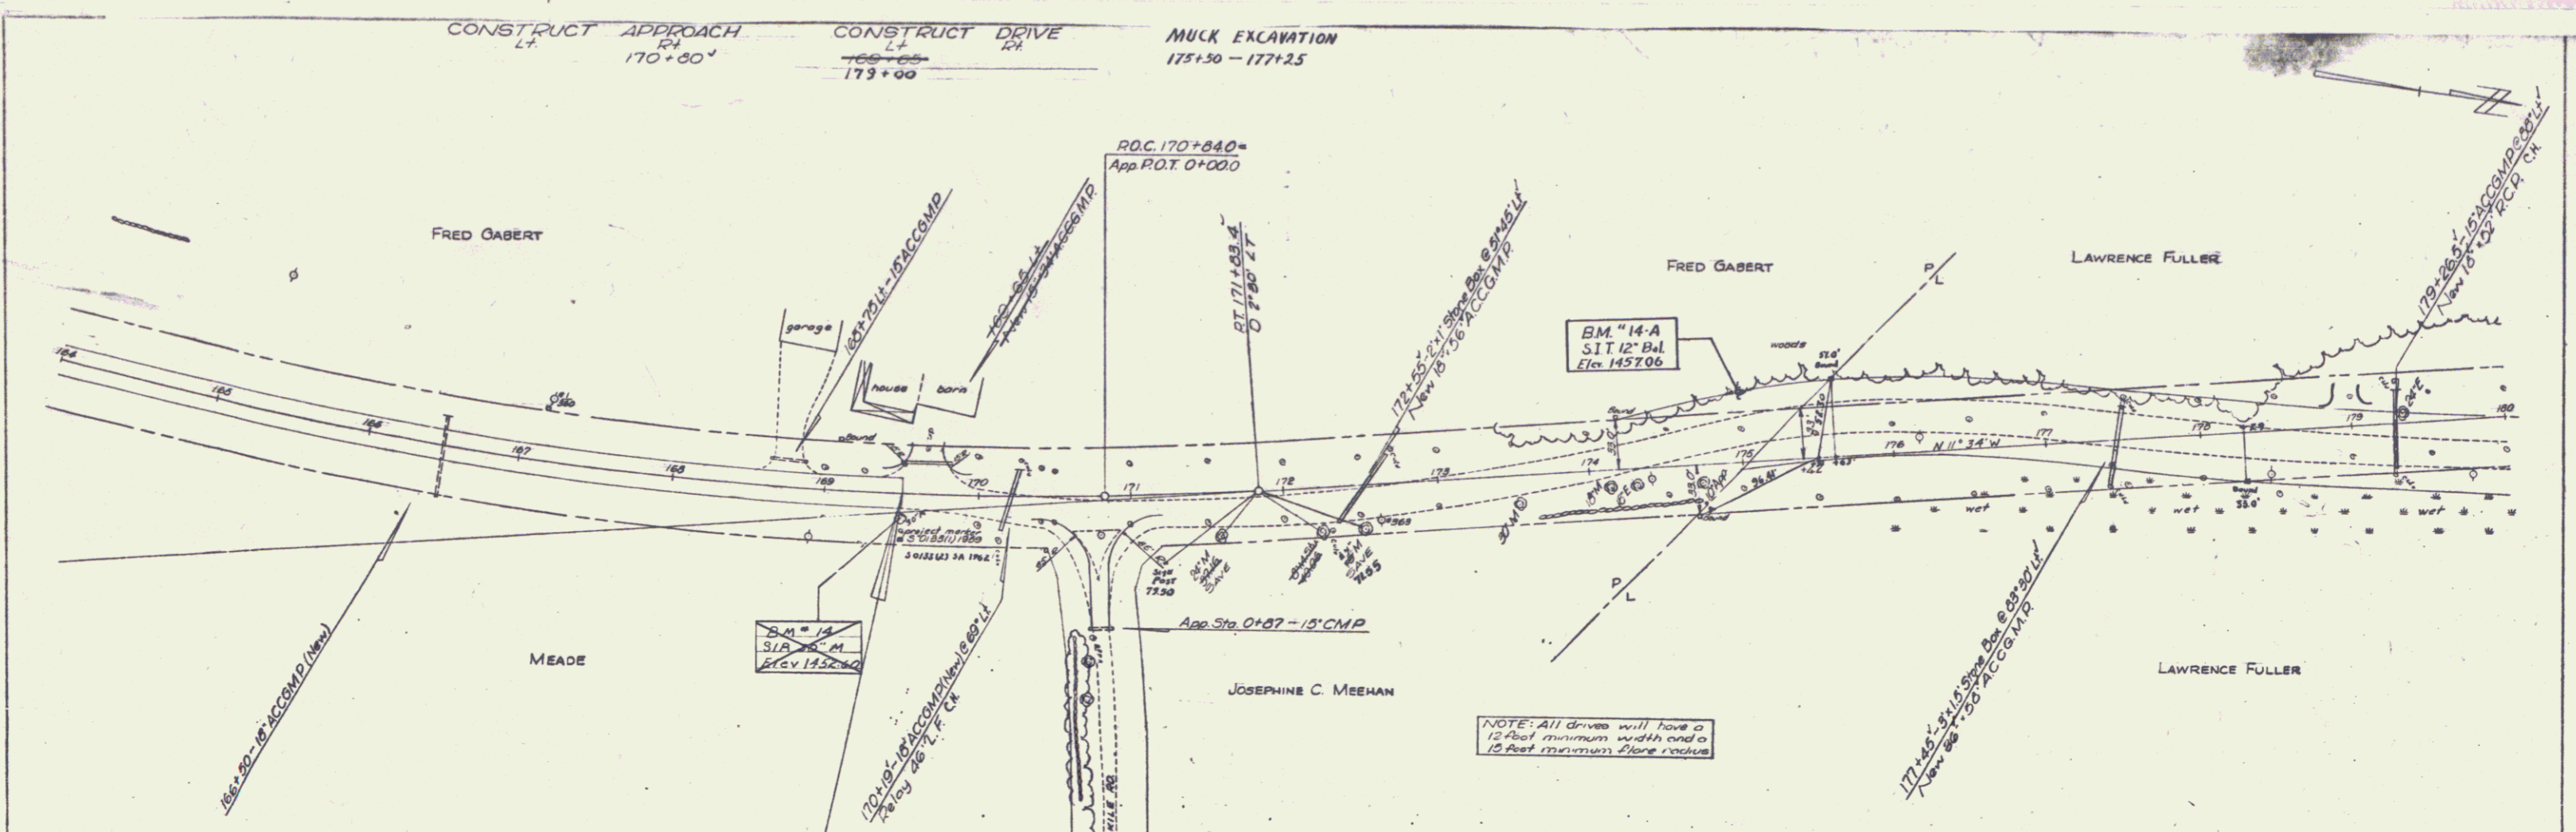



B.M. No. 14-A S.I.T. 12' Bl. 43' Lt. Sta. 175+08 Elev. 1457.06

WESTON - MT. HOLLY  
 Project FH 4-1(1) S-0133(2) SA  
 Sheet 22 of 51



PLAN  
 DATE: MAR 28  
 DRAWN BY: MARTIN A. GAYMAN  
 CHECKED BY: [Signature]  
 SCALE: AS SHOWN



PROFILE  
 DATE: MAR 28  
 DRAWN BY: MARTIN A. GAYMAN  
 CHECKED BY: [Signature]  
 SCALE: AS SHOWN

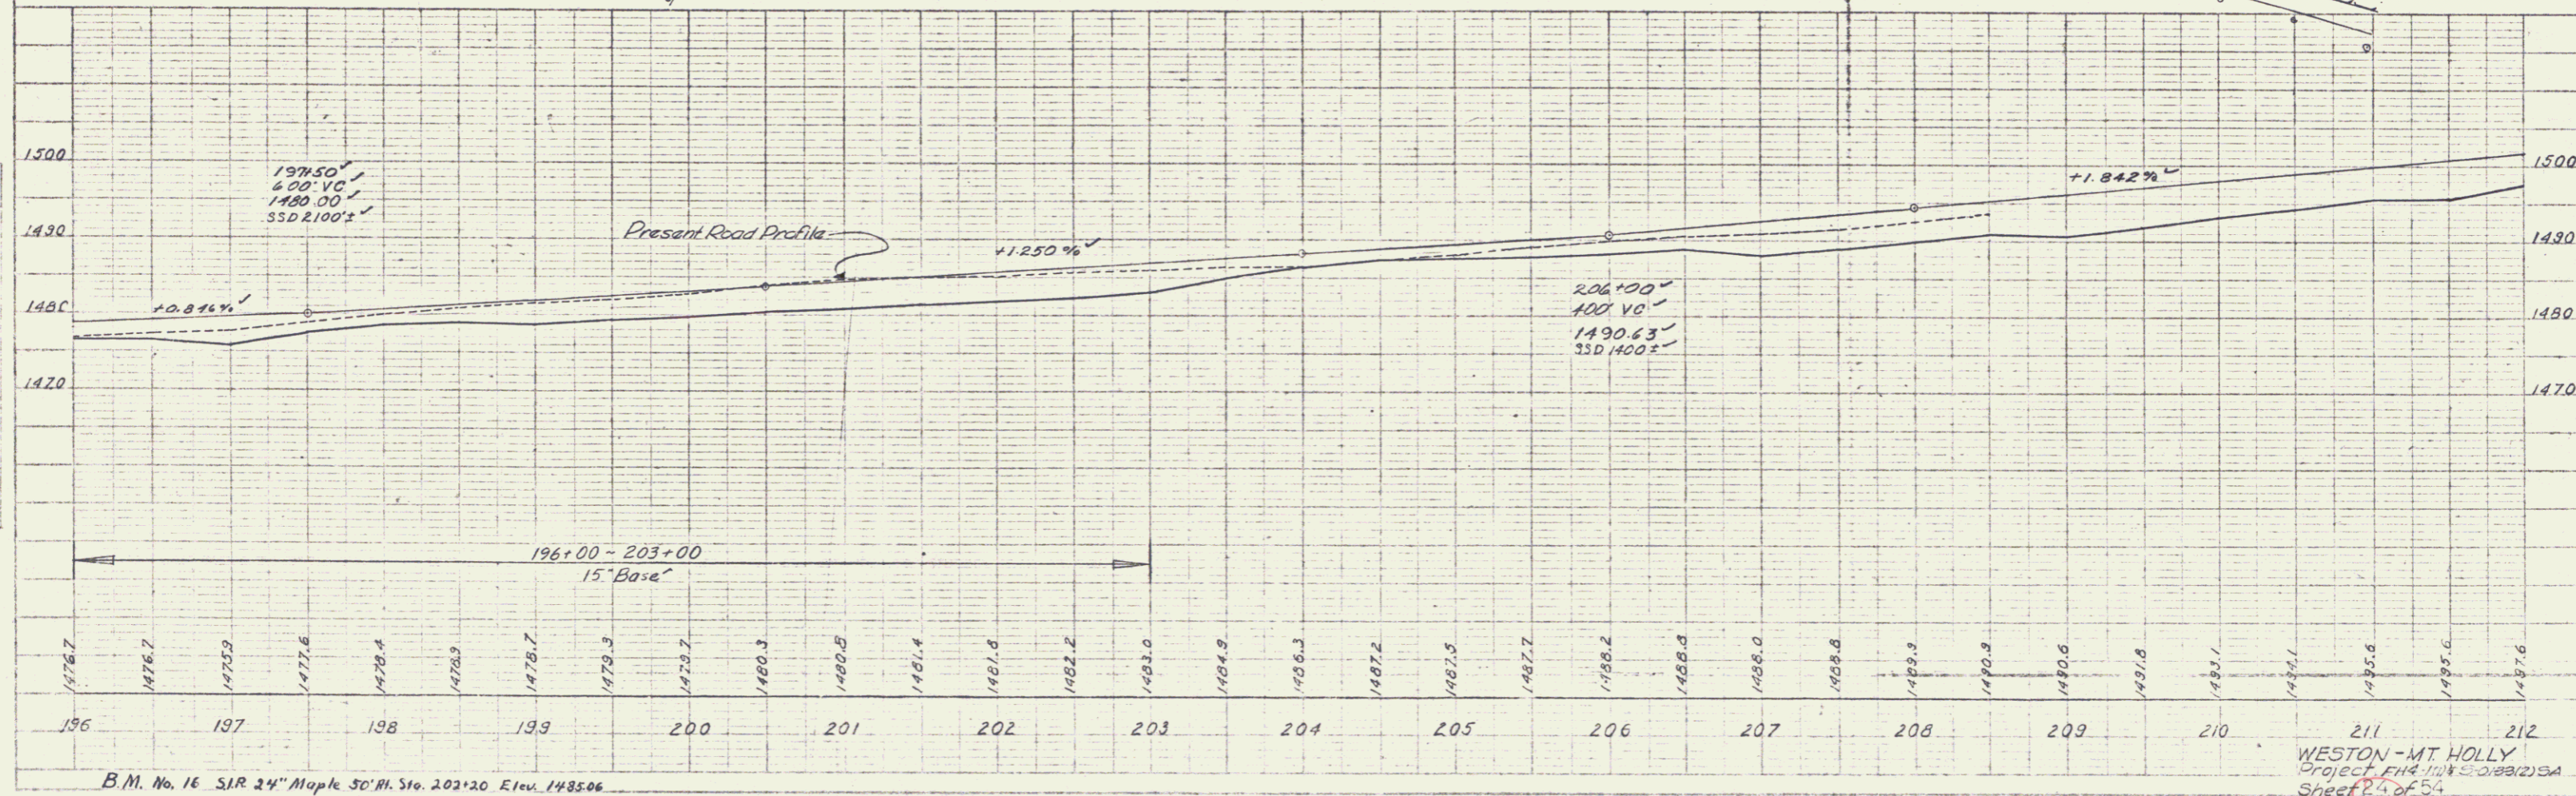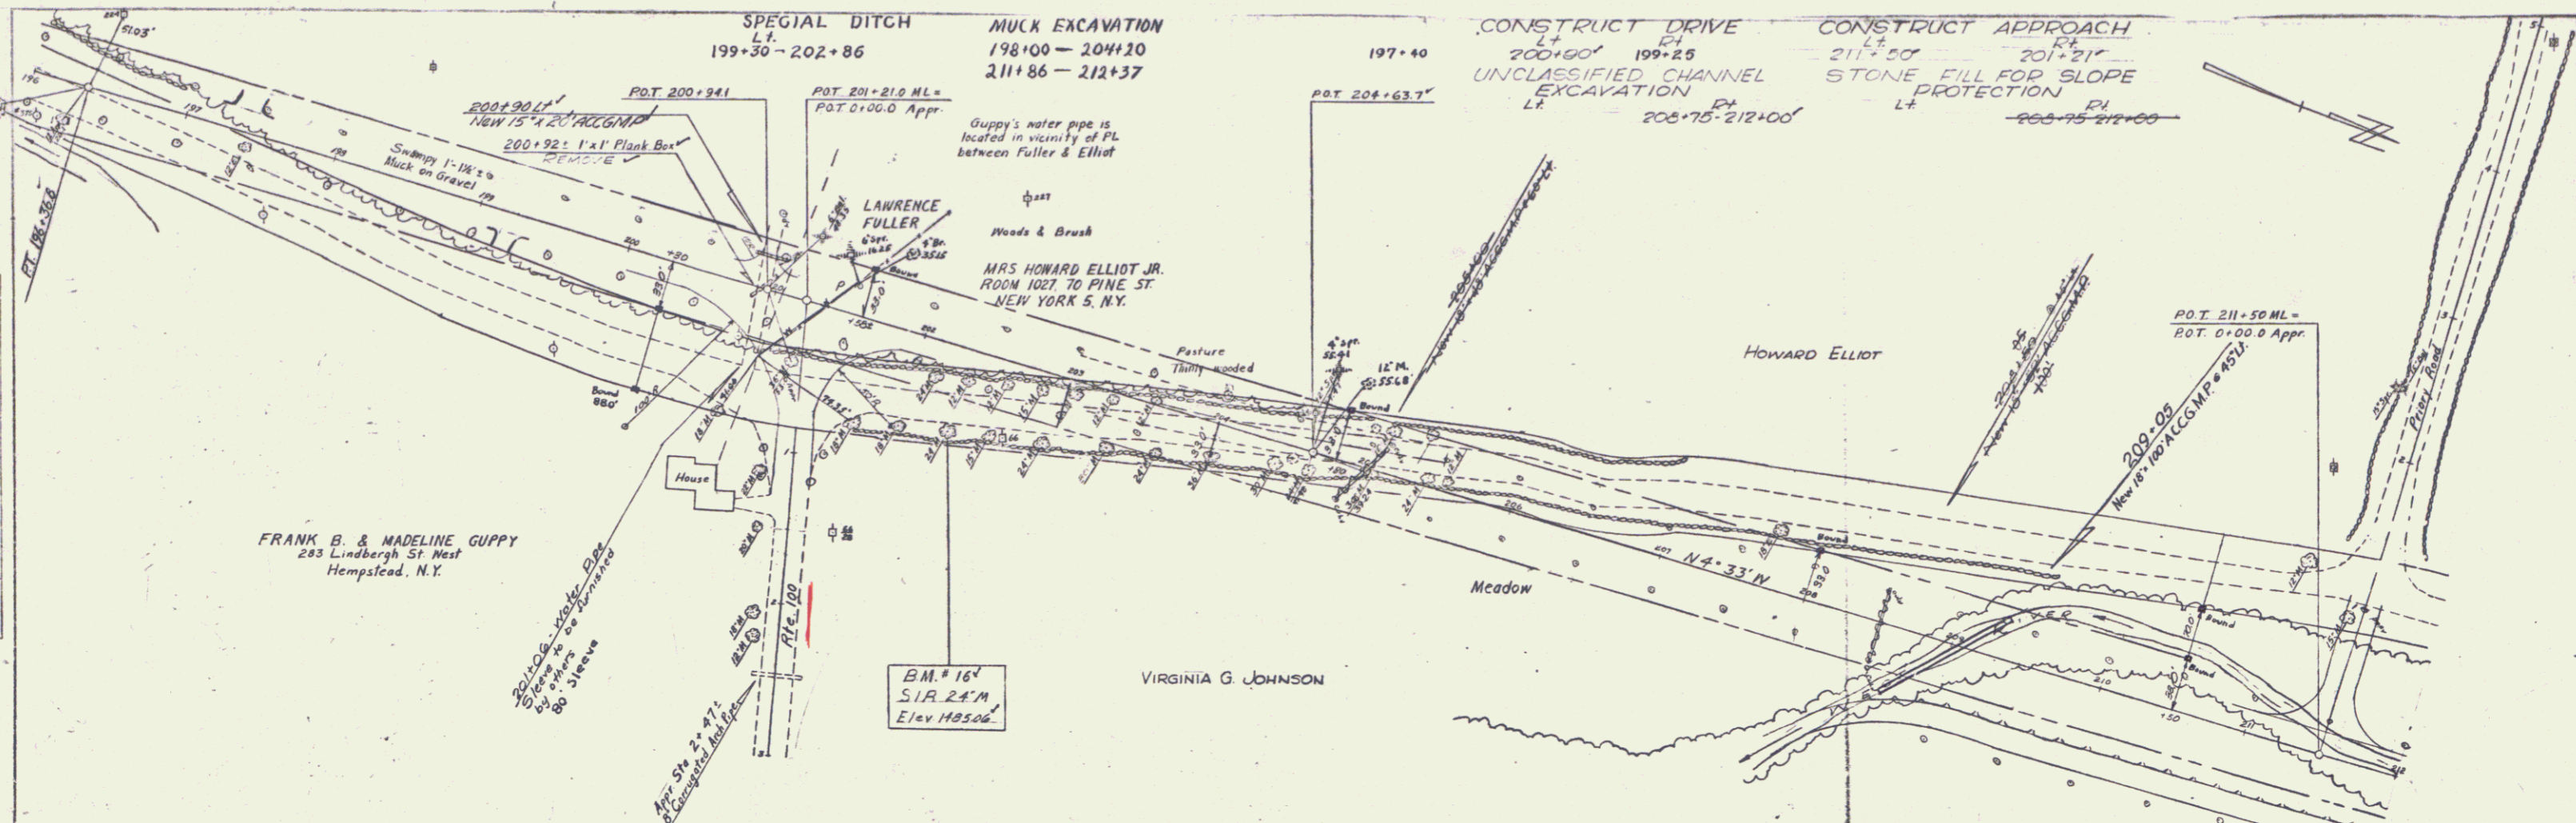

WESTON - MT HOLLY  
 Project FH 11/1/50-023(2)5A  
 Sheet 2.5 of 5.4

PLAN  
 DATE: 11/13/10  
 DRAWN BY: MARTIN A. Johnson  
 CHECKED BY: [Signature]  
 PROJECT: WESTON - MT. HOLLY  
 SHEET: 54



PROFILE  
 DATE: 11/13/10  
 DRAWN BY: Martin A. Johnson  
 CHECKED BY: [Signature]  
 PROJECT: WESTON - MT. HOLLY  
 SHEET: 54

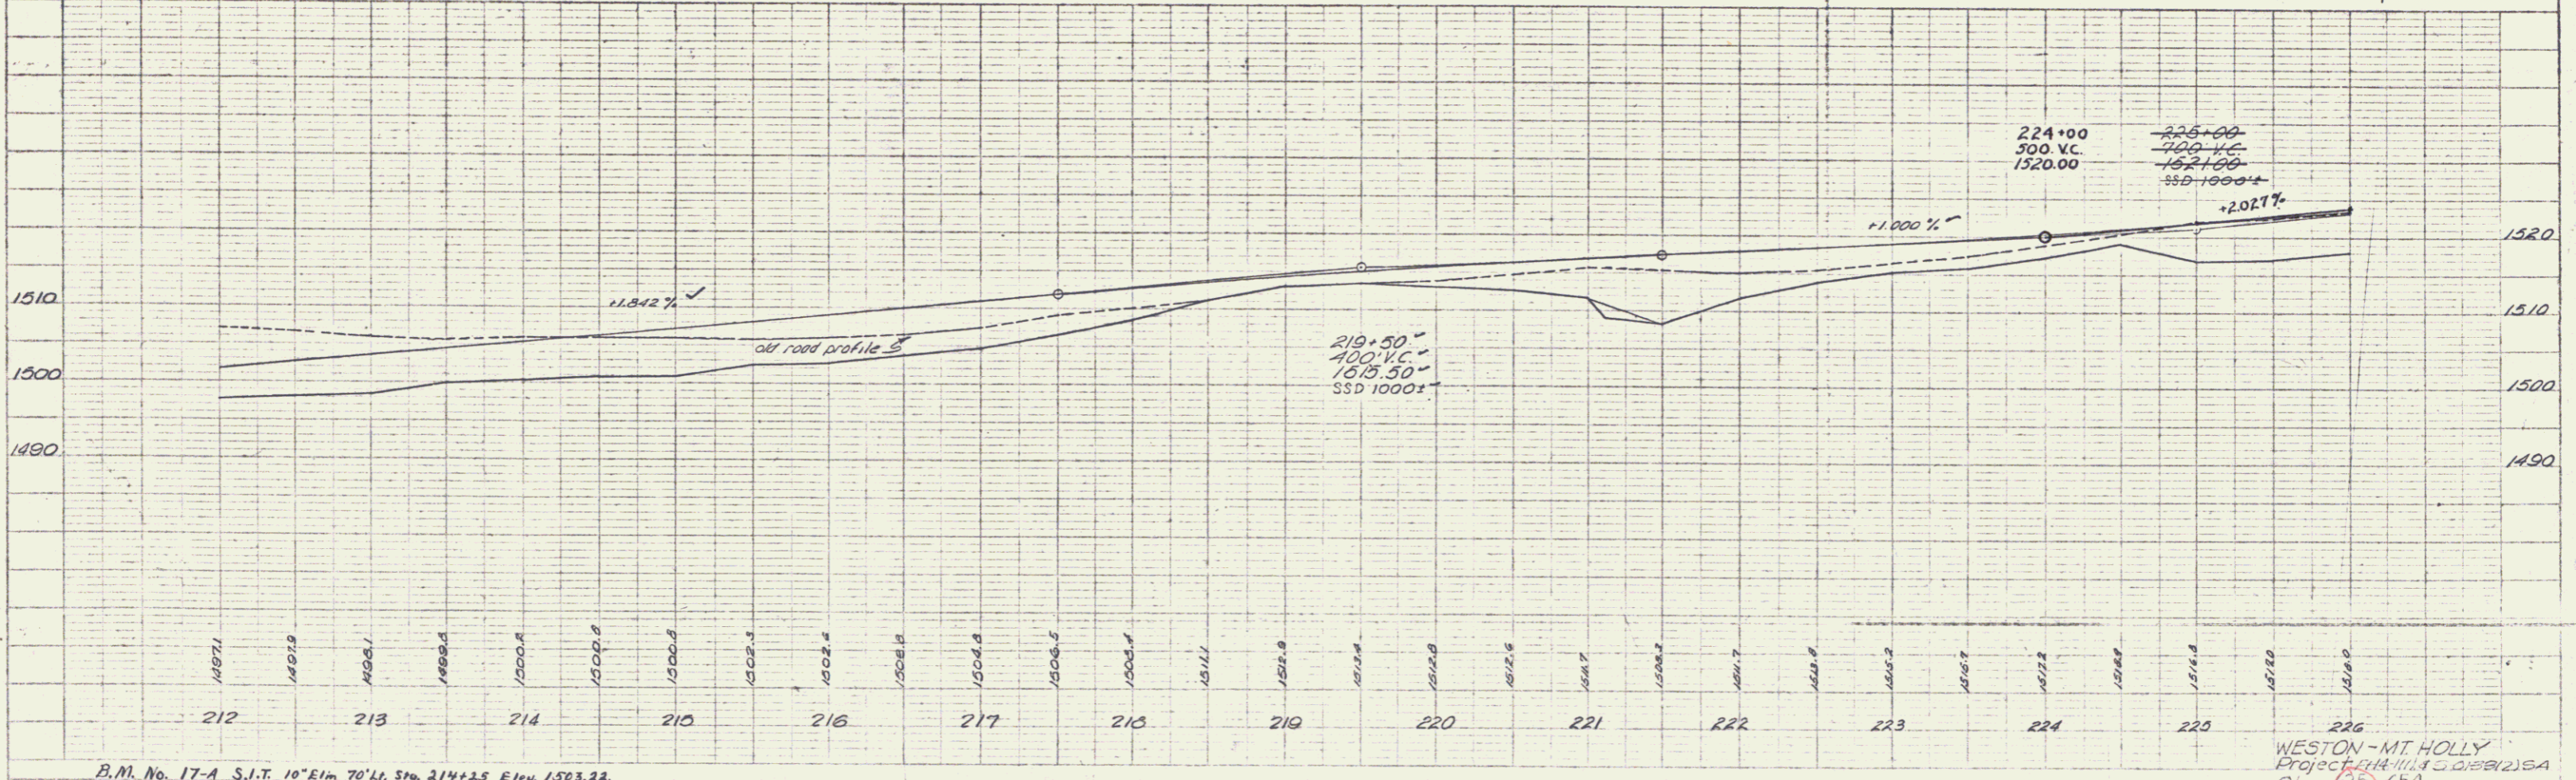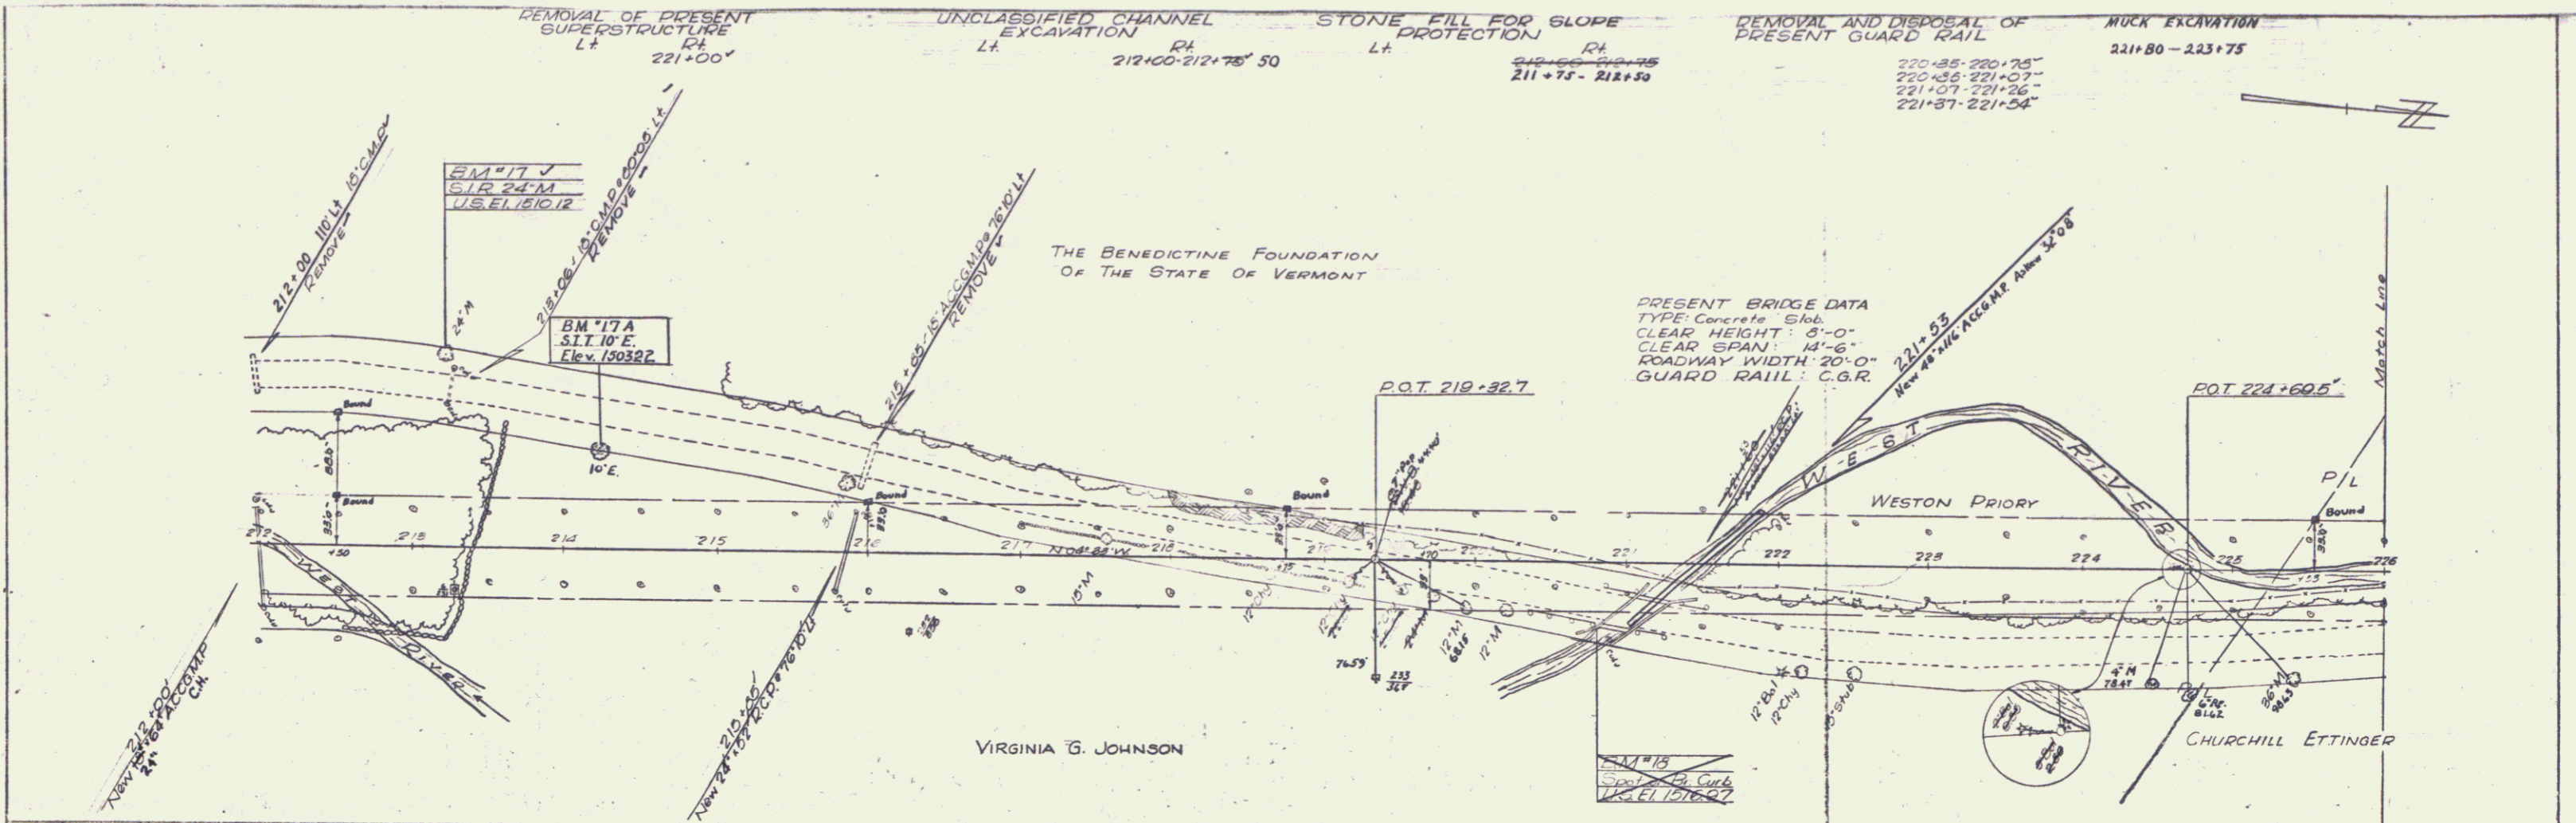



PLAN	DATE	BY
REVISED		
APPROVED		
DATE		
BY		
PROJECT		
LOCATION		
SCALE		
DATE		
BY		

PROFILE	DATE	BY
REVISED		
APPROVED		
DATE		
BY		
PROJECT		
LOCATION		
SCALE		
DATE		
BY		

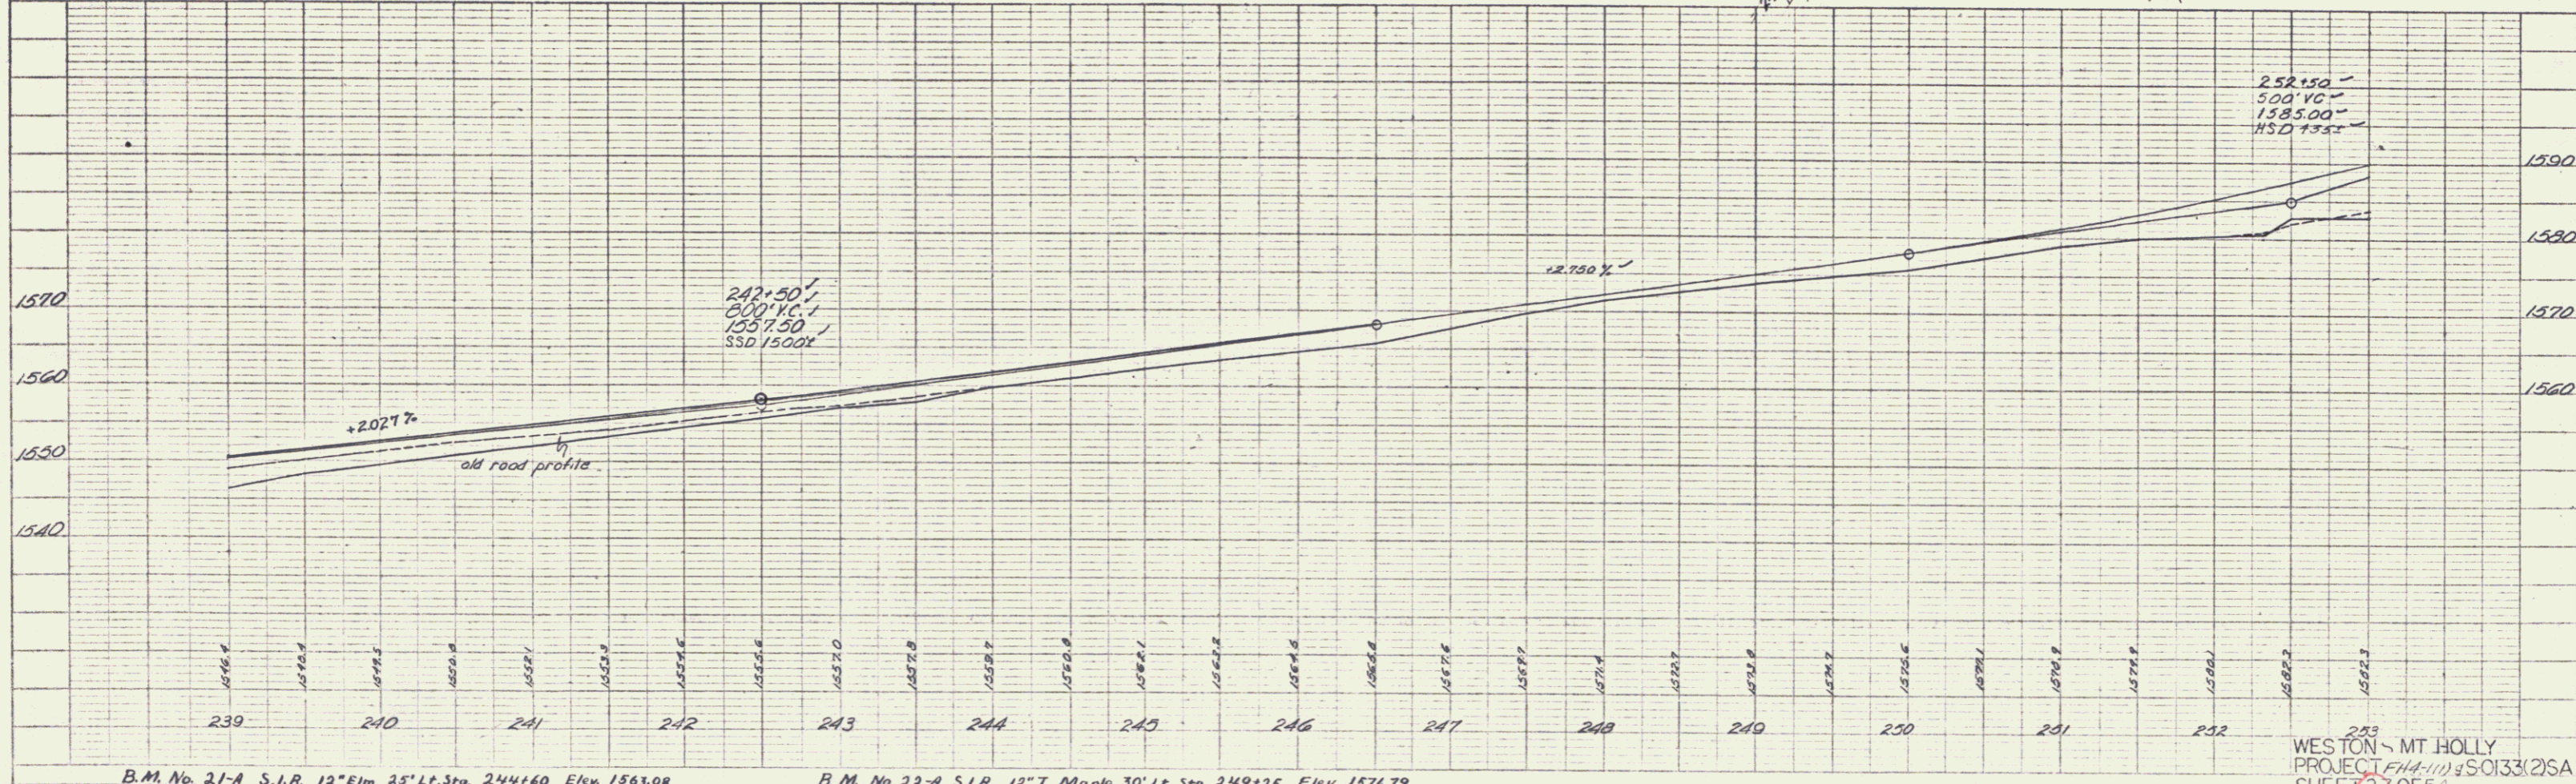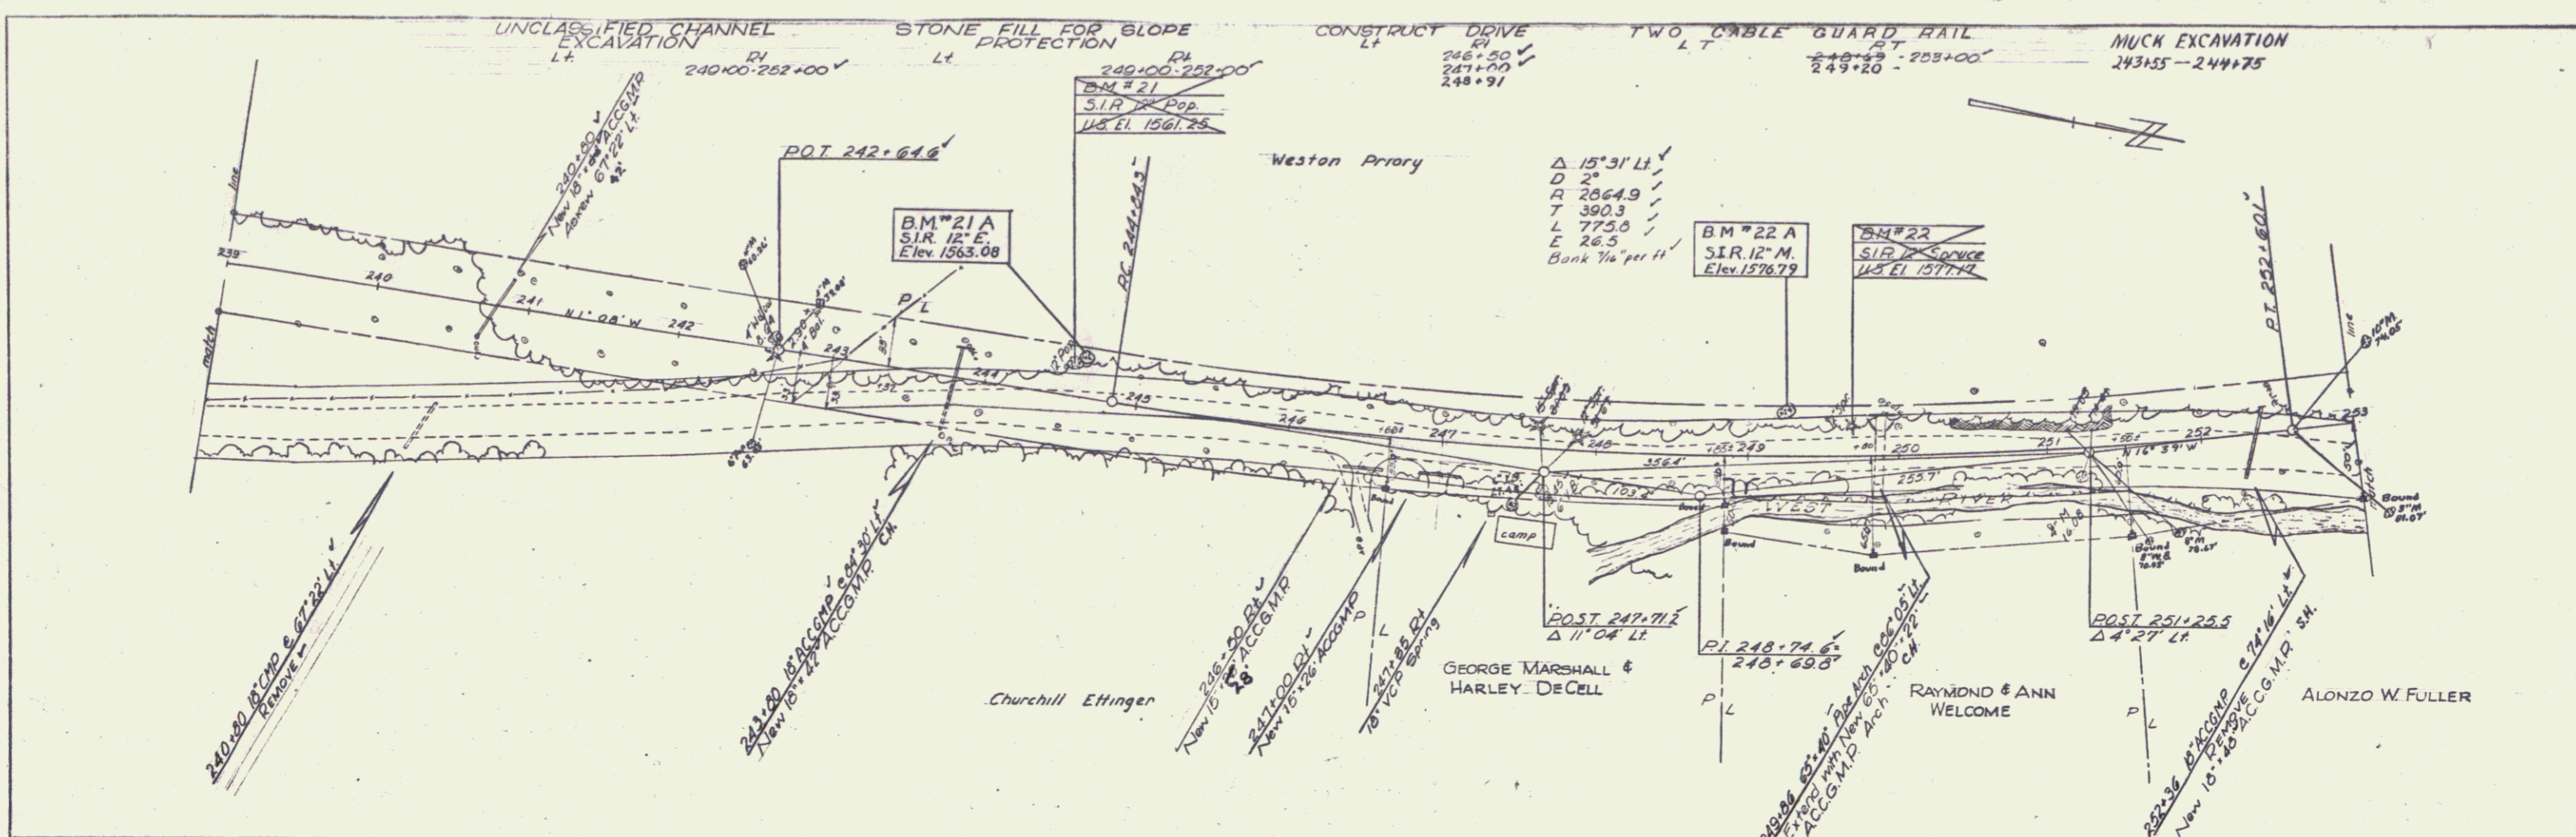


B.M. No. 21-A S.I.R. 12"E. Elm. 33' L.P. Sta. 244+60 Elev. 1563.08

B.M. No. 22-A S.I.R. 12"E. Maple 30' L.P. Sta. 249+25 Elev. 1576.79


WESTON - MT HOLLY  
PROJECT F.H.A. (11) 50133(2)SA  
SHEET 27 OF 54

CONSTRUCT DRIVE L.F. 265+70 R.F. 260+70  
 UNCLASSIFIED CHANNEL EXCAVATION L.F. 267+19-267+30 R.F. 265+00-267+00  
 STONE FILL FOR SLOPE PROTECTION L.F. 267+19-267+30 R.F. 265+00-267+00  
 TWO CABLE GUARD RAIL L.F. 265+00-265+66 R.F. 262+75-267+00  
 DRILLING AND BLASTING OF SOLID ROCK SUBGRADE L.F. 255+75-257+70 R.F. 259+85-261+70

DATE	1/10
BY	J. J. [unclear]
CHECKED	[unclear]
IN CHARGE	[unclear]
PROJECT	[unclear]
NO.	[unclear]

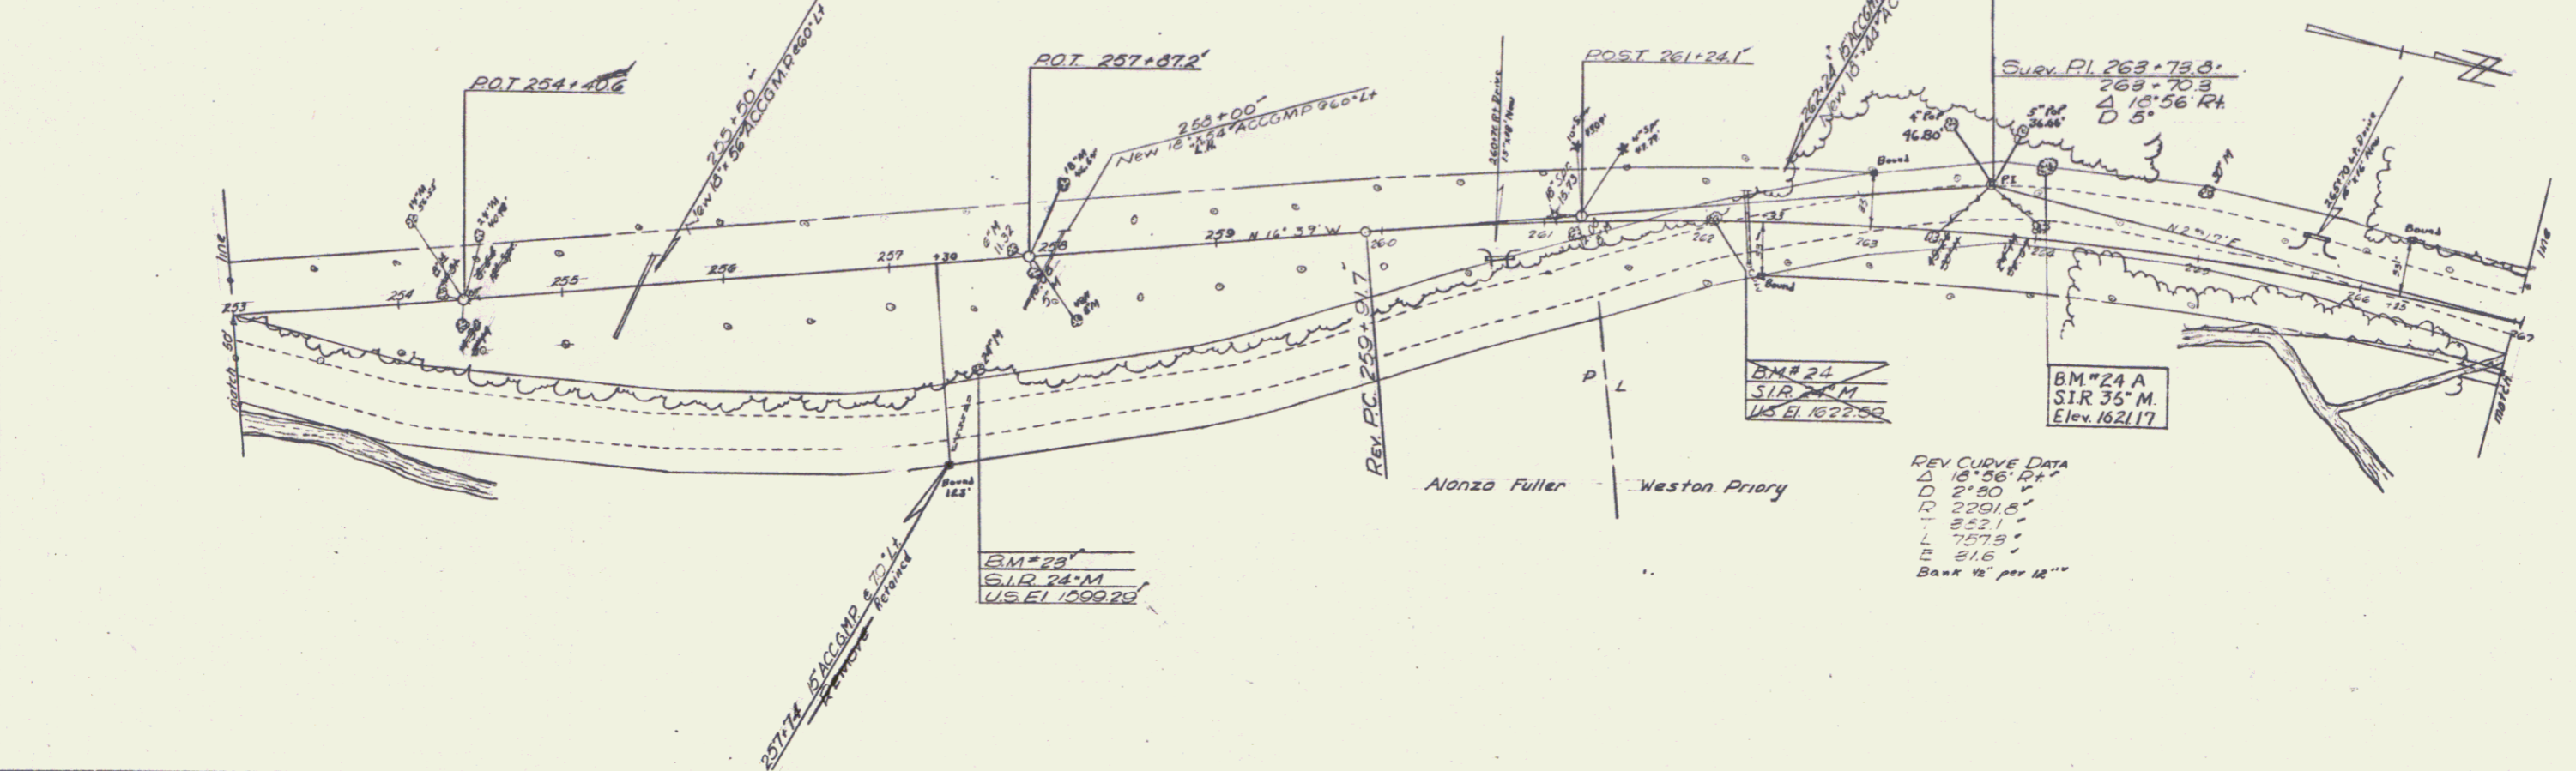



DATE	
BY	
CHECKED	
IN CHARGE	
PROJECT	
NO.	

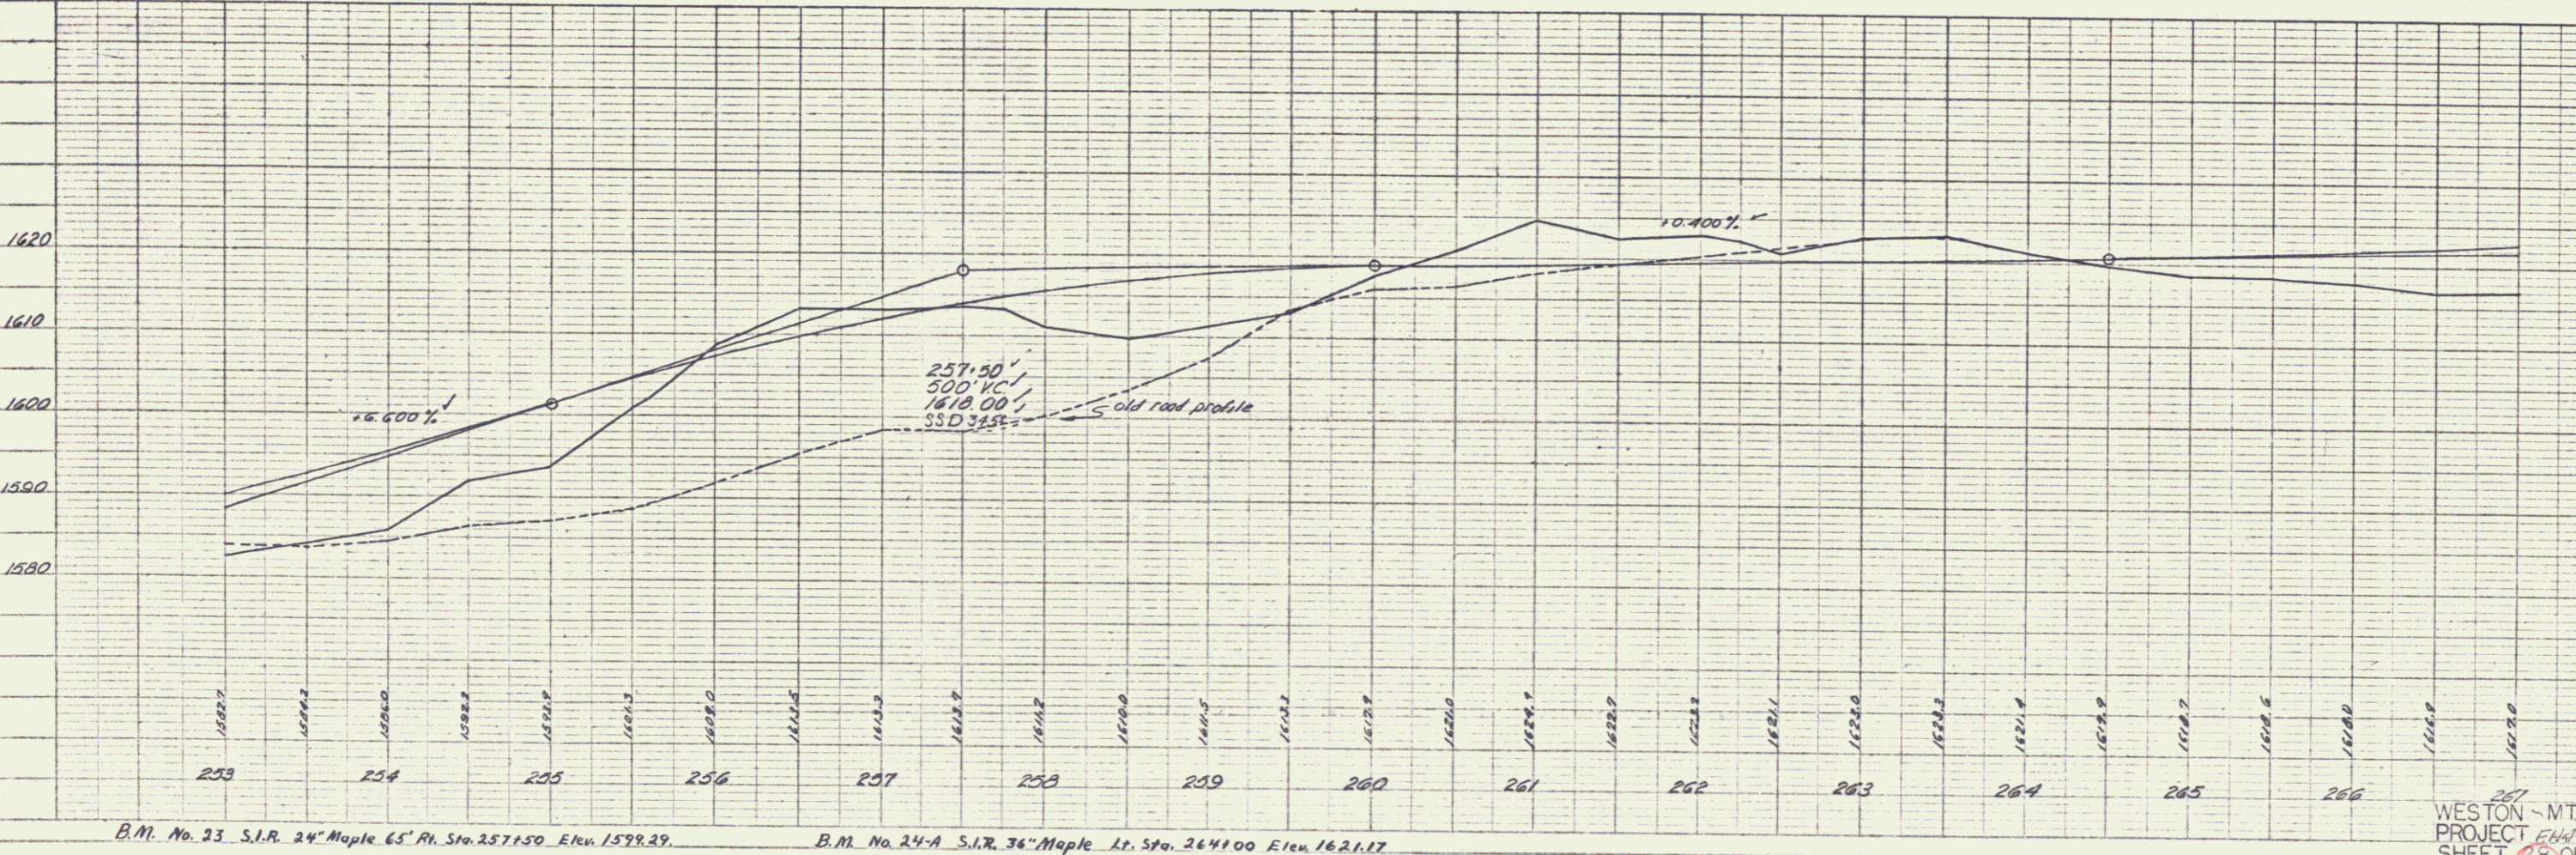





PLAN	DATE	BY
DATE	SCALE	PROJECT
NOTE BOOK	SCALE	PROJECT
NO.	NO.	NO.

PROFILE	DATE	BY
DATE	SCALE	PROJECT
NOTE BOOK	SCALE	PROJECT
NO.	NO.	NO.

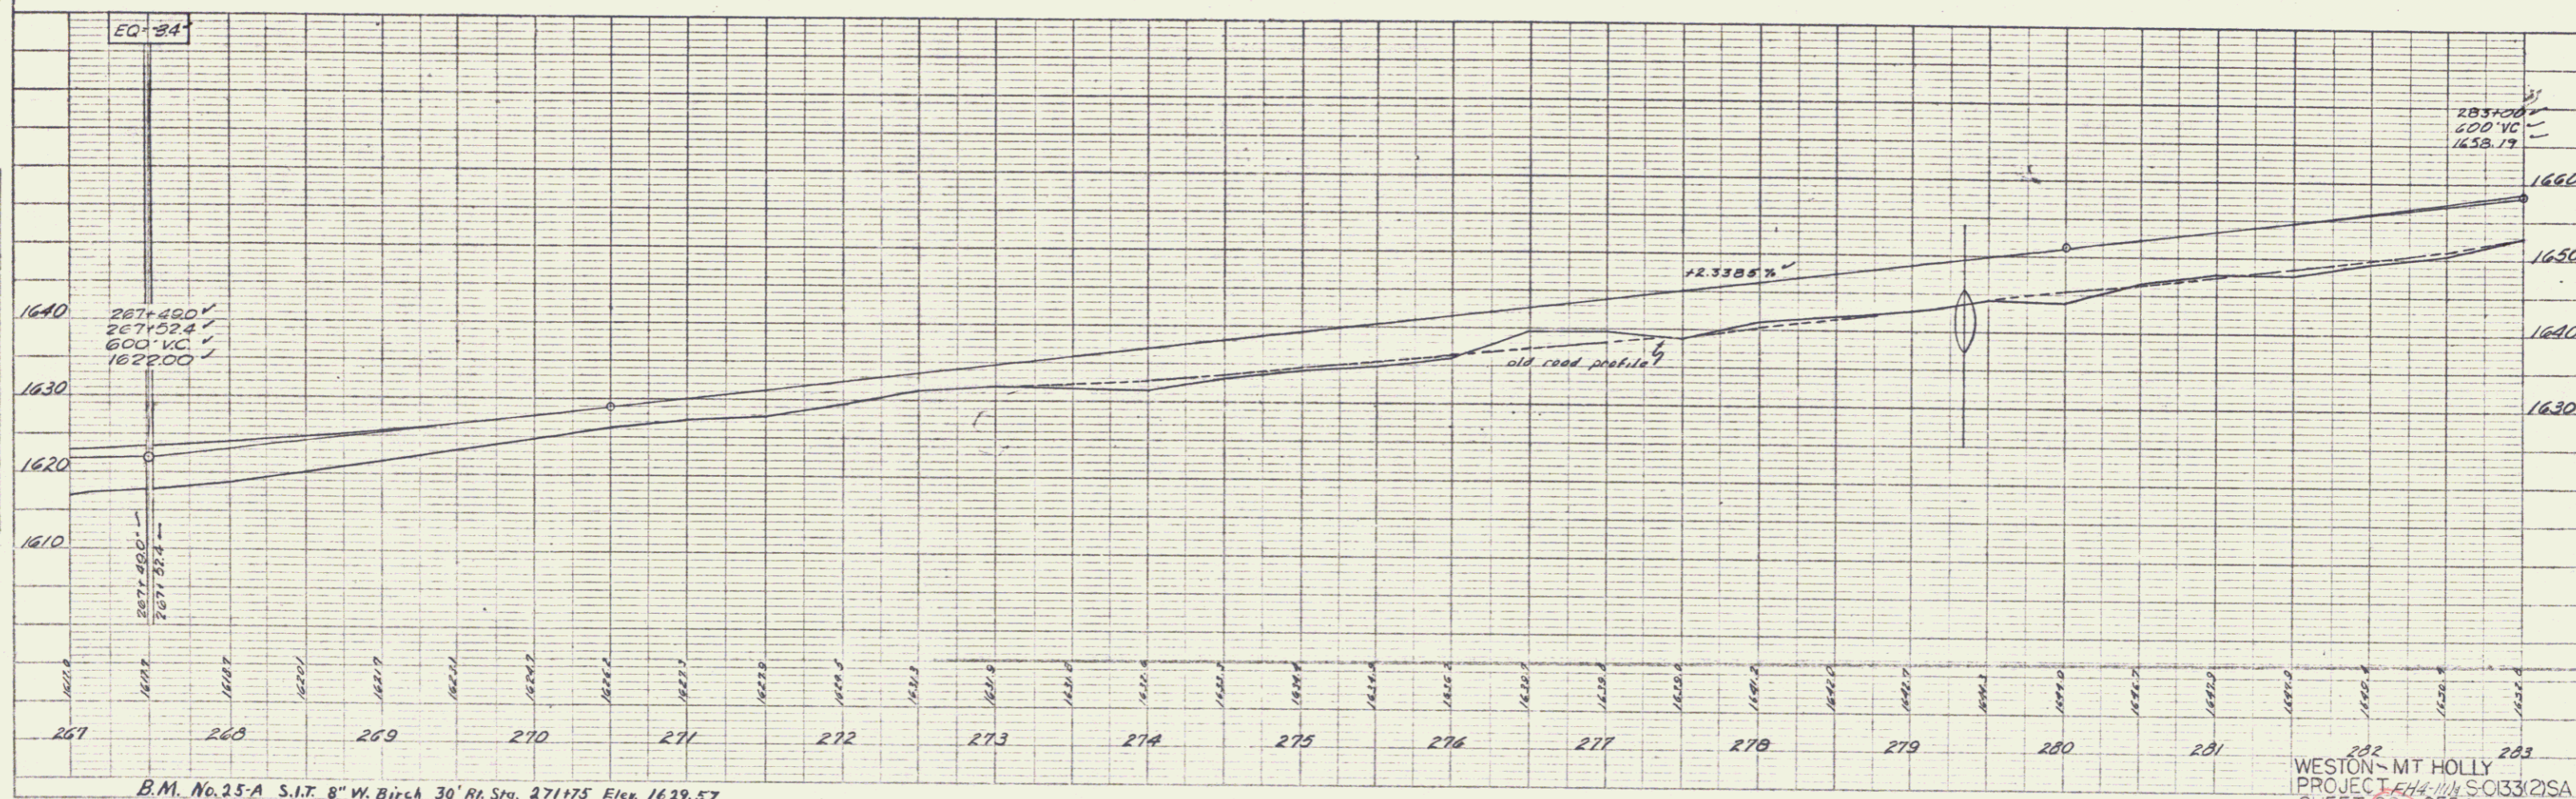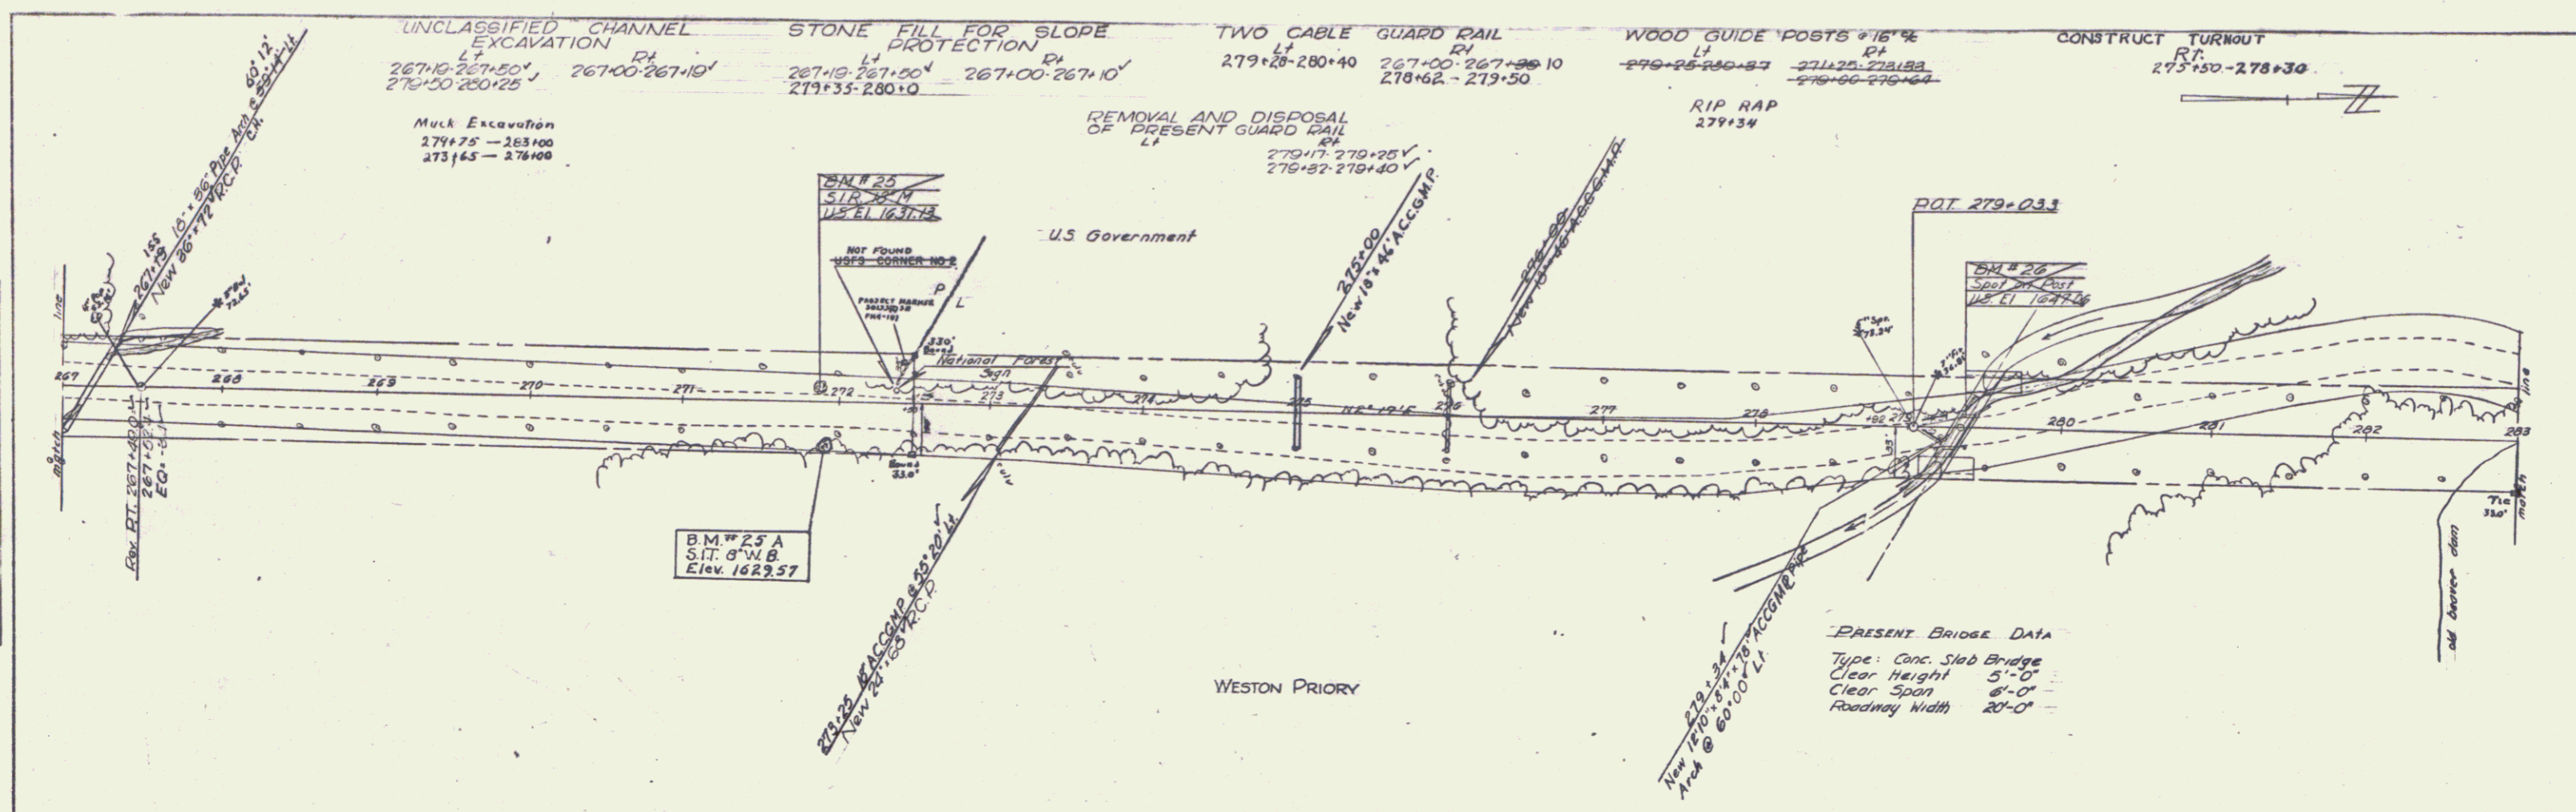

PLAN	DATE	BY
REVISED		
NOTED		
BY		
DATE		
BY		
DATE		

PROFILE	DATE	BY
REVISED		
NOTED		
BY		
DATE		
BY		
DATE		

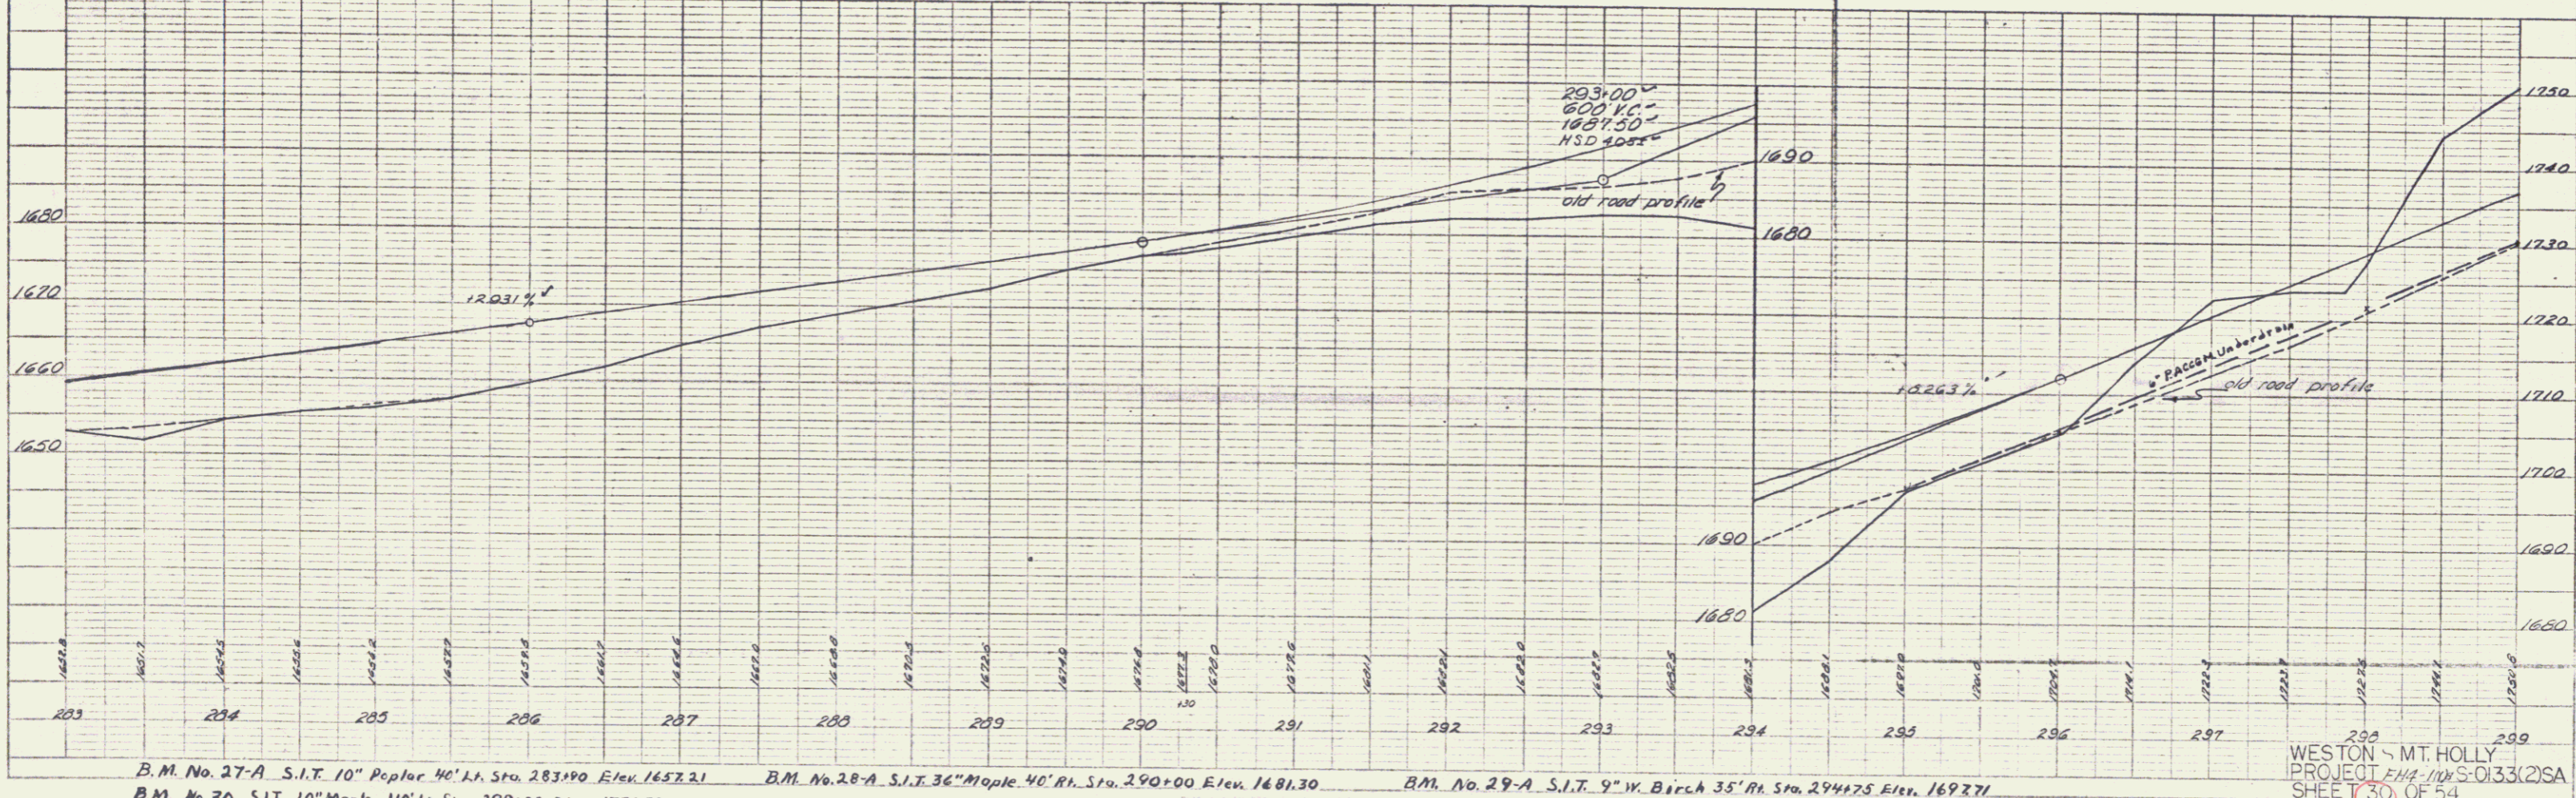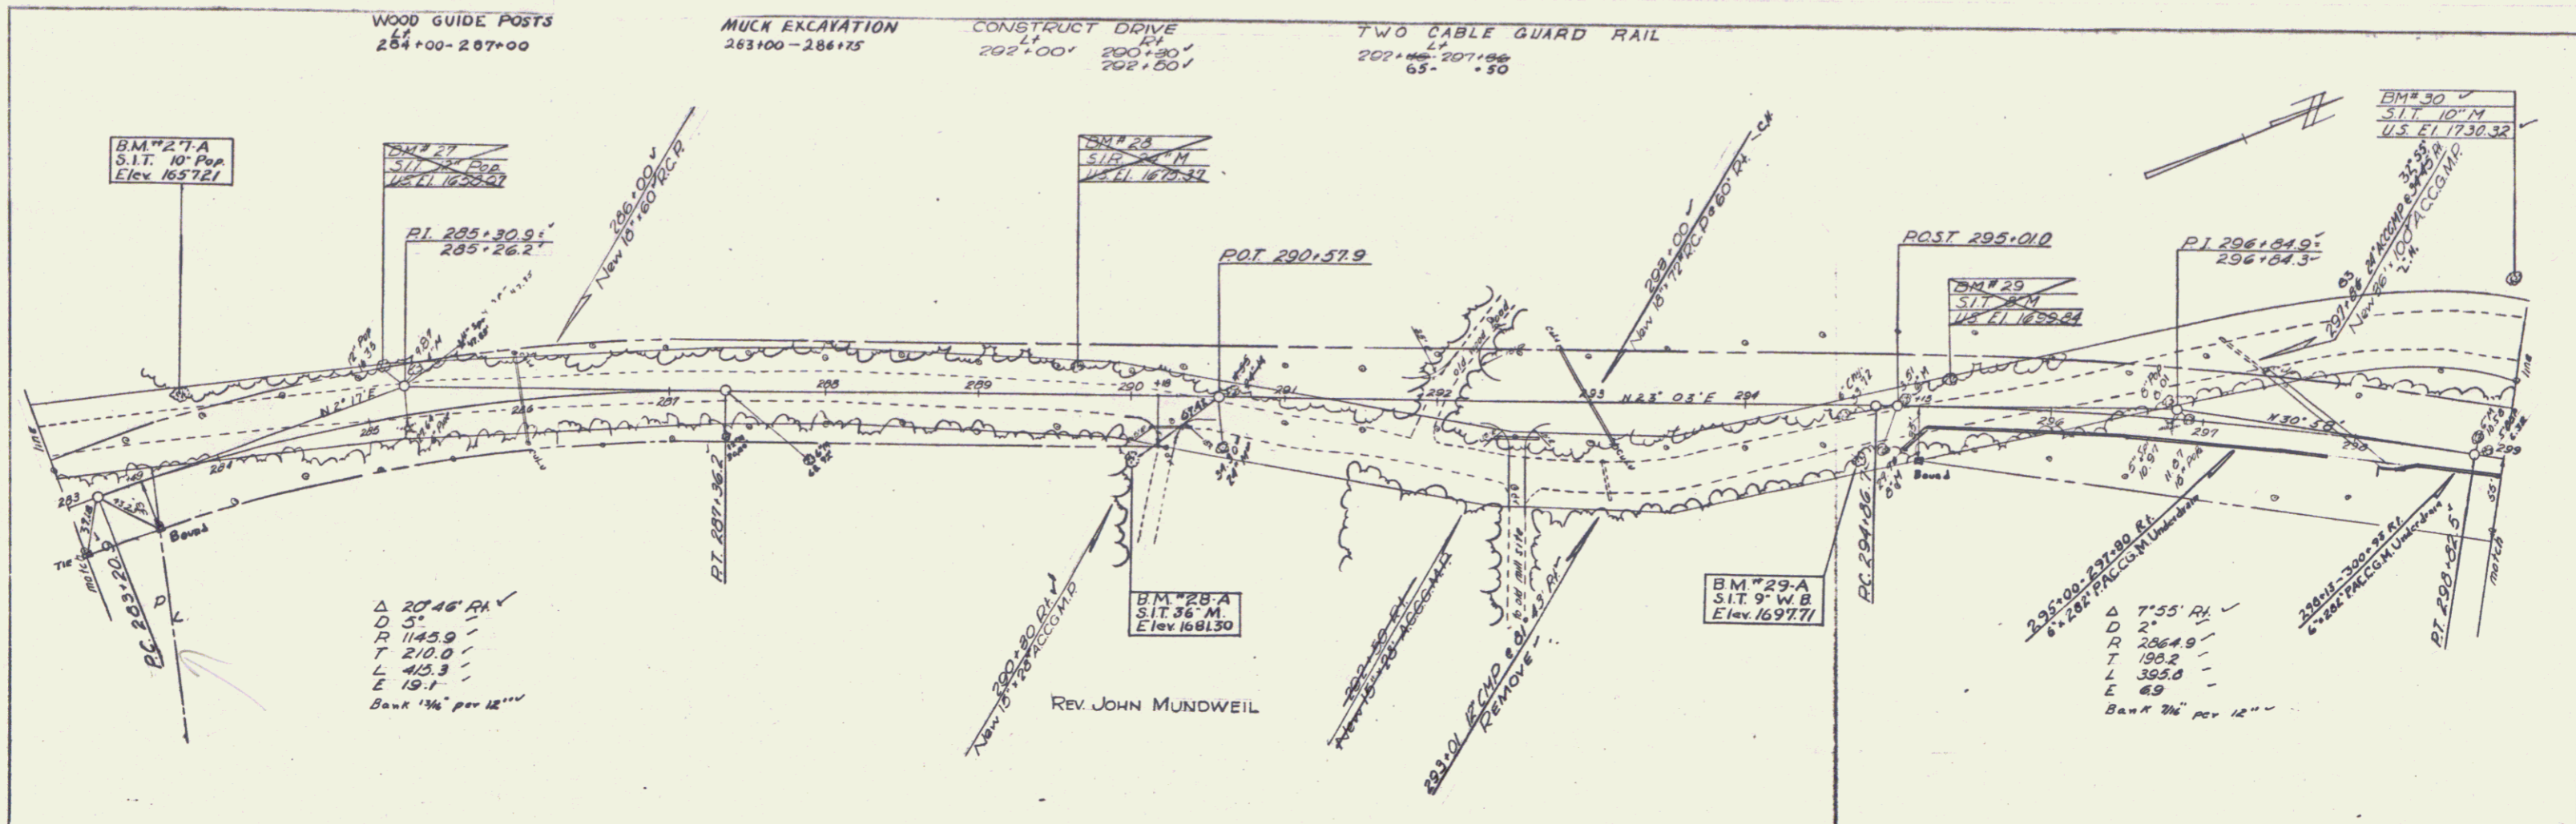


B.M. No. 27-A S.I.T. 10" Poplar 40' Lt. Sta. 283+00 Elev. 1657.21  
 B.M. No. 28-A S.I.T. 36" Maple 40' Rt. Sta. 290+00 Elev. 1681.30  
 B.M. No. 29-A S.I.T. 9" W. Birch 35' Rt. Sta. 294+75 Elev. 1697.71  
 B.M. No. 30 S.I.T. 10" Maple 110' Lt. Sta. 299+00 Elev. 1730.32


WESTON - MT. HOLLY  
 PROJECT E.M.A. 11/15/03-0133(2)SA  
 SHEET 30 OF 54

PLAN  
 DRAWN BY: [Signature]  
 CHECKED BY: [Signature]  
 DATE: 11/15/05  
 SHEET NO. 31 OF 54

PROFILE  
 DRAWN BY: [Signature]  
 CHECKED BY: [Signature]  
 DATE: 11/15/05  
 SHEET NO. 31 OF 54

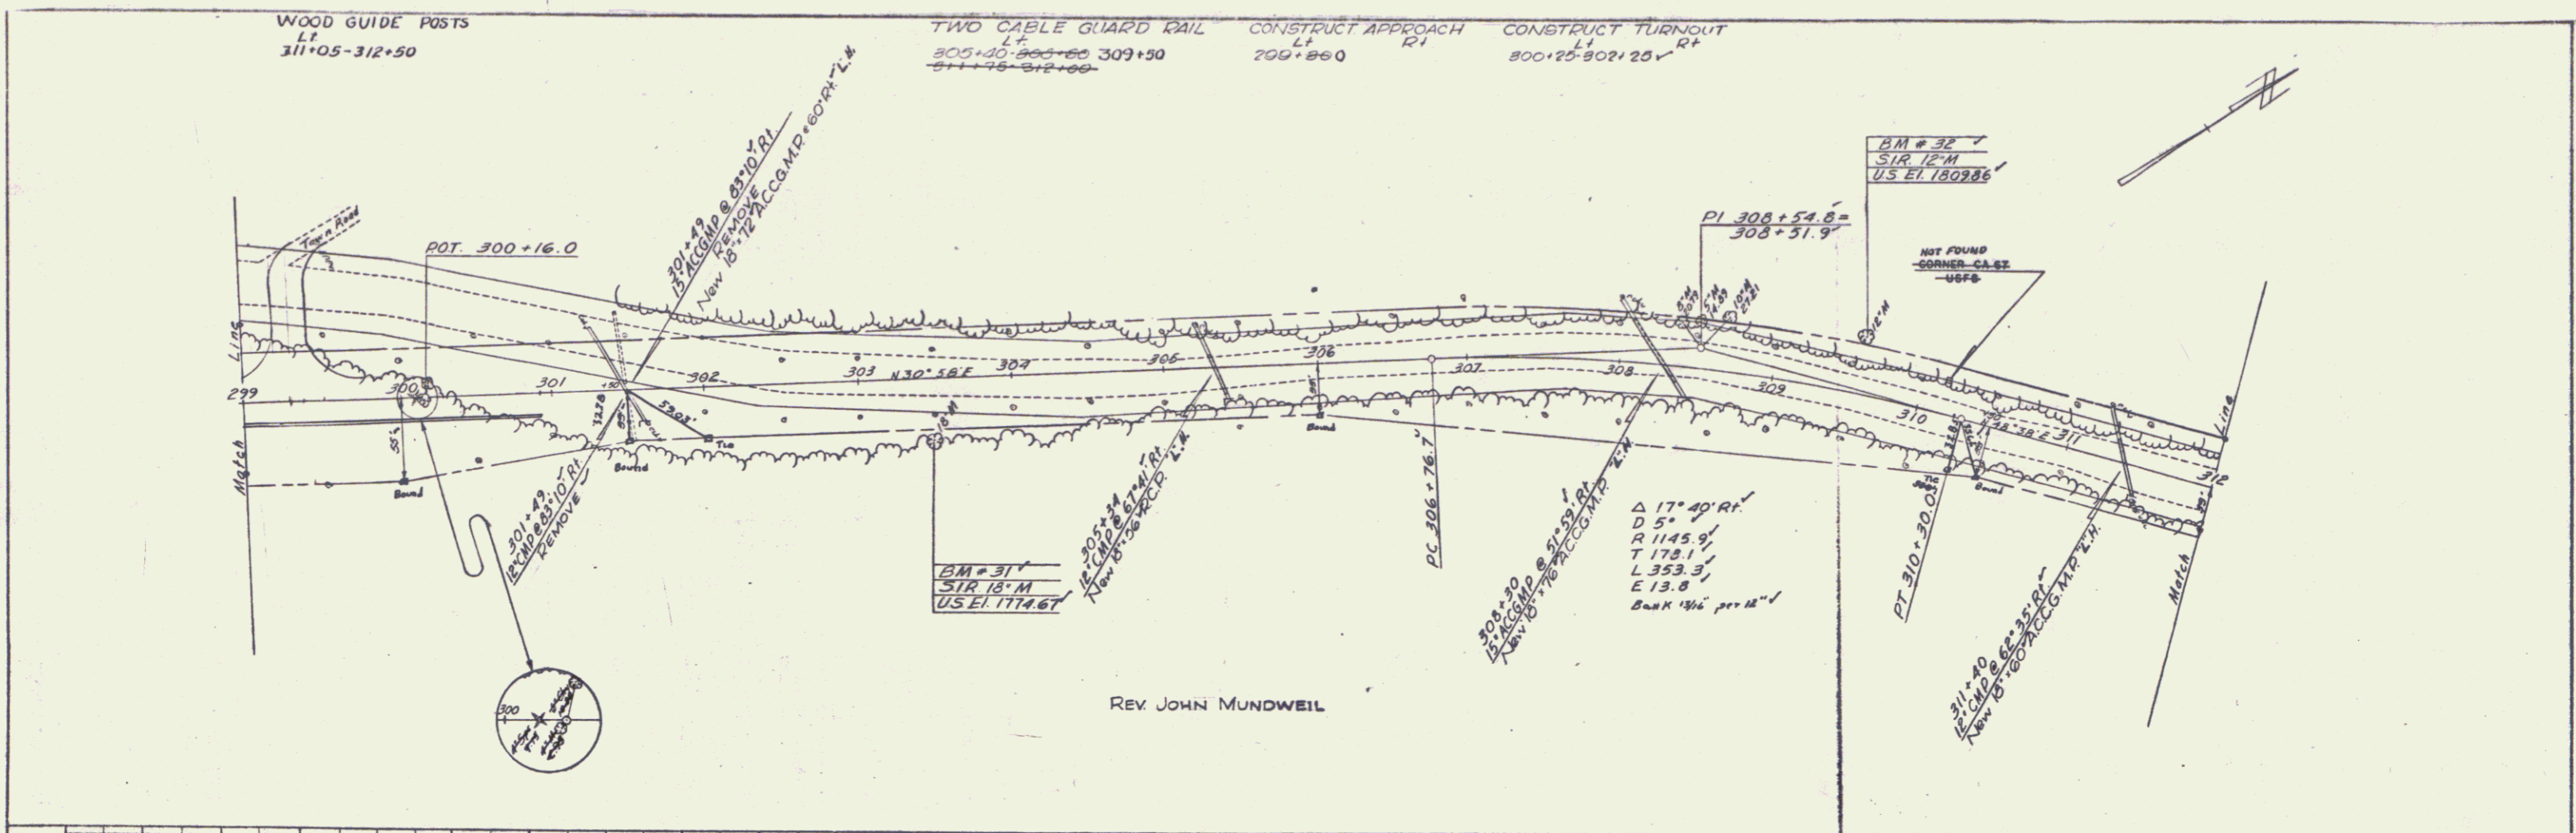

REV. JOHN MUNDWEIL


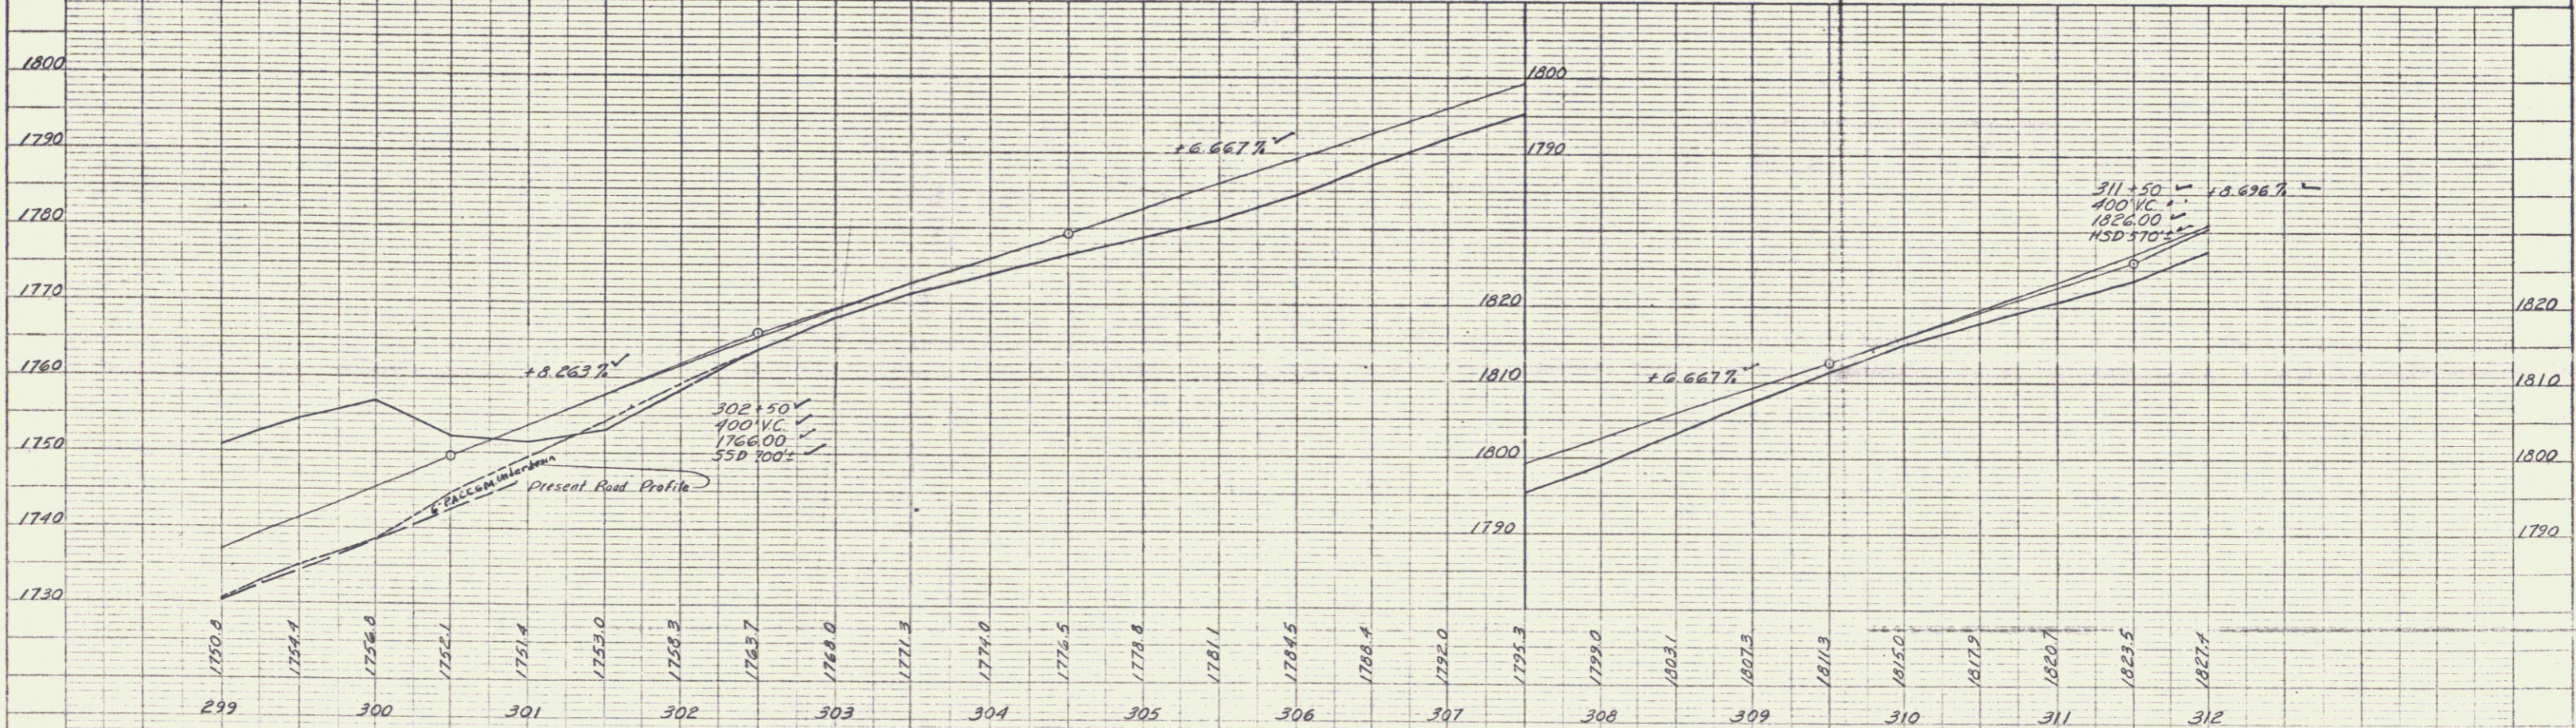


B.M. No. 31 S.I.R. 18' Maple 38' Rt. Sta. 303+50 Elev. 1774.67  
 B.M. No. 32 S.I.R. 12' Maple 36' Lt. Sta. 309+50 Elev. 1809.86

WESTON - MT HOLLY  
 PROJECT E.H. 100-S-0133(2)SA  
 SHEET 31 OF 54

PLAN  
 DRAWN BY: *Tracy*  
 CHECKED BY: *Gagnon*  
 DATE: 1/60

PROFILE  
 DRAWN BY: *Gagnon*  
 CHECKED BY: *Gagnon*  
 DATE: 1/60

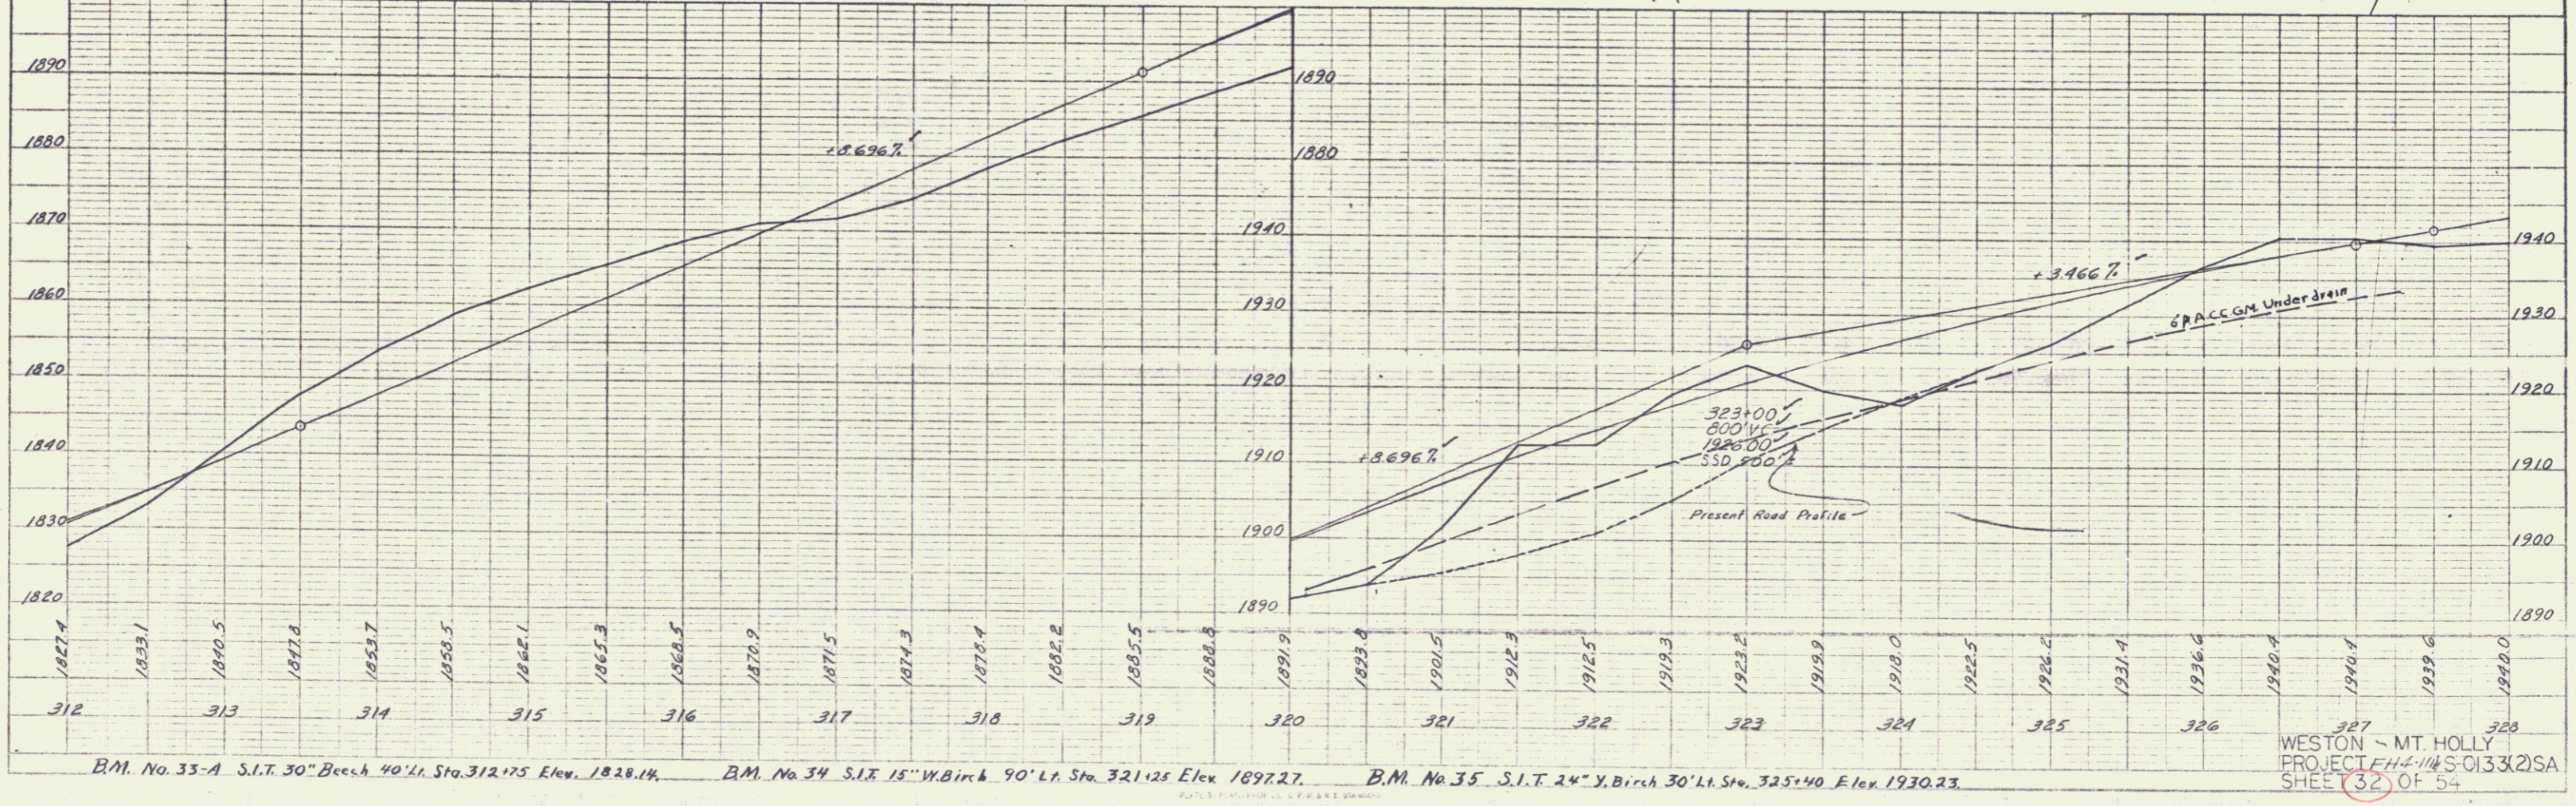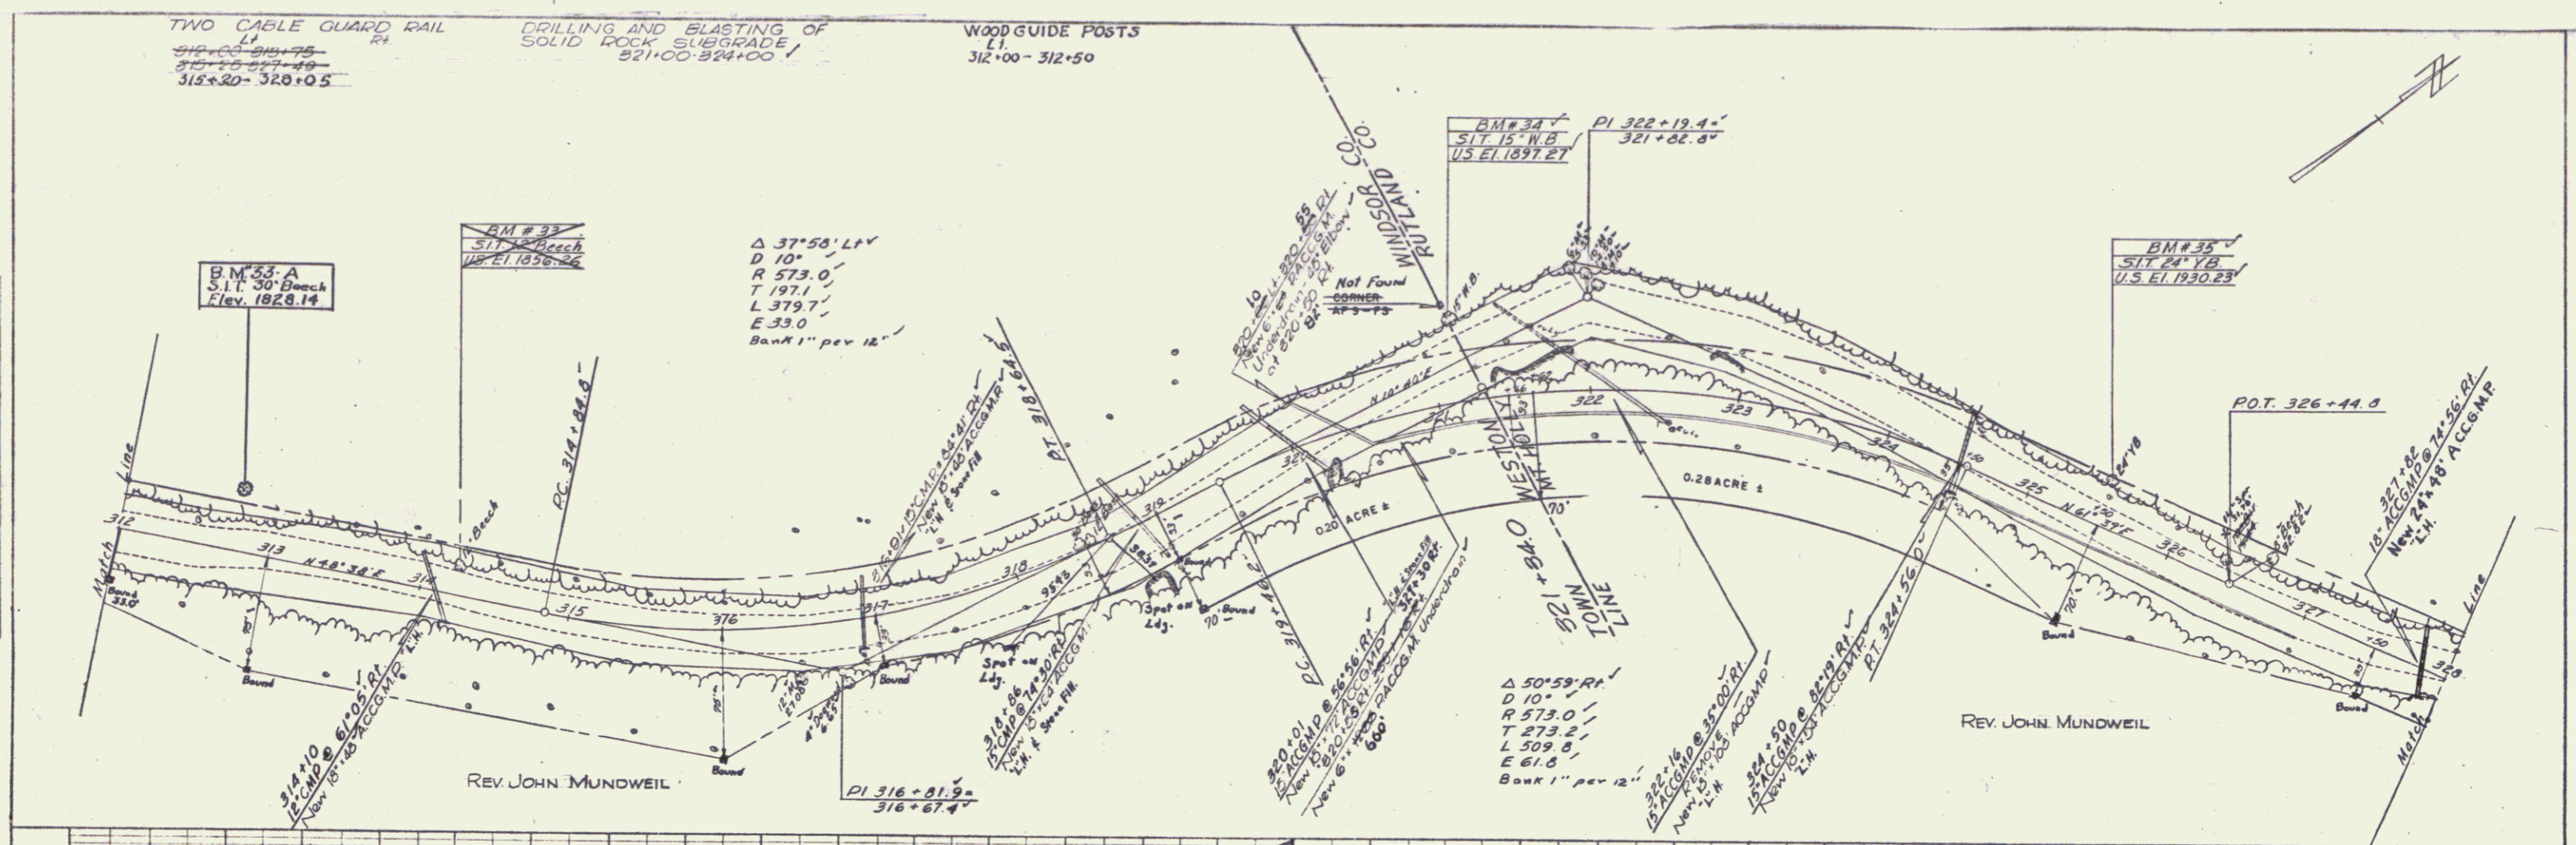

WESTON - MT HOLLY  
 PROJECT FH-114 S-0133(2)SA  
 SHEET 32 OF 54

PLAN  
 DRAWN BY: J. Gagnon  
 DATE: 8/60  
 CHECKED BY: J. Gagnon  
 DATE: 9/60  
 NOTE: ROAD TO BE TRACED

PROFILE  
 DRAWN BY: J. Gagnon  
 DATE: 8/60  
 CHECKED BY: J. Gagnon  
 DATE: 9/60  
 NOTE: ROAD TO BE TRACED

