

PLAN
 4 TRACKED
 7-80
 100'

PROFILE
 8-61
 100'

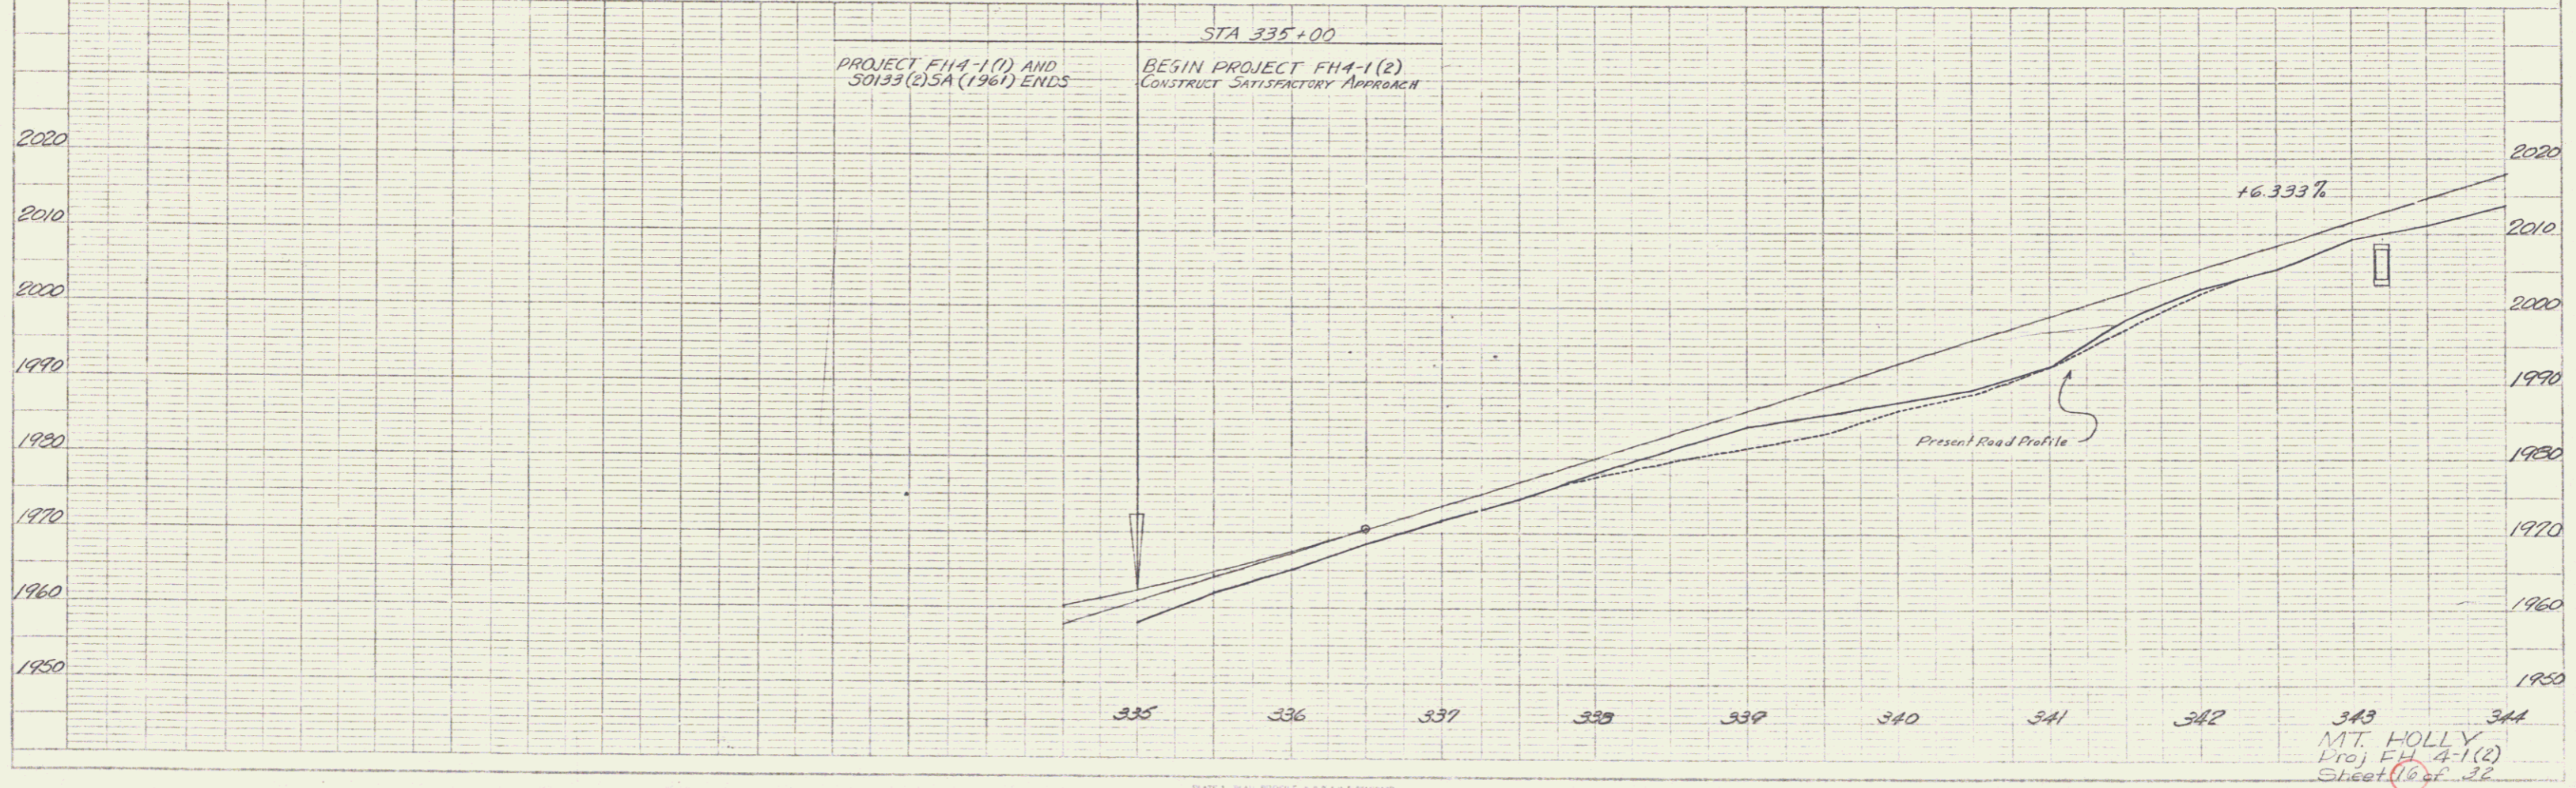
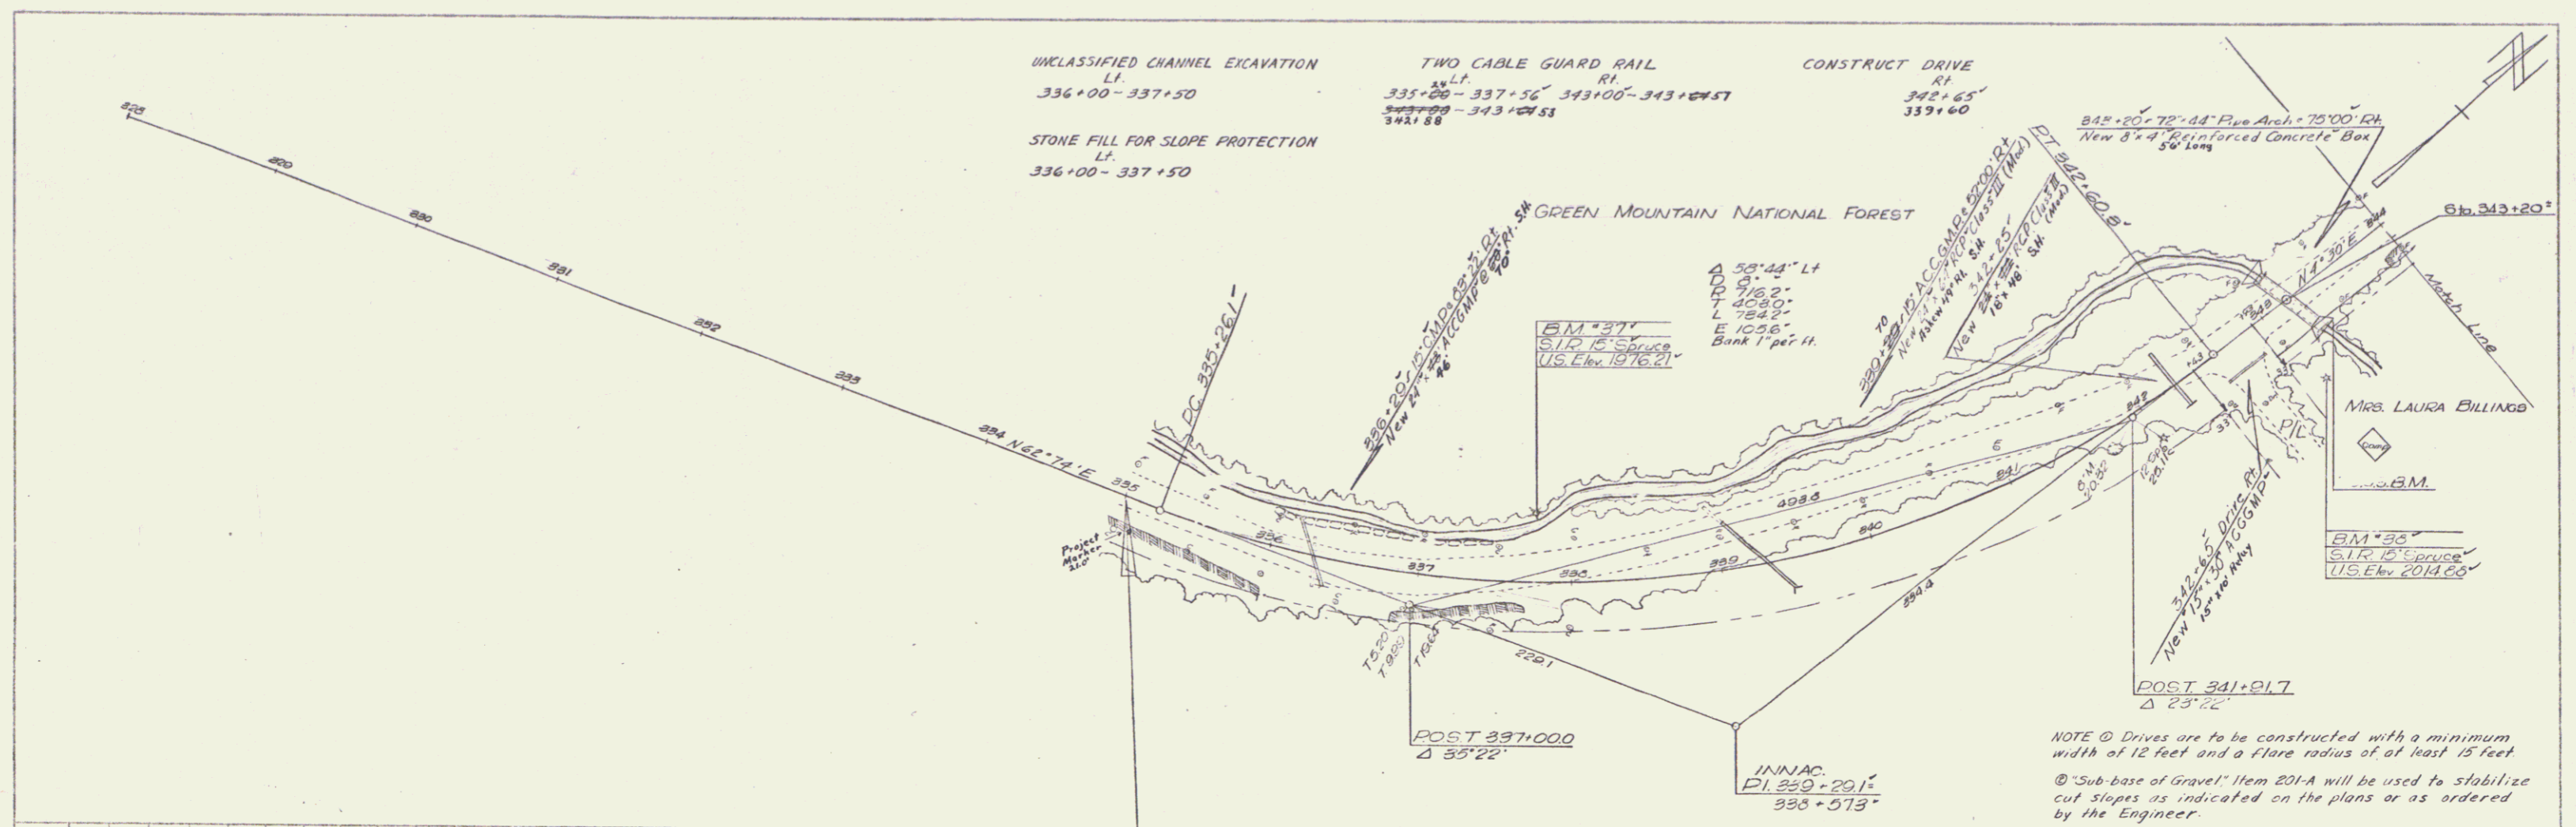


PLATE 1 PLAN, PROFILE, G.P.R. & E. STANDARD
 100' = 1" (PLAN)
 100' = 1" (PROFILE)

MT. HOLLY
 Proj. FH-1(2)
 Sheet 16 of 22