

PARCEL	19A
STATIONS	360+00 - 360+88
TAKING	0.17 Acres

CONSTRUCT DRIVE  
Rt  
365+20


DRILLING AND BLASTING OF  
SOLID ROCK SUBGRADE (MOD)  
361+00 - 367+00

MUCK EXCAVATION  
367+50 - 373+50

PARCEL	19C
STATIONS	367+22 - 368+73
TAKING	1.15 Acres

GREEN MOUNTAIN NATIONAL FOREST


PLAN  
DATE: 8/88  
BY: [Signature]  
CHECKED: [Signature]  
SCALE: 1" = 40'

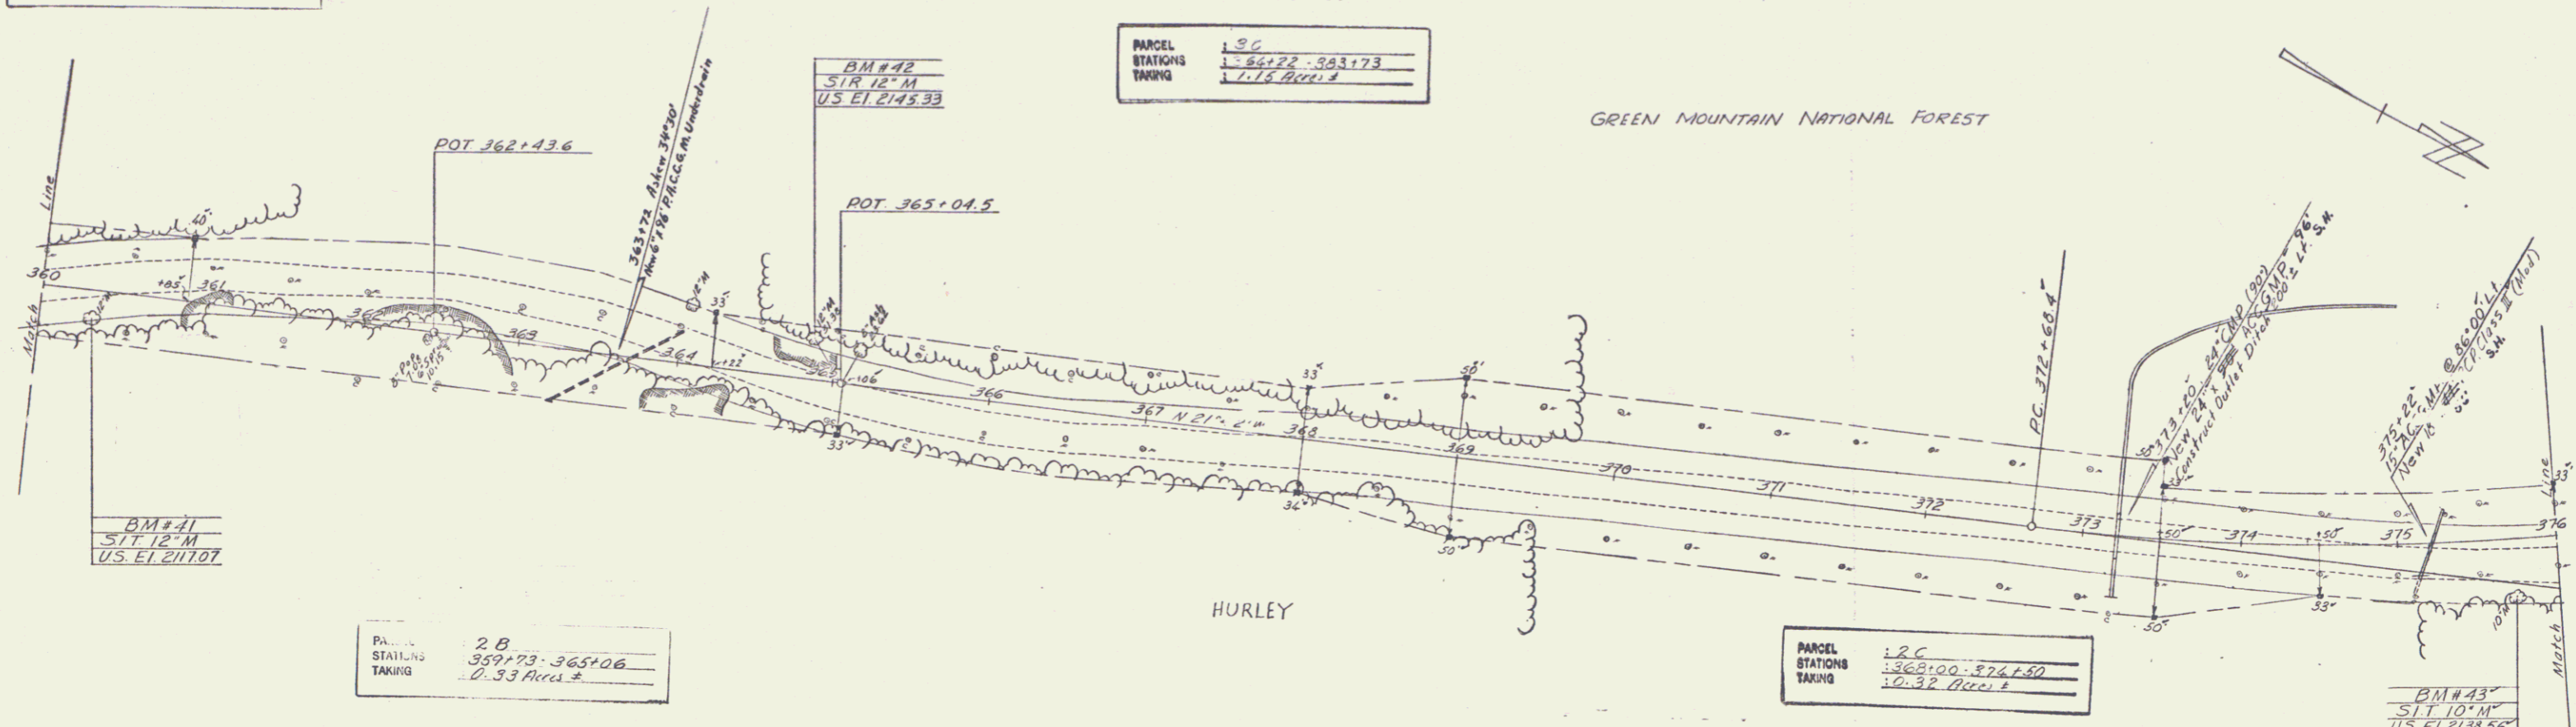

PARCEL	2B
STATIONS	359+73 - 365+06
TAKING	0.33 Acres

PARCEL	19C
STATIONS	368+00 - 374+50
TAKING	10.32 Acres

PROFILE  
DATE: 8/88  
BY: [Signature]  
CHECKED: [Signature]  
SCALE: 1" = 40'

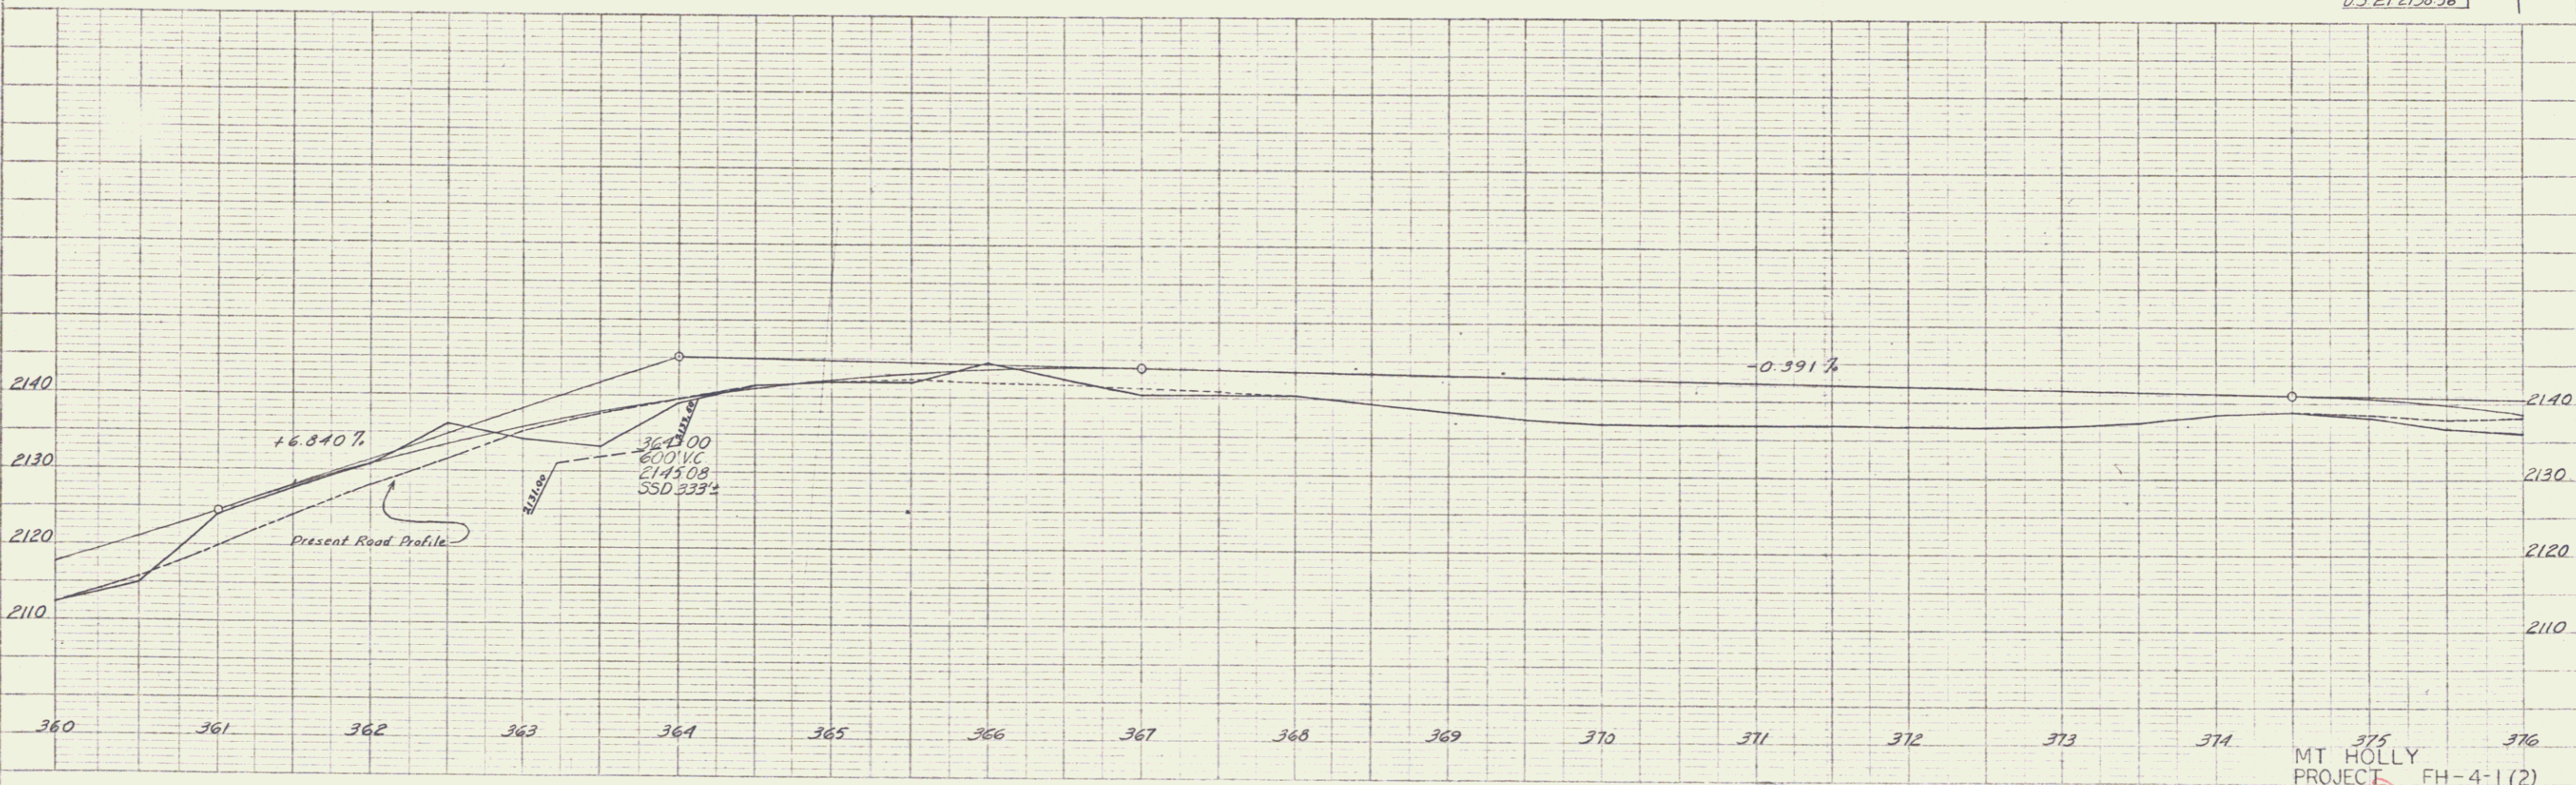

MT HOLLY  
PROJECT FH-4-1(2)  
SHEET 18 OF 32

PLATE - PLAN PROFILE - P.R.A.R. STANDARD  
REVISIONS  
DATE