
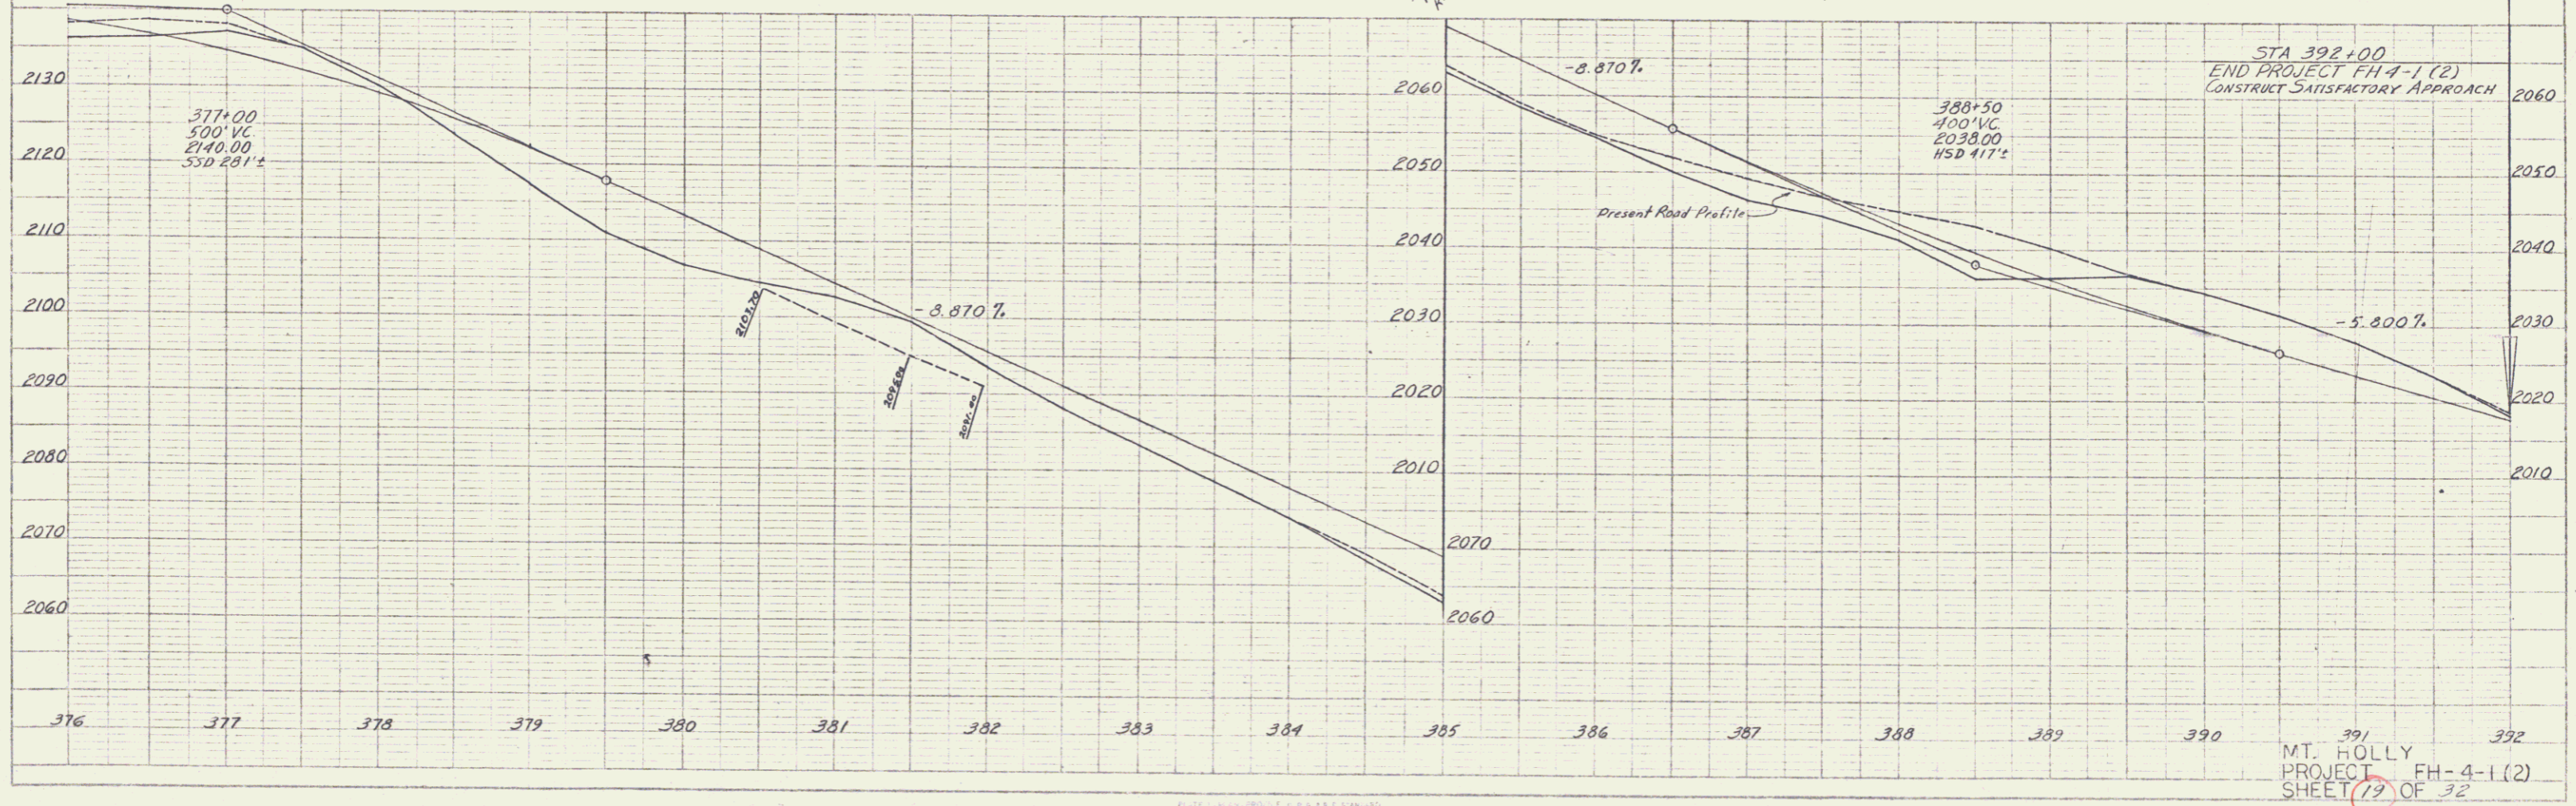


PLAN
 DATE: 8/60
 DRAWN BY: Zaurman
 CHECKED BY: Gagnon
 TITLE: ROADWAY PROJECT

PROFILE
 DATE: 8/60
 DRAWN BY: Gagnon
 CHECKED BY: Gagnon
 TITLE: ROADWAY PROJECT

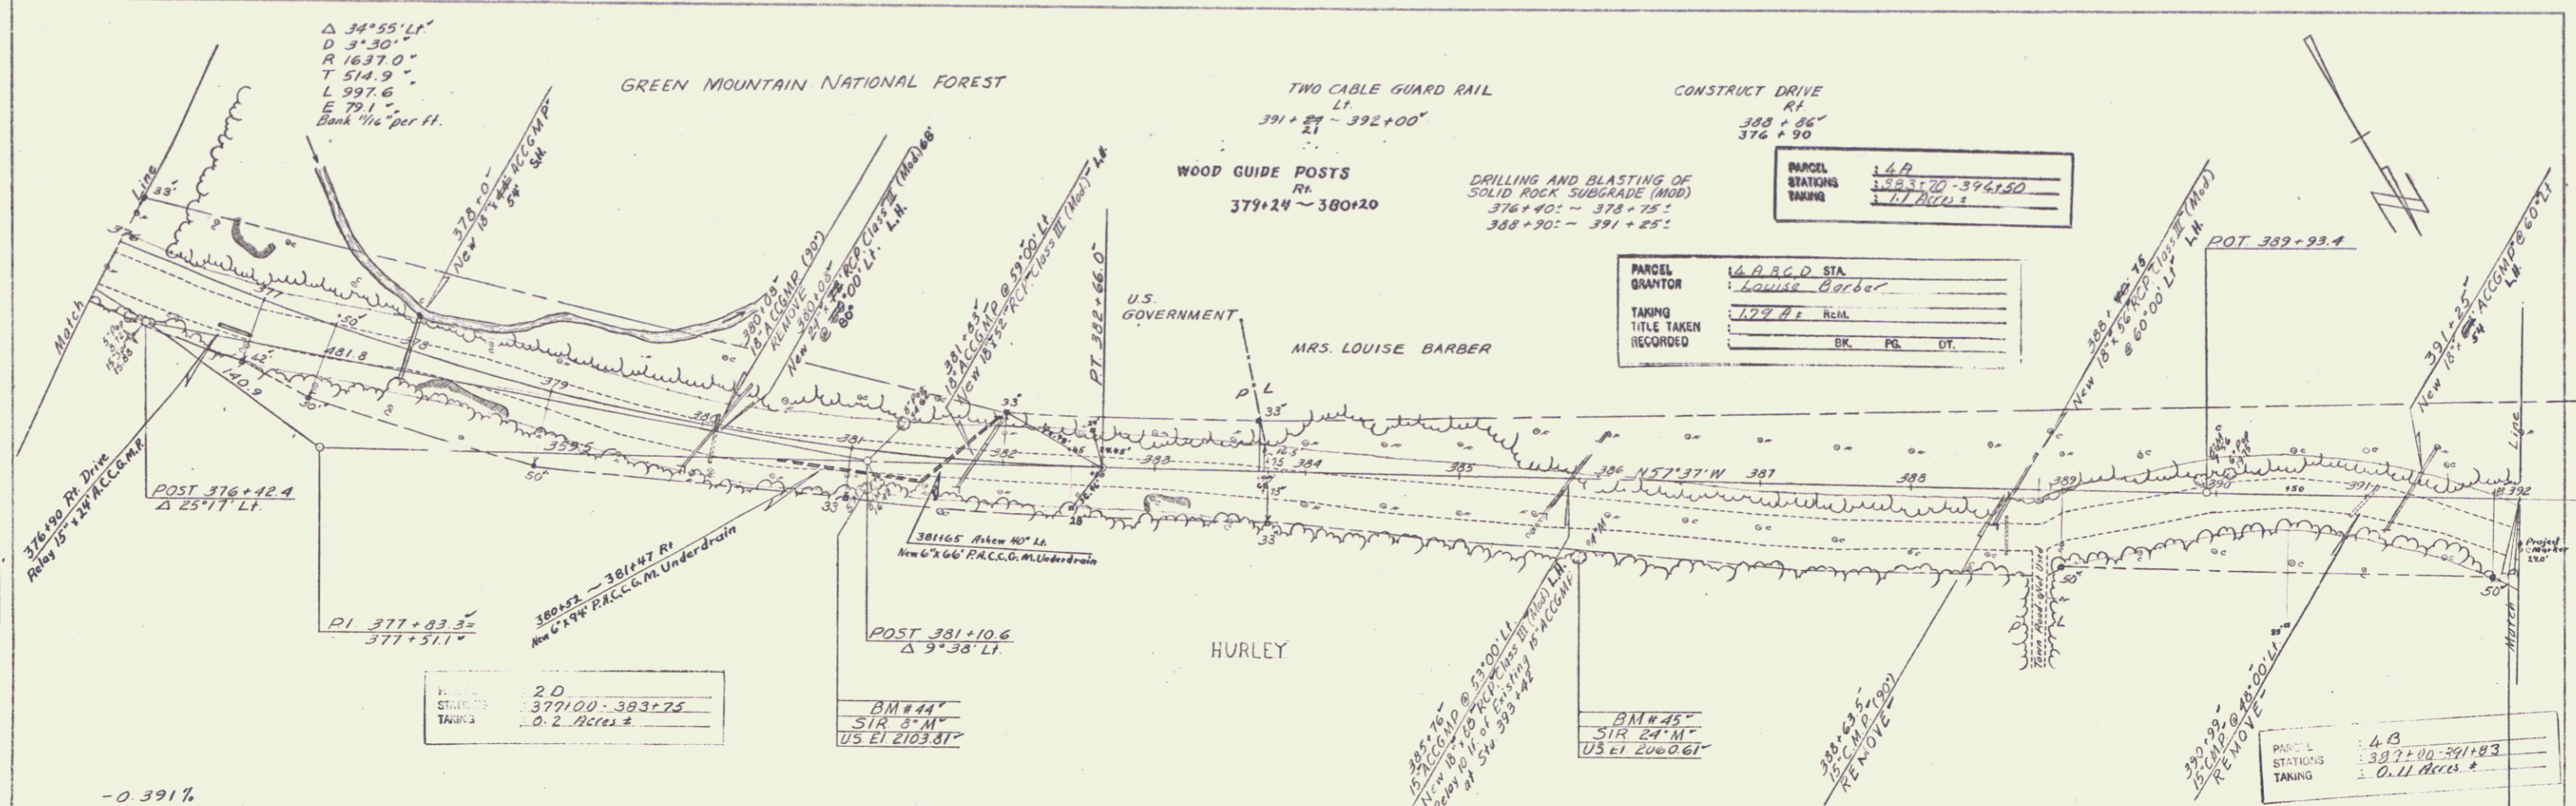

MT. HOLLY
 PROJECT FH-4-1(2)
 SHEET 19 OF 32