
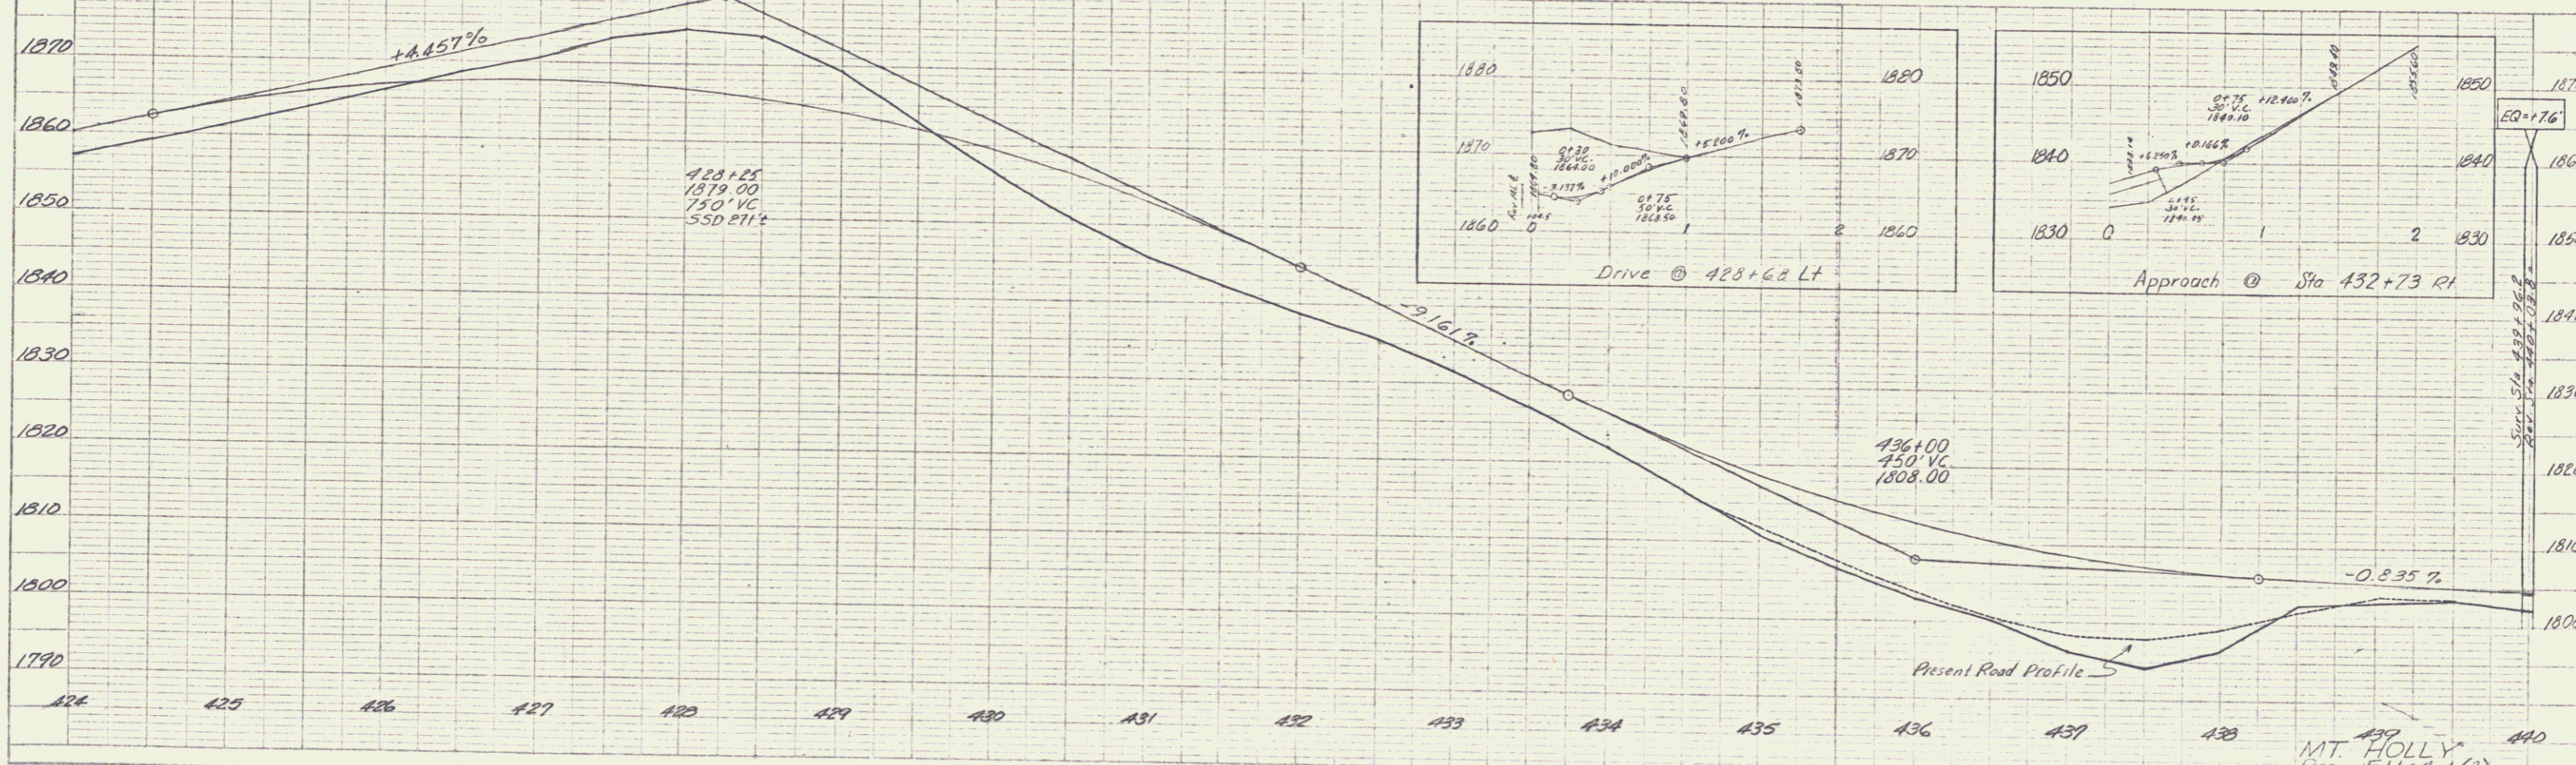


PLAN
 DATE: 1/15/67
 DRAWN BY: [Name]
 CHECKED BY: [Name]
 NO. 1

PROFILE
 DATE: 1/15/67
 DRAWN BY: [Name]
 CHECKED BY: [Name]
 NO. 1

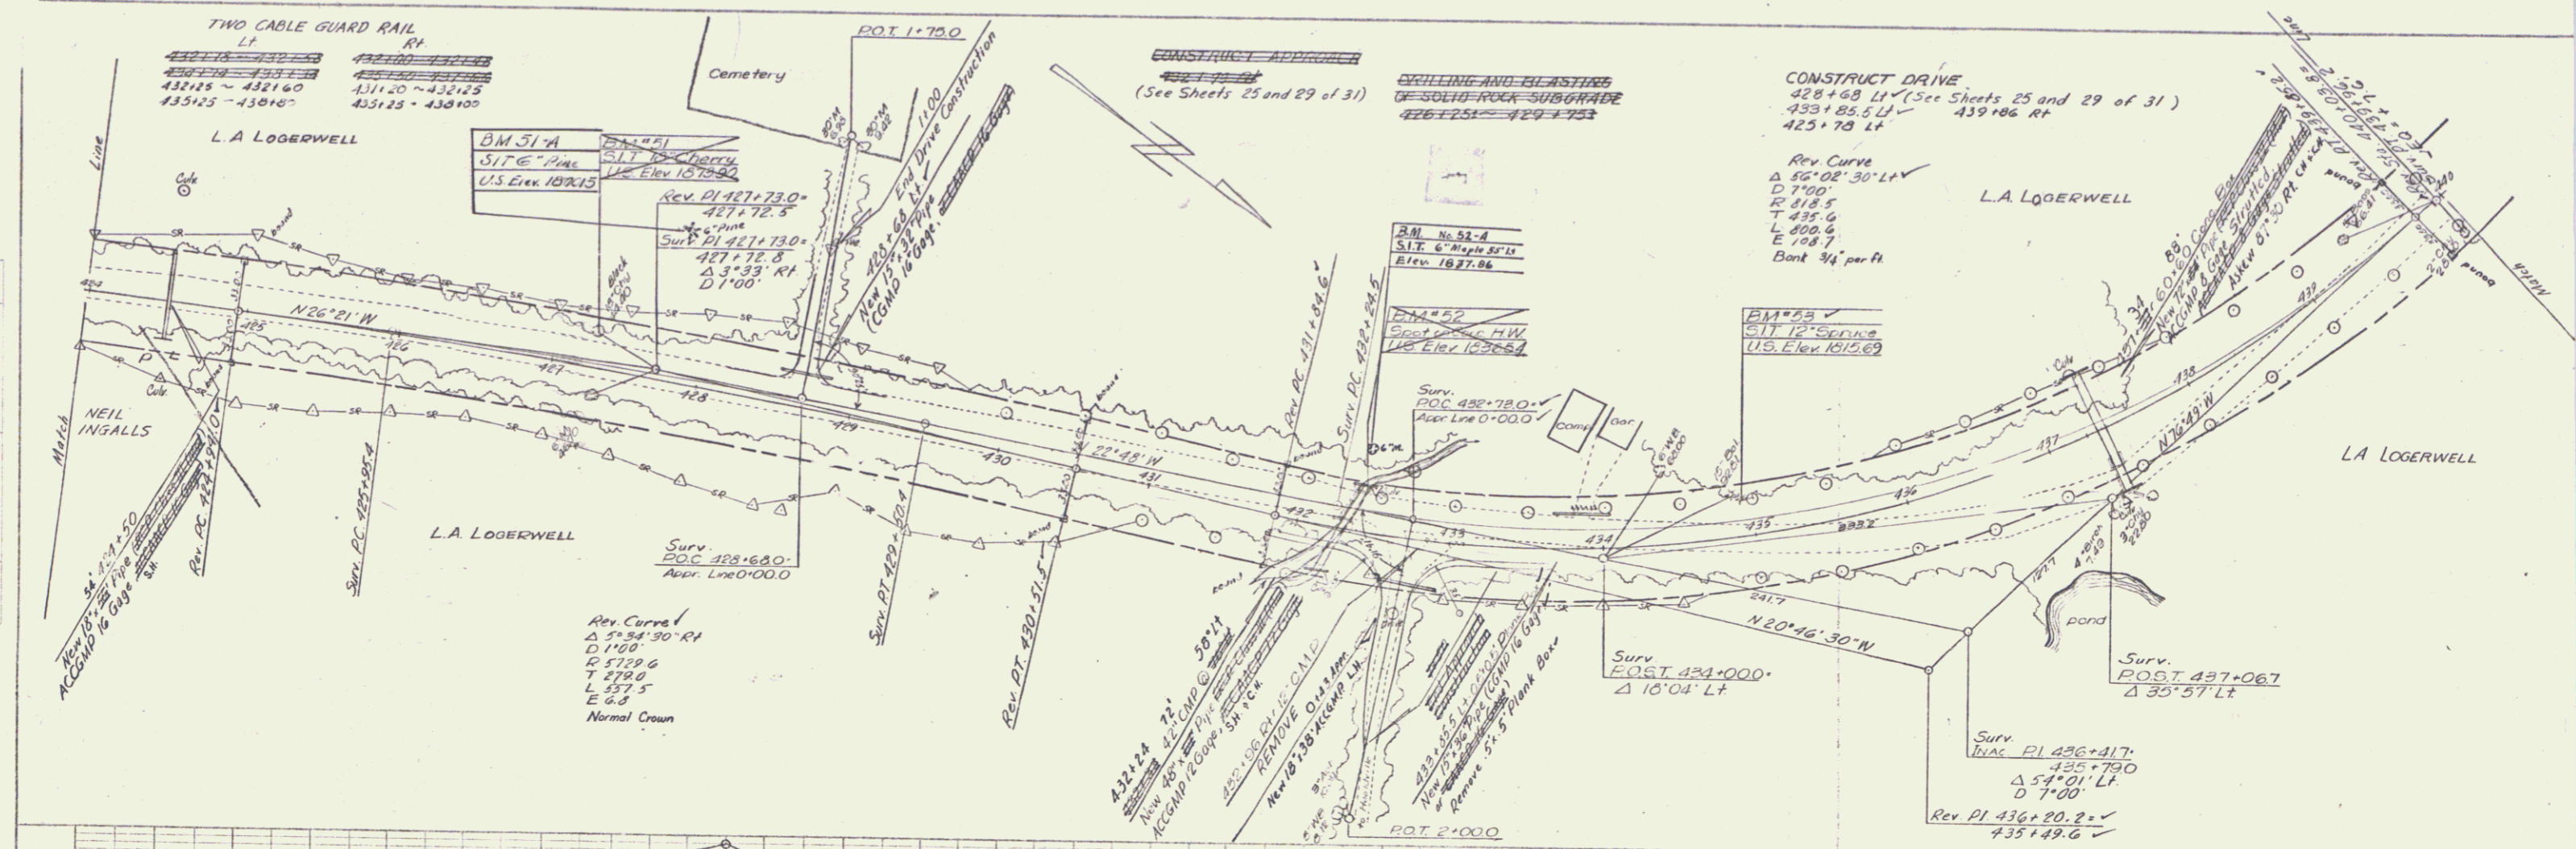

MT HOLLY
 Proj FH-4-1(3)
 Sheet 18 of 31