
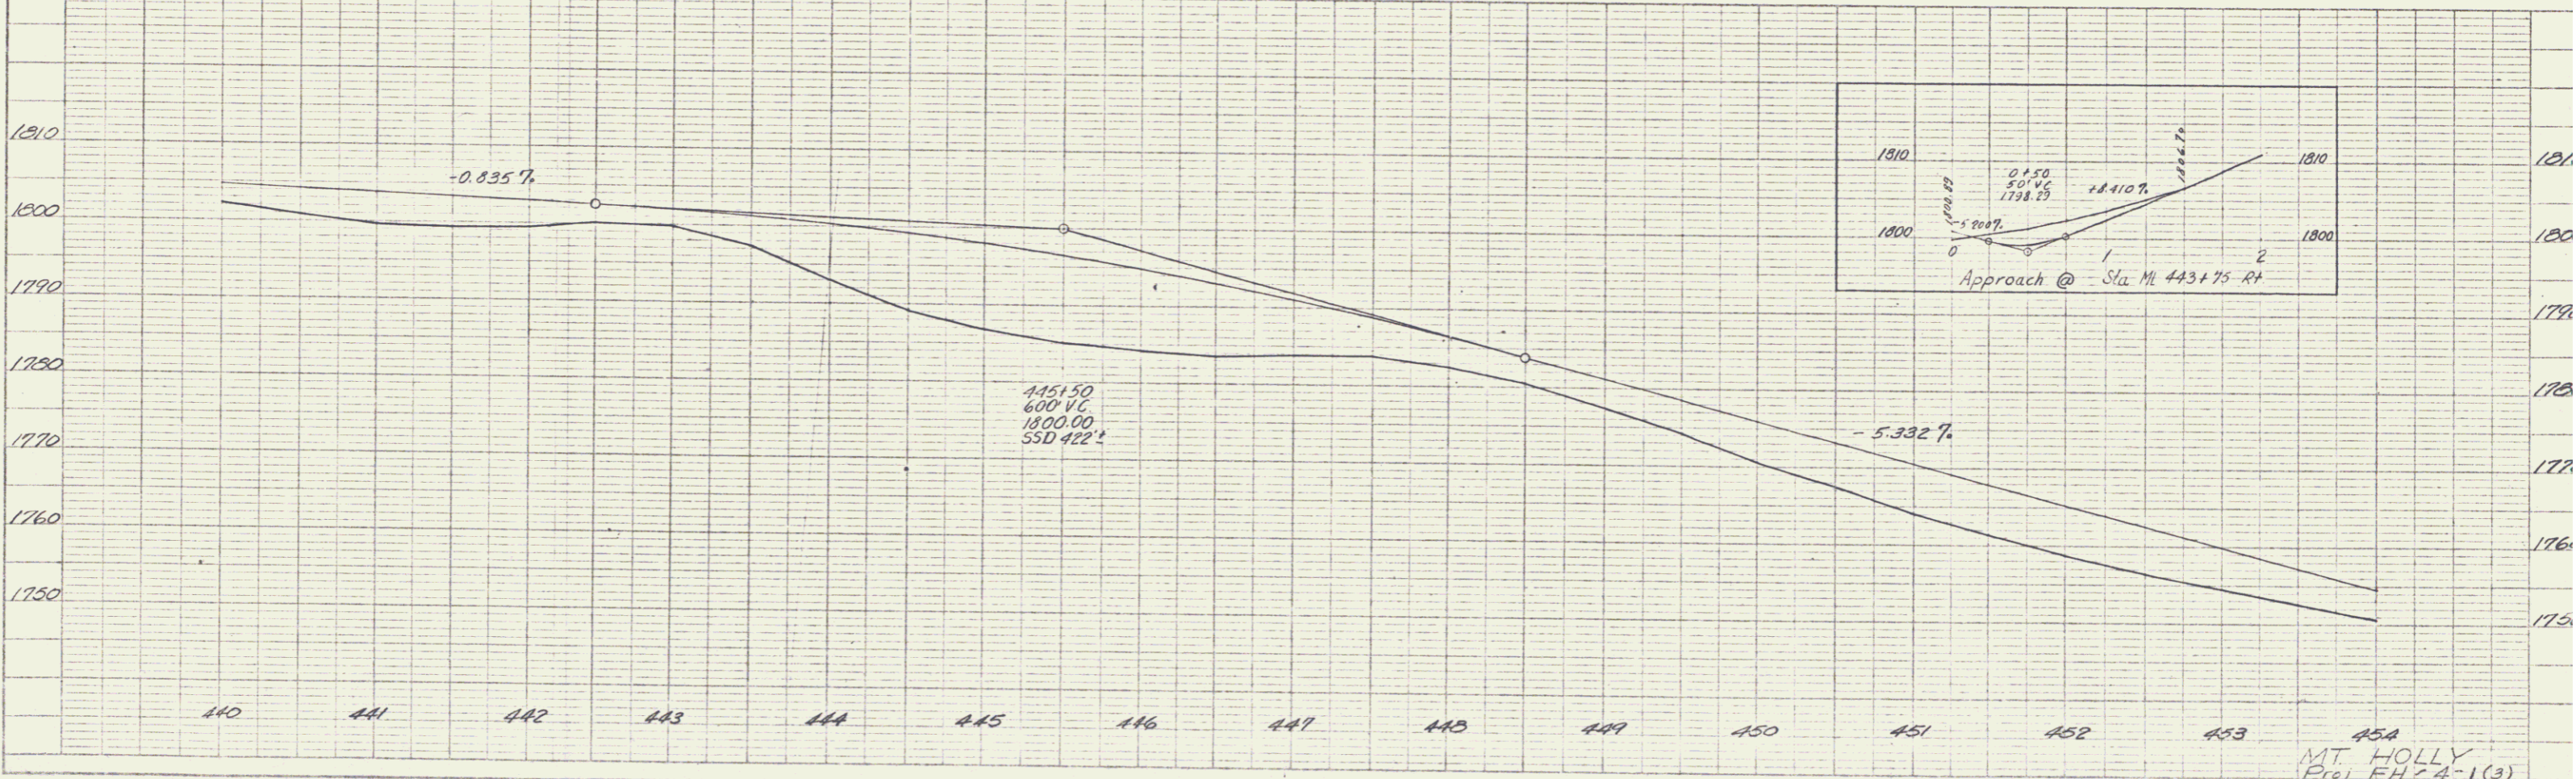


PLAN
 DATE: 5-60
 DRAWN BY: [Signature]
 CHECKED BY: [Signature]
 NO. 1-81

PROFILE
 DATE: 5-60
 DRAWN BY: [Signature]
 CHECKED BY: [Signature]
 NO. 1-81

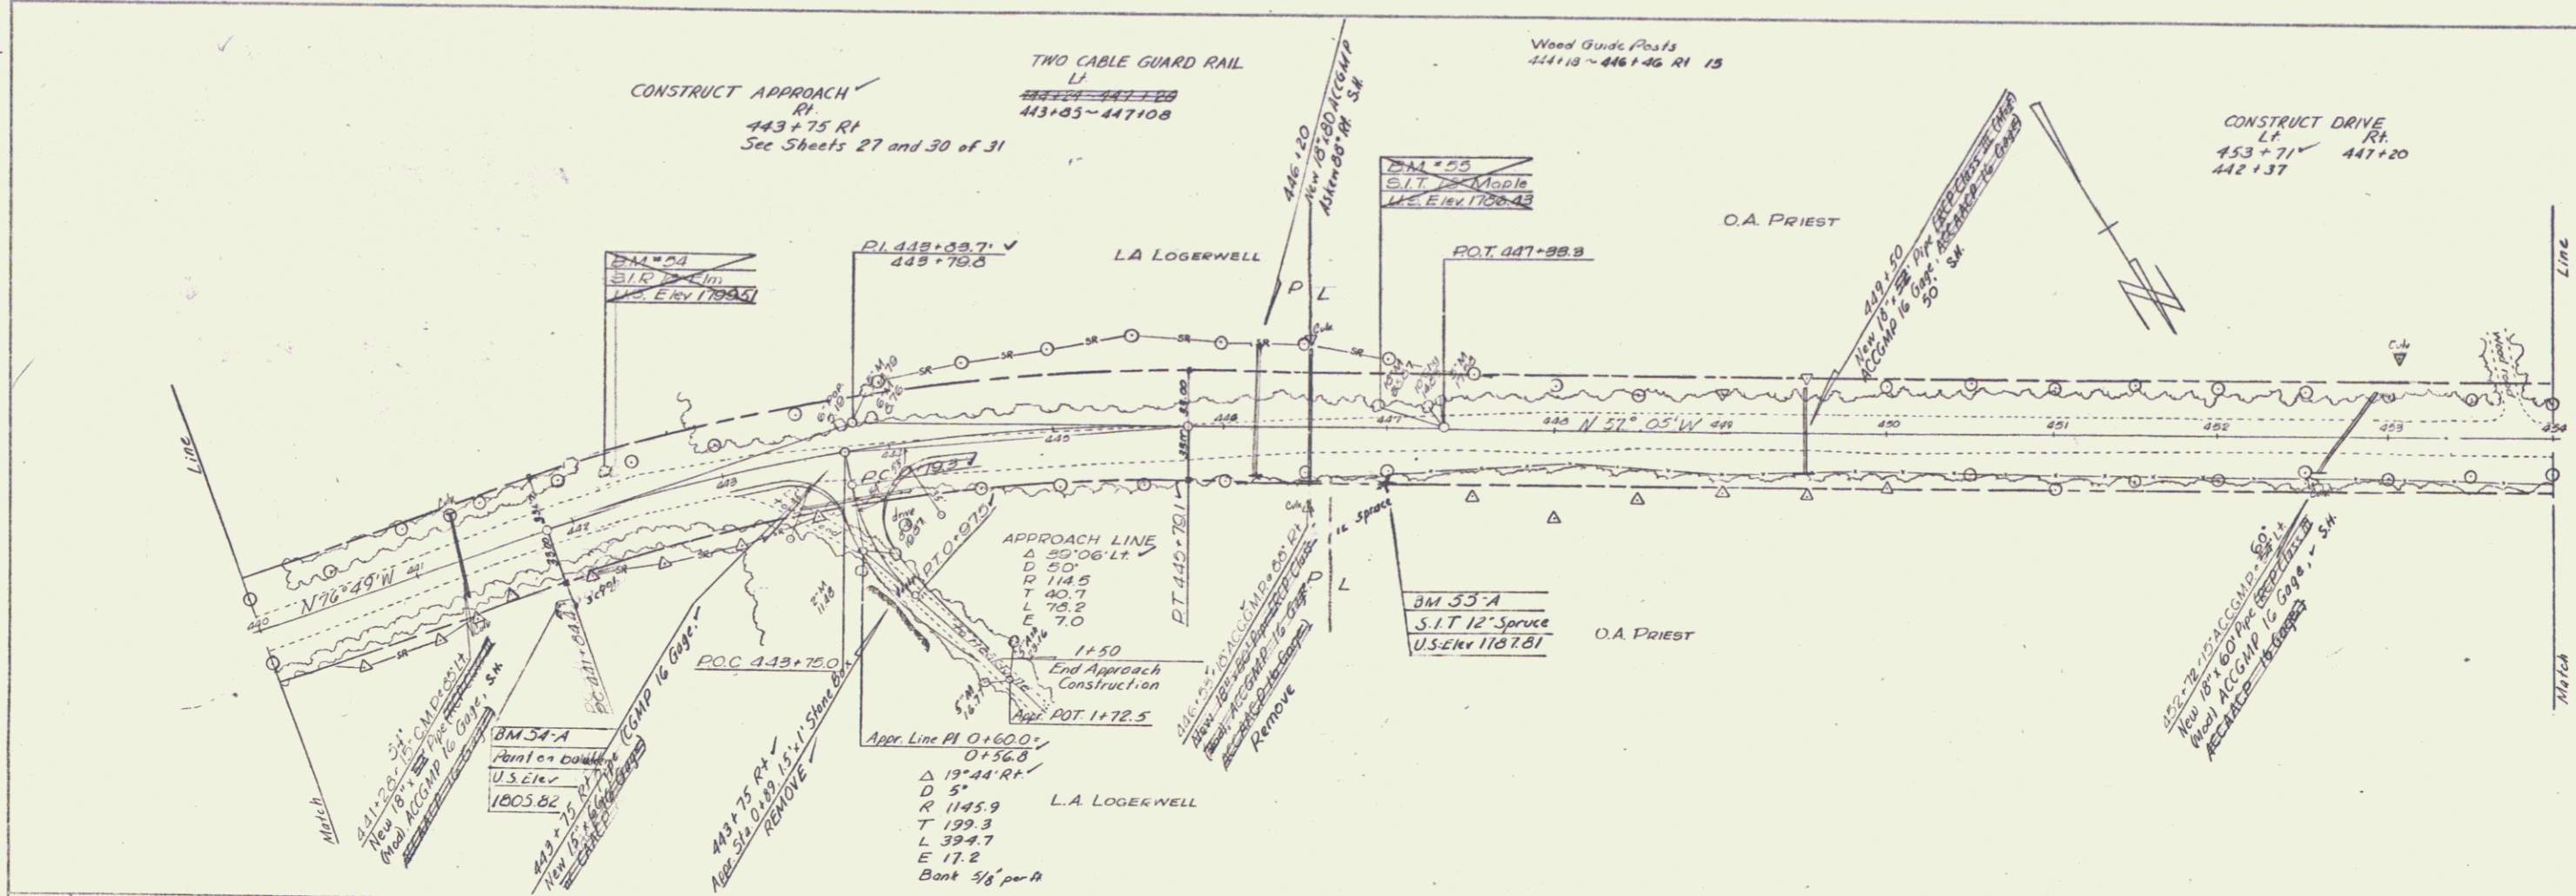

45A
 MT. HOLLY
 Proj. FH-24-1(3)
 Sheet 12 of 31

5