


INDEX OF SHEETS


TITLE PAGE  
 TYPICAL CROSS-SECTION OF IMPROVEMENT  
 QUANTITY SHEET  
 PLAN AND DRAINAGE SHEET  
 NETWORK SHEETS  
 VERTICAL PROFILE SHEETS  
 (SOLID ROCK EXCAVATION) 3-10-65  
 B-1 (BANKING TABLES) 7-17-67R  
 B-5 (TYPICAL SLOPE GRADING) 3-10-65  
 B-6 (MUCK EXCAVATION) 3-10-65  
 B-10 (EMBANKMENT ON A SLOPE) 3-10-65  
 B-11 (UNDERDRAIN WITH SHATTERED ROCK SUBGRADE) 3-10-65  
 D-1 (DROP INLET-TYPE 1-B) 8-1-66R  
 D-2 (HEADWALLS, UNDERDRAIN) 7-25-67R  
 D-4 (UNDERDRAIN FLUSHING BASIN) 8-1-66R  
 E-32 (ROAD CONSTRUCTION APPROACH SIGNS) 1-6-67  
 E-34 (ON-PROJECT CONSTRUCTION SIGNS) 5-3-67R  
 G-2A (TWO CABLE GUARD RAIL WITH ANCHORS) 3-10-65  
 G-4 (MARKER POSTS AND GUIDE POSTS) 12-30-65R  
 J-1 (PROJECT MARKERS) 3-10-65  
 27 DETAILS OF C.G.M.P.P. ARCH AT STA. 500+70  
 28-39. CROSS SECTIONS  
 40-41. CHANNEL SECTIONS  
 \* 21-A E-31 (FEDERAL AID CONSTRUCTION IDENTIFICATION SIGNS) 8-28-67

STATE OF VERMONT  
 DEPARTMENT OF HIGHWAYS  
**PROPOSED IMPROVEMENT**

FOREST HIGHWAY PROJECT  
**TOWN OF MOUNT HOLLY**  
**COUNTY OF RUTLAND**  
**VERMONT ROUTE #155 (STATE AID ROUTE #2)**  
**WESTON - WALLINGFORD ROAD**  
 BEGINNING AT A POINT 2.532 MILES NORTHWESTERLY  
 OF THE WESTON - MOUNT HOLLY TOWN LINE AND  
 EXTENDING NORTHWESTERLY 1.552 MILES  
 LENGTH OF ROADWAY : 8,172.92 FEET = 1.548 MILES  
 LENGTH OF BRIDGE : 21.68 FEET = 0.004 MILE  
 LENGTH OF PROJECT : 8,194.60 FEET = 1.552 MILES

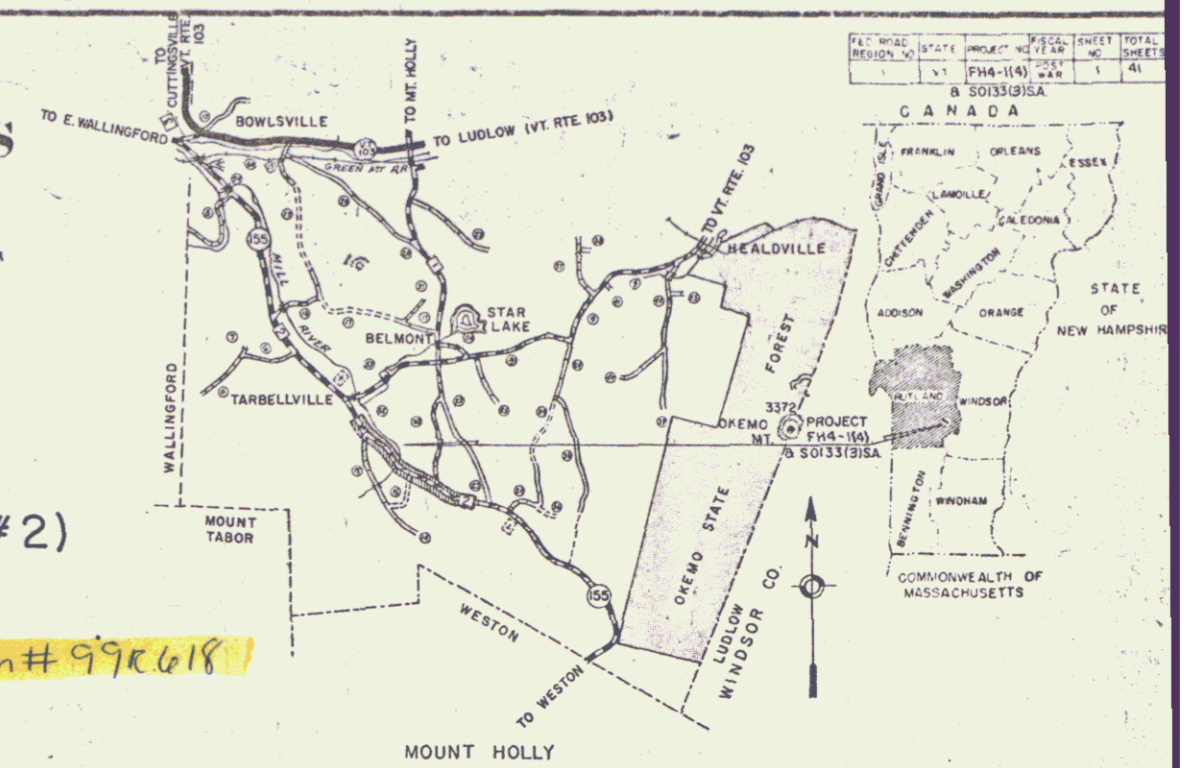

BENCH MARK DATA BASED ON U.S.G.S. ELEVATIONS

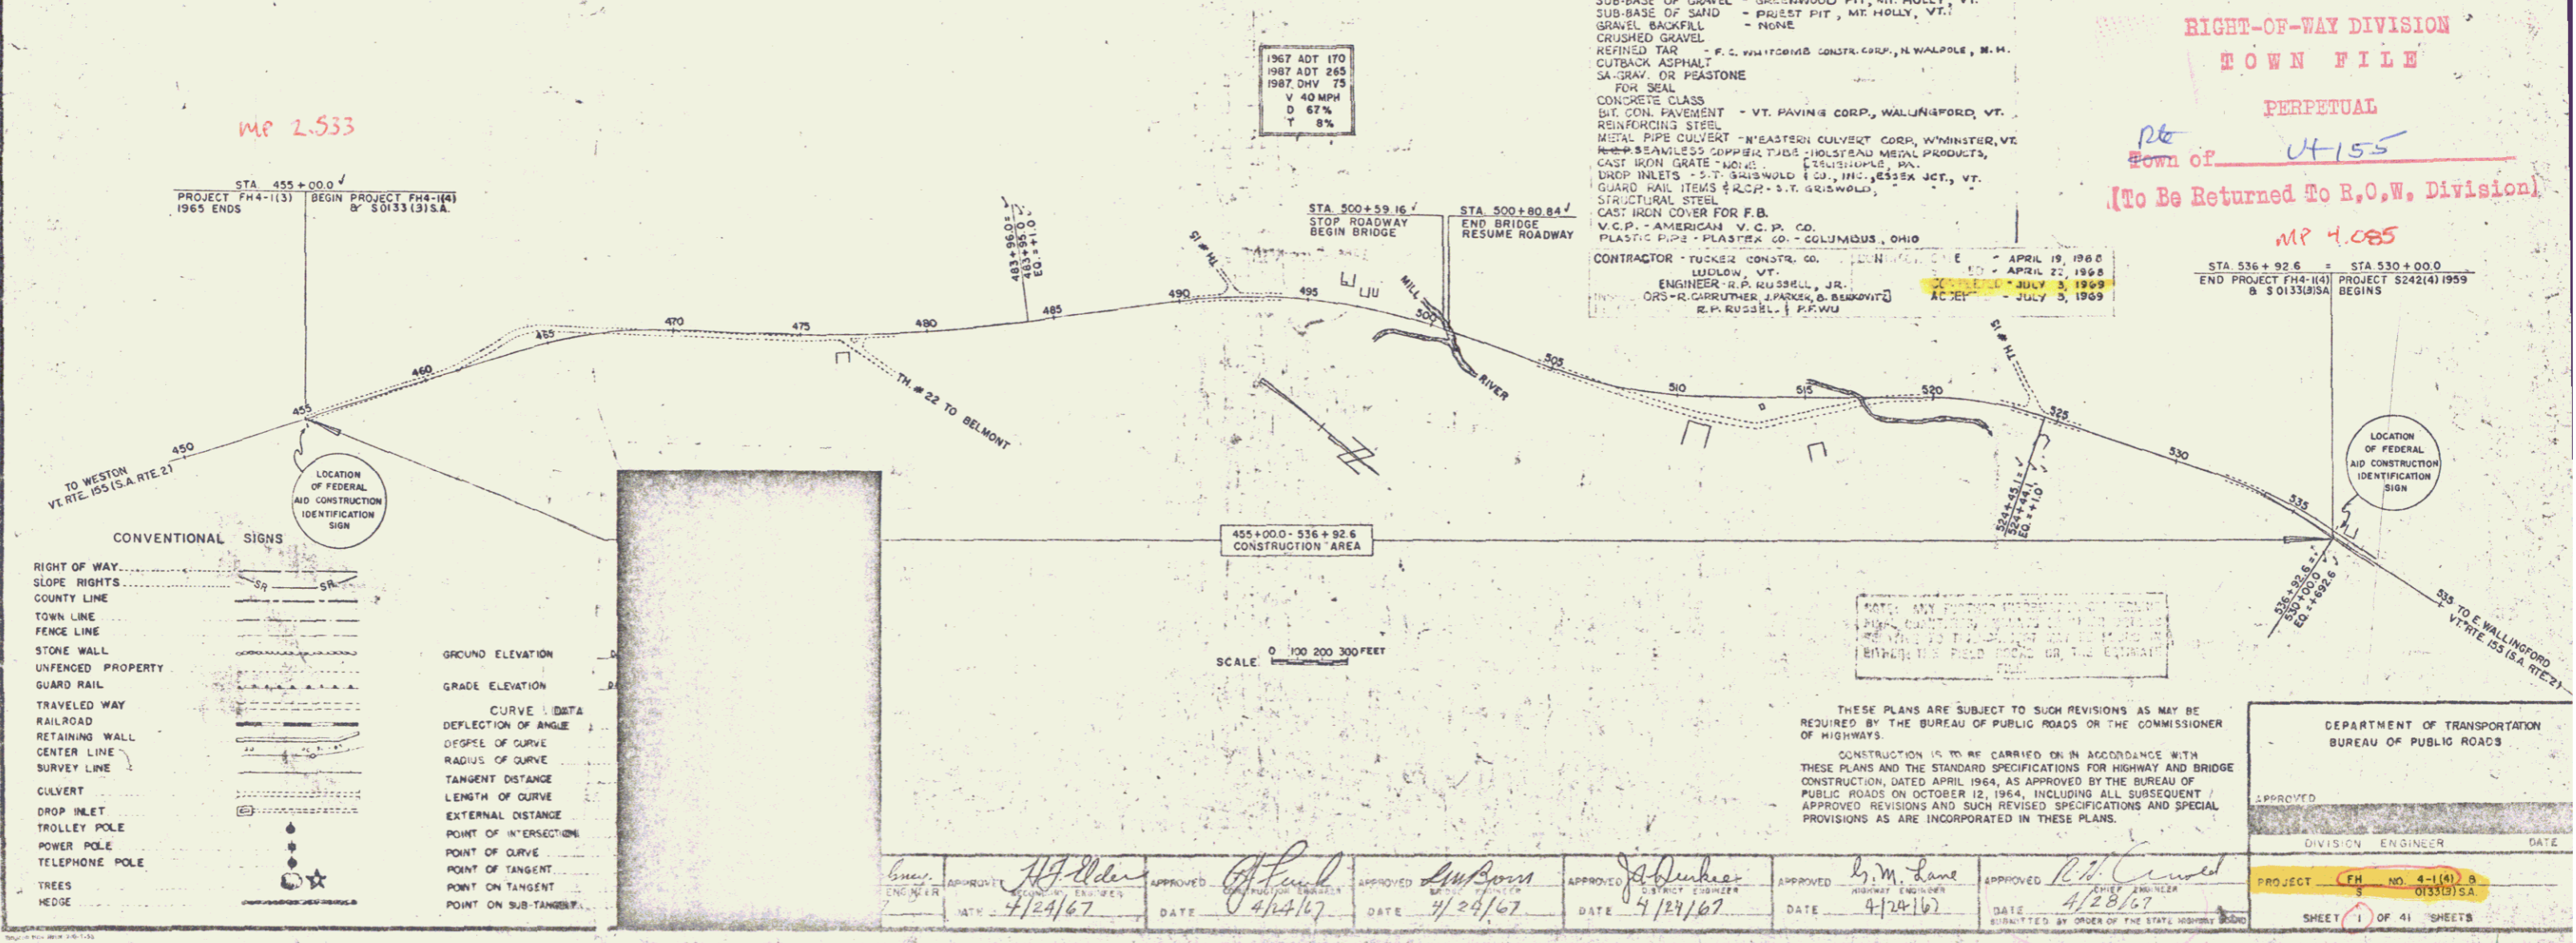

CONVENTIONAL SIGNS

RIGHT OF WAY	GROUND ELEVATION
SLOPE RIGHTS	GRADE ELEVATION
COUNTY LINE	CURVE DATA
TOWN LINE	DEFLECTION OF ANGLE
FENCE LINE	DEGREE OF CURVE
STONE WALL	RADIUS OF CURVE
UNFENCED PROPERTY	TANGENT DISTANCE
GUARD RAIL	LENGTH OF CURVE
TRAVELED WAY	EXTERNAL DISTANCE
RAILROAD	POINT OF INTERSECTION
RETAINING WALL	POINT OF CURVE
CENTER LINE	POINT OF TANGENT
SURVEY LINE	POINT ON TANGENT
CULVERT	POINT ON SUB-TANGENT
DROP INLET	
TROLLEY POLE	
POWER POLE	
TELEPHONE POLE	
TREES	
HEDGE	

MATERIALS  
 RECORD PLANS  
 SUB-BASE OF GRAVEL - GREENWOOD PIT, MT. HOLLY, VT.  
 SUB-BASE OF SAND - PROJECT PIT, MT. HOLLY, VT.  
 GRAVEL BACKFILL - NONE  
 CRUSHED GRAVEL - NONE  
 REFINED TAR - F. C. WATSON & SONS, CONTS. CO., N. WALPOLE, N. H.  
 CUTBACK ASPHALT - NONE  
 SAND OR PEASTONE - NONE  
 FOR SEAL  
 CONCRETE CLASS - NONE  
 BIT. CON. PAVEMENT - VT. PAVING CORP., WALLINGFORD, VT.  
 REINFORCING STEEL - NONE  
 METAL PIPE CULVERT - WEAVER CULVERT CORP., WMINSTER, VT.  
 NON-SEAMLESS COPPER TUBES - HOLLISTON METAL PRODUCTS, WINDHAM, VT.  
 CAST IRON GRATE - NONE  
 DROP INLETS - S. T. SAUNDERS & CO., INC., ESSEX JCT., VT.  
 GUARD RAIL IRON PIPE - S. T. SAUNDERS & CO., INC., ESSEX JCT., VT.  
 STRUCTURAL STEEL - NONE  
 CAST IRON COVER FOR F.B. - NONE  
 V.C.P. - AMERICAN V.C.P. CO. - COLUMBIUS, OHIO  
 PLASTIC PIPE - PLASTEX CO. - COLUMBIUS, OHIO  
 CONTRACTOR - TUCKER CONSTR. CO., LUDLOW, VT.  
 ENGINEER - R. P. RUSSELL, JR., RUTLAND, VT.  
 COR.-R. GARRUTHER, J. PARKER, D. BERKOWITZ, R. P. RUSSELL, J. P. WU

RIGHT-OF-WAY DIVISION  
 TOWN FILE  
 PERPETUAL  
 Town of MT HOLLY  
 (To Be Returned To R.O.W. Division)

APPROVED DATE 4/24/67	APPROVED DATE 4/24/67	APPROVED DATE 4/24/67	APPROVED DATE 4/24/67	APPROVED DATE 4/24/67	APPROVED DATE 4/28/67
--------------------------	--------------------------	--------------------------	--------------------------	--------------------------	--------------------------

DEPARTMENT OF TRANSPORTATION  
 BUREAU OF PUBLIC ROADS  
 APPROVED  
 DIVISION ENGINEER  
 DATE  
 PROJECT - CH. NO. 4-1(4) B  
 01331915A  
 SHEET 1 OF 41 SHEETS