



NOTE: DRIVES ARE TO BE CONSTRUCTED WITH A MINIMUM WIDTH OF 12 FEET AND A FLARE RADIUS OF AT LEAST 15 FEET

TWO CABLE GUARD RAIL

CONSTRUCT DRIVE

LT. 458+24 - 461+28
458+00 - 46+25

LT. 469+51.5 - 466+50
466+00 - 462+25
468+95 - 469+75

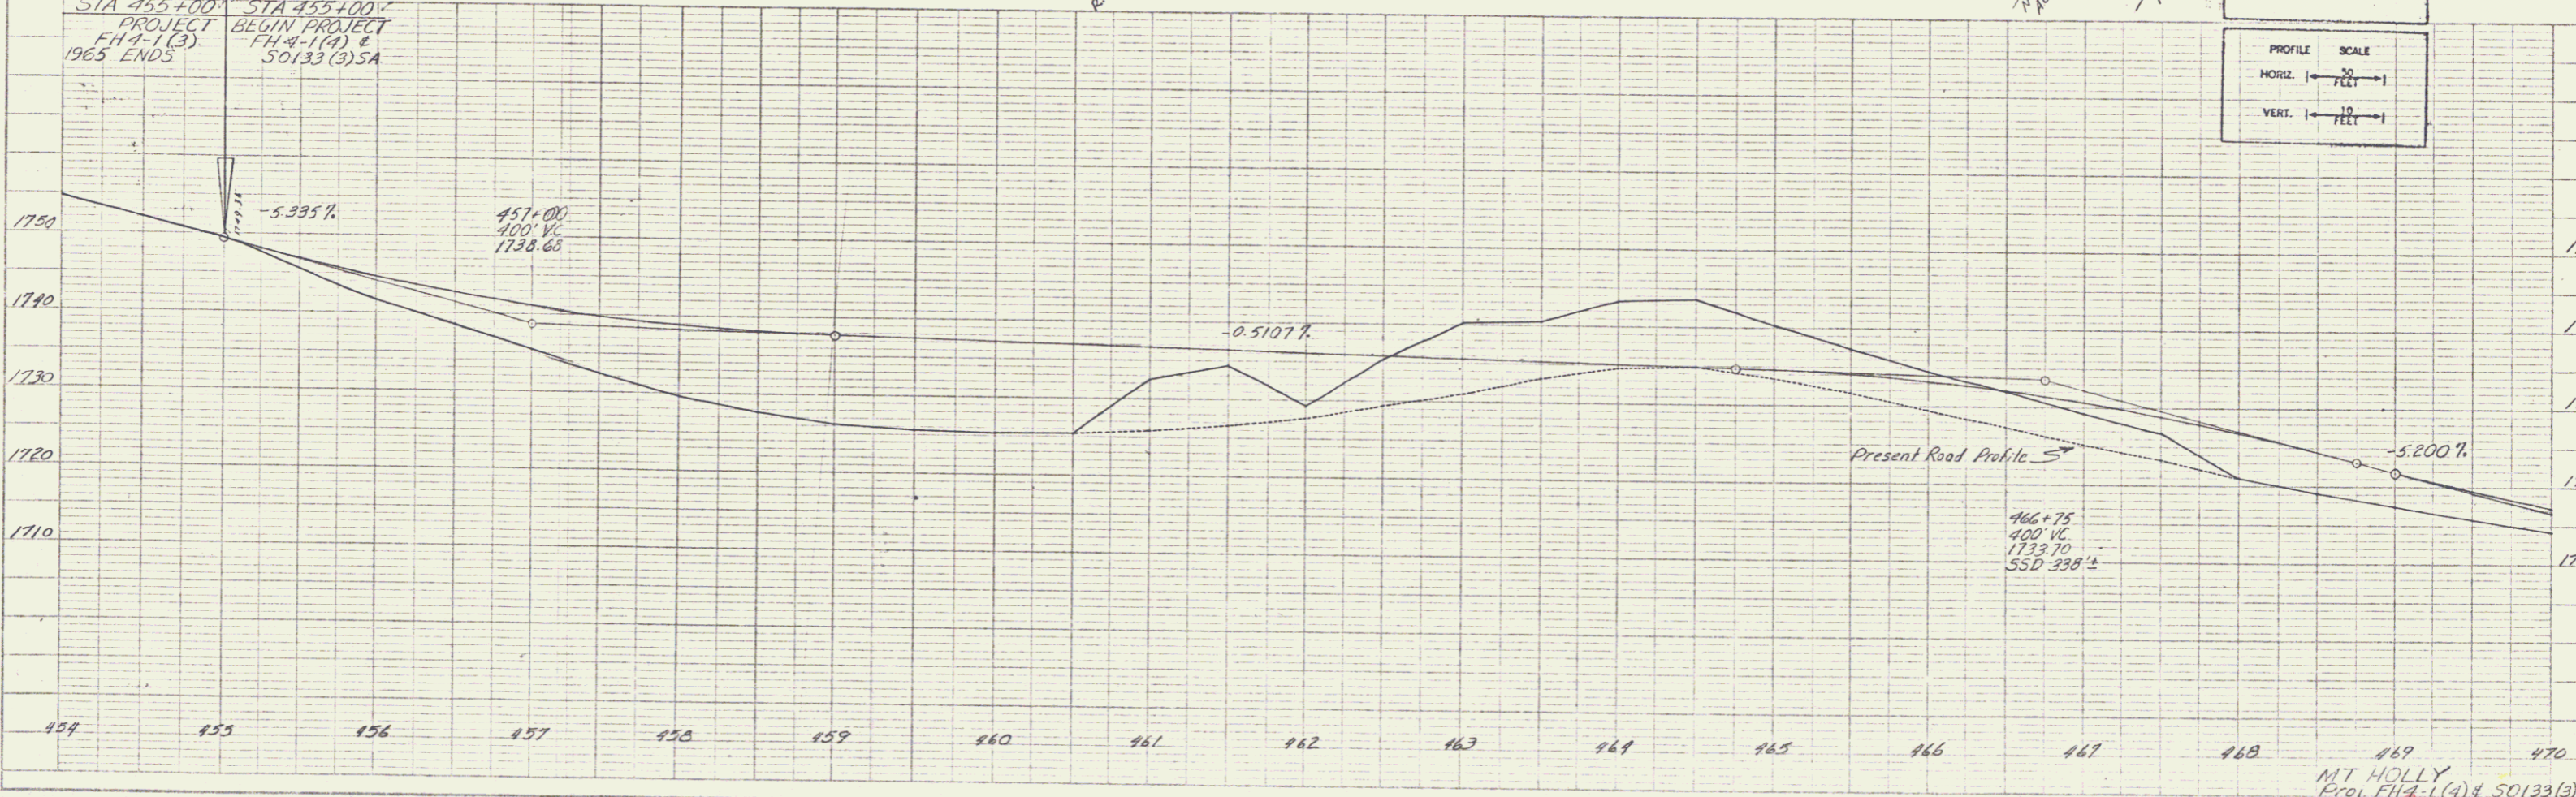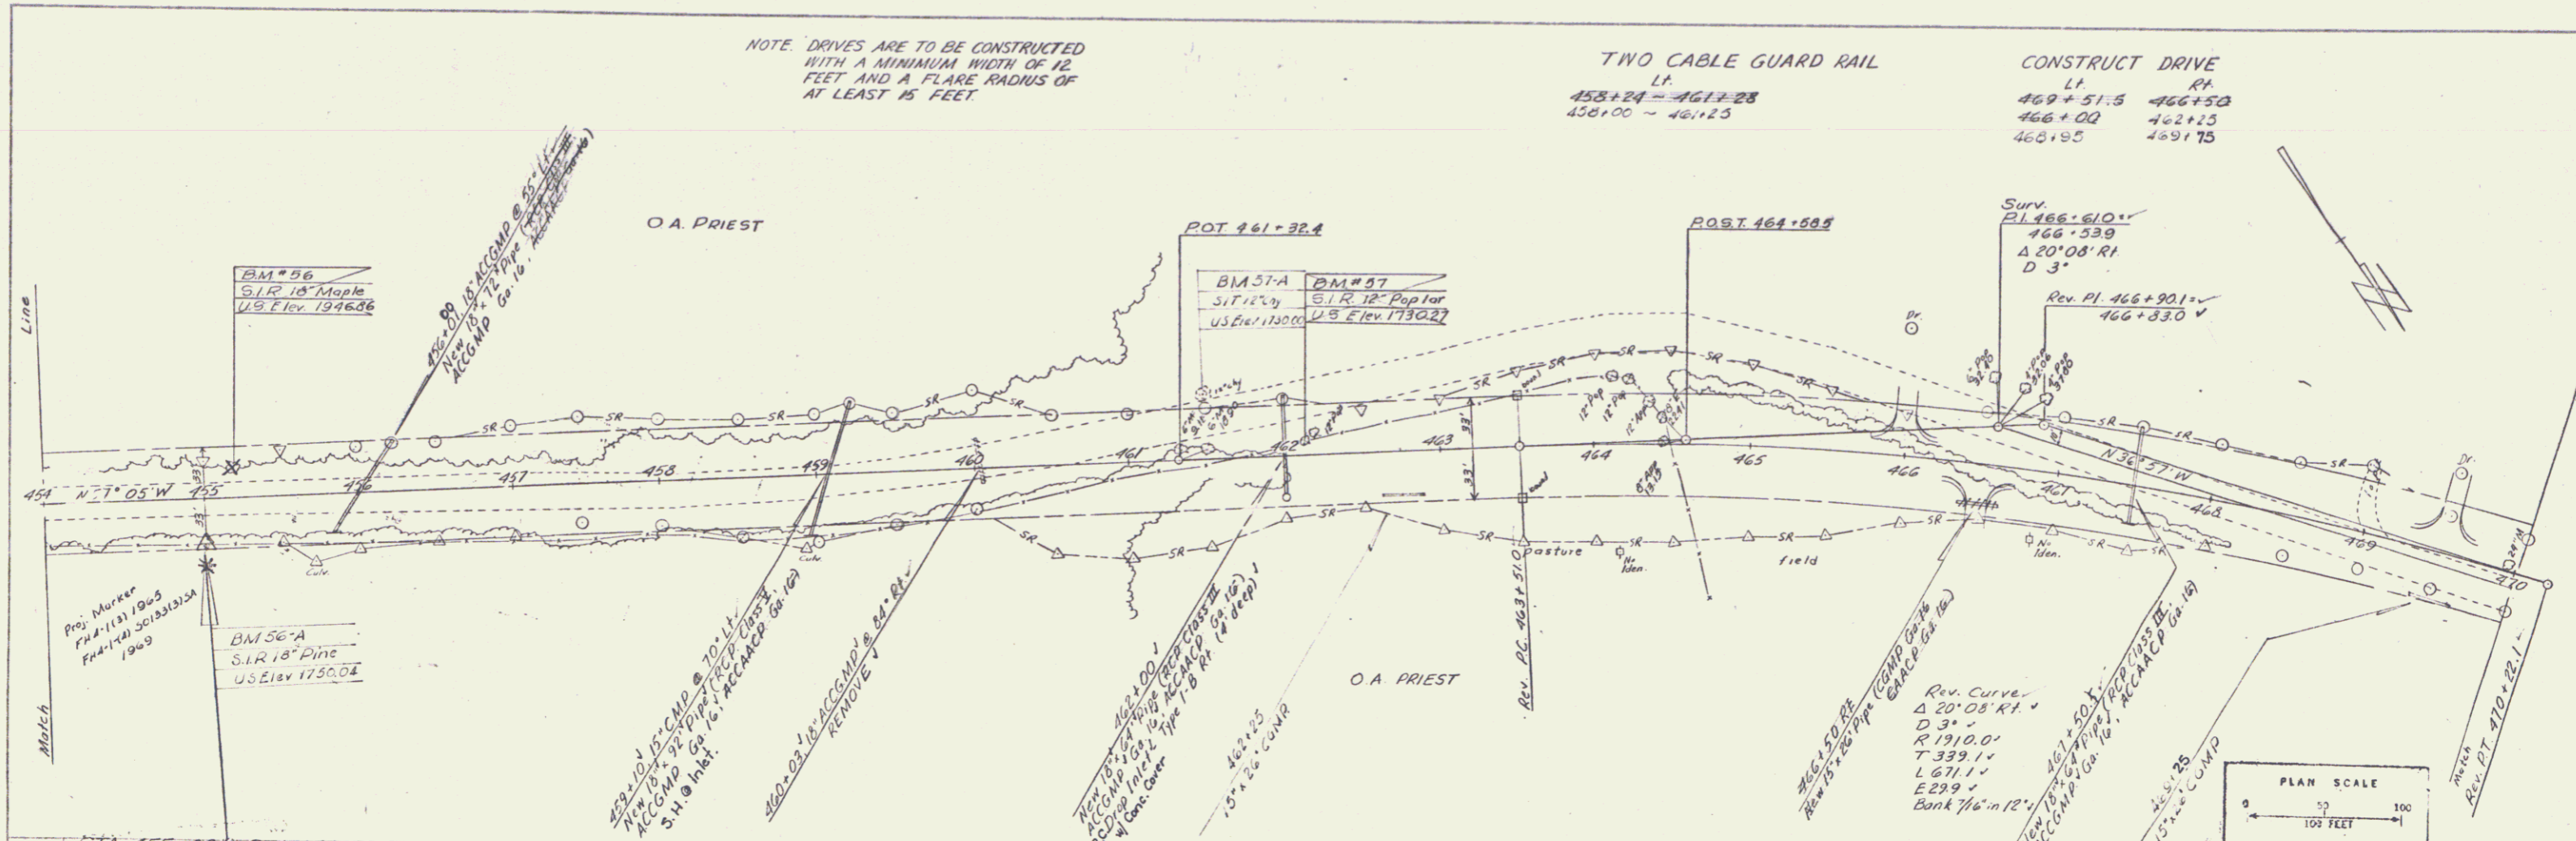

PLAN
DATE: 11/11/05
PROJECT: FH 4-1(3)
1965 ENDS

PROFILE
DATE: 11/11/05
PROJECT: FH 4-1(3)
1965 ENDS

PLAN SCALE
0 50 100 FEET

PROFILE SCALE
HORIZ. 1" = 50 FEET
VERT. 1" = 10 FEET

MT HOLLY
Proj. FH 4-1(4) & 50133(3)S
Sheet 7 of 41