
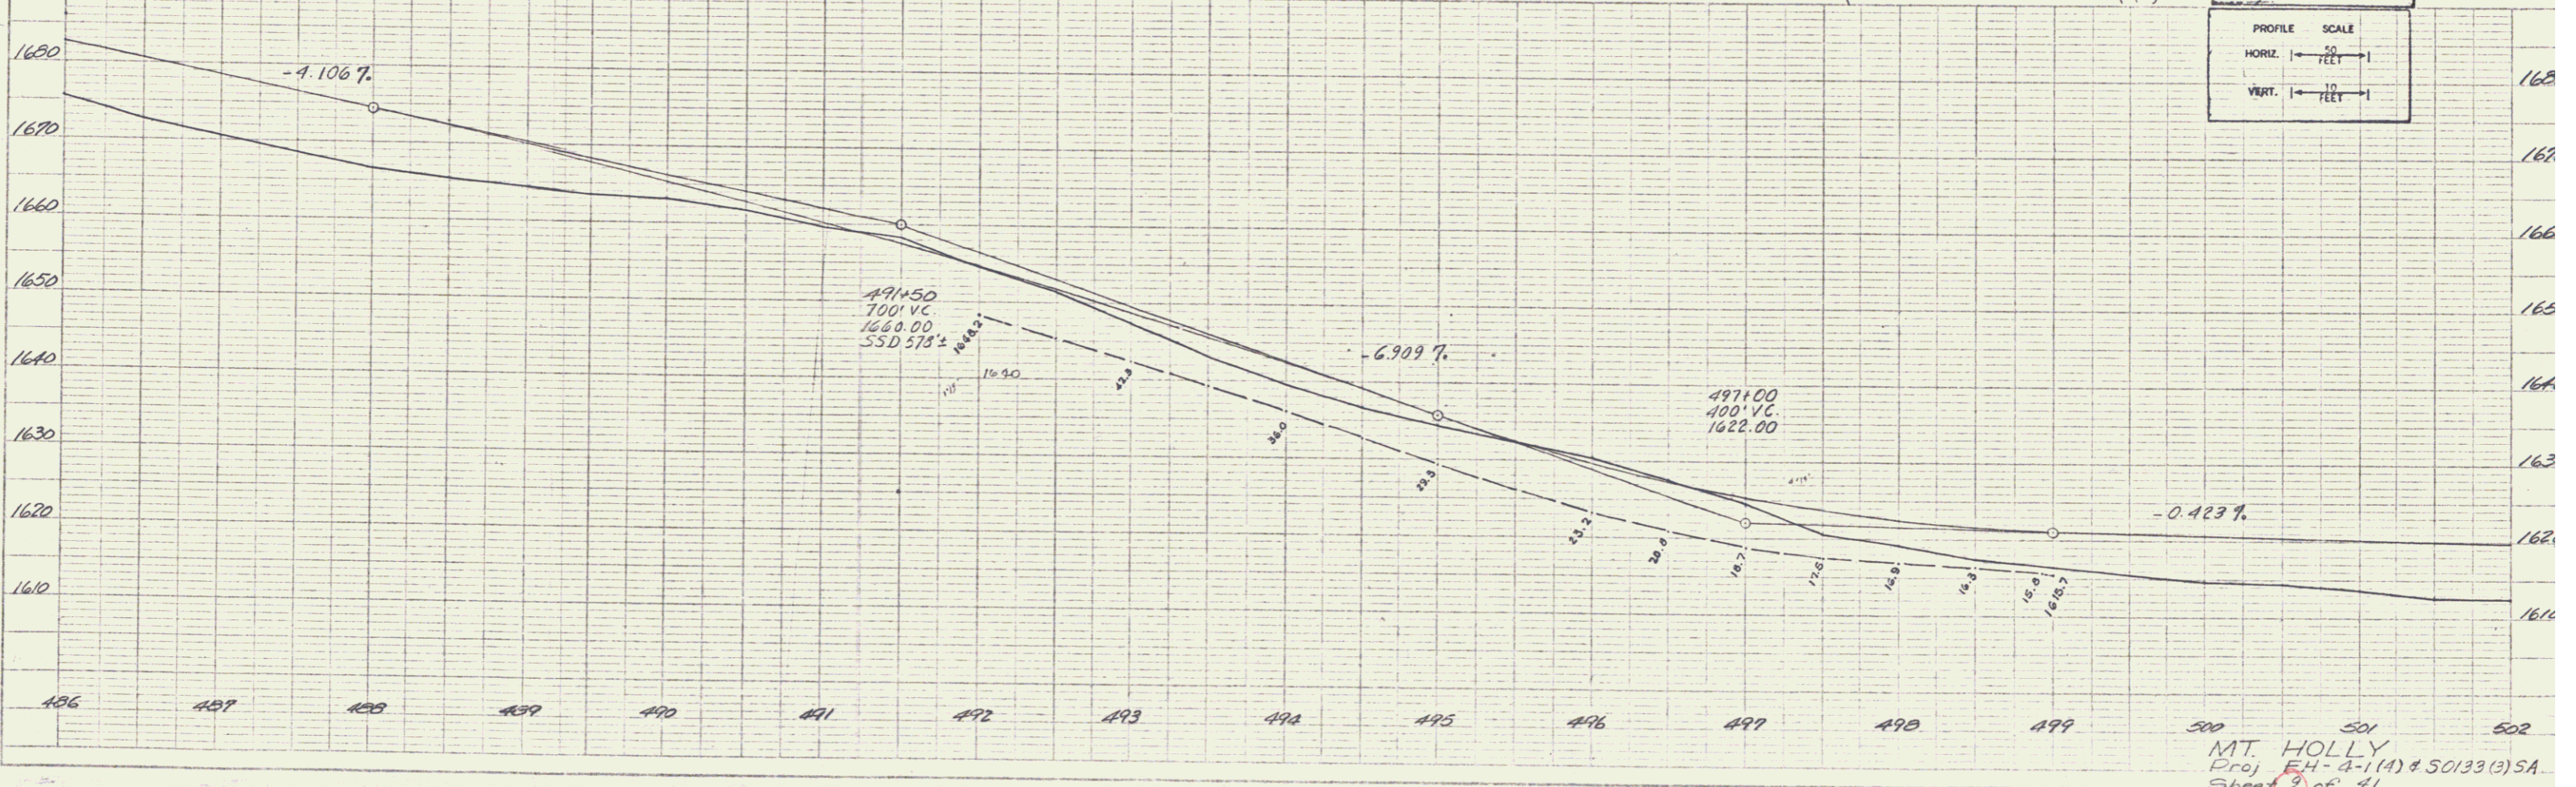


PLAN
 DATE: 0-69
 DRAWN BY: Spaulding
 CHECKED BY: Loumar
 PROJECT: 50133(3) SA

PROFILE
 DATE: 0-69
 DRAWN BY: A.B. Higuera
 CHECKED BY: RAK
 PROJECT: 50133(3) SA

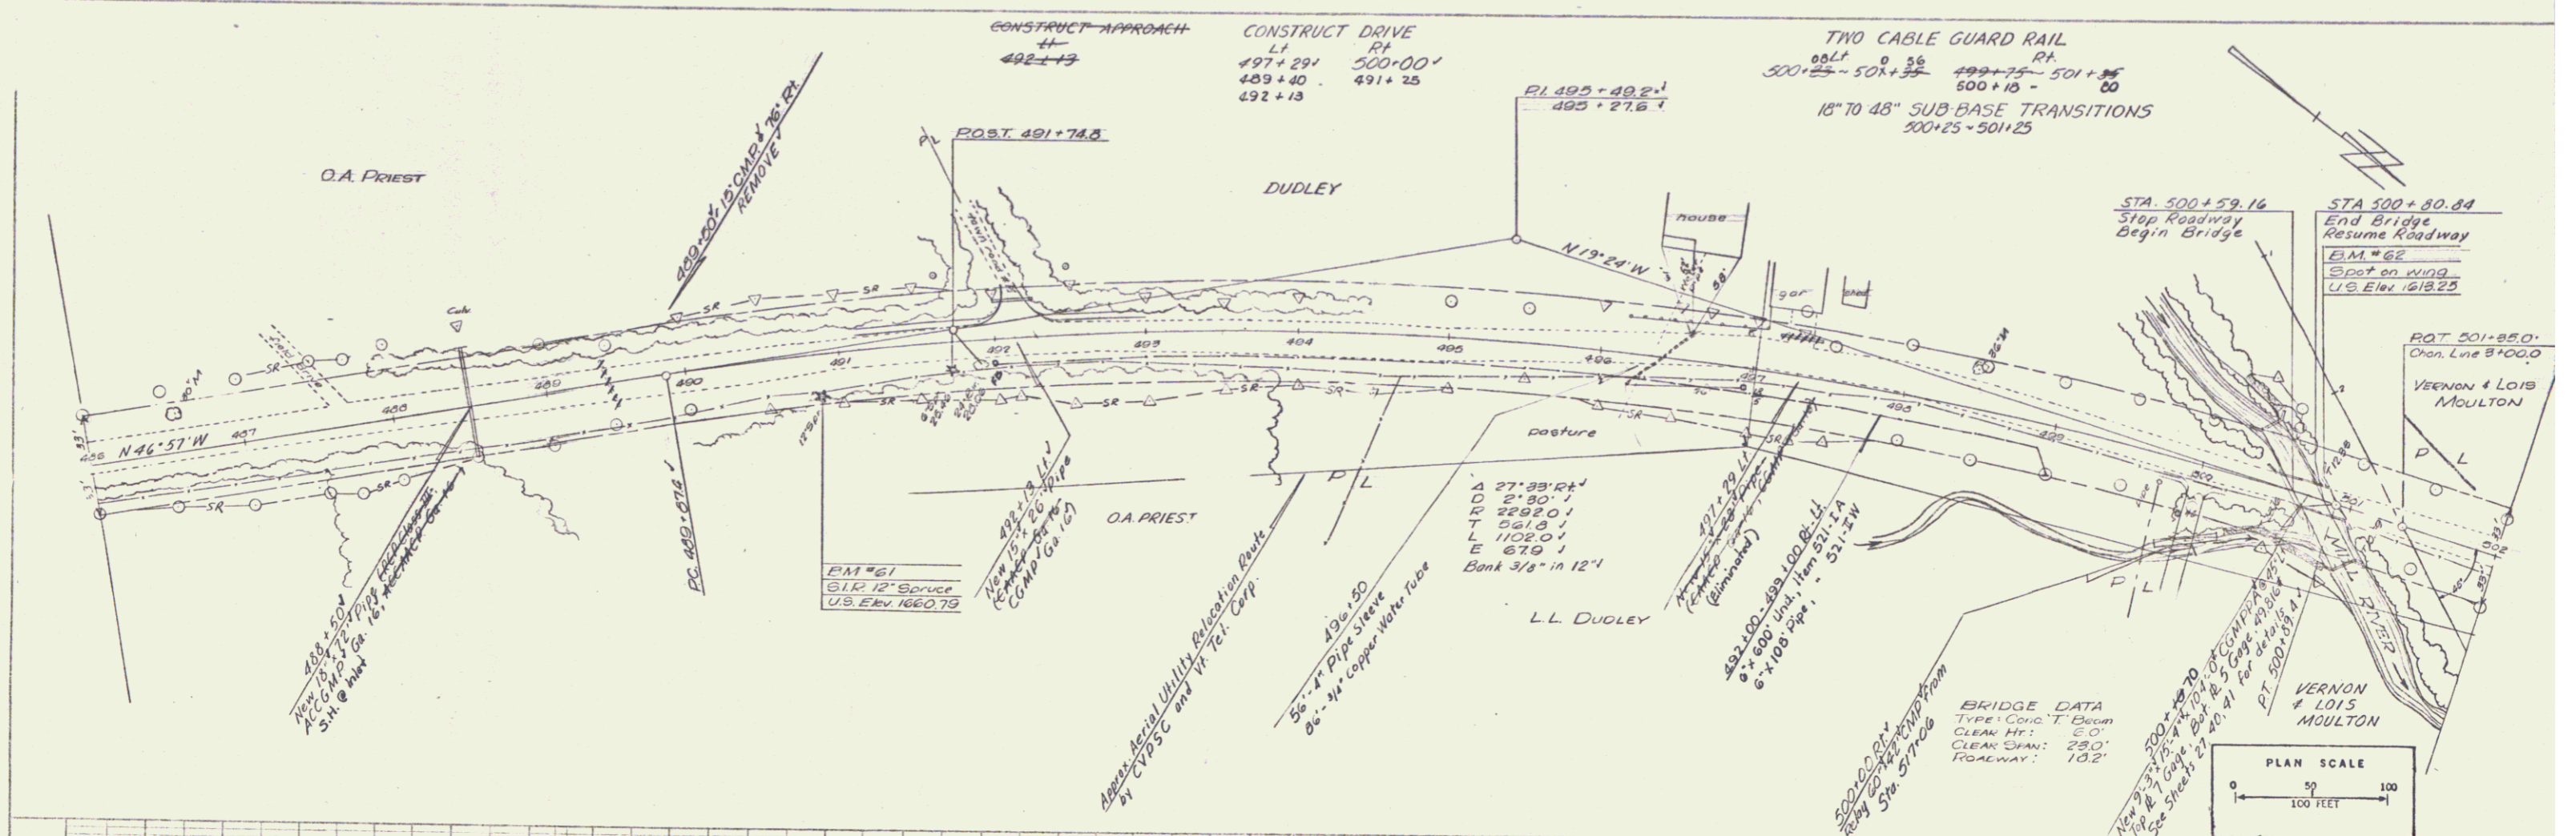

PLAN SCALE
 0 50 100 FEET

PROFILE SCALE
 HORIZ. 1" = 20 FEET
 VERT. 1" = 10 FEET

MT. HOLLY
 Proj. 50133(3) SA
 Sheet 3 of 41