

INDEX OF SHEETS

SHEET NO.	TITLE PAGE
2	TYPICAL CROSS-SECTION OF IMPROVEMENT
3	PARKING AND WIDENING BW NO.1
4	QUANTITY SHEET
5	ITEM AND DRAINAGE SHEETS
6-9	EARTHWORK SHEETS
10	CONSTRUCTION DETAILS RS-56-3(MARKERS AND WOODSIDE POSTS)
11	CONSTRUCTION DETAILS RS-56-4(DRAINAGE)
12	STANDARD STRUCTURE SHEET RS-56-10(TWO CABLE BRD RAIL)
13	STANDARD STRUCTURE SHEET RS-56-12(BARRICADES AND LIGHTS FOR ROADWAY)
14	STANDARD STRUCTURE SHEET RS-56-14(PRECAST CONC. PIPE D.I.)
15-26	PLAN AND PROFILE SHEETS
27	DETAIL SHEET FOR MULTI PLATE PIPE ARCH
28	SUPERSTRUCTURE WIDENING
29	ABUTMENT NO. 1 DETAILS
30	ABUTMENT NO. 2 DETAILS
31	DETAILS OF WING NO. 1 AND NO. 2
32	REINFORCING STEEL SCHEDULE
33	STANDARD STRUCTURE SS-20-58(CONSTRUCTION DETAILS FOR W.F. BEAM BRIDGES)
34	STANDARD STRUCTURE SS-56-2(BARRICADES AND LIGHTS FOR BRIDGES)
35	STANDARD CONCRETE BOX CULVERTS SC-1
36-94	CROSS SECTIONS
95-97	CHANNEL SECTIONS

STATE OF VERMONT  
DEPARTMENT OF HIGHWAYS

**PROPOSED IMPROVEMENT**  
FEDERAL-AID  
SECONDARY-PROJECT




**TOWN OF MOUNT HOLLY**  
COUNTY OF RUTLAND

VERMONT ROUTE 8  
MOUNT HOLLY — WESTON ROAD

STANDARD STRUCTURE SHEET APPROVED BY THE CHIEF ENGINEER  
OF VERMONT STATE DEPARTMENT OF HIGHWAYS  
S-40 JUNE 10, 1950

PROJECT NAME & NUMBER	TYPE	PAVEMENT AREA
MOUNT HOLLY S-242(4)	DOUBLE TACK COAT OF REFINED TAR WITH PEA STONE SEAL	41,107 s.y.
RECORD PLANS MATERIALS		
SUB-BASE OF GRAVEL - COLE AND GARROW PITS - MOUNT HOLLY, VERMONT.		
TRANSIT MIX CONCRETE - JOSEPH CARRARA - RUTLAND, VERMONT.		
REINFORCING & STRUCTURAL STEEL - VERMONT STRUCTURAL STEEL CO. - BURLINGTON, VT.		
REFINED TAR - THE BARRETT CO. - MAJEN, MASSACHUSETTS.		
BITUMINOUS CONCRETE PAVEMENT - VERMONT PAVING CO. INC. - BURLINGTON, VT.		
REINFORCED CONCRETE PIPE - VERMONT CONCRETE PIPE CO. - WINDSOR, VERMONT.		
A.C.C.G. METAL PIPE - NEW ENGLAND METAL CULVERT CO. - WHITE RIVER JCT., VT.		
VITRIFIED CLAY PIPE - RUTLAND FIRE CLAY CO. - RUTLAND, VERMONT.		
CABLE GUARD RAIL - BETHLEHEM STEEL CO. - BOSTON, MASSACHUSETTS.		
CONTRACTOR - S.V. ROSSI CONST. CO.		
RESIDENT ENGINEER - HUGH ELDER		
INSPECTOR - J.G. PHILBRICK		
RECORD PLANS - W.H. DRATH		
CONTRACT DATED - APRIL 4, 1958.		
CONTRACT STARTED - MAY 5, 1958.		
CONTRACT COMPLETED - AUGUST 19, 1959.		
CONTRACT ACCEPTED - AUGUST 19, 1959.		

BEGINNING AT A POINT APPROXIMATELY 3578.1 FEET SOUTHERLY FROM THE WALLINGFORD - MOUNT HOLLY TOWN LINE AND EXTENDING NORTHERLY 18,498.1 FEET.  
LENGTH OF PROJECT - 18,498.1 FEET = 3.503 MILES

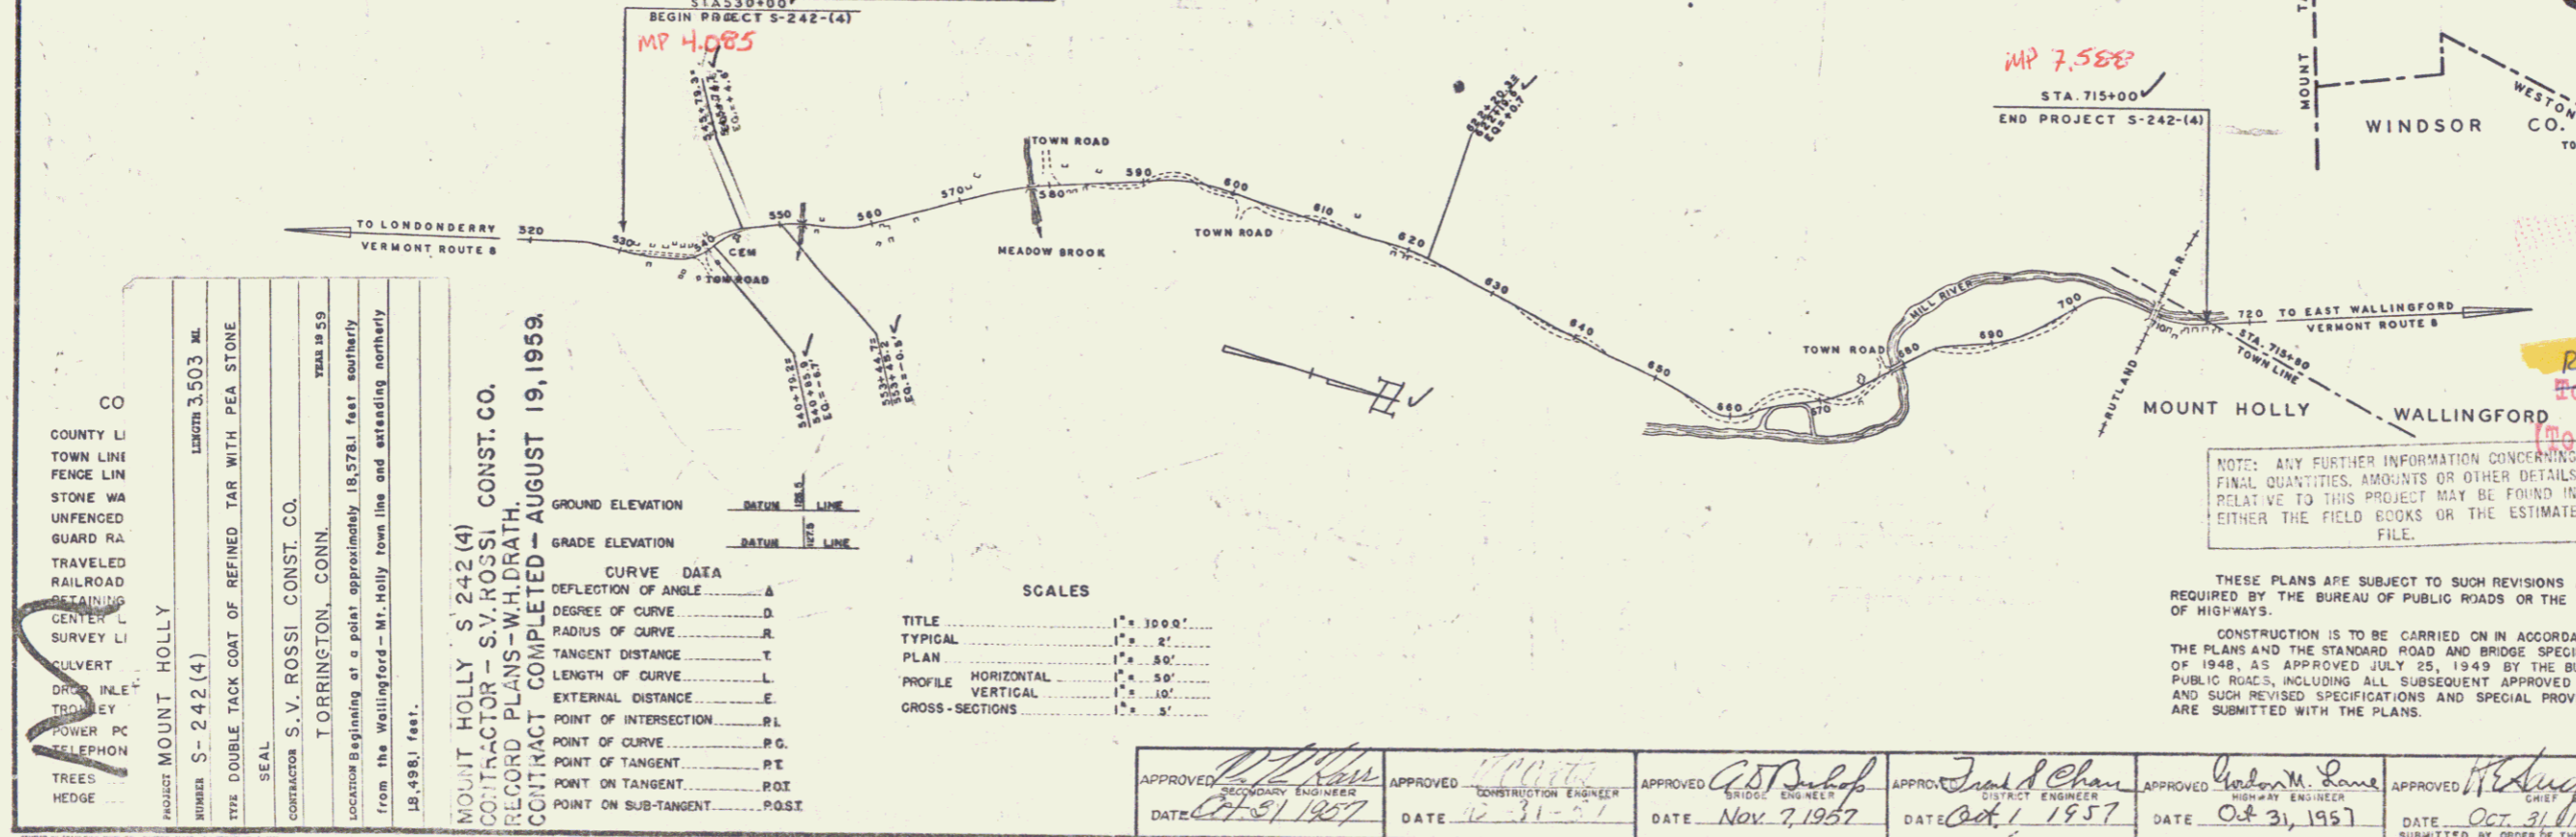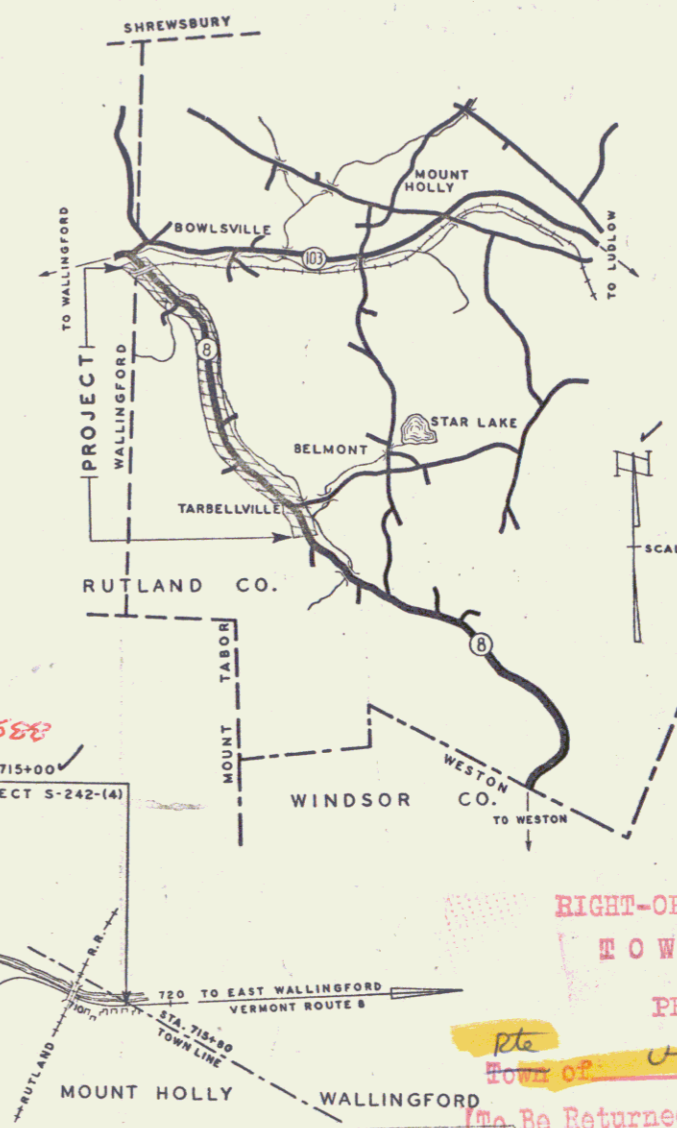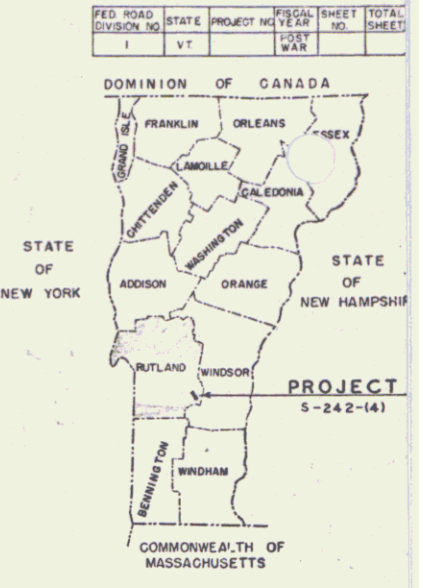

CO  
COUNTY LI  
TOWN LINE  
FENCE LINE  
STONE WA  
UNFENCED  
GUARD RA  
TRAVELED  
RAILROAD  
RESERVING  
CENTER L  
SURVEY L  
CULVERT  
DRAIN INLE  
TR  
POWER PC  
TELEPHONE  
TREES  
HEDGE

PROJECT MOUNT HOLLY  
NUMBER S-242(4)  
TYPE DOUBLE TACK COAT OF REFINED TAR WITH PEA STONE SEAL  
CONTRACTOR S.V. ROSSI CONST. CO.  
TORRINGTON, CONN.  
LOCATION Beginning at a point approximately 3578.1 feet southerly from the Wallingford - Mt. Holly town line and extending northerly 18,498.1 feet.

MOUNT HOLLY S-242(4)  
CONTRACTOR - S.V. ROSSI CONST. CO.  
RECORD PLANS - W.H. DRATH  
CONTRACT COMPLETED - AUGUST 19, 1959.

RIGHT-OF-WAY DIVISION  
TOWN FILE  
PERPETUAL  
Town of 4155  
To Be Returned To R.O.W. Division

NOTE: ANY FURTHER INFORMATION CONCERNING FINAL QUANTITIES, AMOUNTS OR OTHER DETAILS RELATIVE TO THIS PROJECT MAY BE FOUND IN EITHER THE FIELD BOOKS OR THE ESTIMATE FILE.

THESE PLANS ARE SUBJECT TO SUCH REVISIONS AS MAY BE REQUIRED BY THE BUREAU OF PUBLIC ROADS OR THE COMMISSIONER OF HIGHWAYS.

CONSTRUCTION IS TO BE CARRIED ON IN ACCORDANCE WITH THE PLANS AND THE STANDARD ROAD AND BRIDGE SPECIFICATIONS OF 1948 AS APPROVED JULY 25, 1949 BY THE BUREAU OF PUBLIC ROADS, INCLUDING ALL SUBSEQUENT APPROVED REVISIONS AND SUCH REVISED SPECIFICATIONS AND SPECIAL PROVISIONS AS ARE SUBMITTED WITH THE PLANS.

DEPARTMENT OF COMMERCE BUREAU OF PUBLIC ROADS	
RECOMMENDED FOR APPROVAL	
DISTRICT ENGINEER	DATE
APPROVED	
DIVISION ENGINEER	DATE
PROJECT S NO. 242-14	
SHEET 1 OF 97 SHEETS	

APPROVED DATE 10/31/1957	APPROVED DATE 10/31/1957	APPROVED DATE Nov. 7, 1957	APPROVED DATE Oct. 1, 1957	APPROVED DATE Oct. 31, 1957	APPROVED DATE Oct. 31, 1957
-----------------------------	-----------------------------	-------------------------------	-------------------------------	--------------------------------	--------------------------------