
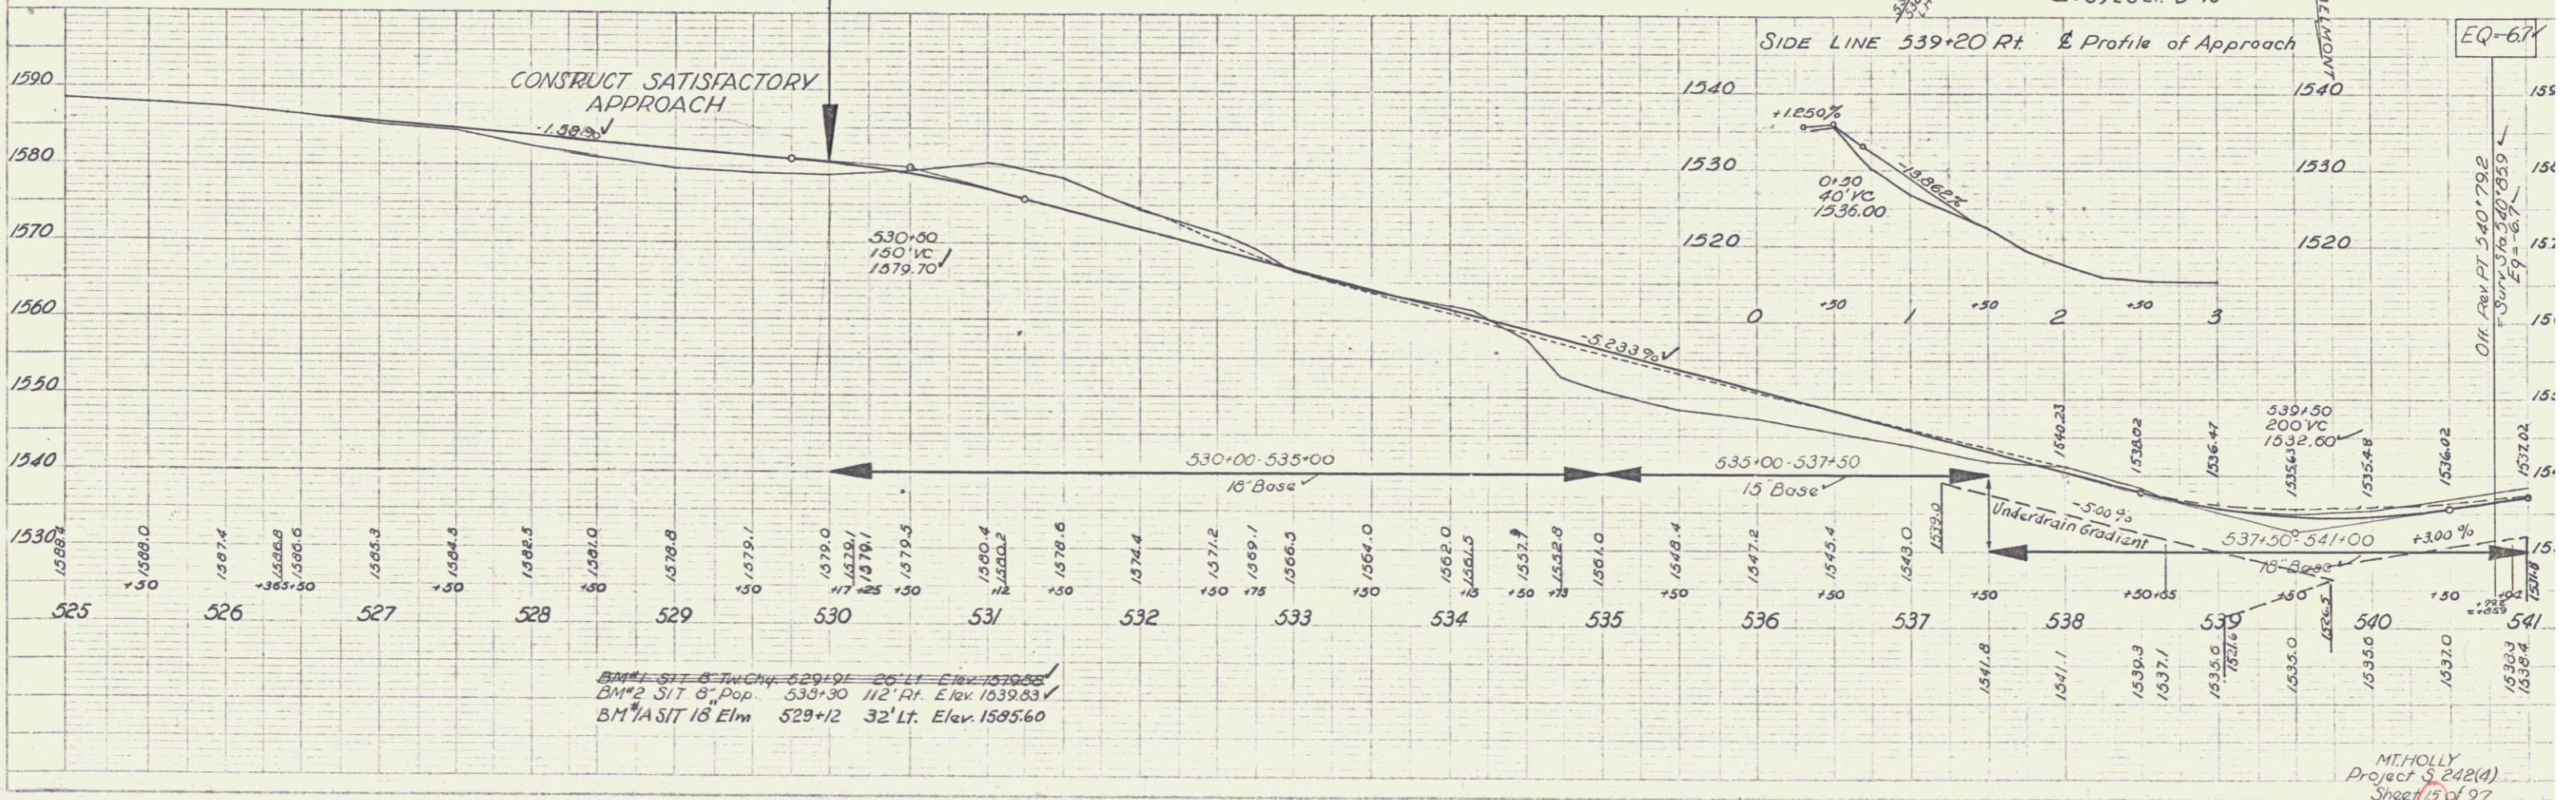


PLAN
 DATE: 1/15/57
 DRAWN BY: J.R.A.
 CHECKED BY: J.R.A.

PROFILE
 DATE: 1/15/57
 DRAWN BY: J.R.A.
 CHECKED BY: J.R.A.

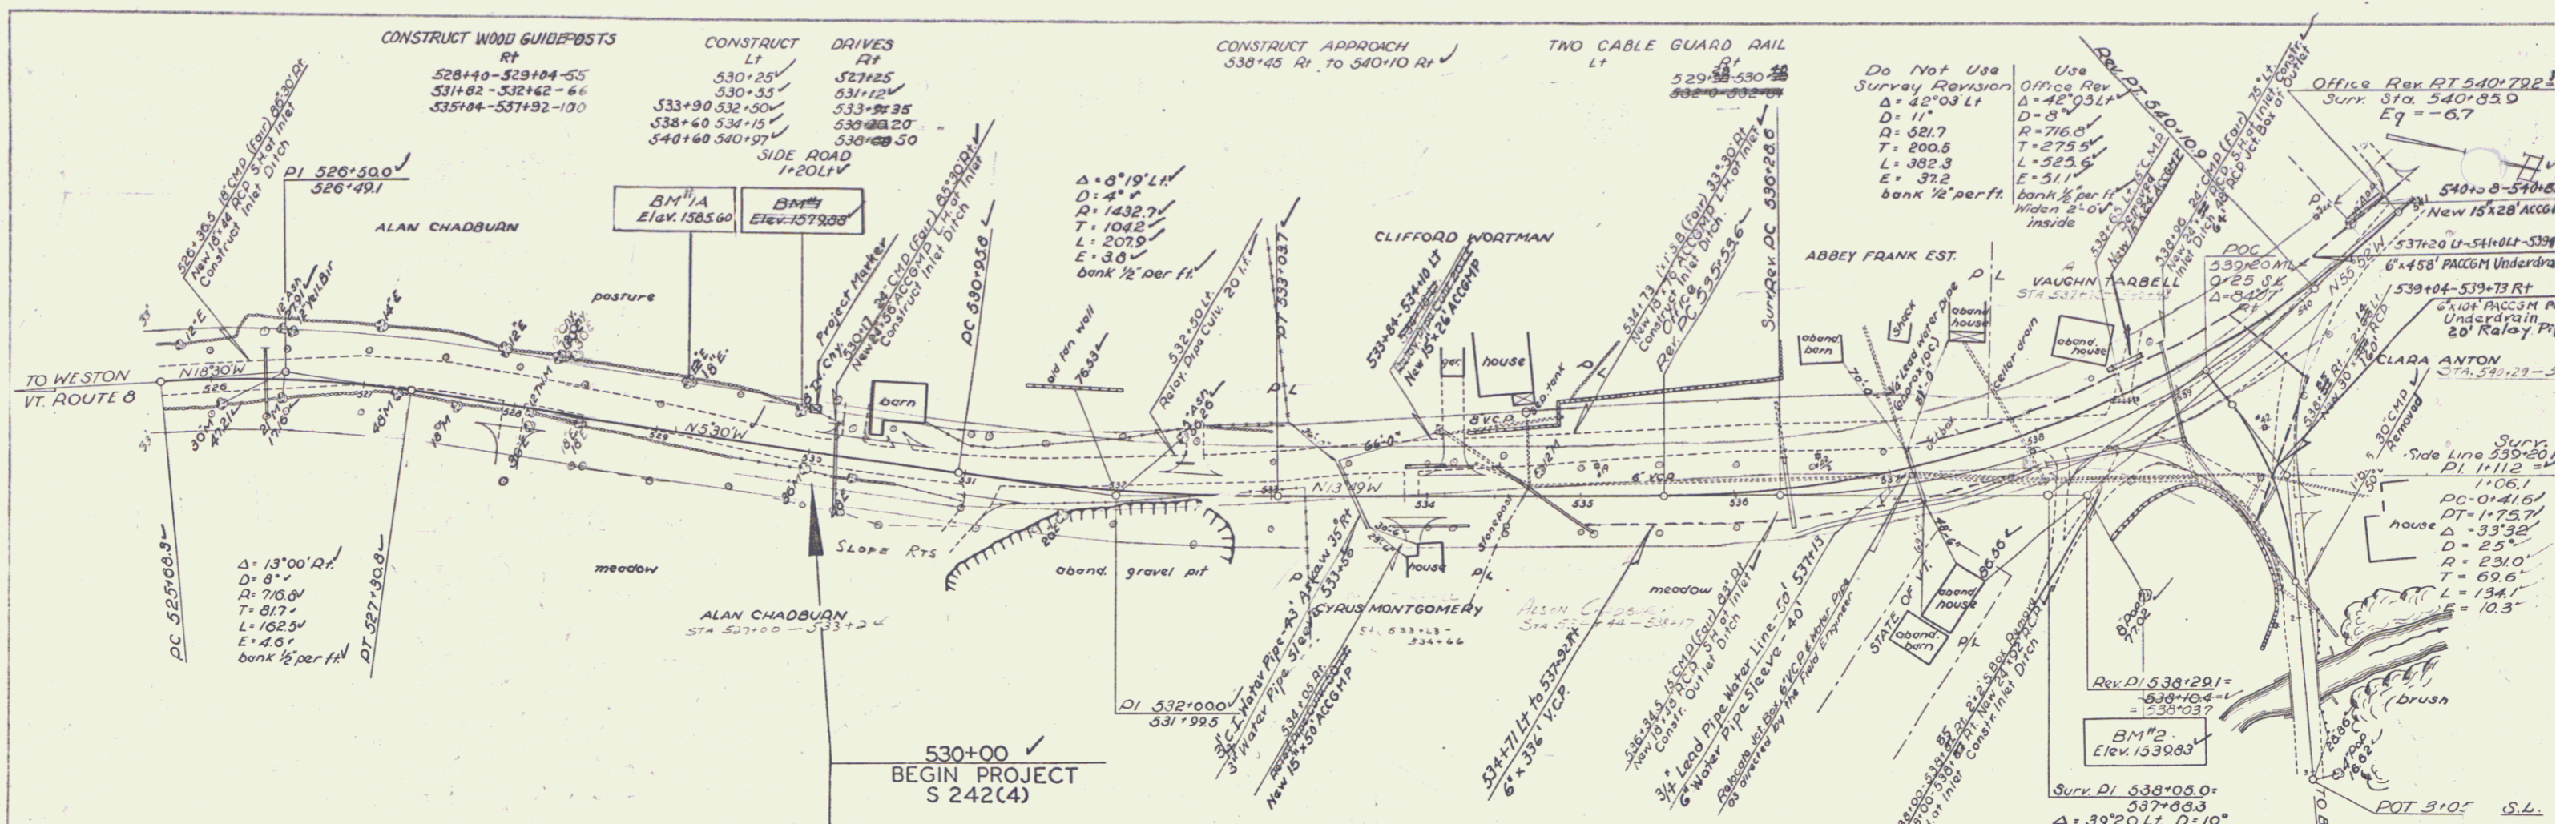

BM#1 SIT 8" IN CHY 529+91 25' Lt. Elev. 1570.52
 BM#2 SIT 8" Pop. 530+30 112' Rt. Elev. 1539.83
 BM#3 SIT 18" Elm 529+12 32' Lt. Elev. 1585.60

MTHOLLY
 Project S 242(4)
 Sheet 15 of 97