

PLAN
 DATE: 10/15/03
 DRAWN BY: JLD
 CHECKED BY: JLD
 PROJECT: S 242(4)
 SHEET: 27 OF 27

PROFILE
 DATE: 10/15/03
 DRAWN BY: JLD
 CHECKED BY: JLD
 PROJECT: S 242(4)
 SHEET: 27 OF 27

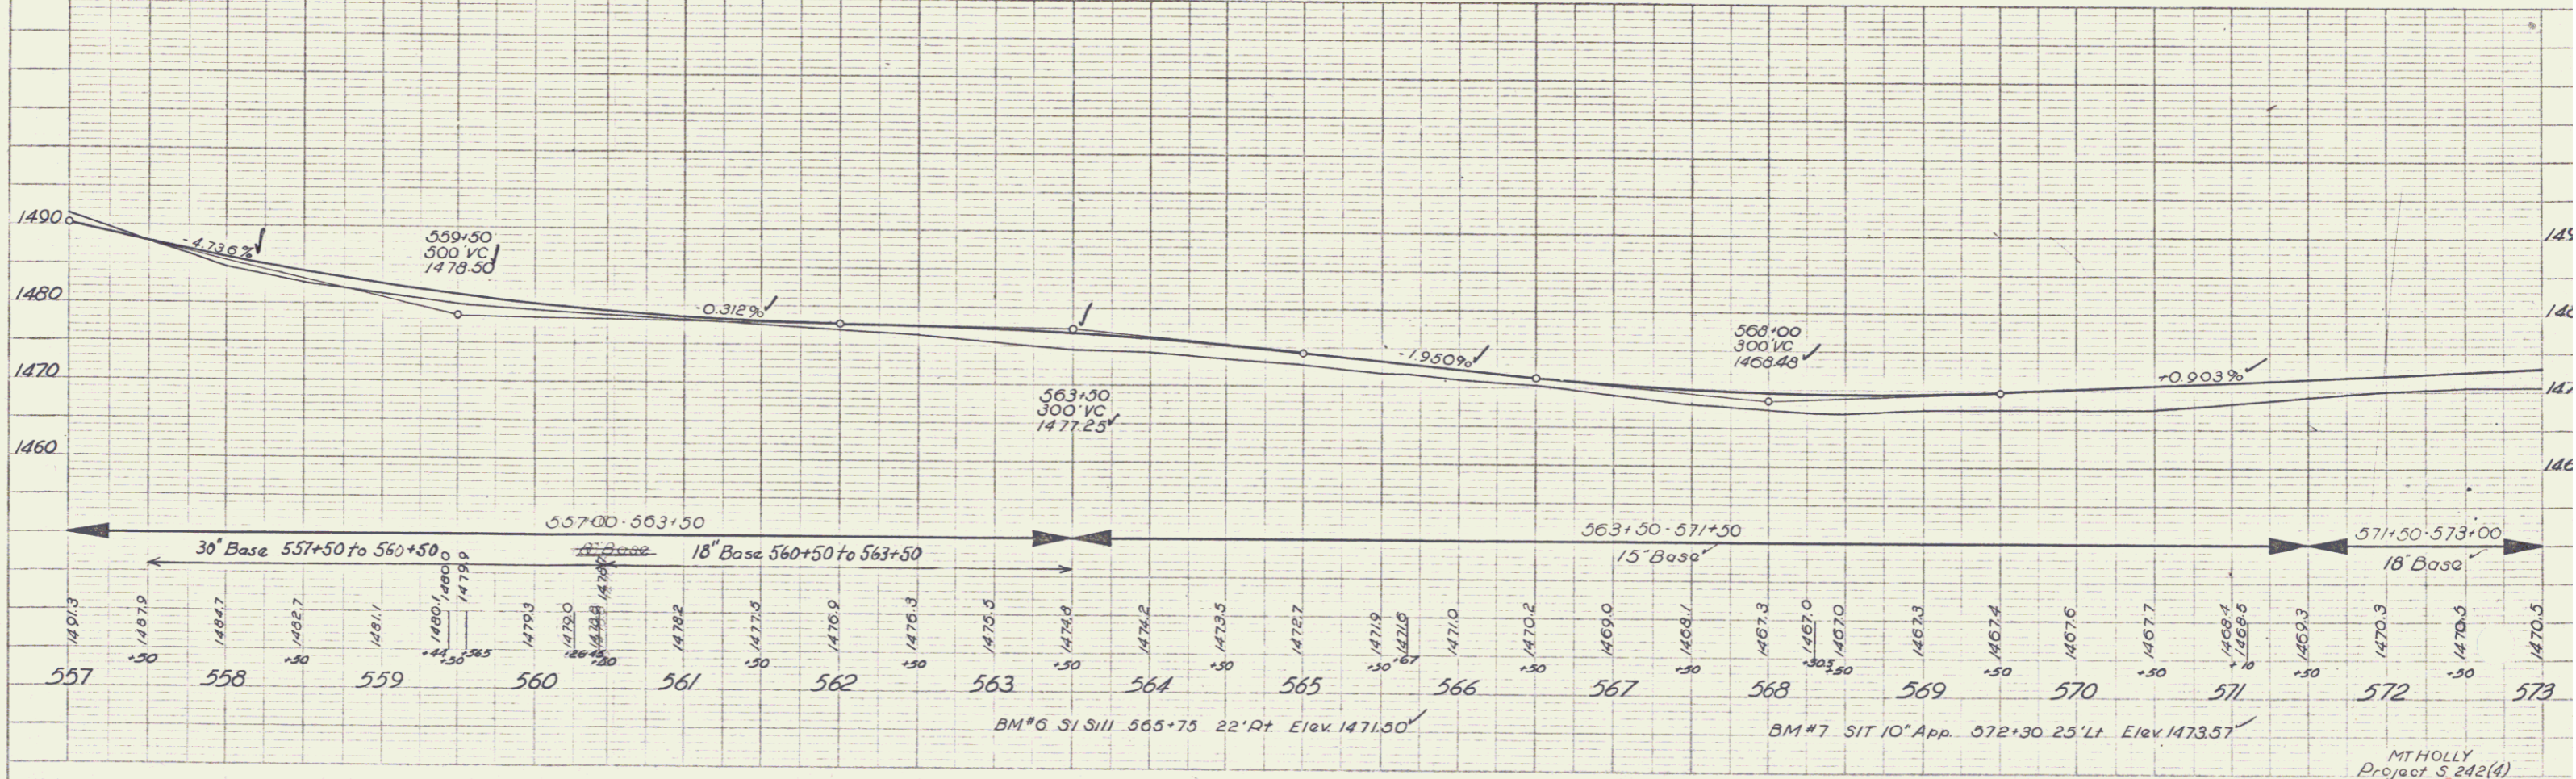
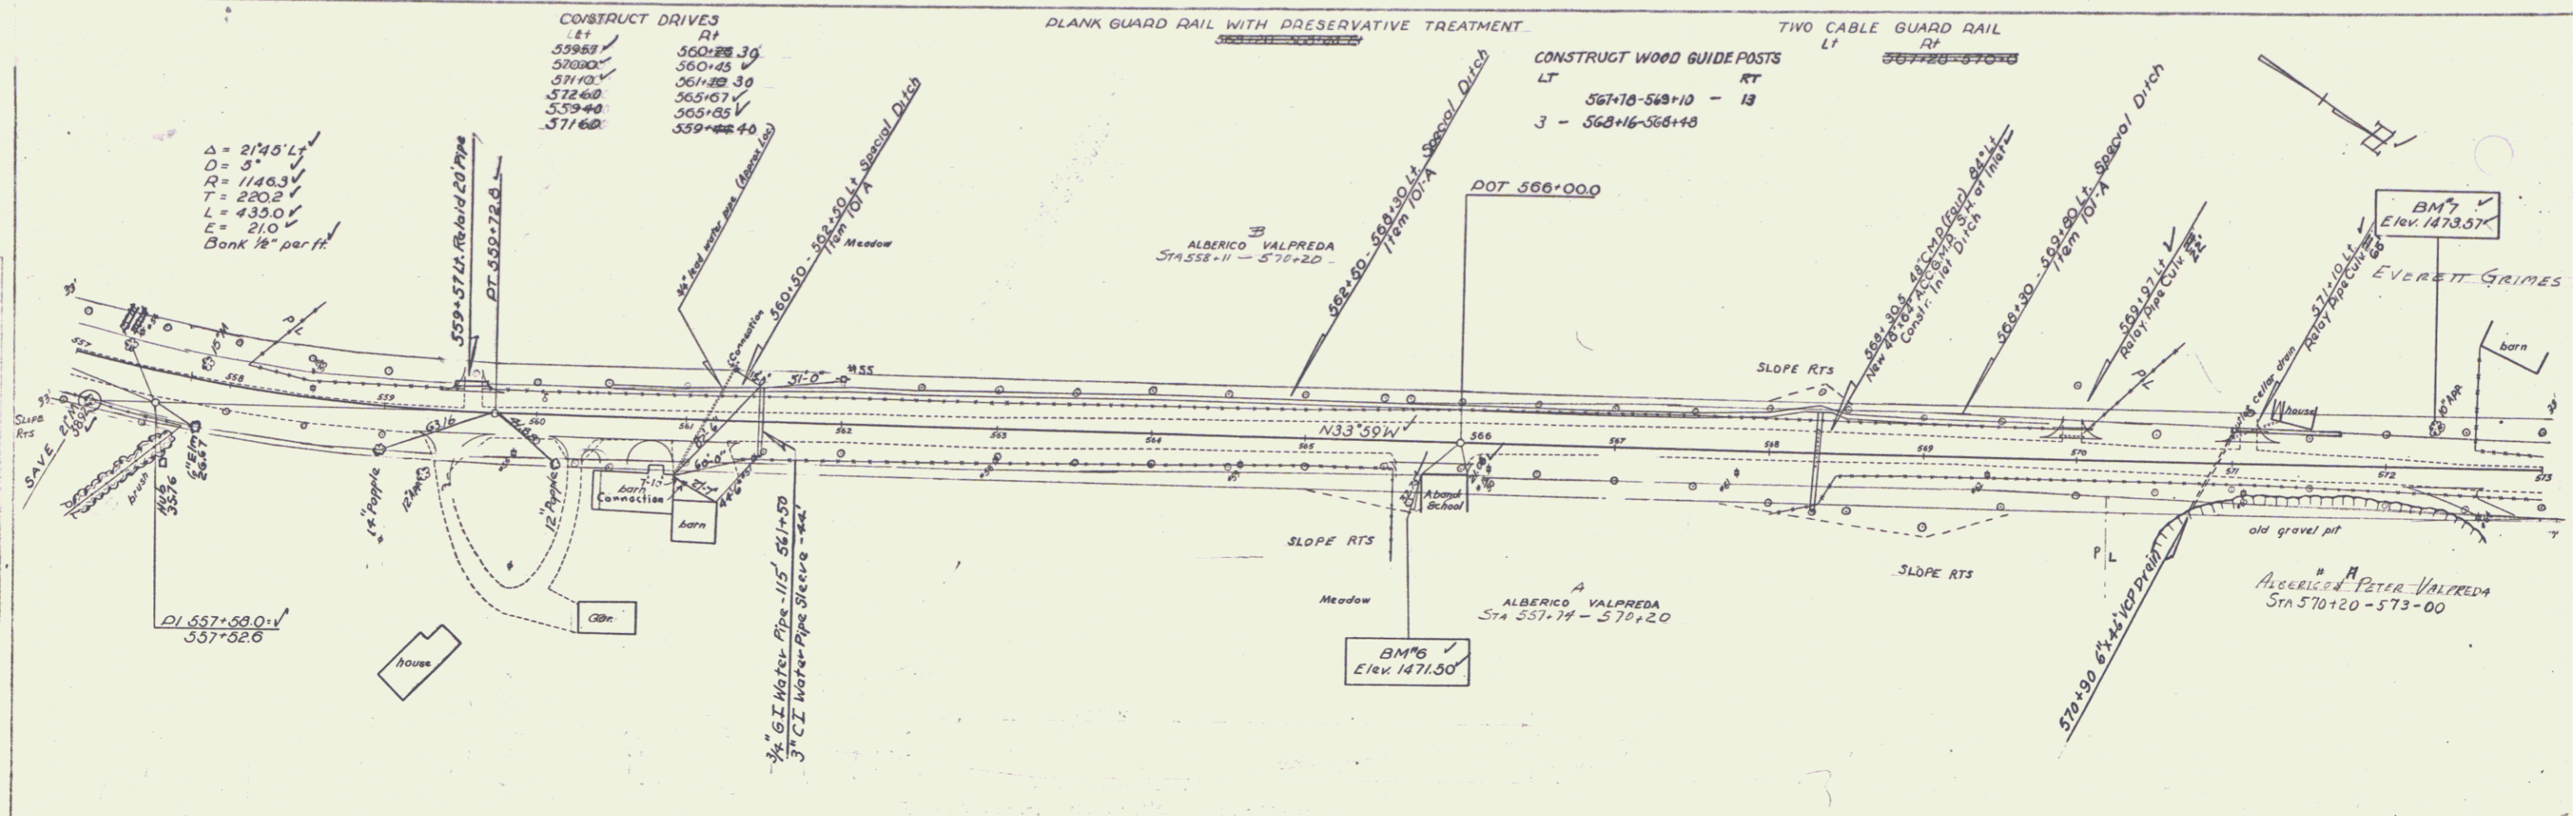


PLATE 1 - PLAN & PROFILE - P. R. A. E. ENGINEERS
 PROJECT: S 242(4) - RAMP ROAD
 SHEET: 27 OF 27

MTHOLLY
 Project S 242(4)
 Sheet 27 of 27