


PLAN
 DATE 1/27/57
 BY J.M.
 CHECKED BY J.M.
 PROJECT NO. 242(R)
 SHEET NO. 20 OF 27

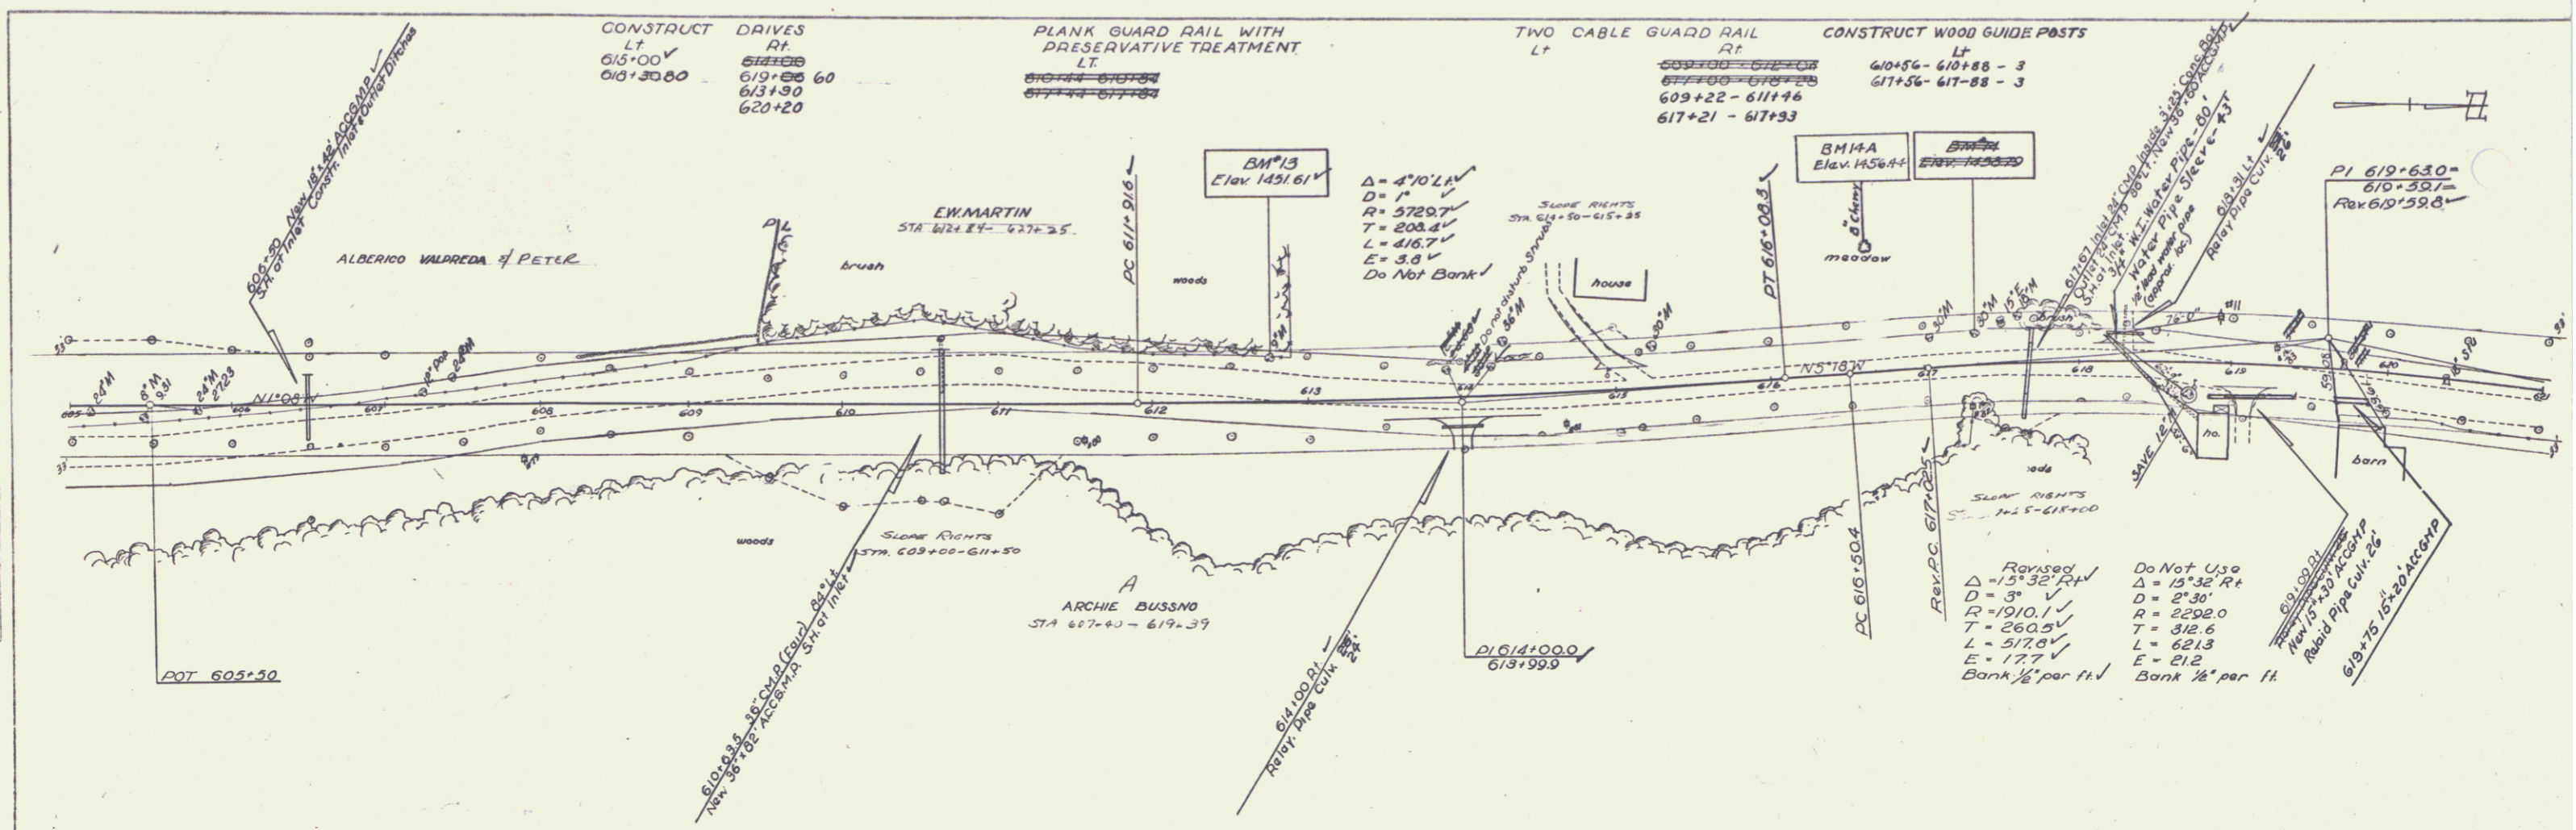

PROFILE
 DATE 1/27/57
 BY J.M.
 CHECKED BY J.M.
 PROJECT NO. 242(R)
 SHEET NO. 20 OF 27

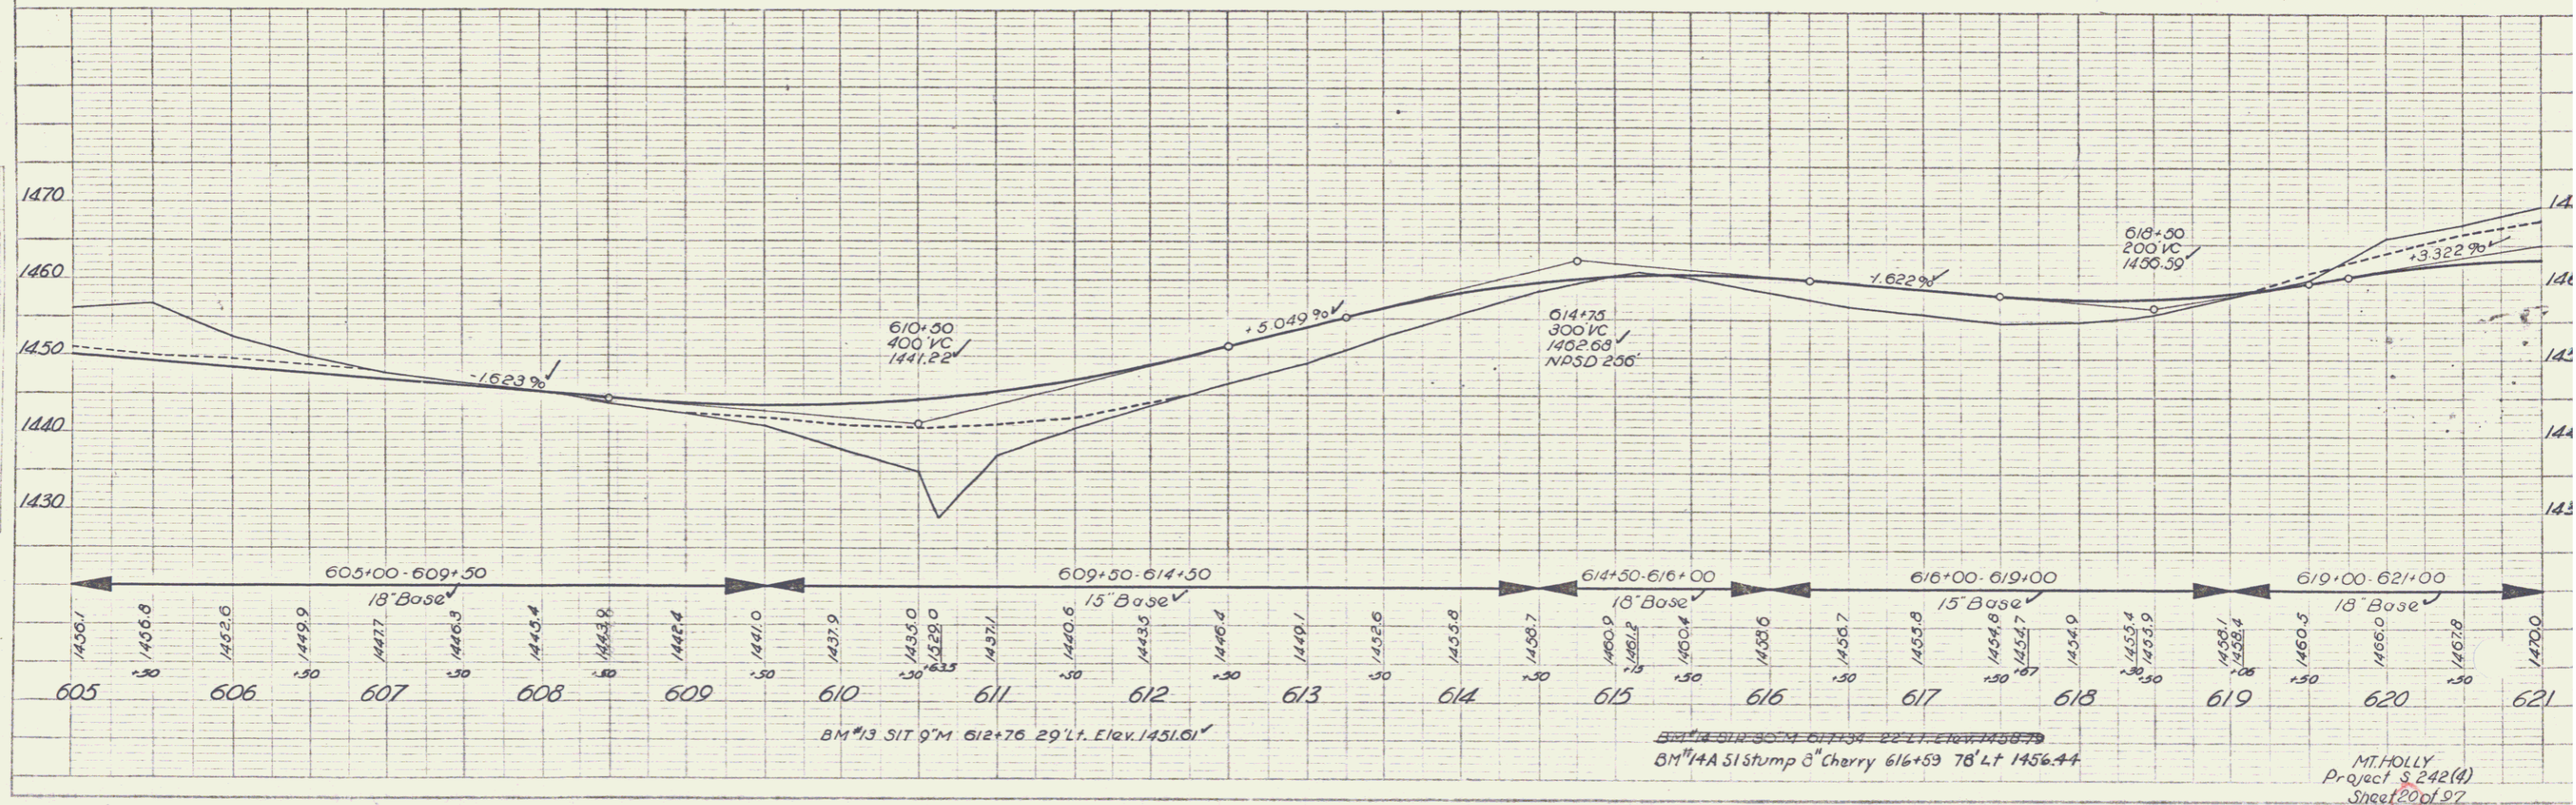


PLATE 1 - PLAN & PROFILE
 PROJECT NO. 242(R)
 SHEET NO. 20 OF 27

MT. HOLLY
 Project 242(R)
 Sheet 20 of 27