
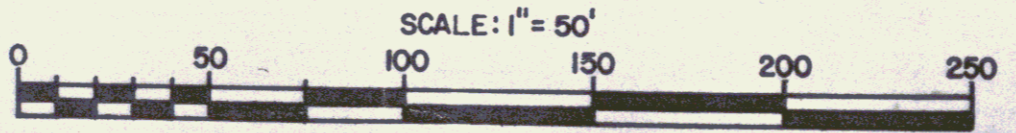
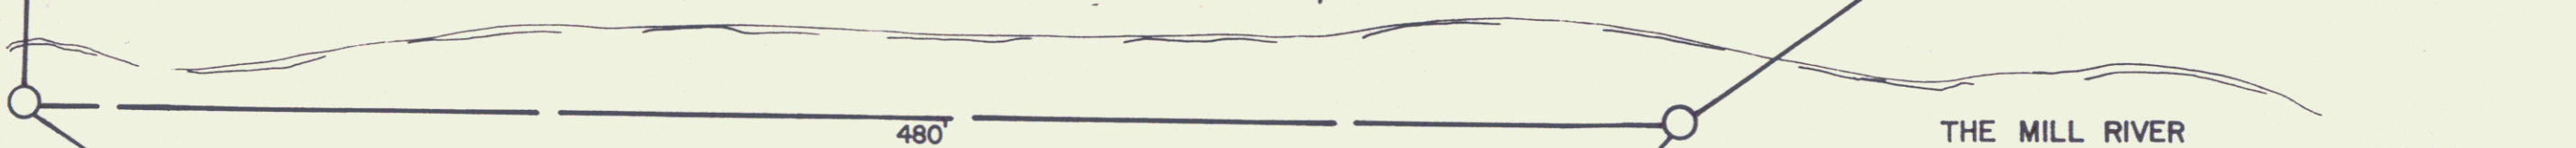
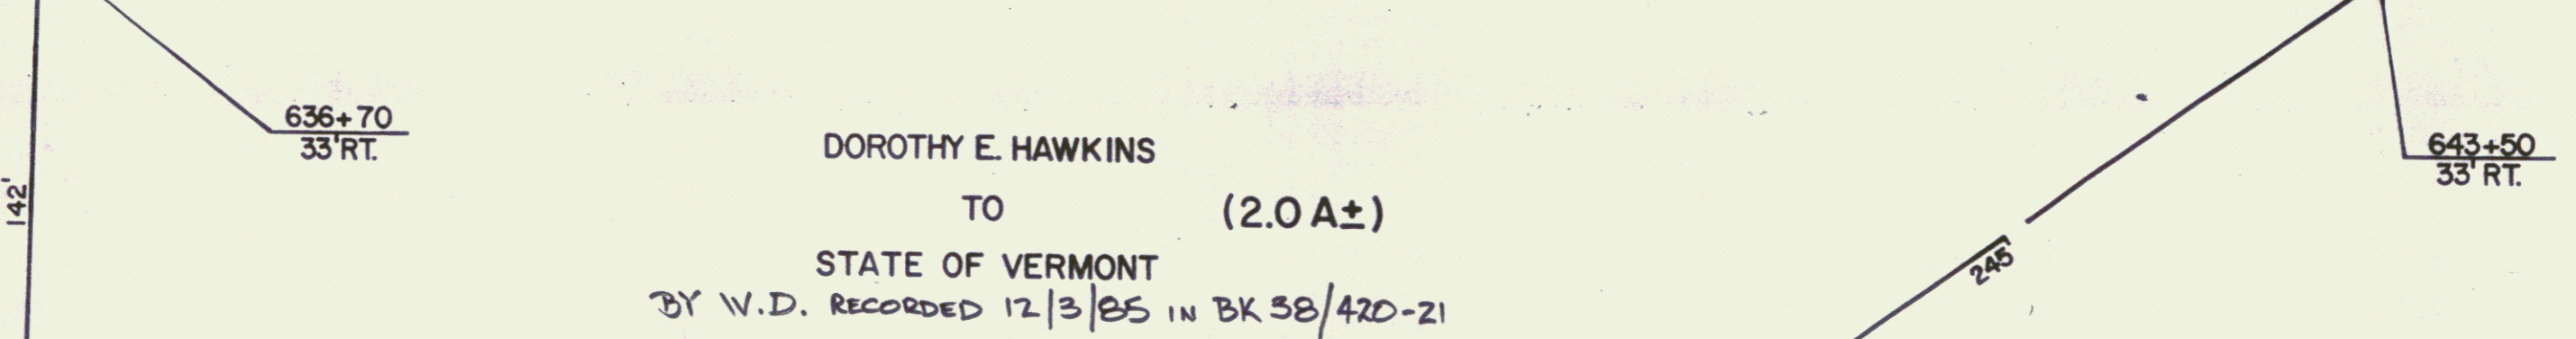
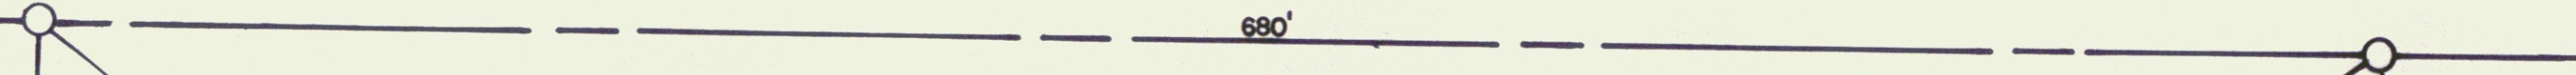
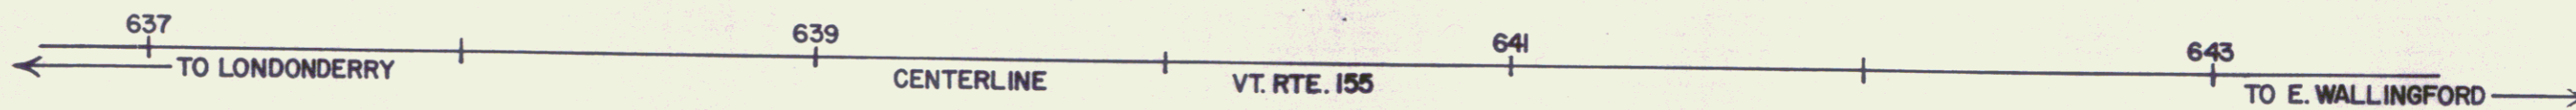


STATE OF VERMONT - ACQUIRED FROM DOROTHY E. HAWKINS  
BY W.D. RECORDED 3/16/85 BOOK 38 PG. 421

M.P. 0611

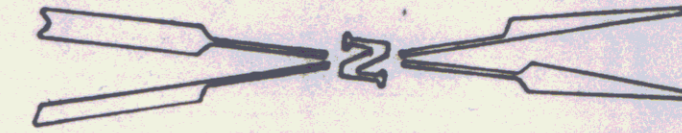

REF. PROJECT: MT. HOLLY S242(4) SHEET 22 OF 97  
STATE OF VERMONT  
AGENCY OF TRANSPORTATION  
TOWN OF MOUNT HOLLY  
APPROX. SCALE 1" = 50' DATE 8-27-85 DRAWN BY DEM  
DEV. 9-9-85 DEM

VT SHEET 22A

10