


|      |       |    |      |
|------|-------|----|------|
| PLAN | DATE  | BY | CHKD |
|      | 11/06 | PH | PH   |
|      | 11/07 | PH | PH   |
|      | 3/17  | PH | PH   |

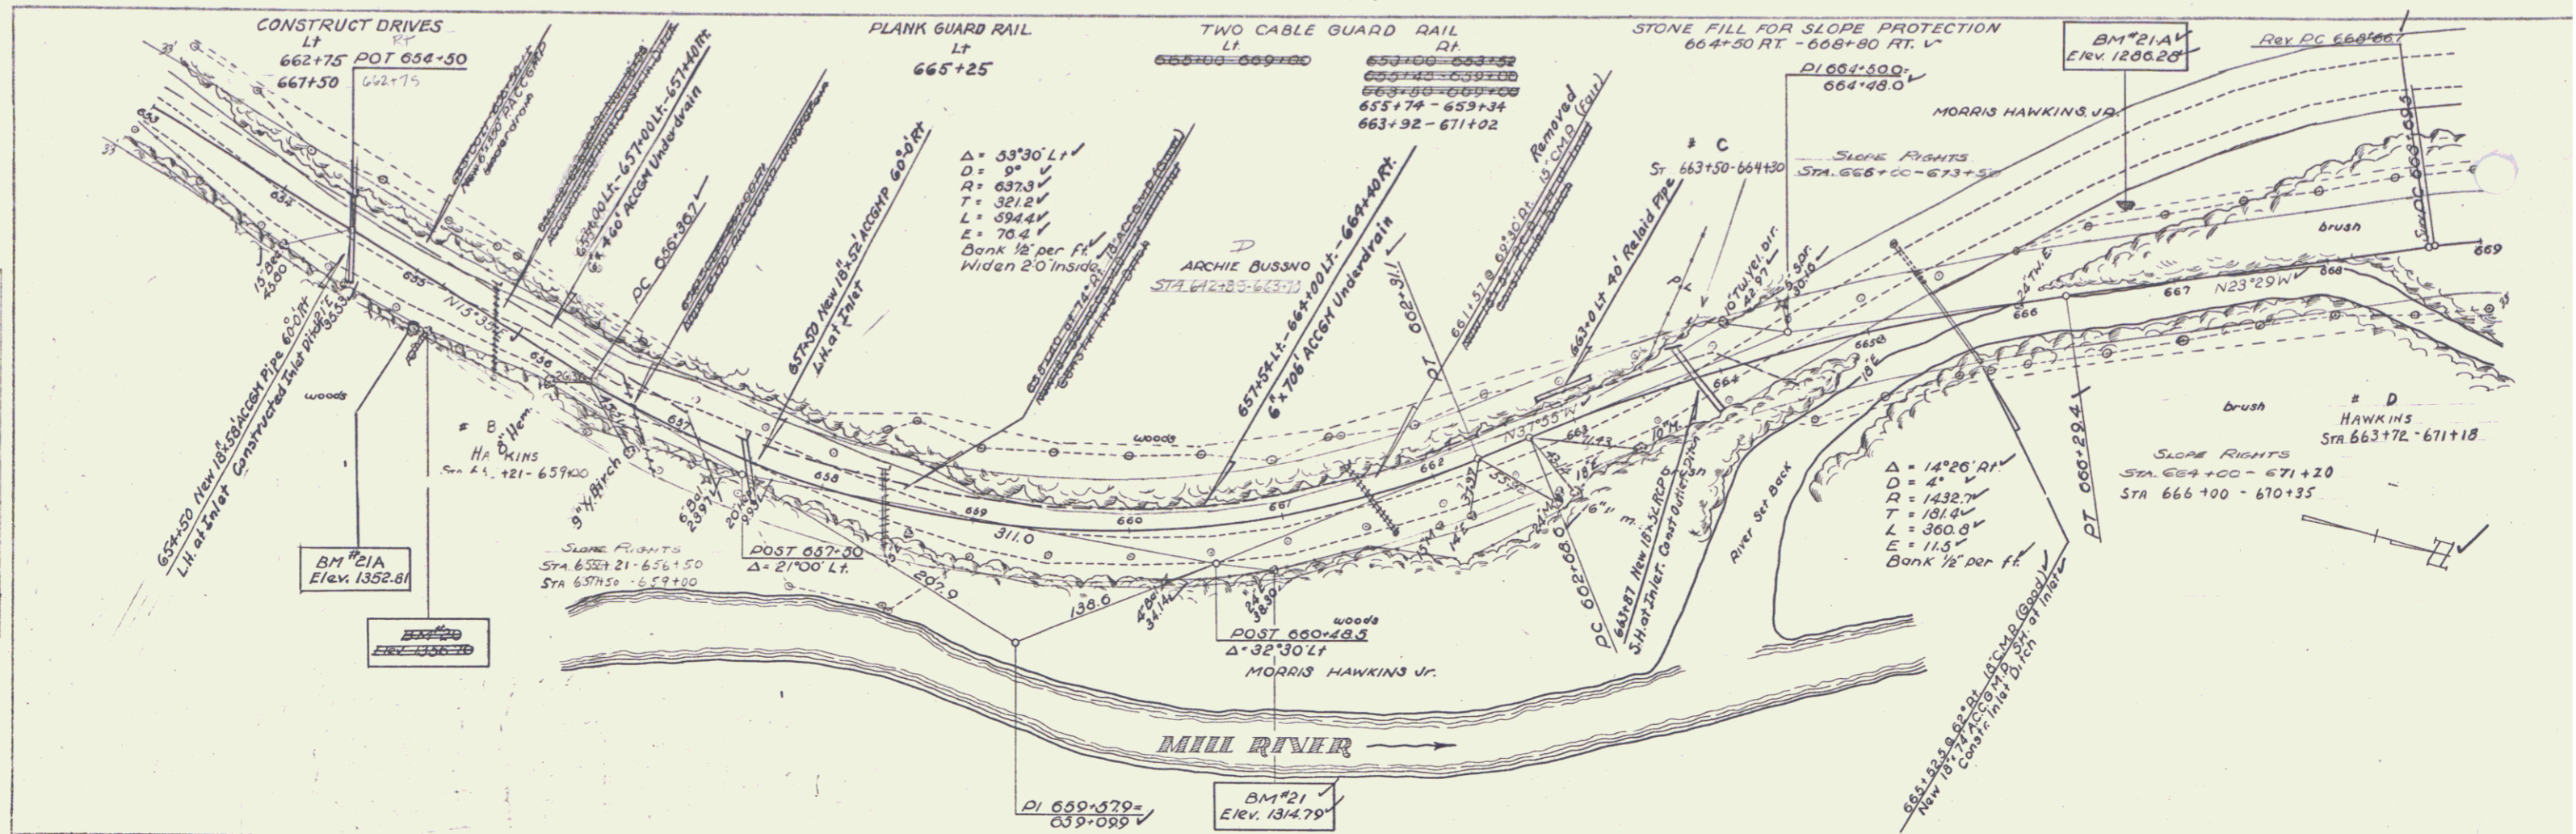

|         |       |    |      |
|---------|-------|----|------|
| PROFILE | DATE  | BY | CHKD |
|         | 11/06 | PH | PH   |
|         | 11/07 | PH | PH   |
|         | 3/17  | PH | PH   |

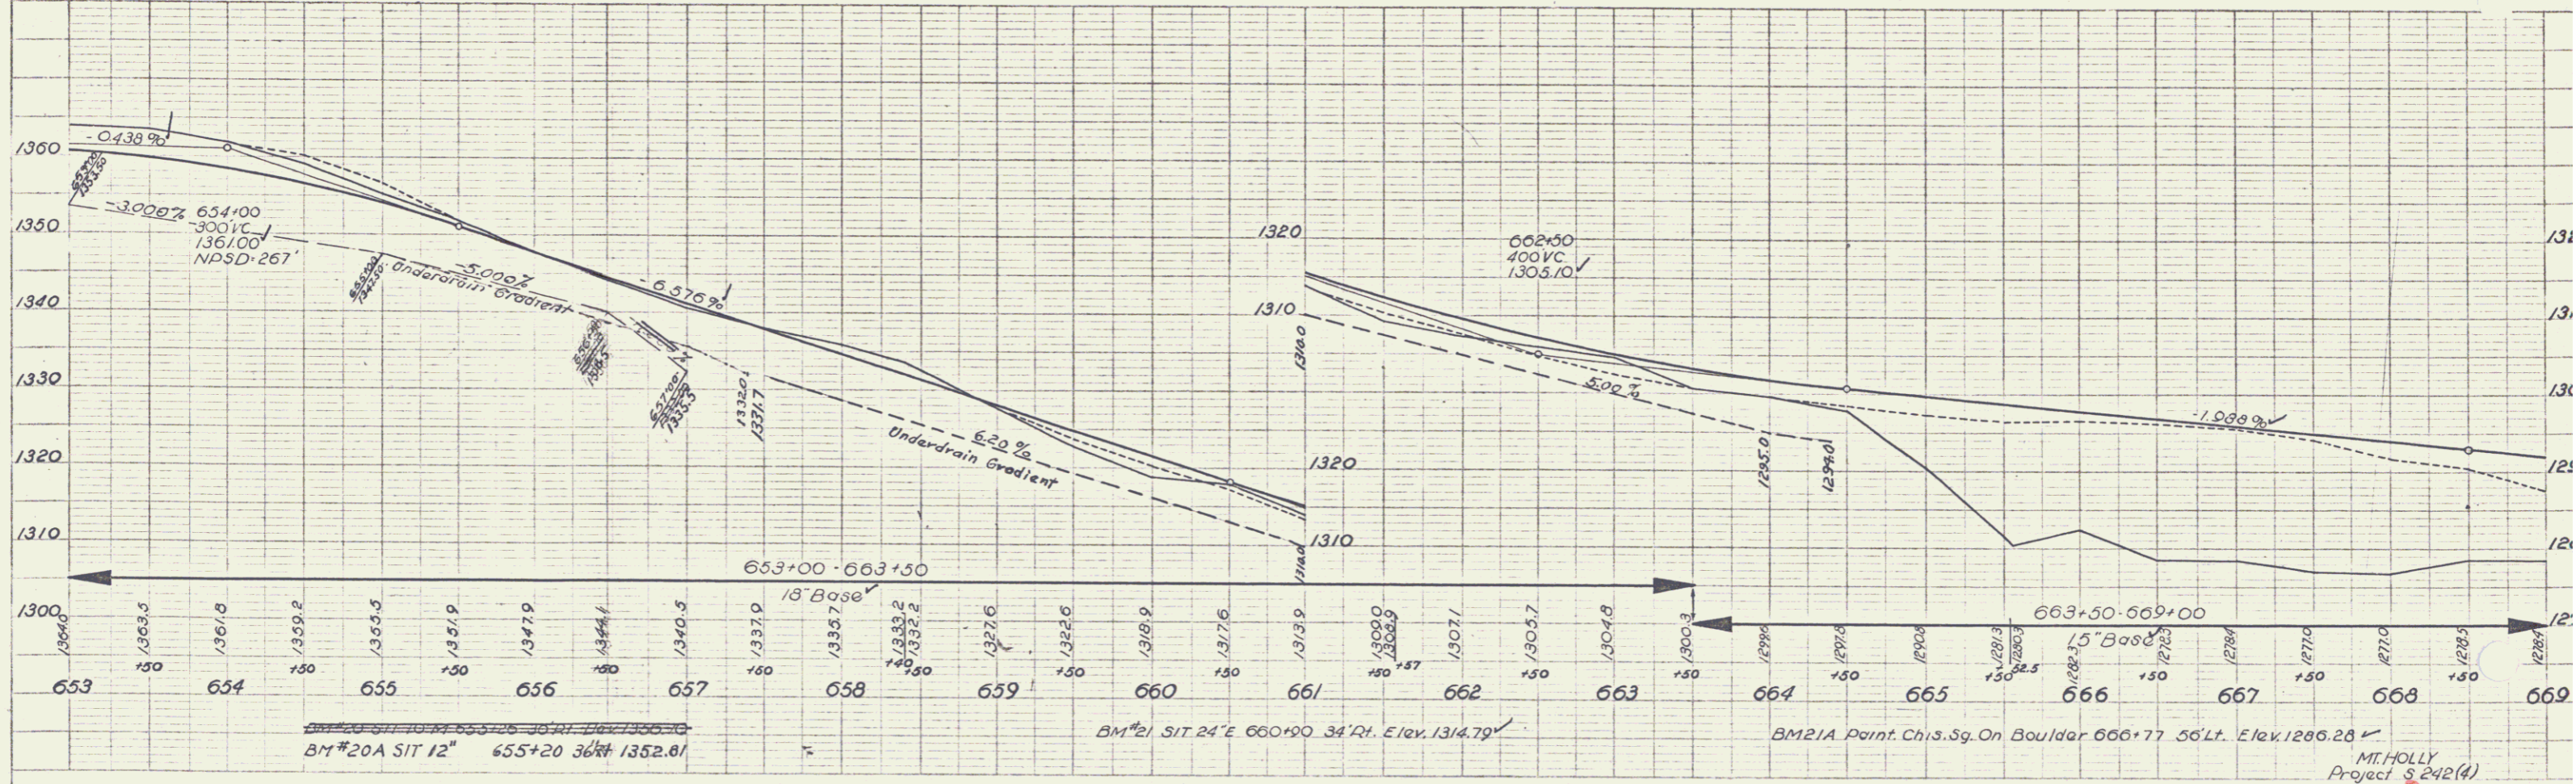


PLATE 1 - PLAN PROFILE TO P. & S. E. STATION  
 REVISIONS  
 DATE  
 BY  
 CHKD

MT. HOLLY  
 Project S 242(4)  
 Sheet 23 of 27