
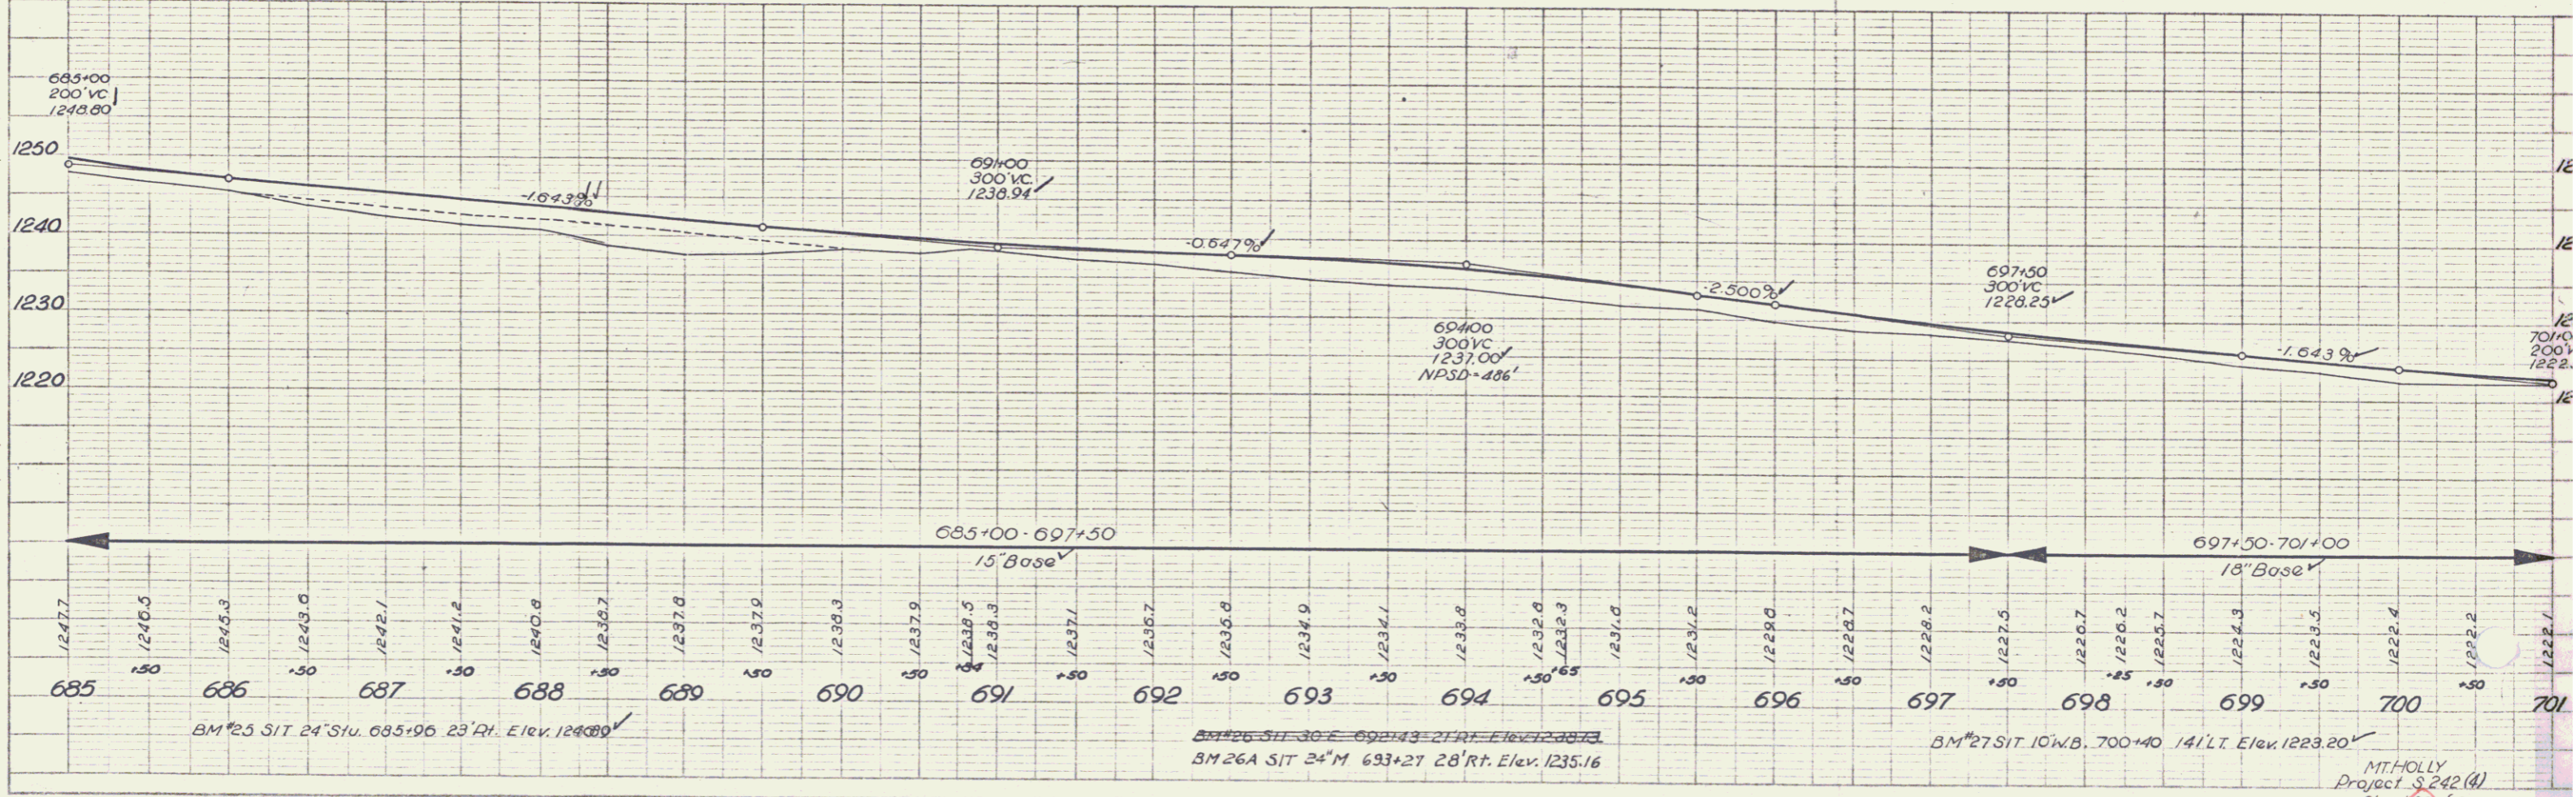


PLAN  
 DATE: 11/25/55  
 DRAWN BY: J.H. HANCOCK  
 CHECKED BY: J.H. HANCOCK  
 PROJECT: M.T. HOLLY PROJECT 3242 (A)  
 SHEET: 2 OF 97

PROFILE  
 DATE: 11/25/55  
 DRAWN BY: J.H. HANCOCK  
 CHECKED BY: J.H. HANCOCK  
 PROJECT: M.T. HOLLY PROJECT 3242 (A)  
 SHEET: 2 OF 97

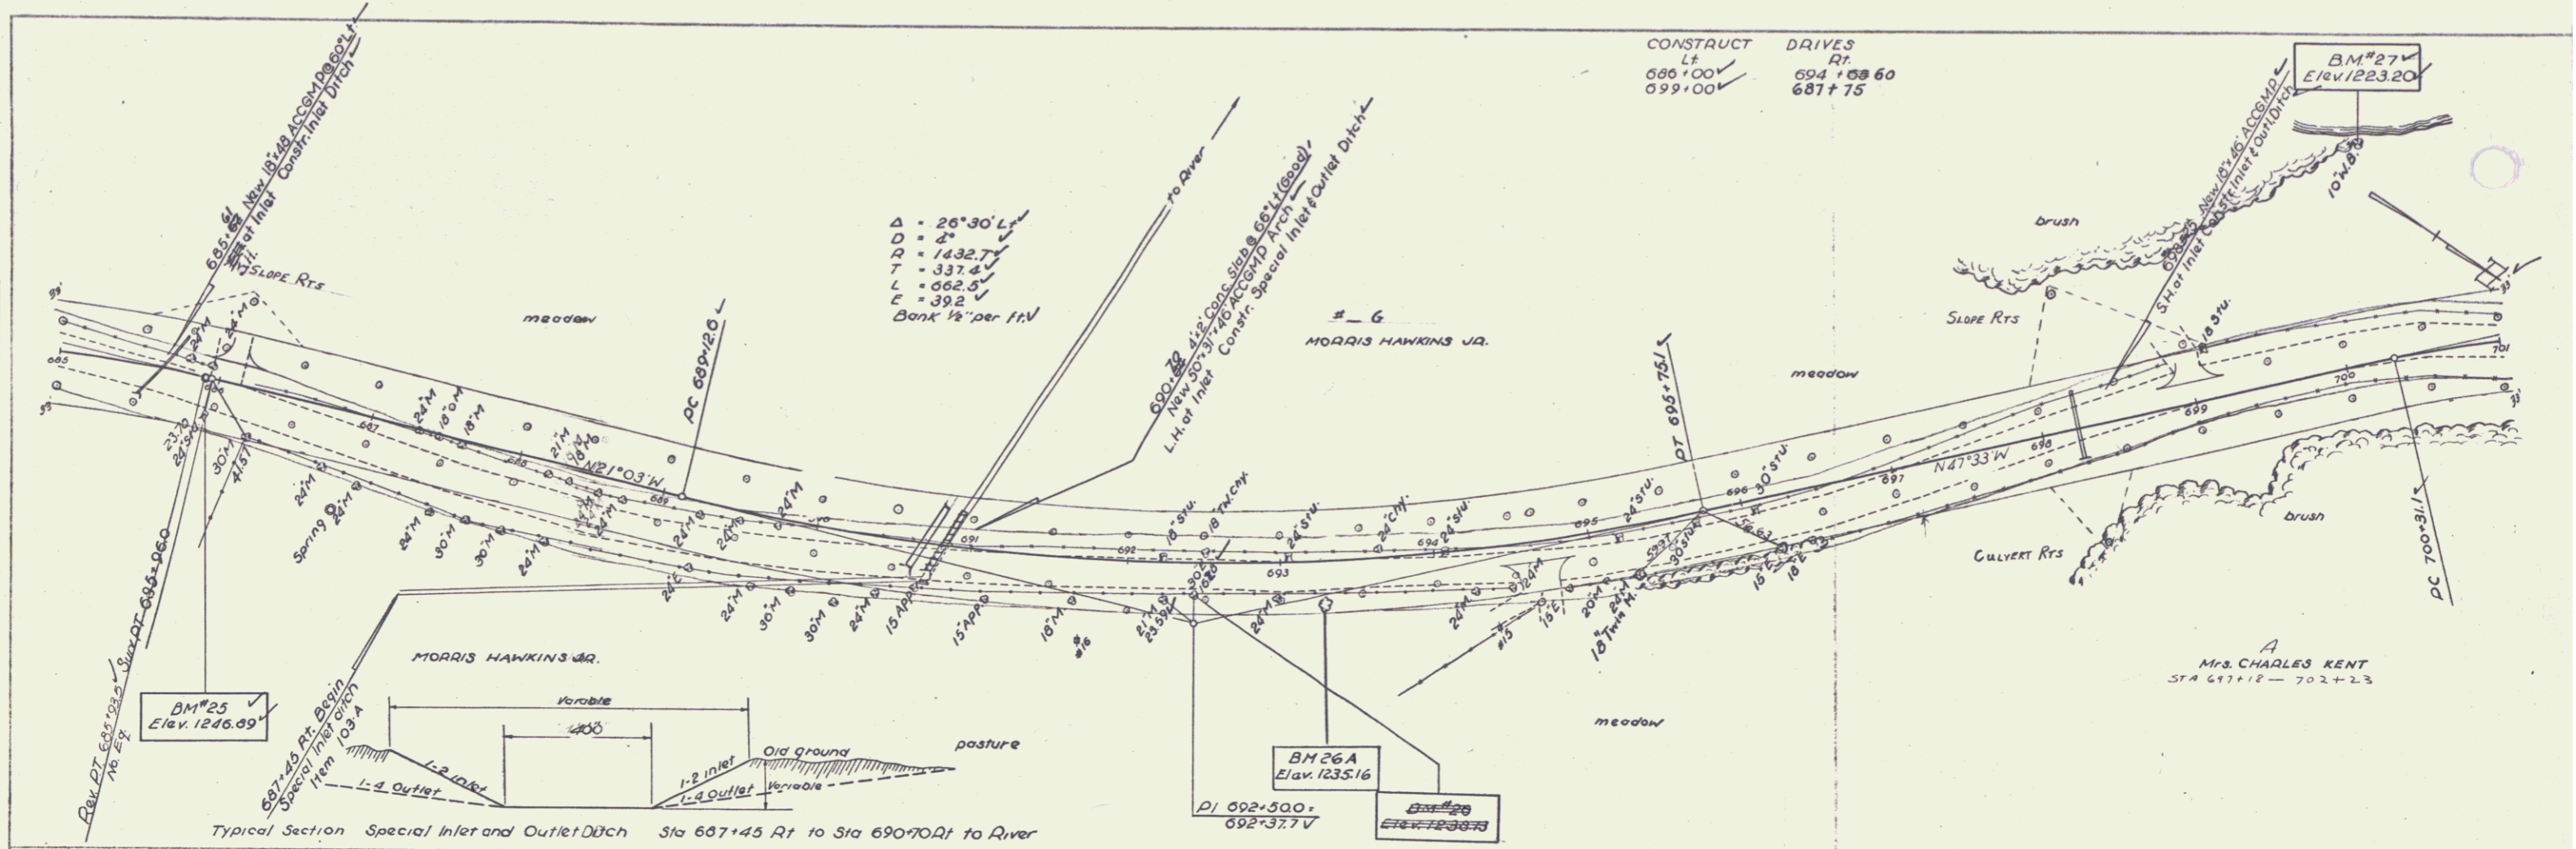

M.T. HOLLY  
 Project 3242 (A)  
 Sheet 2 of 97