
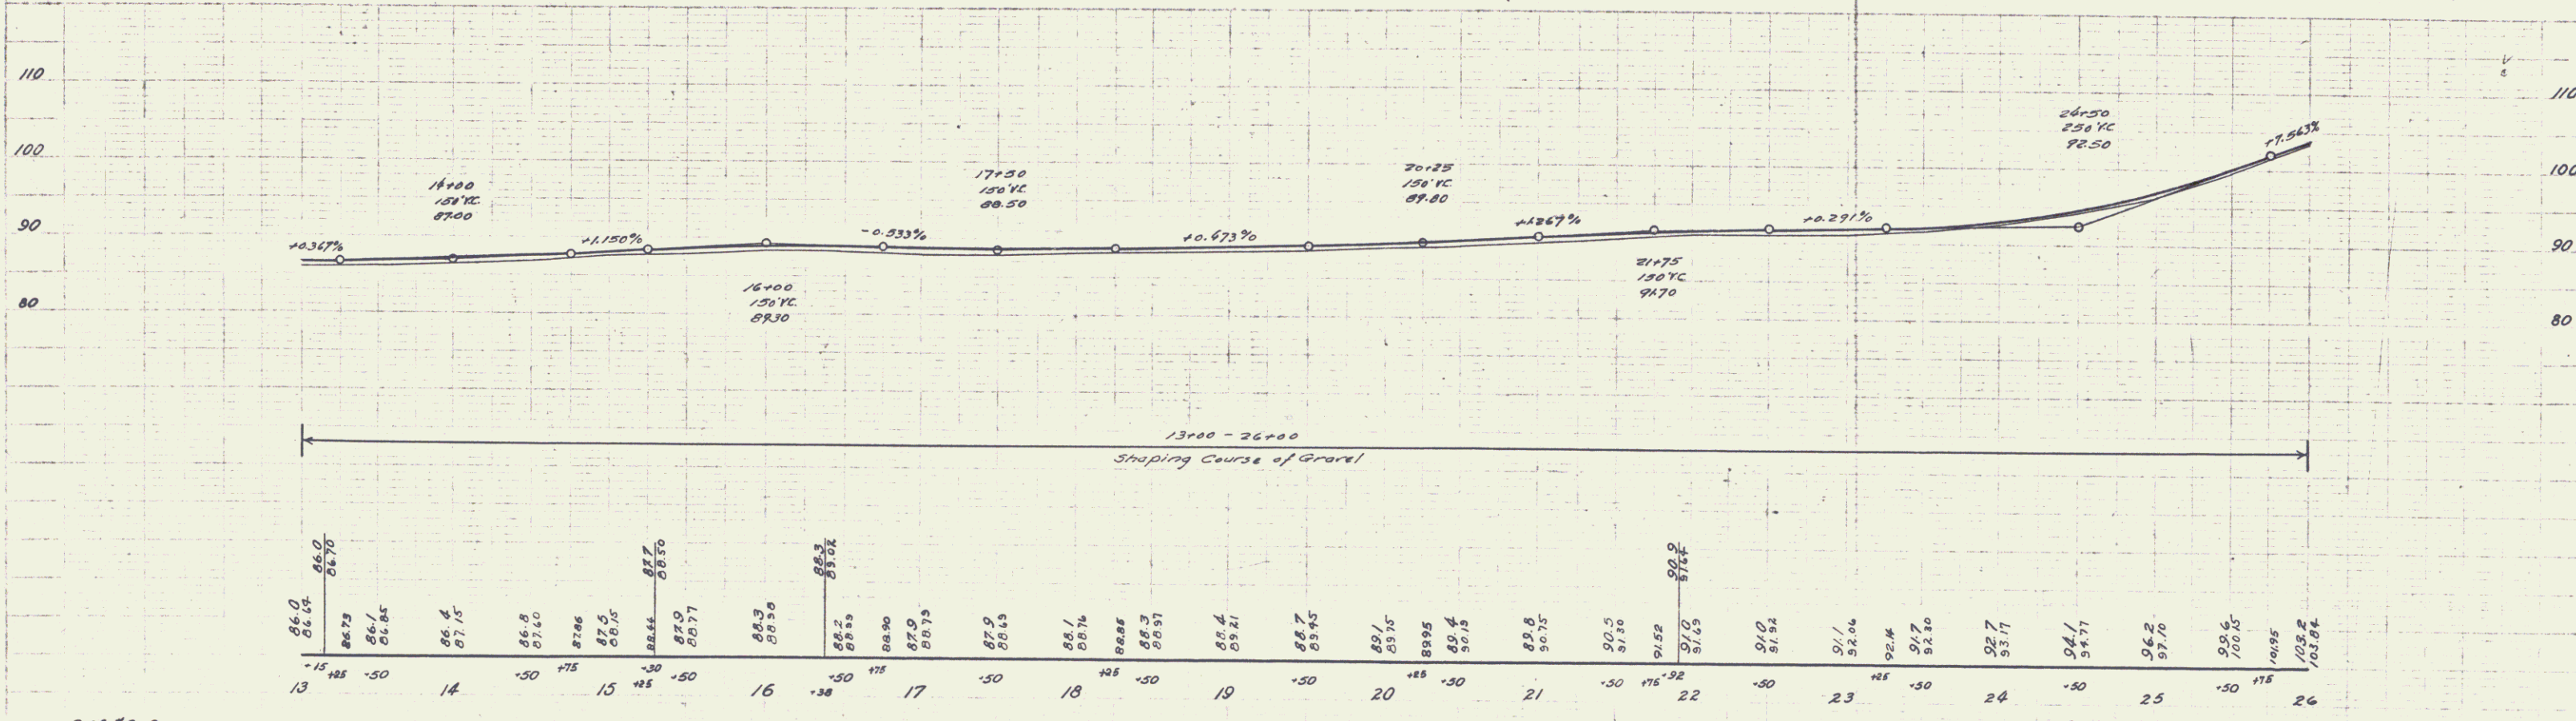


No. 2-3-F

PROPERTY OF
 THE STATE OF CALIFORNIA
 DIVISION OF HIGHWAYS
 SACRAMENTO OFFICE
 1933

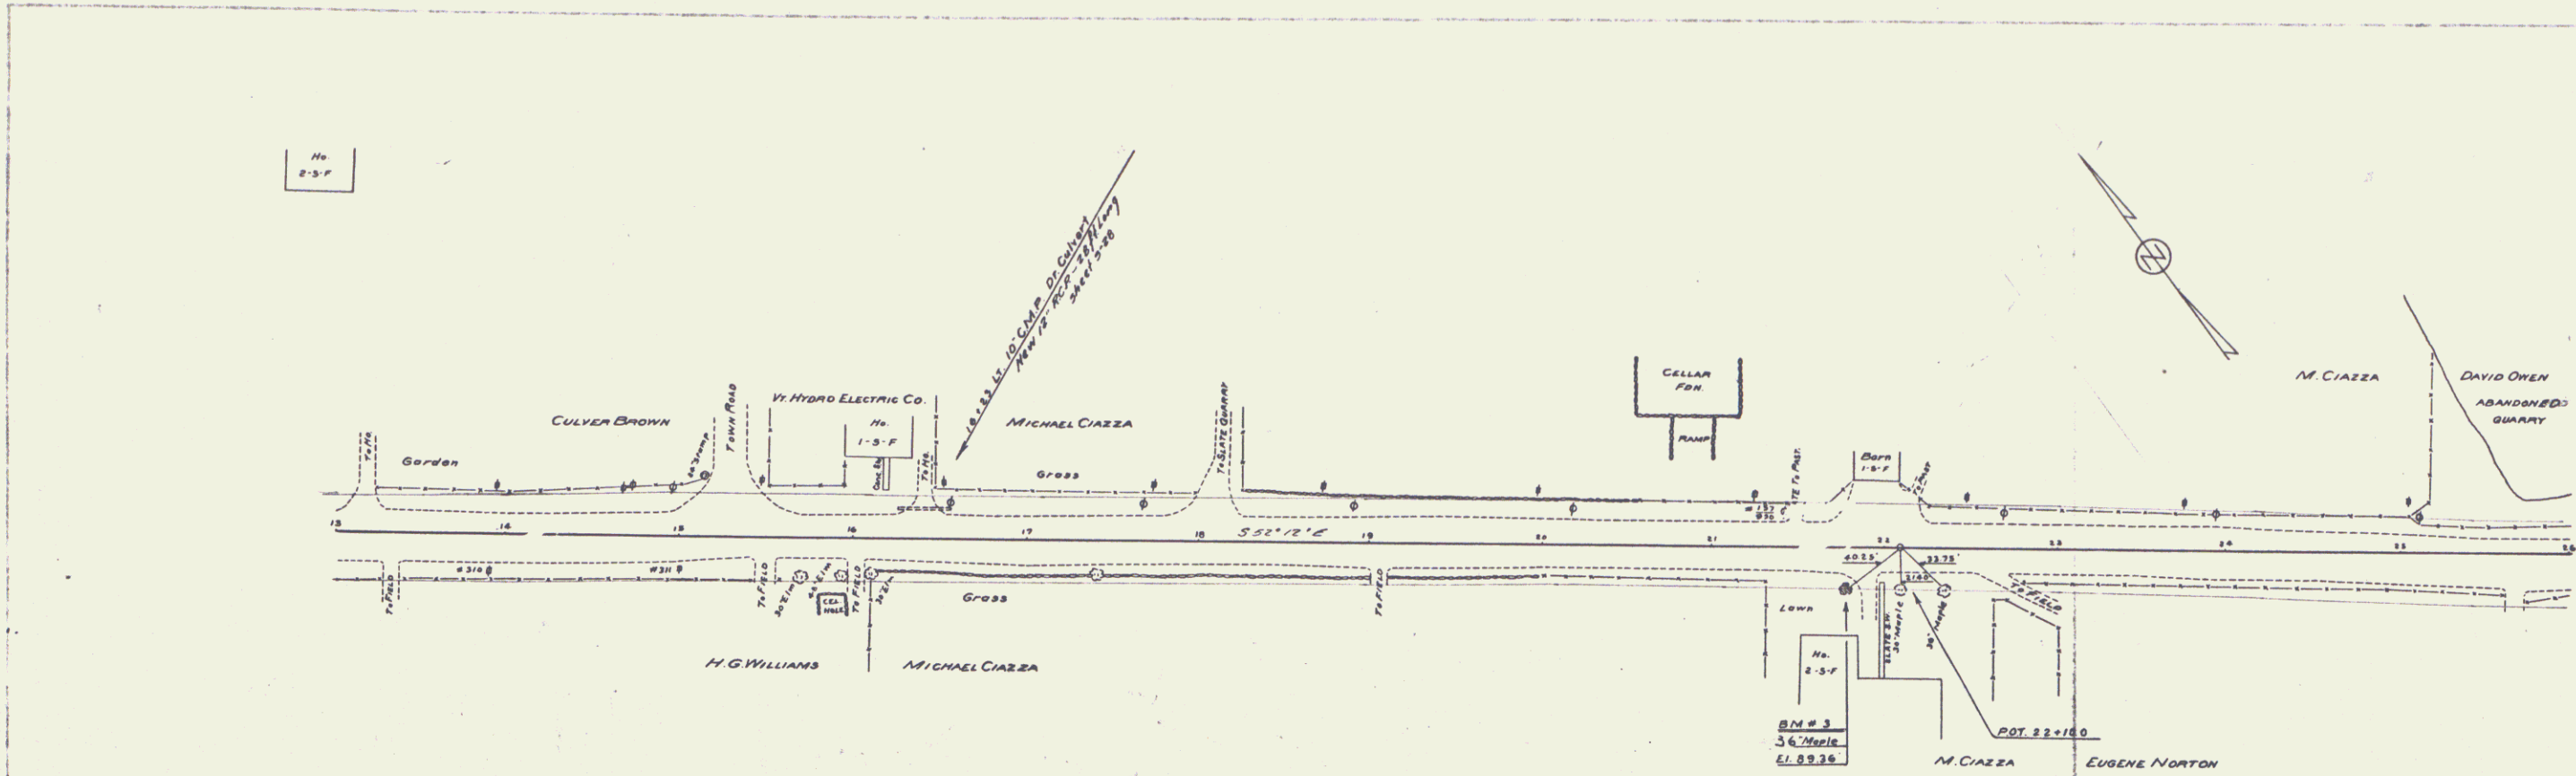

B.M. "3 SPIKE IN ROOT OF 36" MAPLE 21' RT OF STR. 2175 ELEV. 89.36

3