


PLAN
 DATE: 1912
 DRAWN BY: [Name]
 CHECKED BY: [Name]



PROFILE
 DATE: 1912
 DRAWN BY: [Name]
 CHECKED BY: [Name]

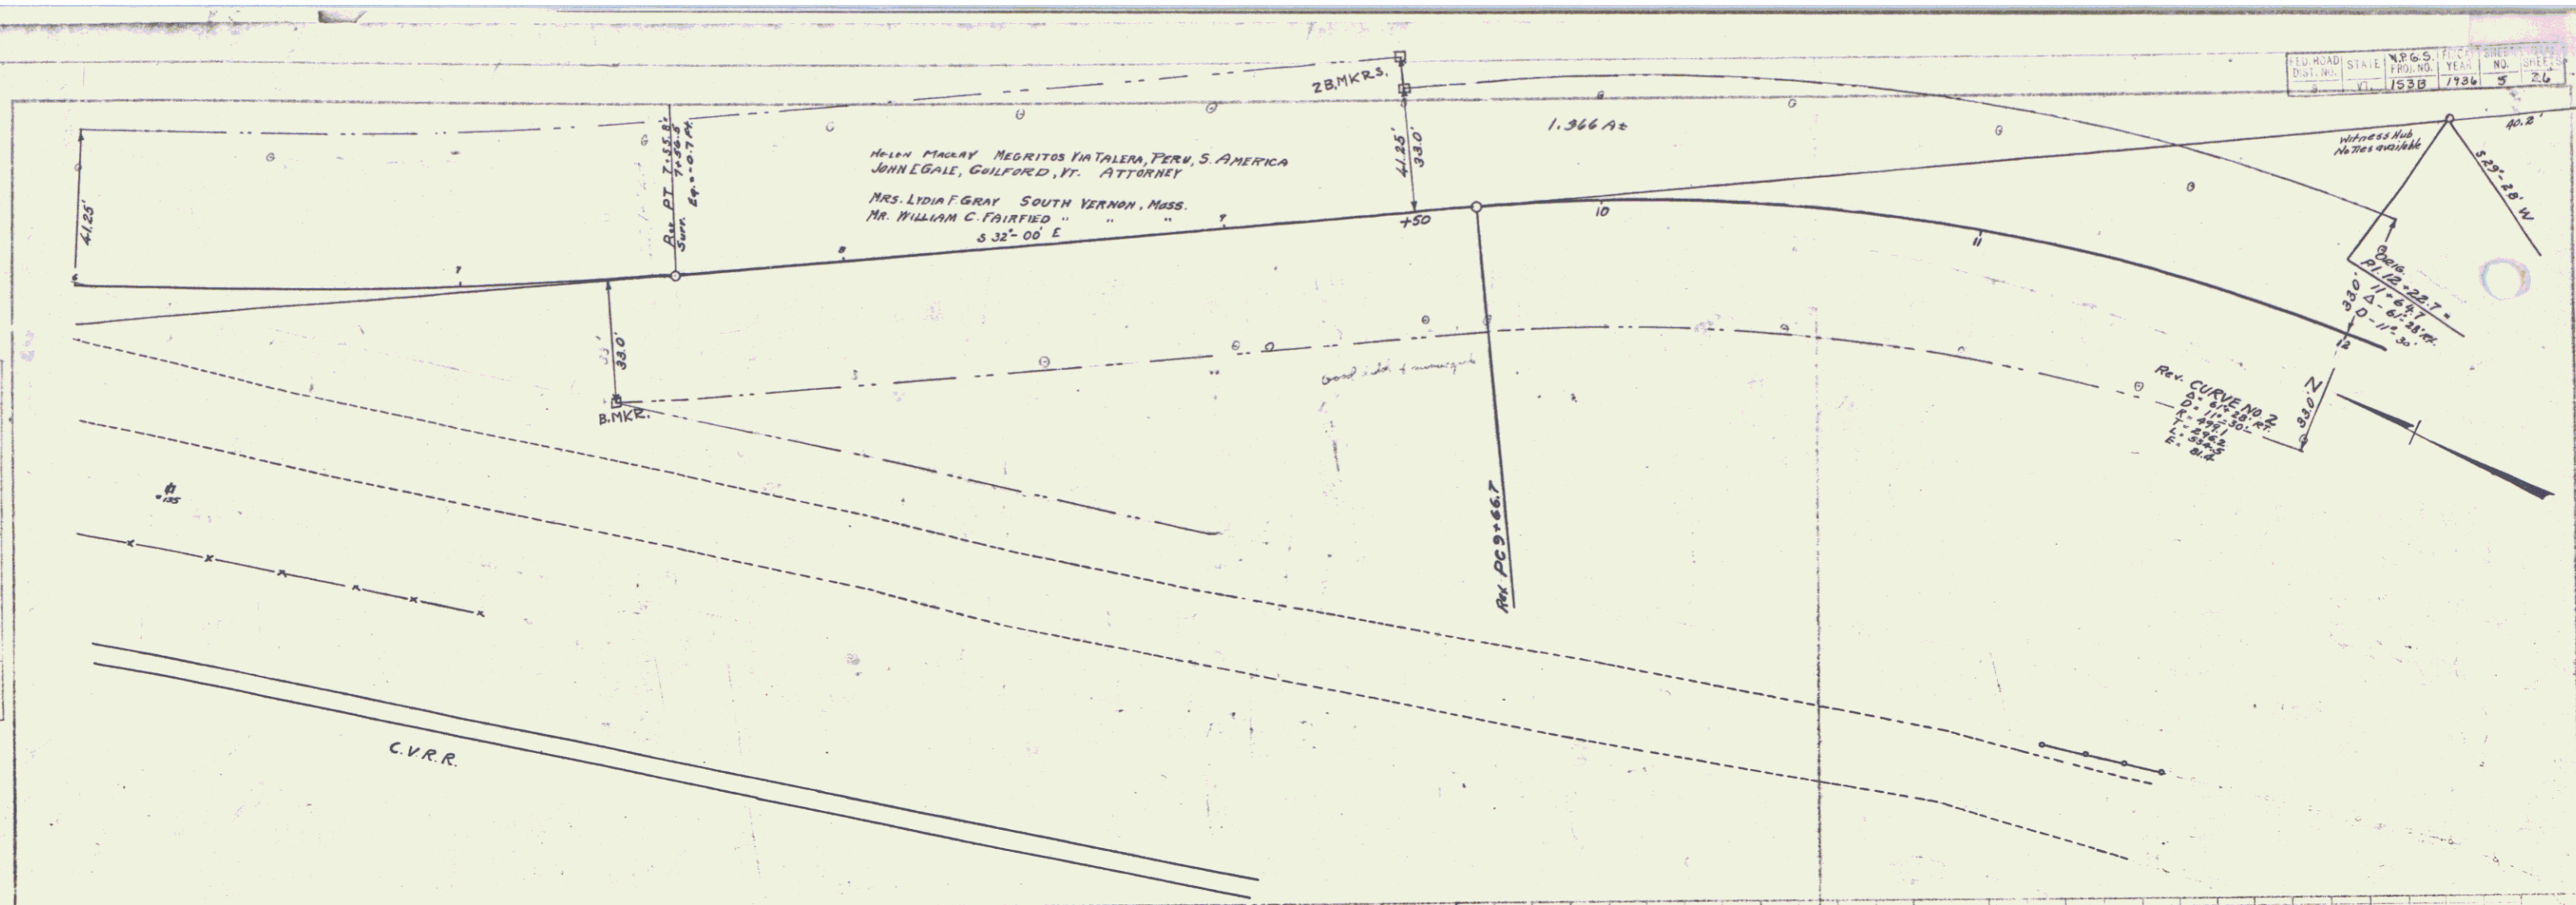