
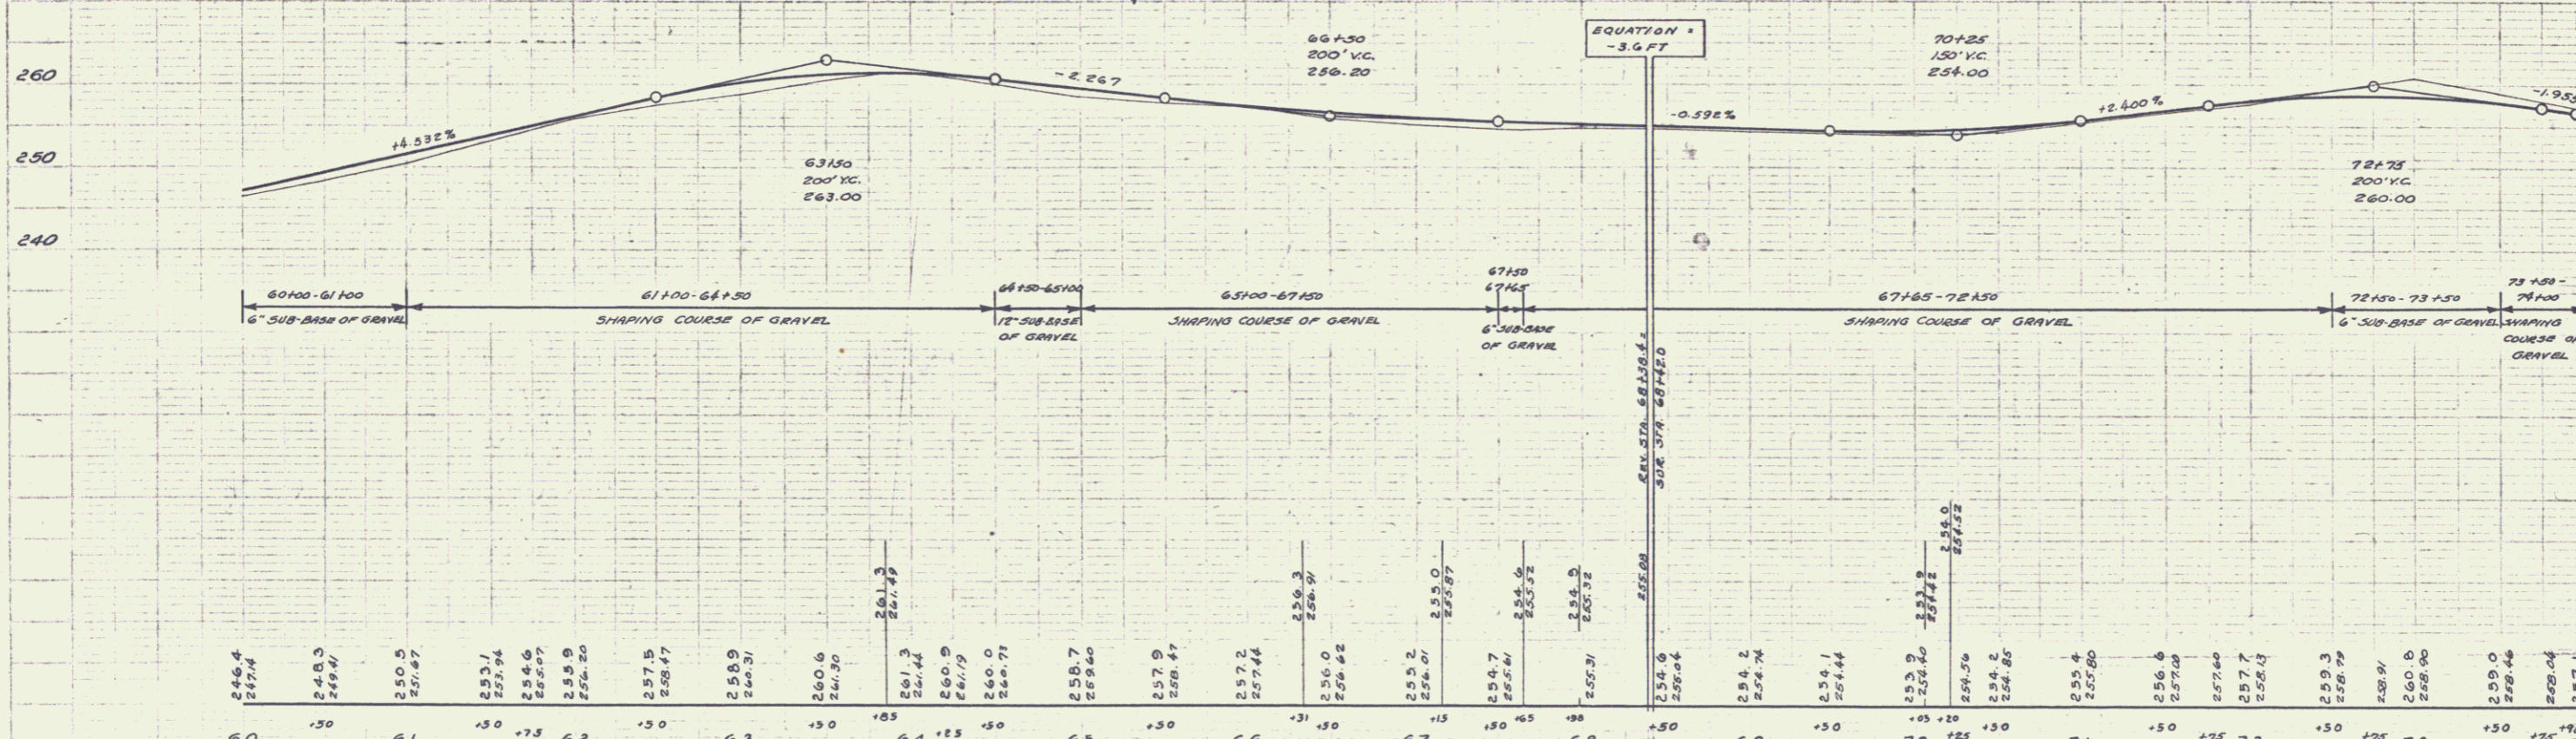


CULVERT QUANTITIES		GUIDE POSTS			
STA	DIAM/LENGTH	C.R.M.	EXCAVATION	LT	RT
60+31	18" 64'	15	7.2	1	
70+15					2
72+02-72+66					5
2" Dia. Manhole		Size	Repat		
60+28	1/0	0.1	18	58	1
GUIDE POSTS		LY	RY	STA	
60+42-60+74	16			67+02	1
60+82-60+96	16			67+08	1
61+01-61+66	7			71+84	1
				70+20	2
67+16-71+76	Reinforced Concrete	4.8	18.8		

A.D. Moore  
 Civil Engineer  
 No. 1000  
 St. Paul, Minn.

A.D. Moore  
 Civil Engineer  
 No. 1000  
 St. Paul, Minn.

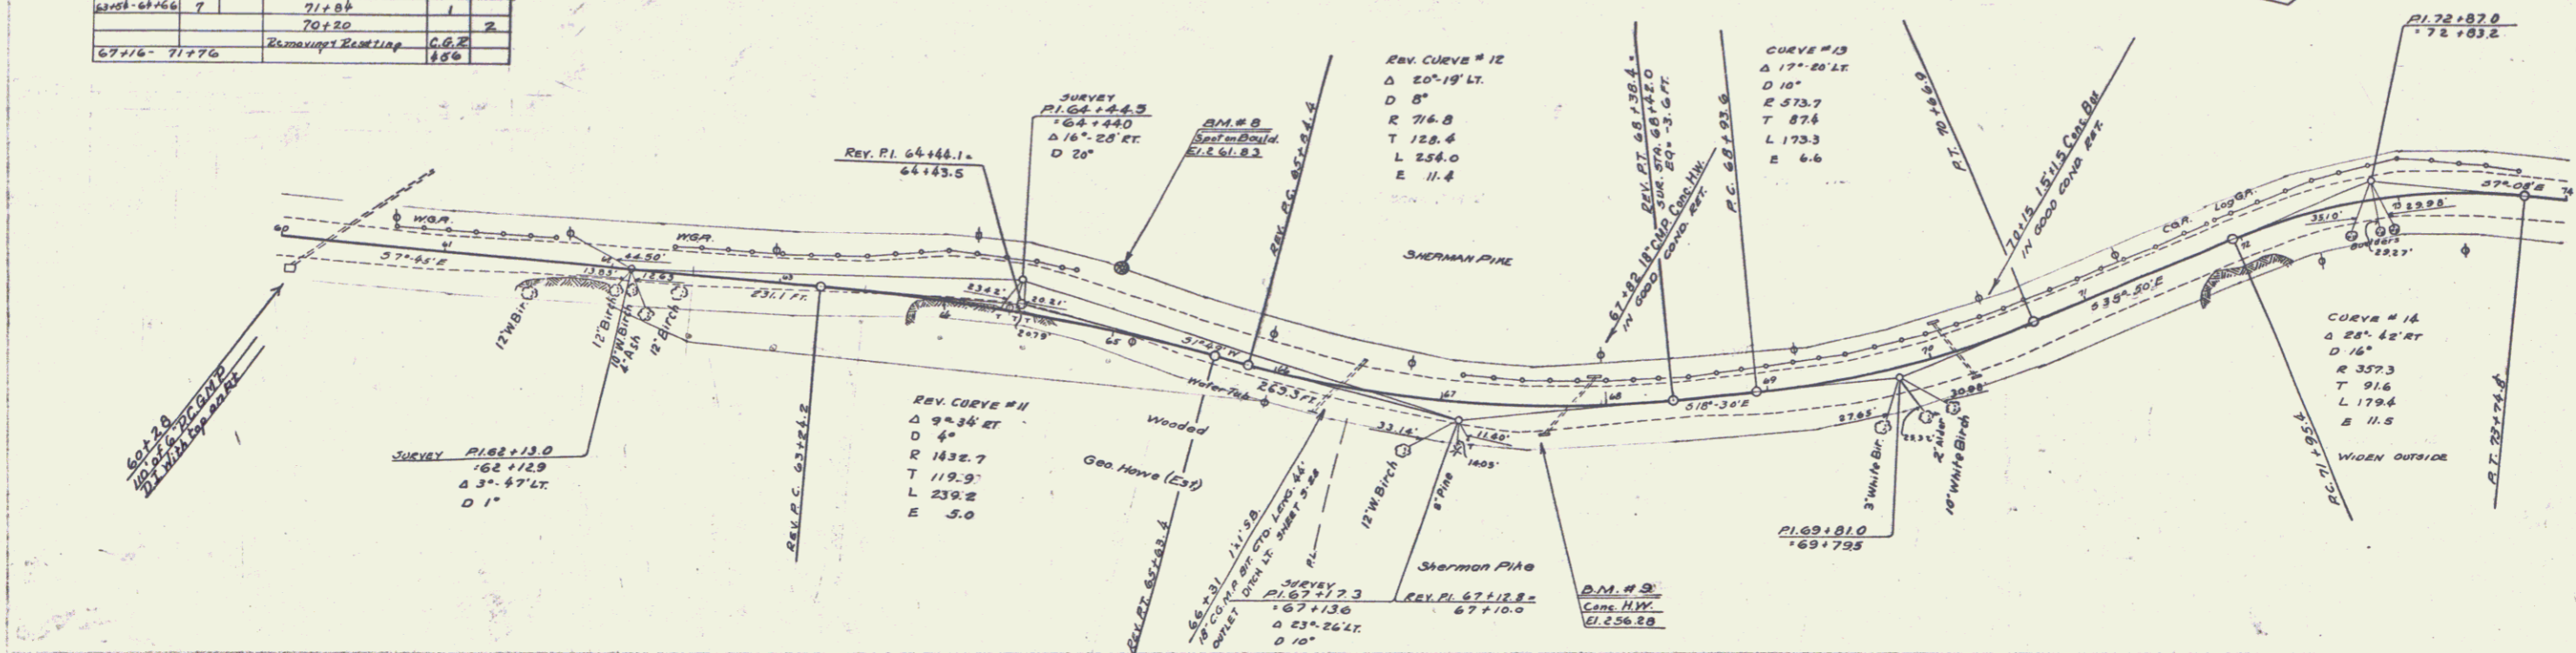

B.M. # 8 Paint Spot on 4 Yr Boulder 21' Lt Sta 64+97 Elev. 261.03  
 B.M. # 9 Paint Spot on Conc. Cully. H.W. 17.5' Ft. Sta. 67+63 Elev. 256.28

6