
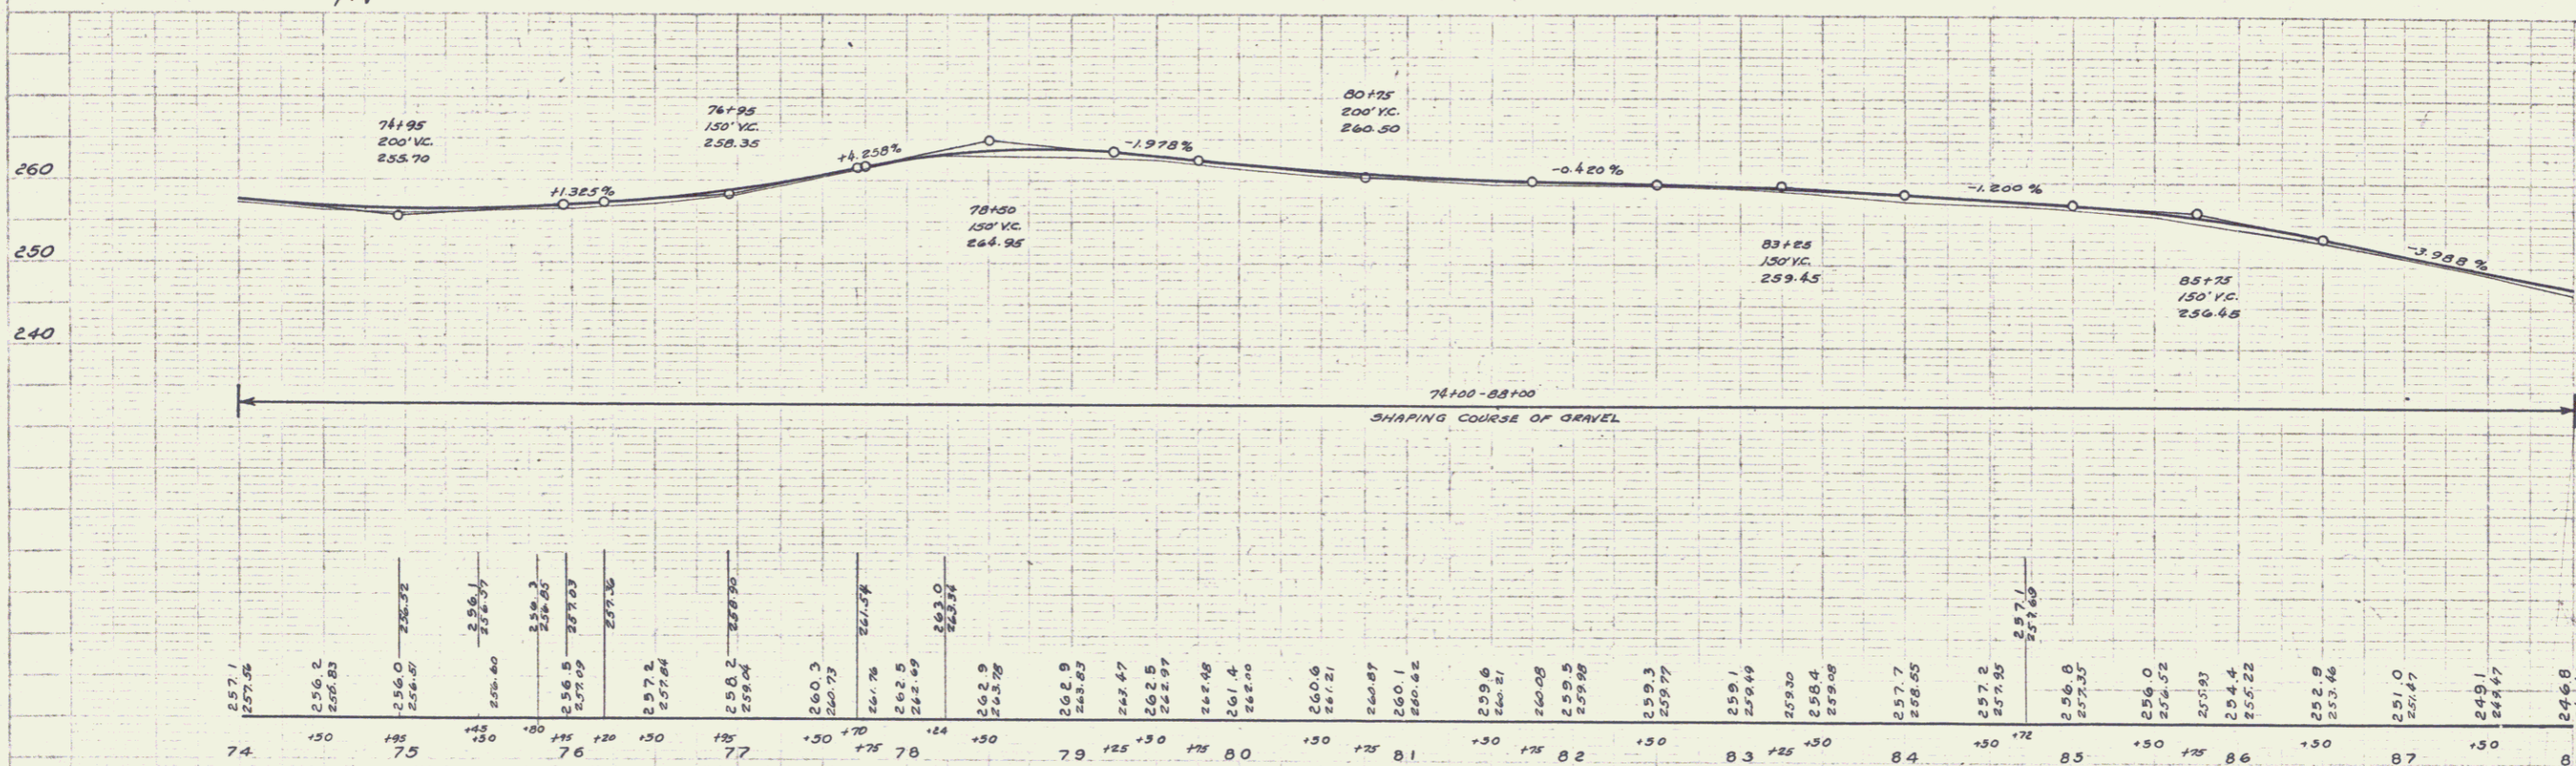


STA	CULVERT QUANTITIES		GUIDE POSTS		PLANNING & BULKHEADS		
	W.C. PERSON	C.R.M.	Excavation	LT	RT	Sta	LR
75+45	24"	16"	51	-	2	74+36	120
81+75	18"	16"	38	1	1	76+0	304
						79+20	

NRS
153 1933 9 54

PLAN
A.D. Wood
F.W. Hayward
8/12/33

PLAN
A.D. Wood
F.W. Hayward
8/12/33

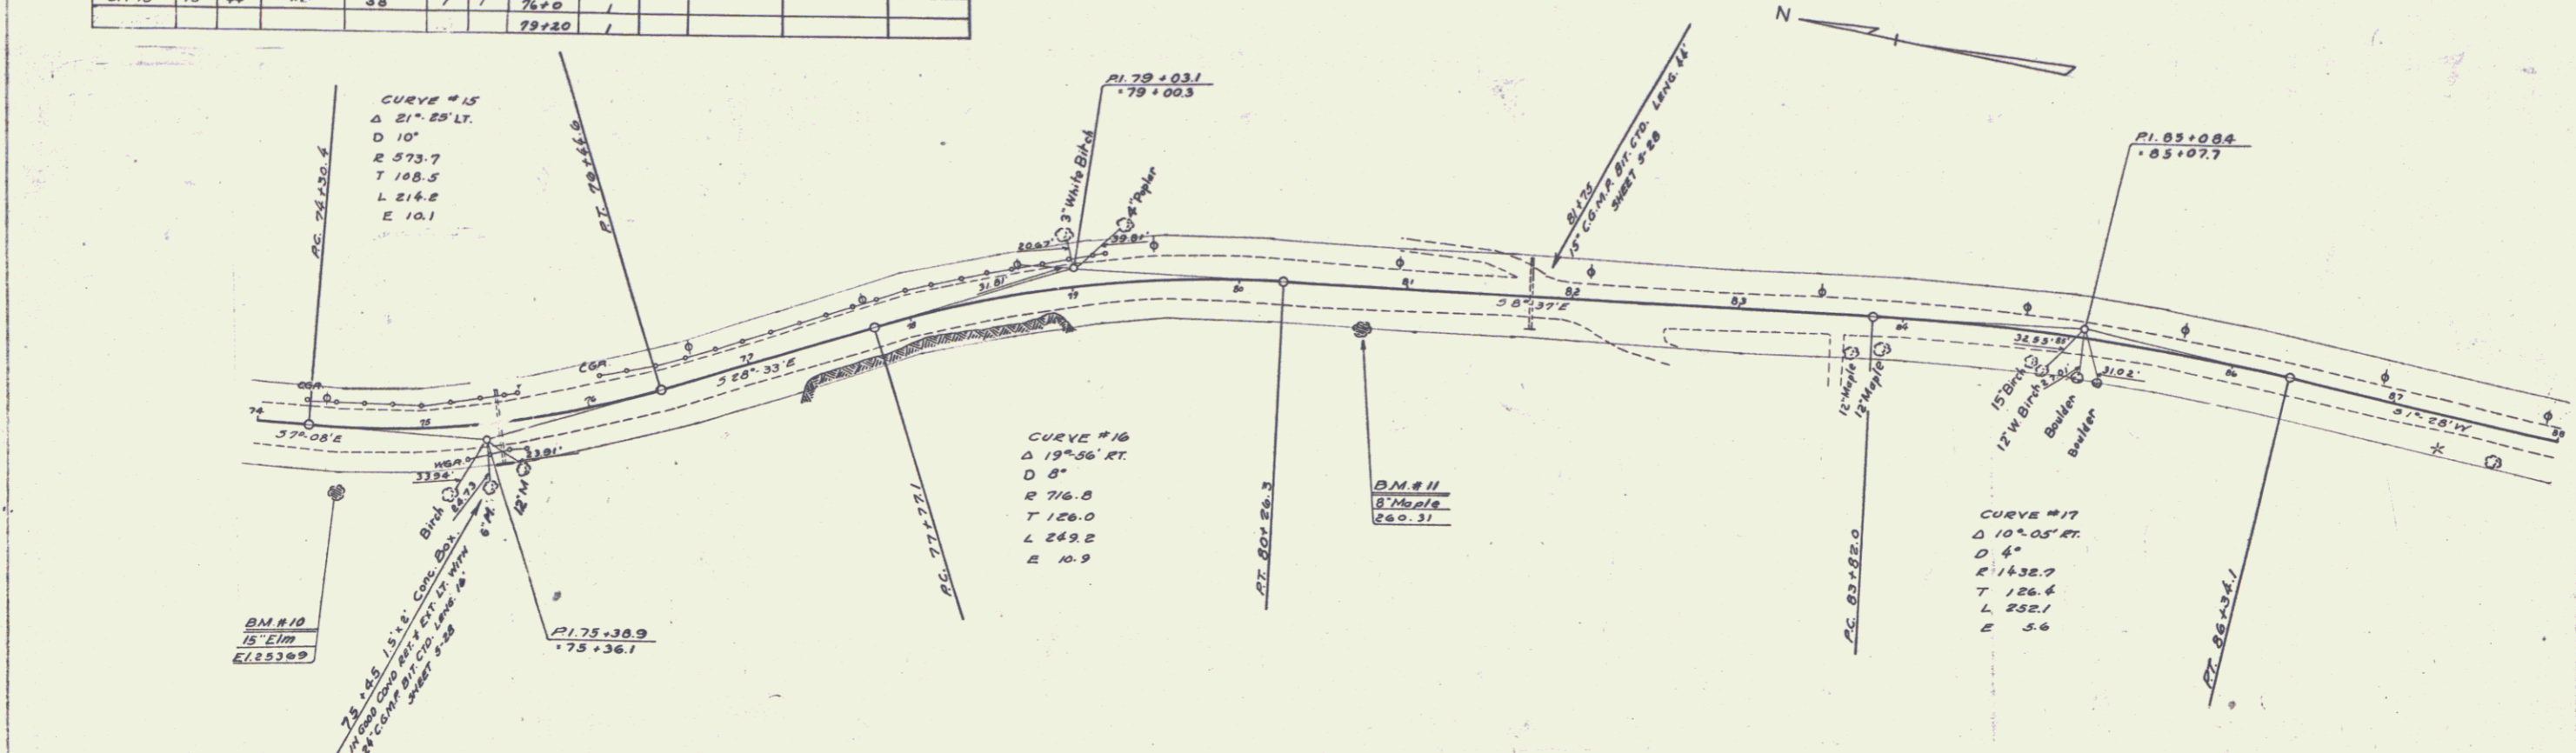

BM. #10 Spike in Root of 15' Elm 36' Rt. Sta. 74+50 Elev. 253.69
 BM. #11 Spike in Root of 8' Maple 21' Rt. Sta. 80+75 Elev. 260.31

SERIES NRS NO. 153
SHEET 9 OF 54