
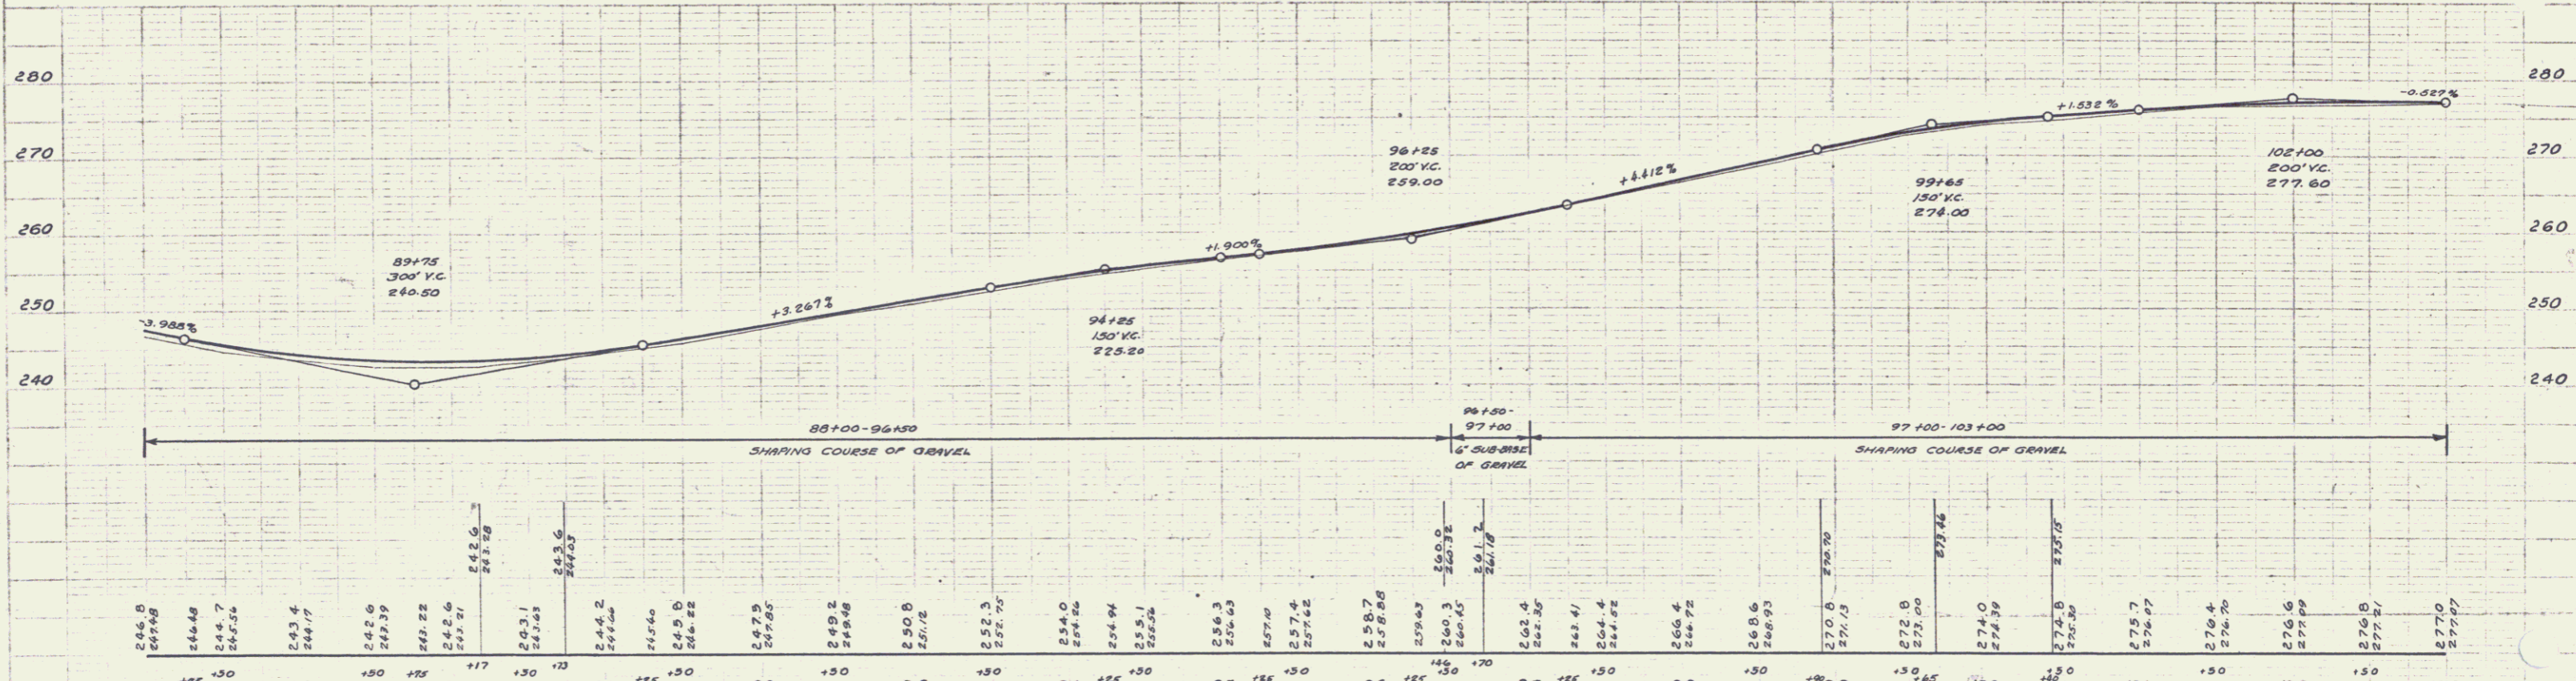


Summary of Readings C.G.P.			
STA.	CULVERT QUANTITIES	GRADE DATA	...
...
96+48
99+25-9106
99+75
99+22
101+22
102+16
88+42

DIST. NO. STA. N.E.S. TOTAL SHEET NO. OF SHEETS
 153 1931 10 54

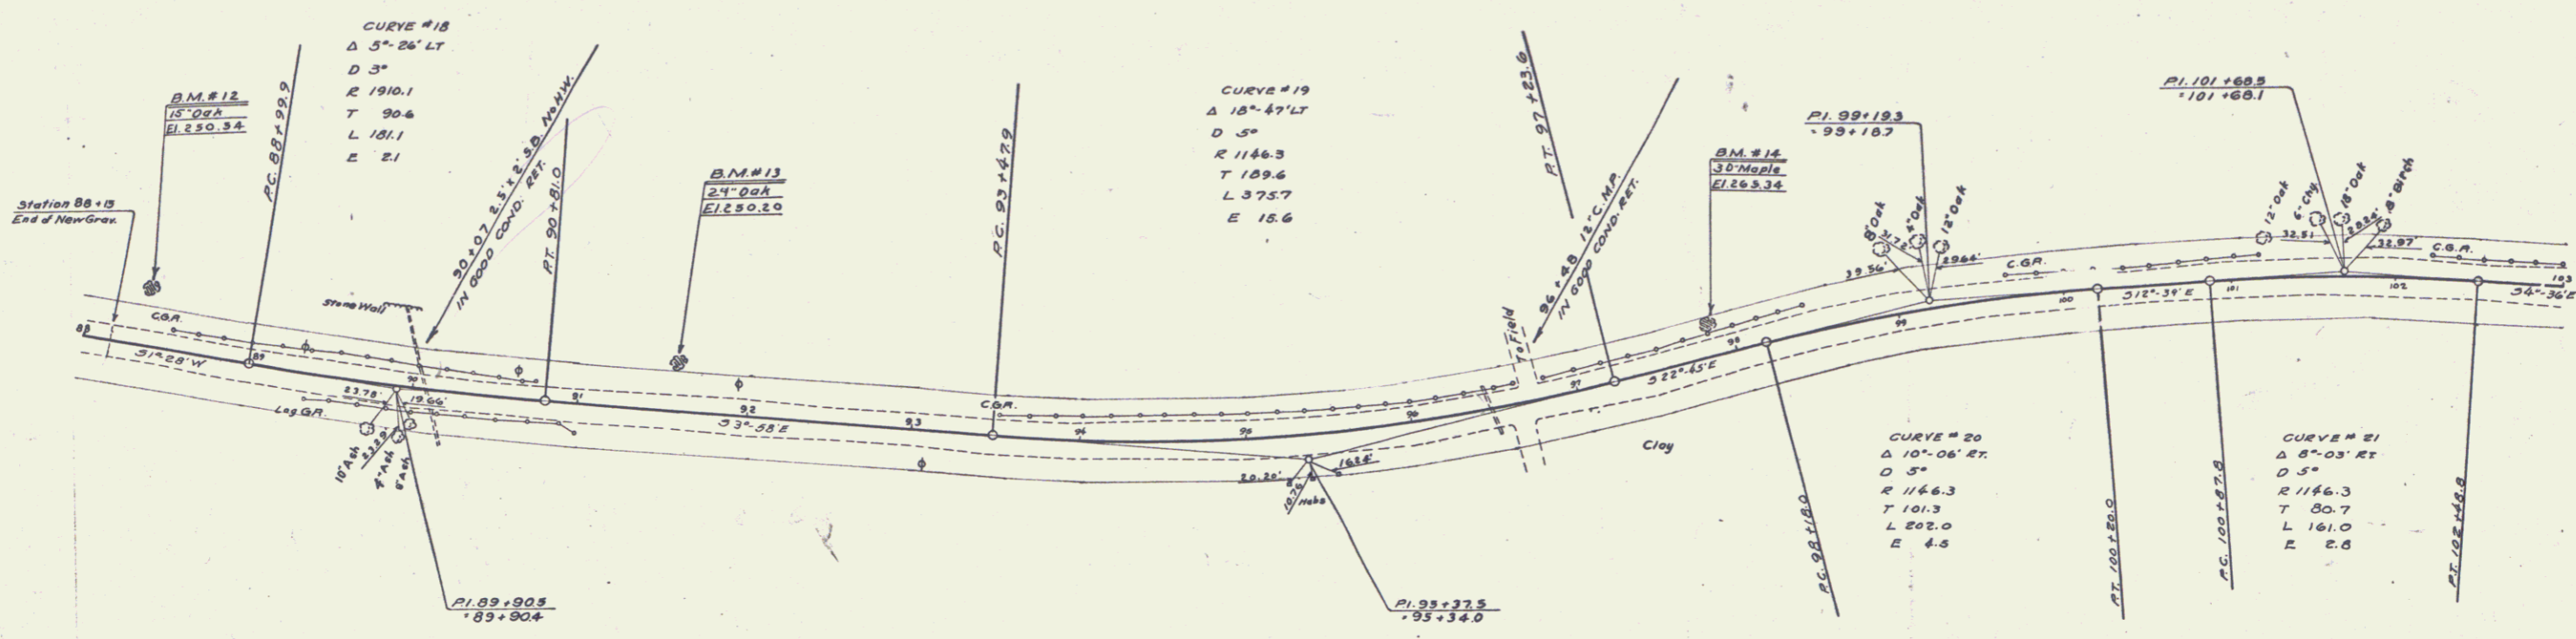

B.M. #12 Spike in Root of 15' Oak 31.5' Lt. Sta. 88+34 Elev. 250.54
 B.M. #13 Spike in Root of 24' Oak 25' Lt. Sta. 91+56 Elev. 250.20
 B.M. #14 Spike in Root of 30' Maple 16.5' Lt. Sta. 97+56 Elev. 265.34

SERIES N.R.S. NO. 153
 SHEET 10 OF 54

PLAN
 A.D. HOOD
 F.W. ANTHONY

PROFILE
 A.D. HOOD
 F.W. ANTHONY

FULL SCALE PROFILE TO 1/4" = 1' VERTICAL

8