
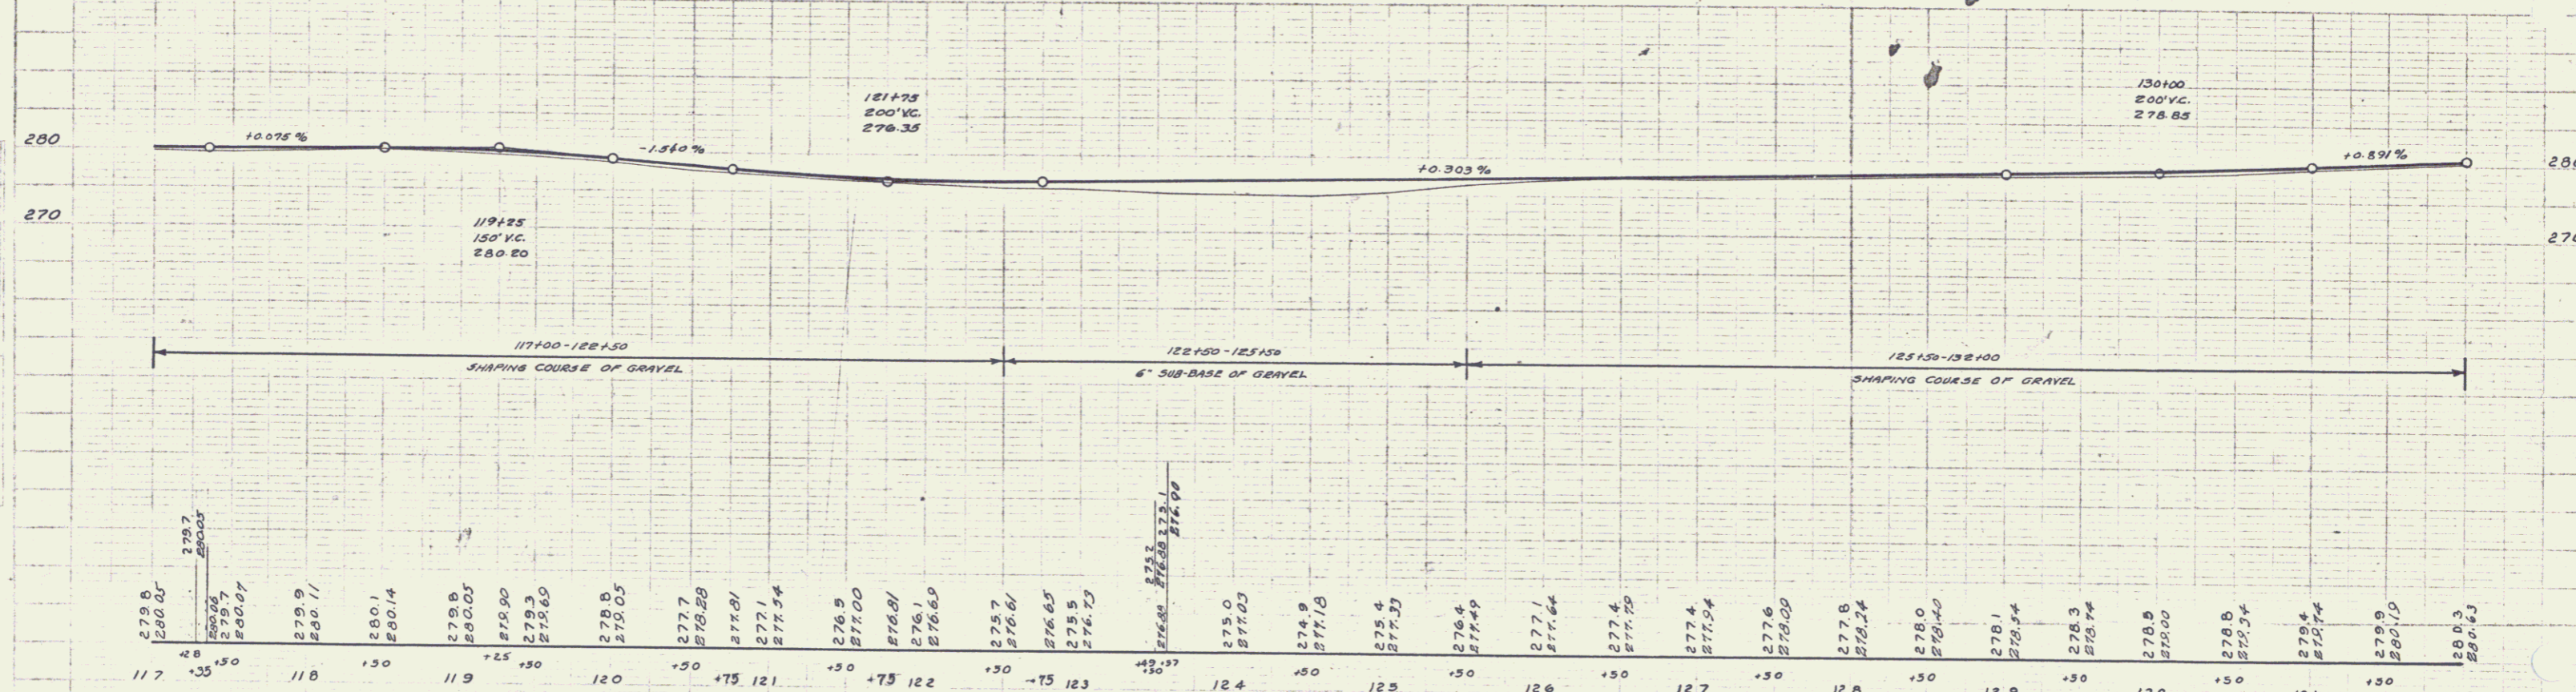


STA	CULVERT QUANTITIES		Grade Posts	
	Excavation	Excavation	LT	RT
127+29	15" 64'	1.9	3.1	- 2
128+75			2.0	
128+85				6
126+85 - 127+29				17

N.E.S. SHEET NO. 153
 193 12 54

A.D. Wood
 P.M. Hartman
 9/12/33

A.D. Wood
 P.M. Hartman
 9/12/33

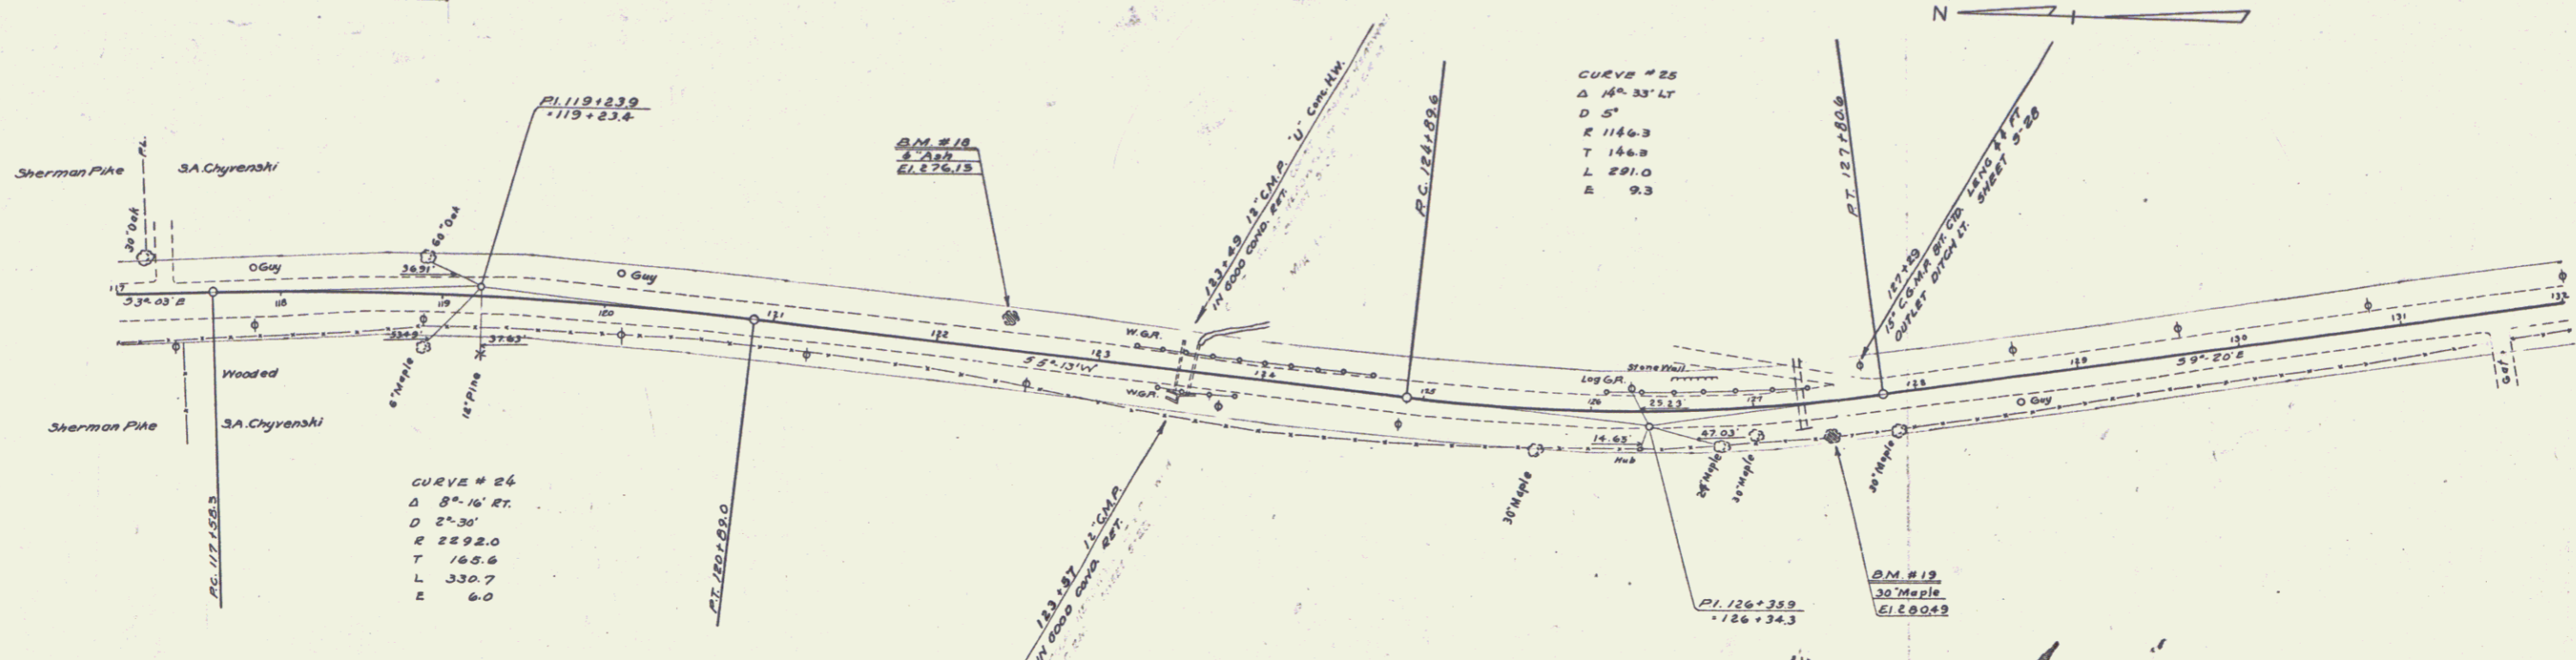

B.M. # 18 Spike in Root of 6' Ash 15' Lt. Sta. 122+41 Elev. 276.15
 B.M. # 19 Spike in Root of 30' Maple 17' Rt. Sta. 127+44 Elev. 280.49

SERIES N.E.S. NO. 153
 SHEET 12 OF 54