


CULVERT QUANTITIES					DRAINAGE		
STA.	CULVERT	C.R.M.	EXCAVATION	LT.	RT.		
178+00	15' x 36'	2.7	17	2	1		

N.R.S. NO. 153  
SHEET 16 OF 54

AD. Wood  
 P.M. Hartman  
 8/19/53

A.S. Johnson  
 F. Hartman  
 8/19/53

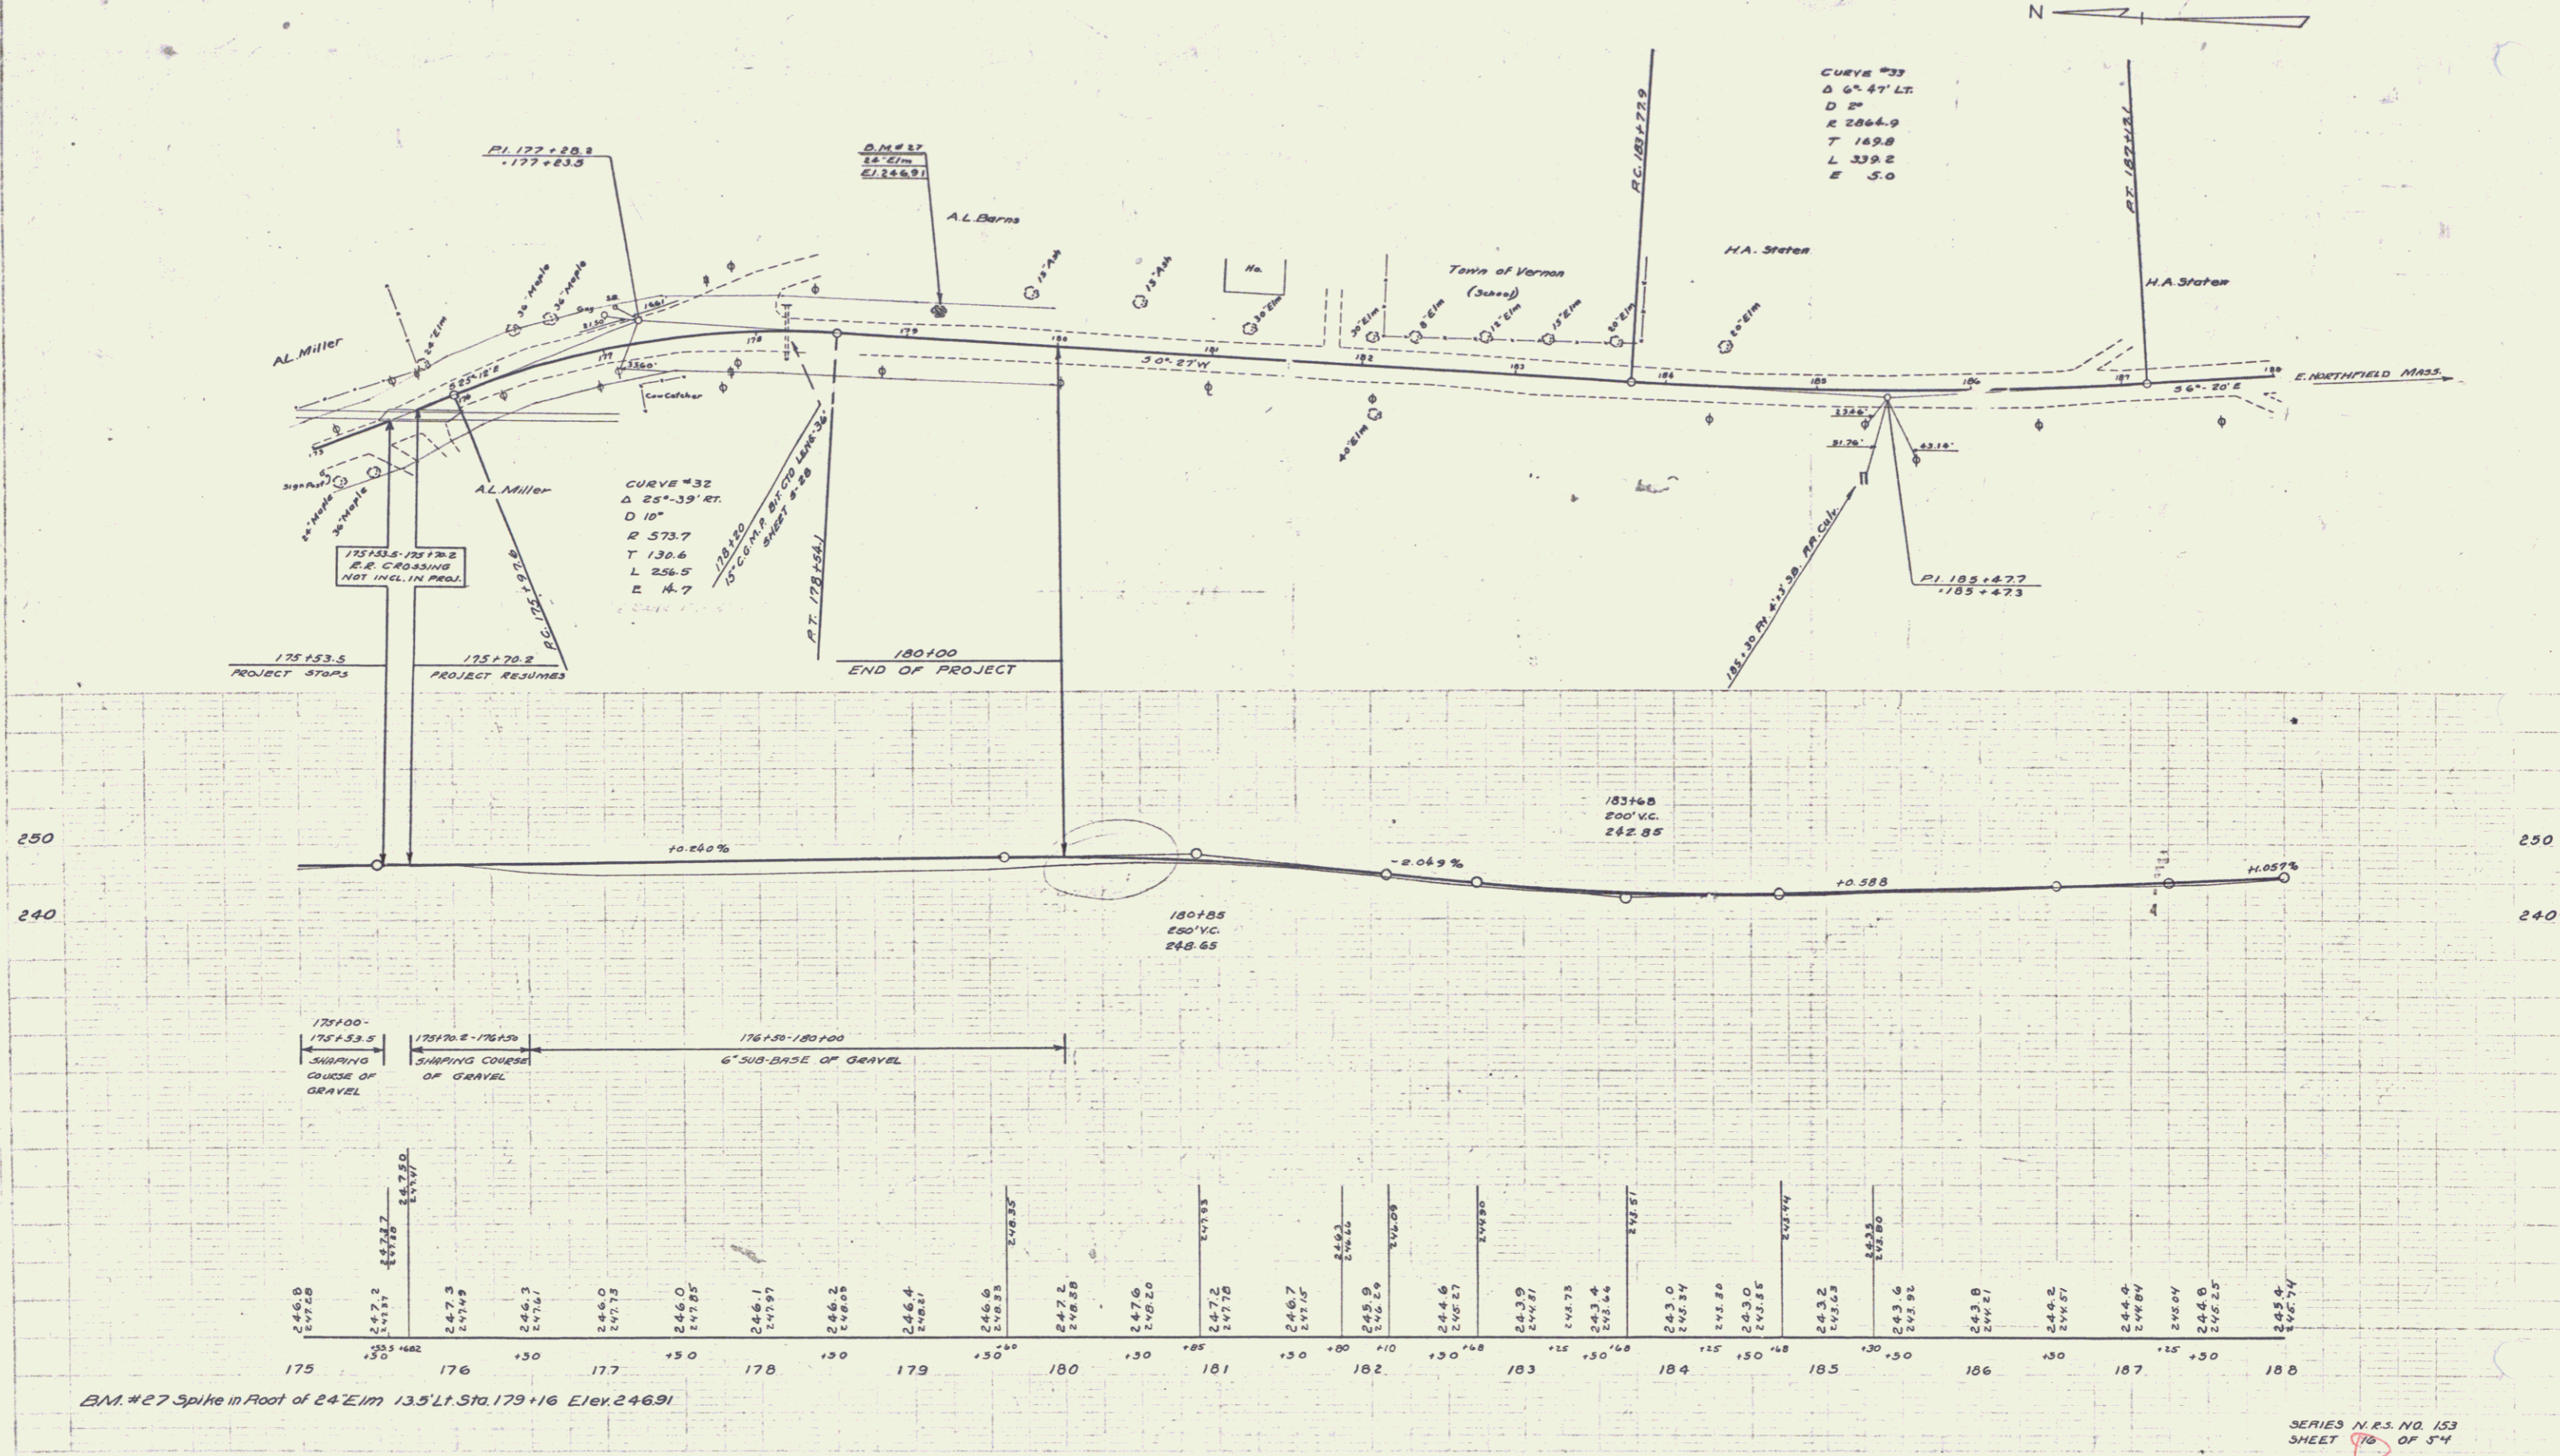

SERIES N.R.S. NO. 153  
SHEET 16 OF 54