
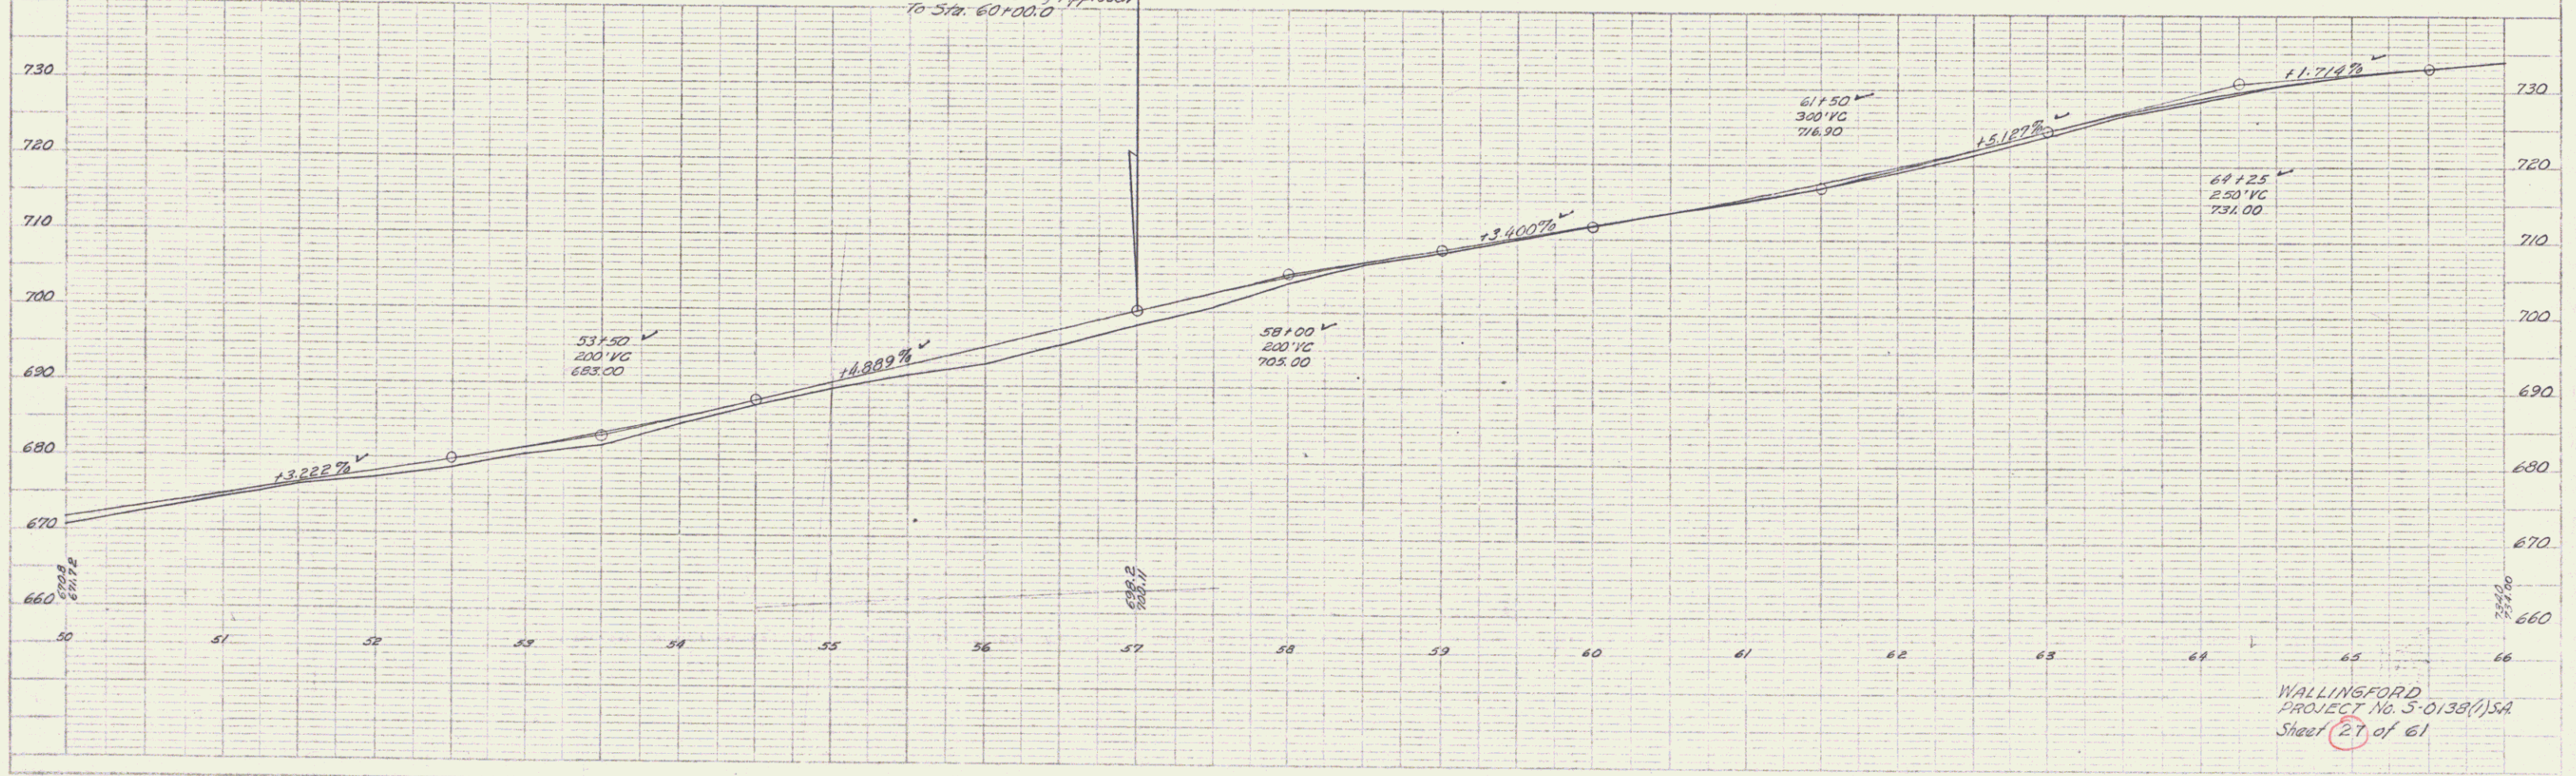


PLANT 17 OWNERS: JAMES E. DODD, JR.  
 4800 S. 11th St. - FISH KILL, N.H.  
 50% SEVERANCE - 50% AS DIRECTED  
 BY THE ENGINEER.

WOOD GUIDE POSTS  
 Item 518-A  
 44- 44-  
 55-58 55-58

CONSTRUCT DRIVES  
 LA PA  
 51+25 ✓  
 55-60 ✓  
 58+50 ✓  
 59+95 ✓

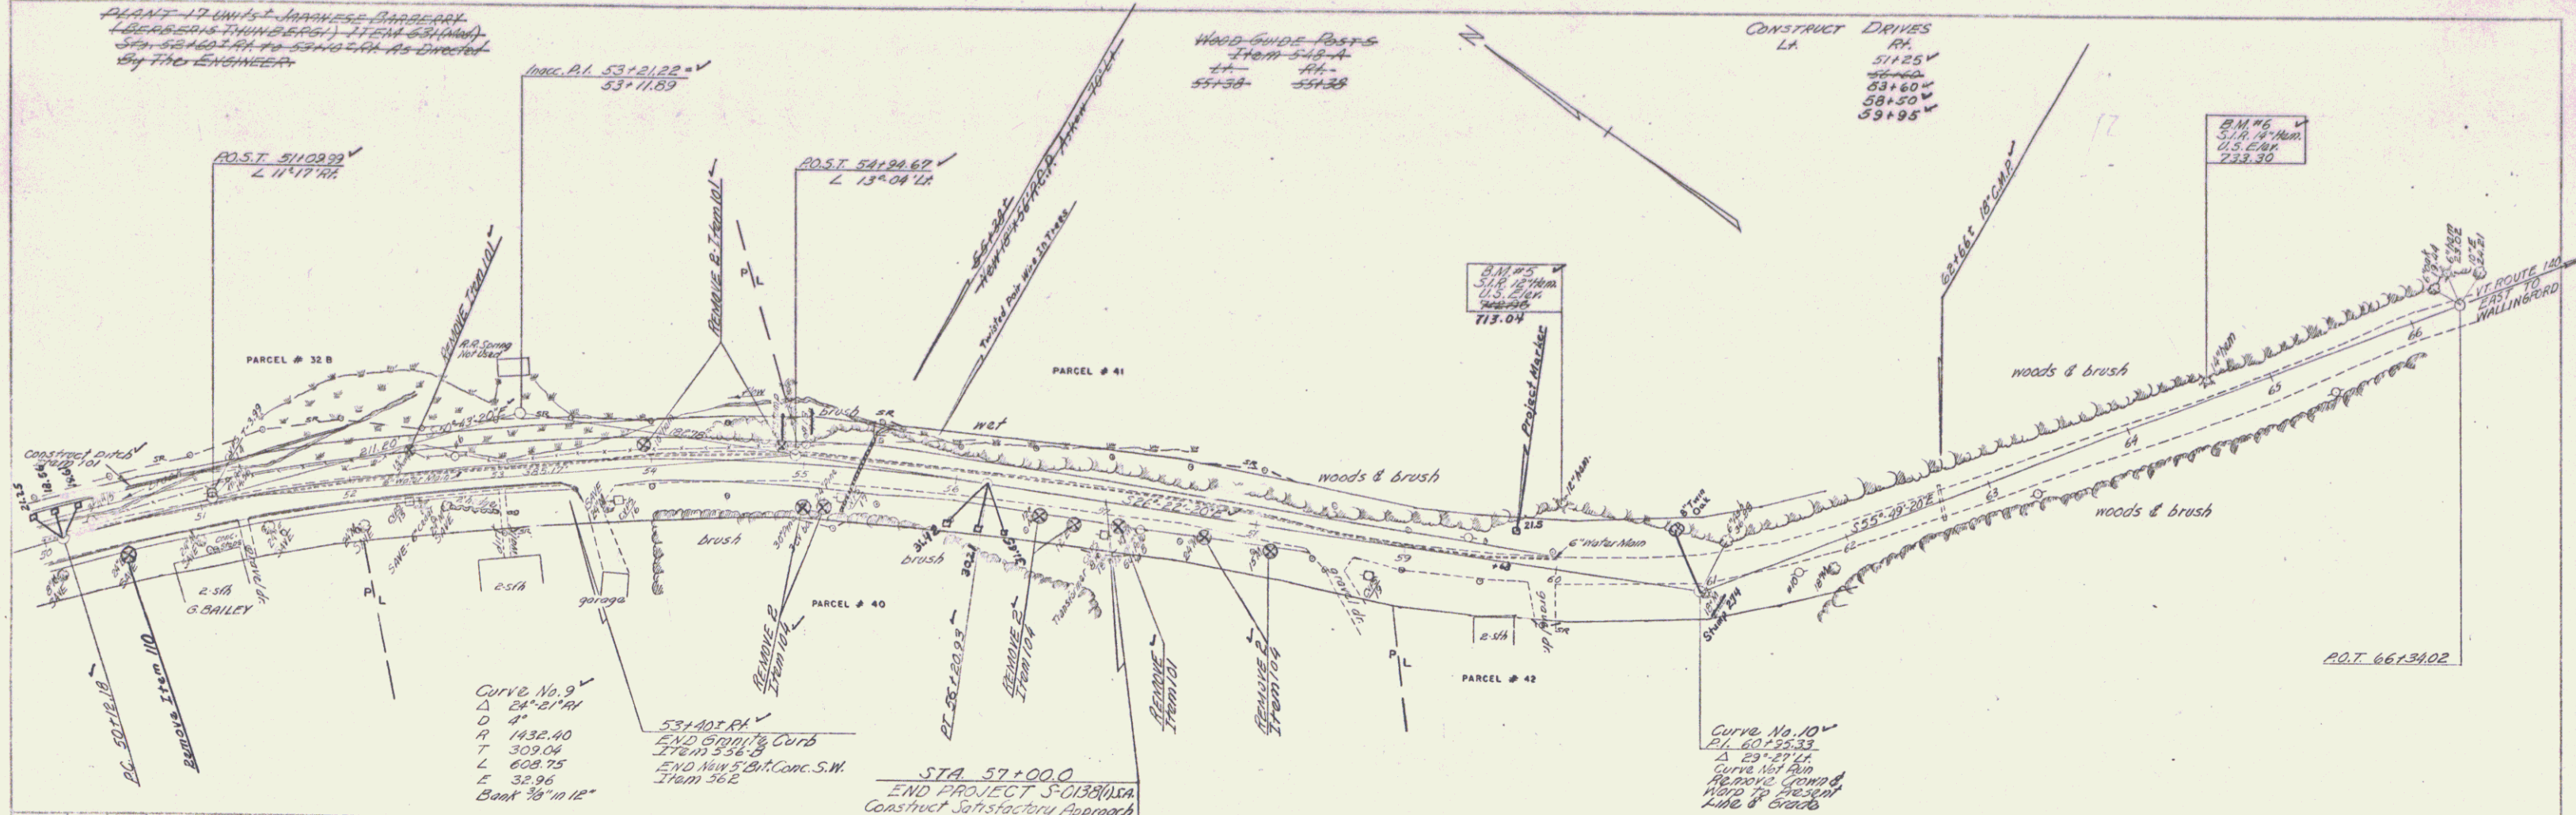

WALLINGFORD  
 PROJECT No. S-0138(1)SA  
 Sheet 27 of 61