



POOR ORIGINAL COPY

PLAN
 DATE: 1/1/87
 DRAWN BY: H. COVINE
 CHECKED BY: H. COVINE
 NO. 4

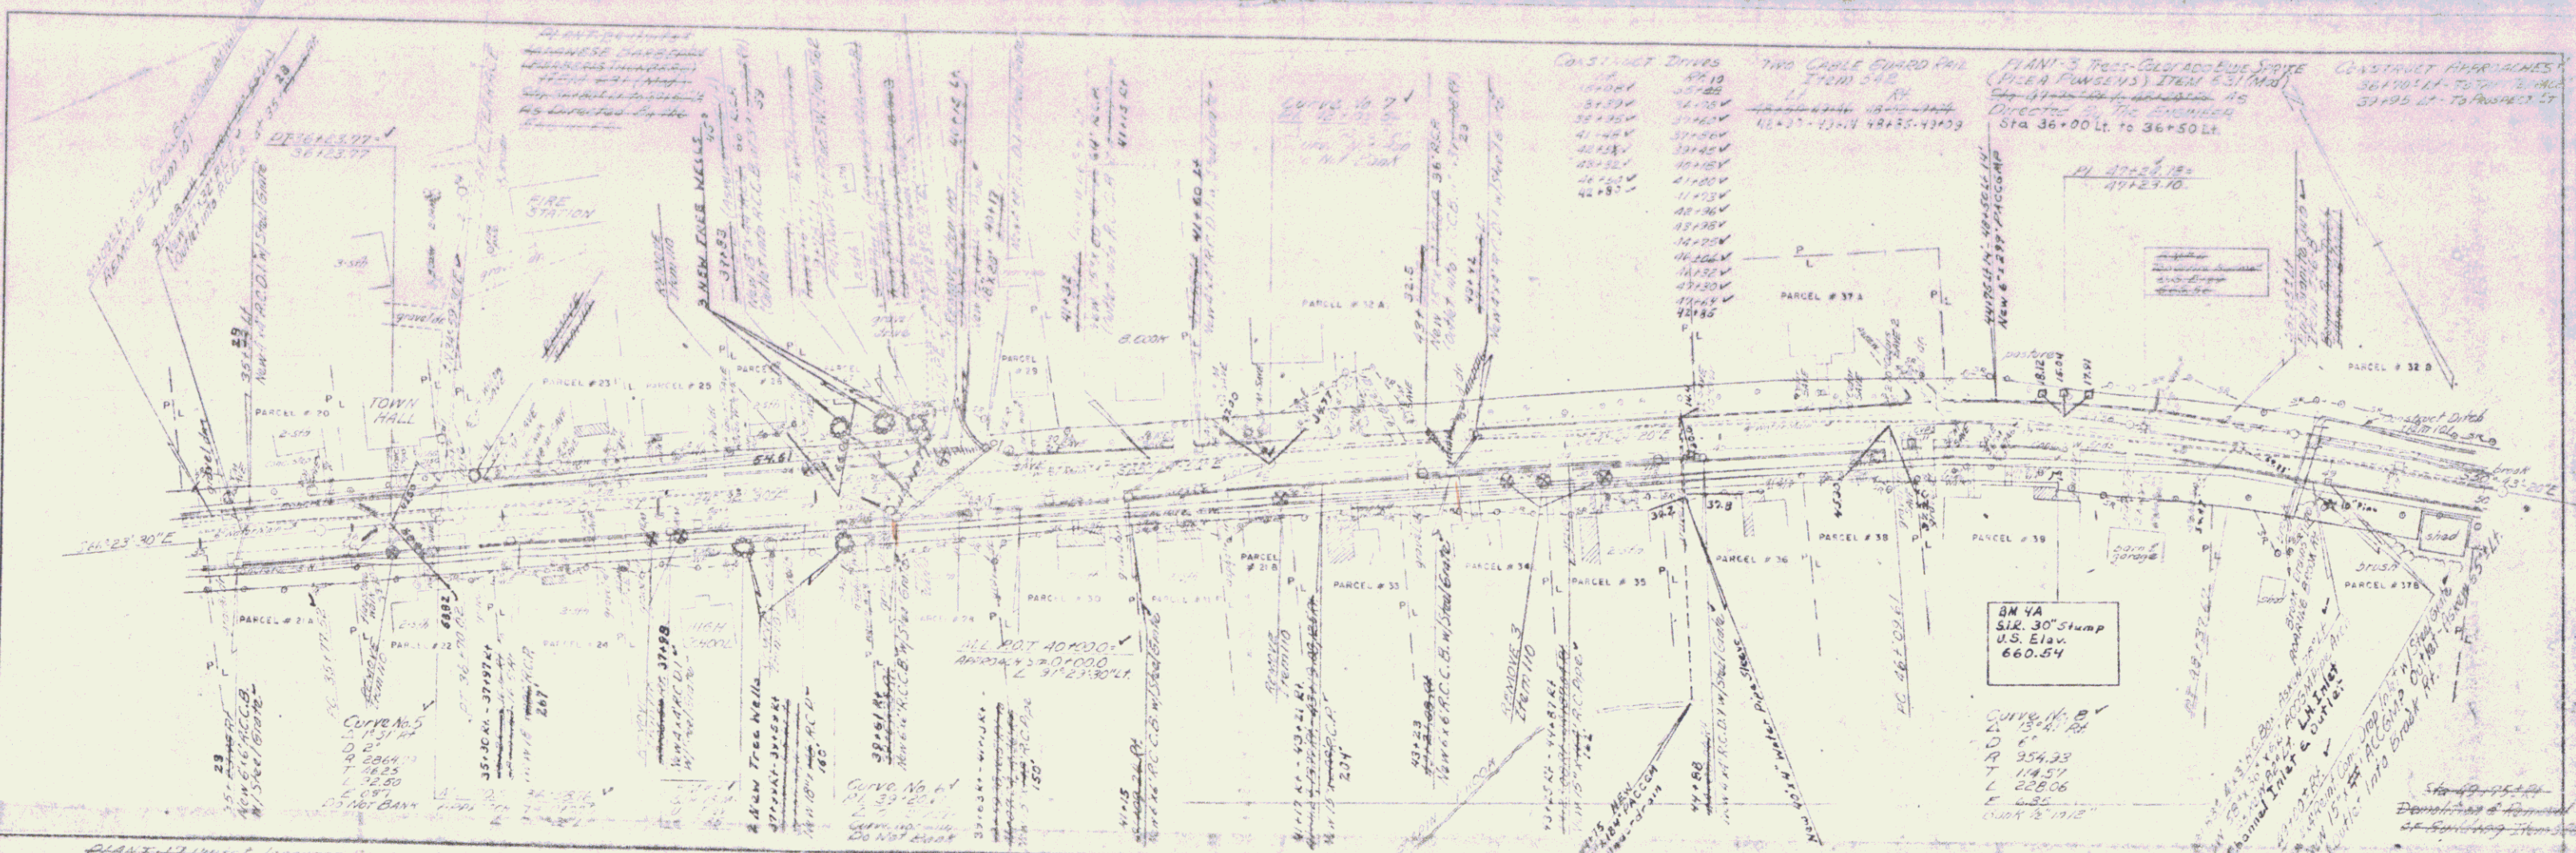

PLAN
 DATE: 1/1/87
 DRAWN BY: H. COVINE
 CHECKED BY: H. COVINE
 NO. 4

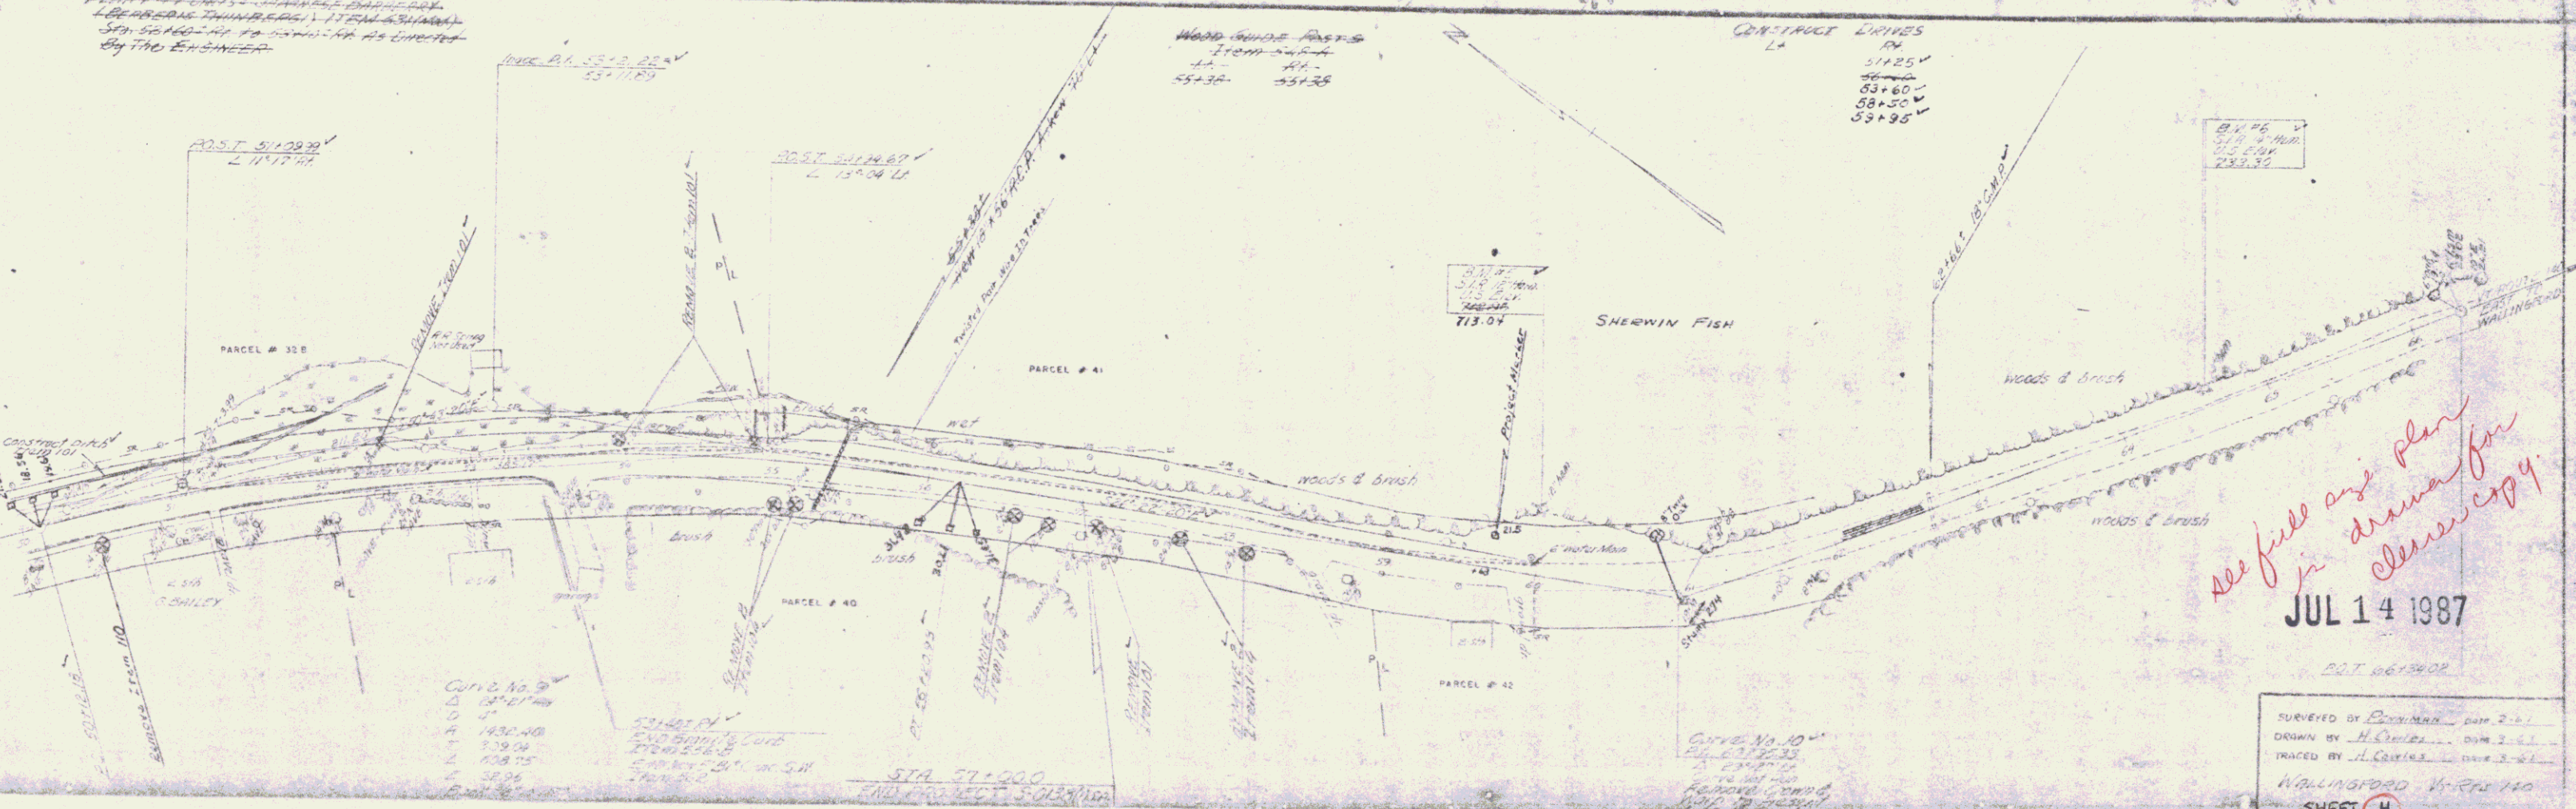

*See full size plan
 in drawer for
 clear copy.*

JUL 14 1987

SURVEYED BY: [unclear] DATE: 2-87
 DRAWN BY: H. COVINE DATE: 2-87
 TRACED BY: H. COVINE DATE: 3-87
 WALLINGFORD, Vt. 05490
 SHEET 4