
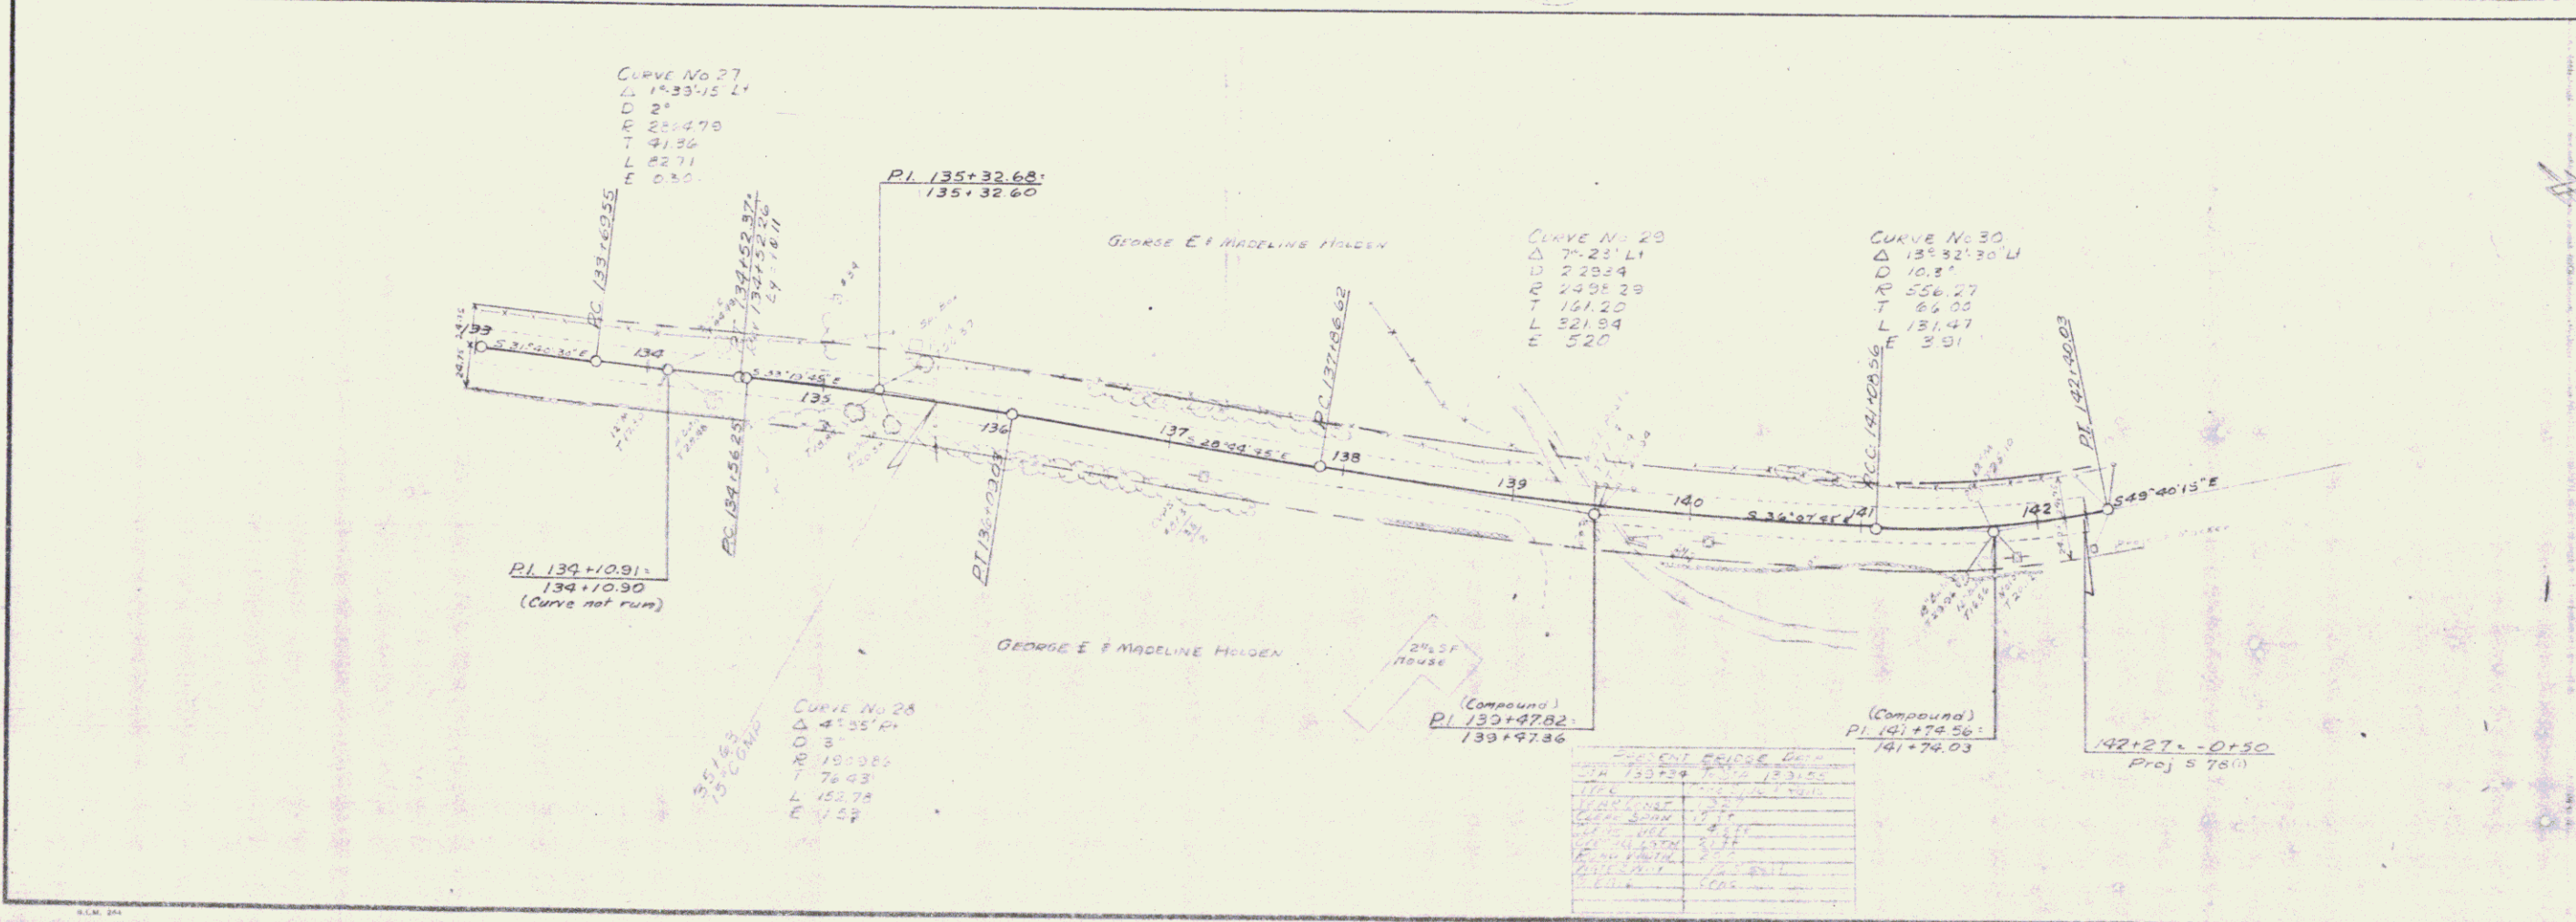


POOR ORIGINAL COPY

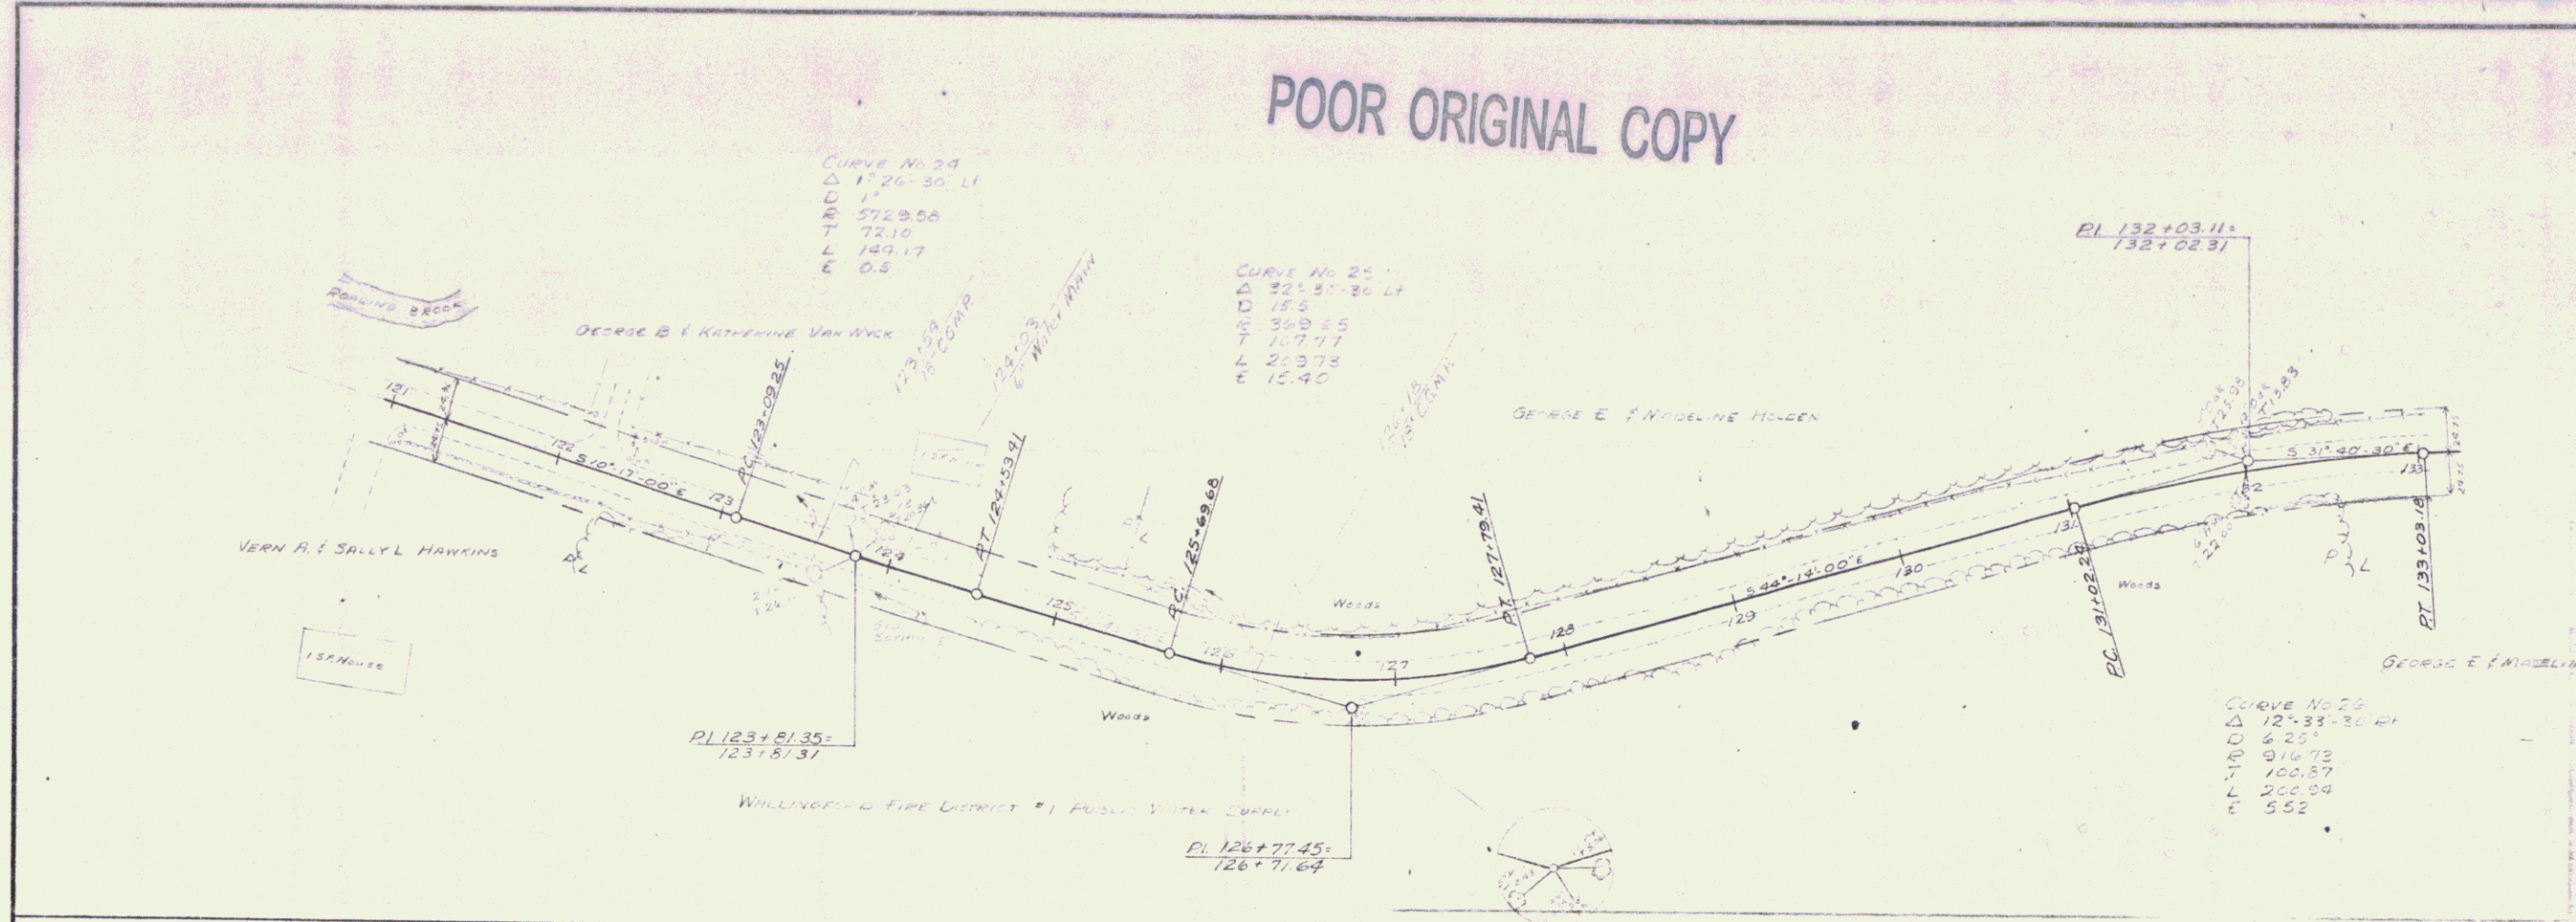

JUL 14 1987

SURVEYED BY Brian DATE 3-82
 DRAWN BY Stifford DATE 6-82
 TRACED BY Stifford DATE 6-82
 WALLINGFORD 14 Rte 100
 PROJ. NO.
 SHEET 7 OF 15