



POOR ORIGINAL COPY

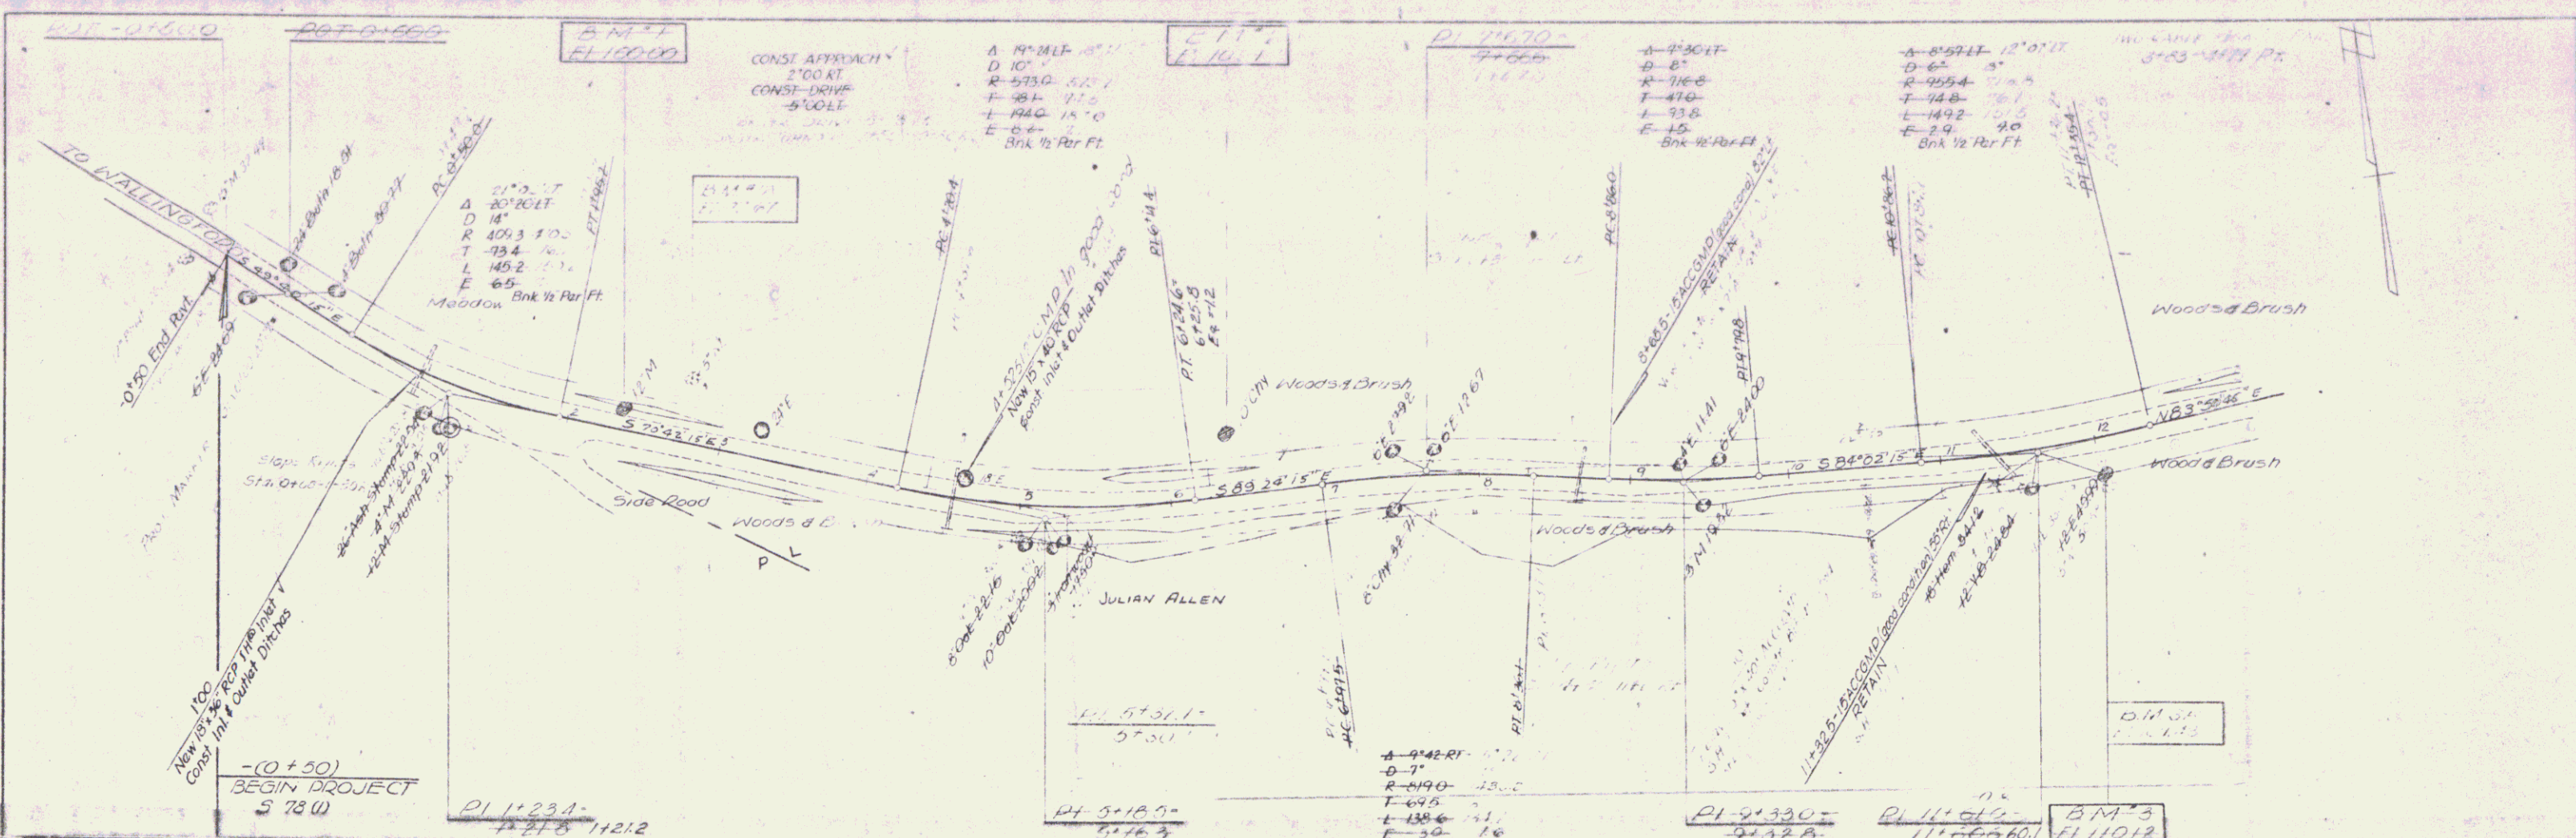

PLAN

DATE	1912
BY	W. J. ...
CHECKED	...
NO.	...

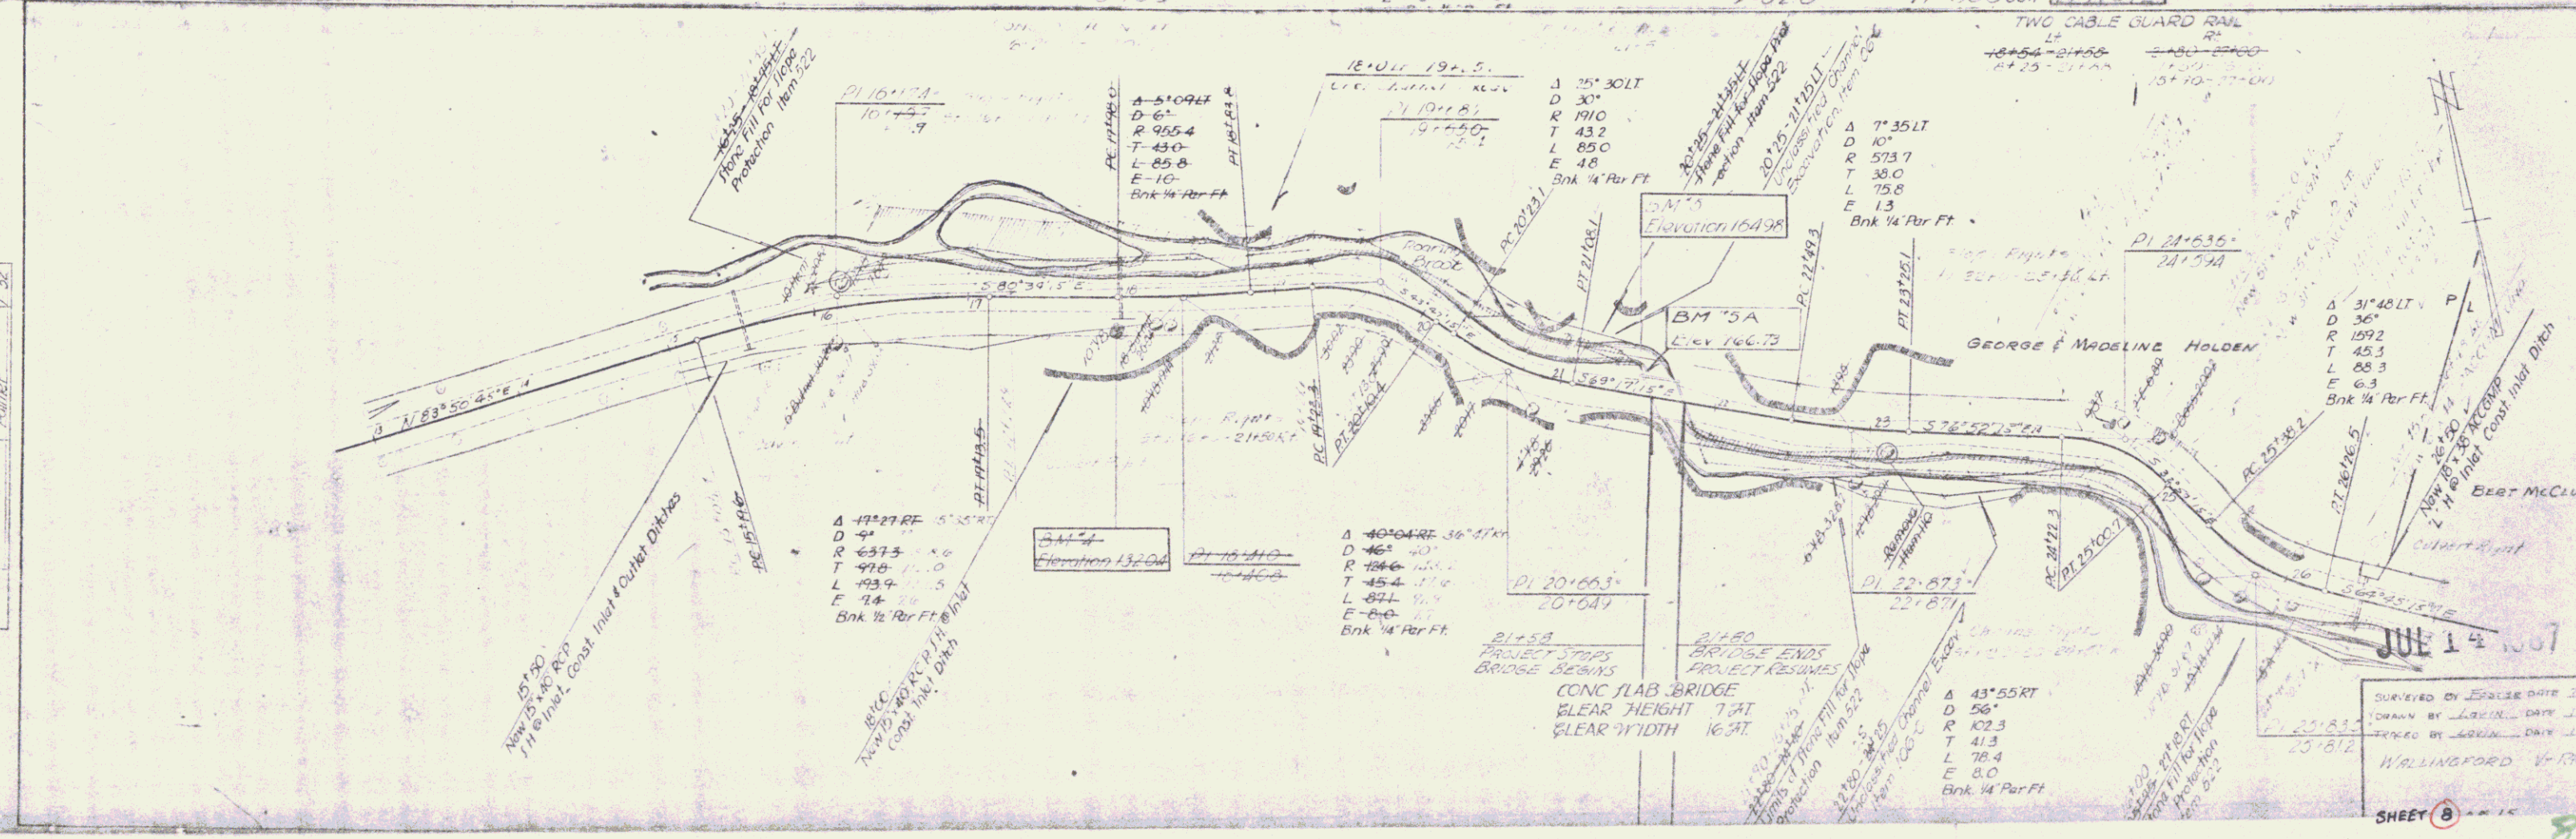

PLAN

DATE	1912
BY	W. J. ...
CHECKED	...
NO.	...

SHEET 8

25-1812

WALLINGFORD V-17-10

JUL 14 1907

SURVEYED BY ...