
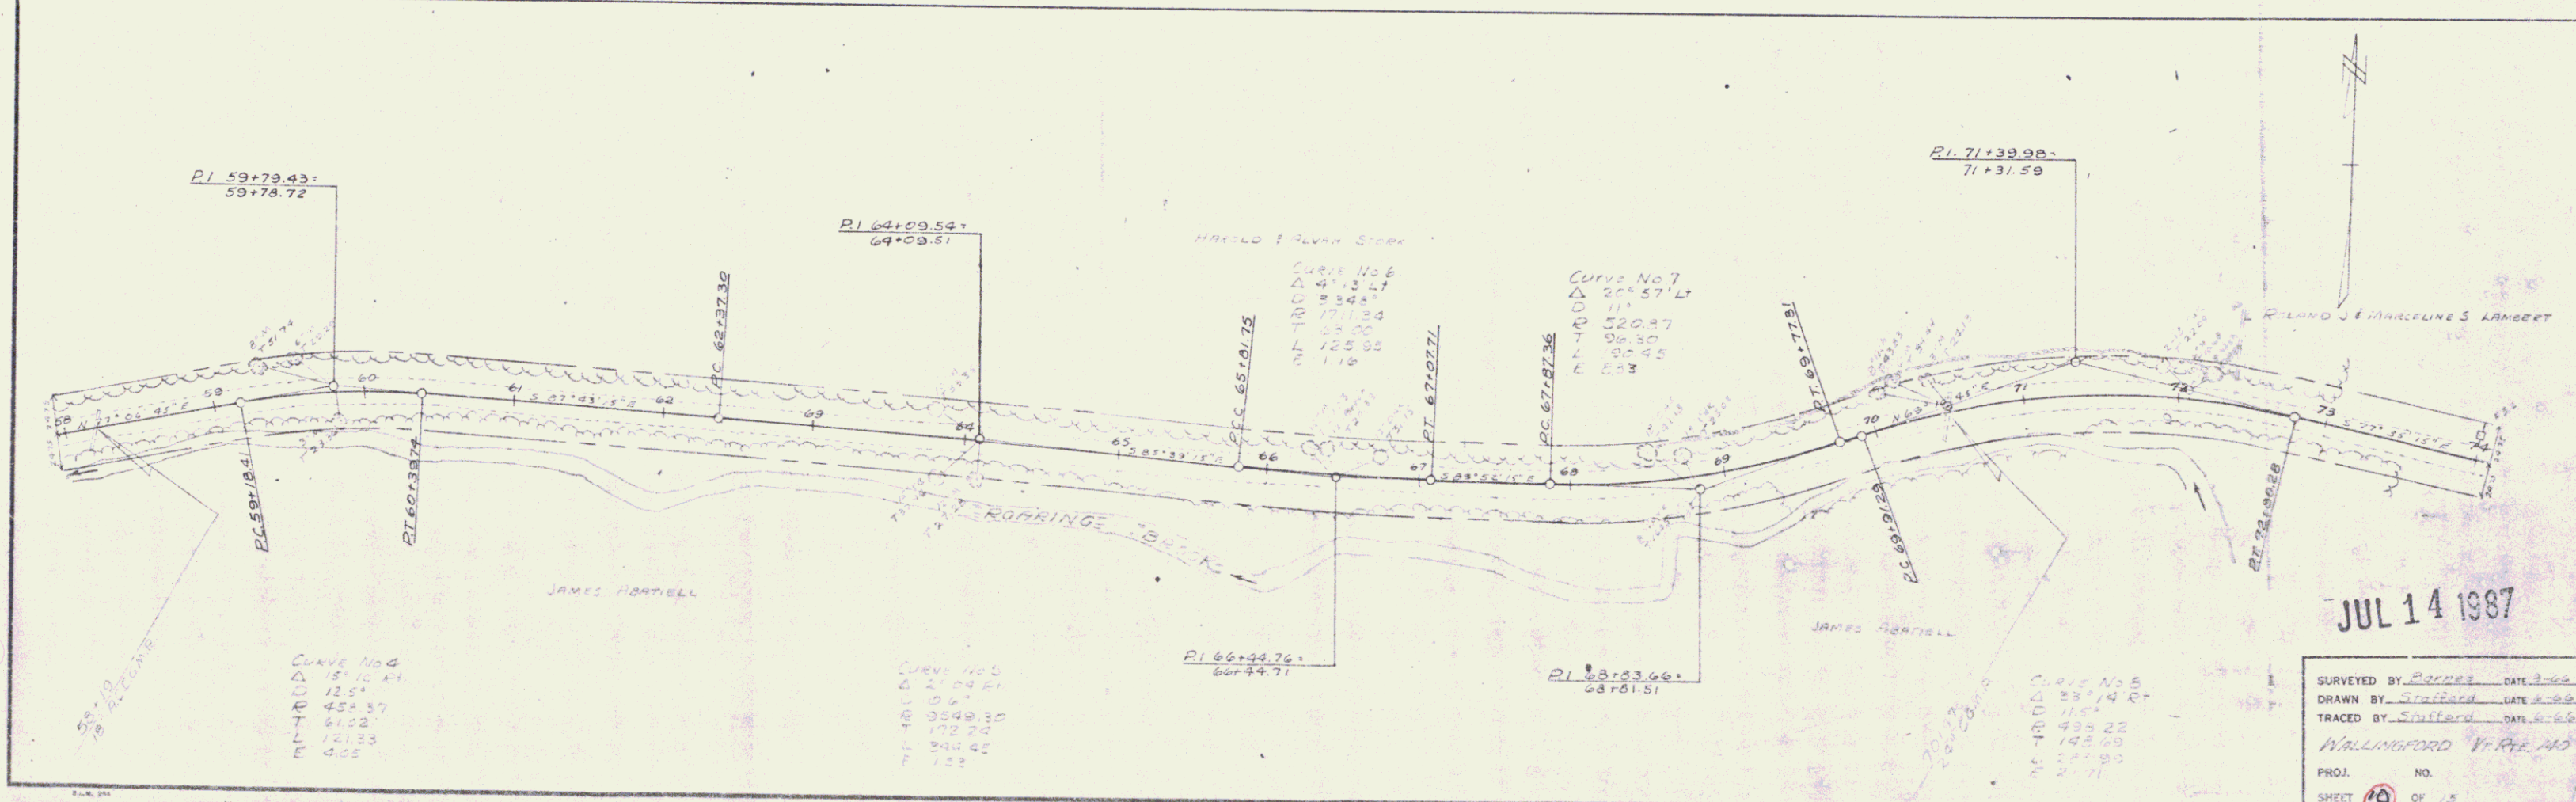


POOR ORIGINAL COPY

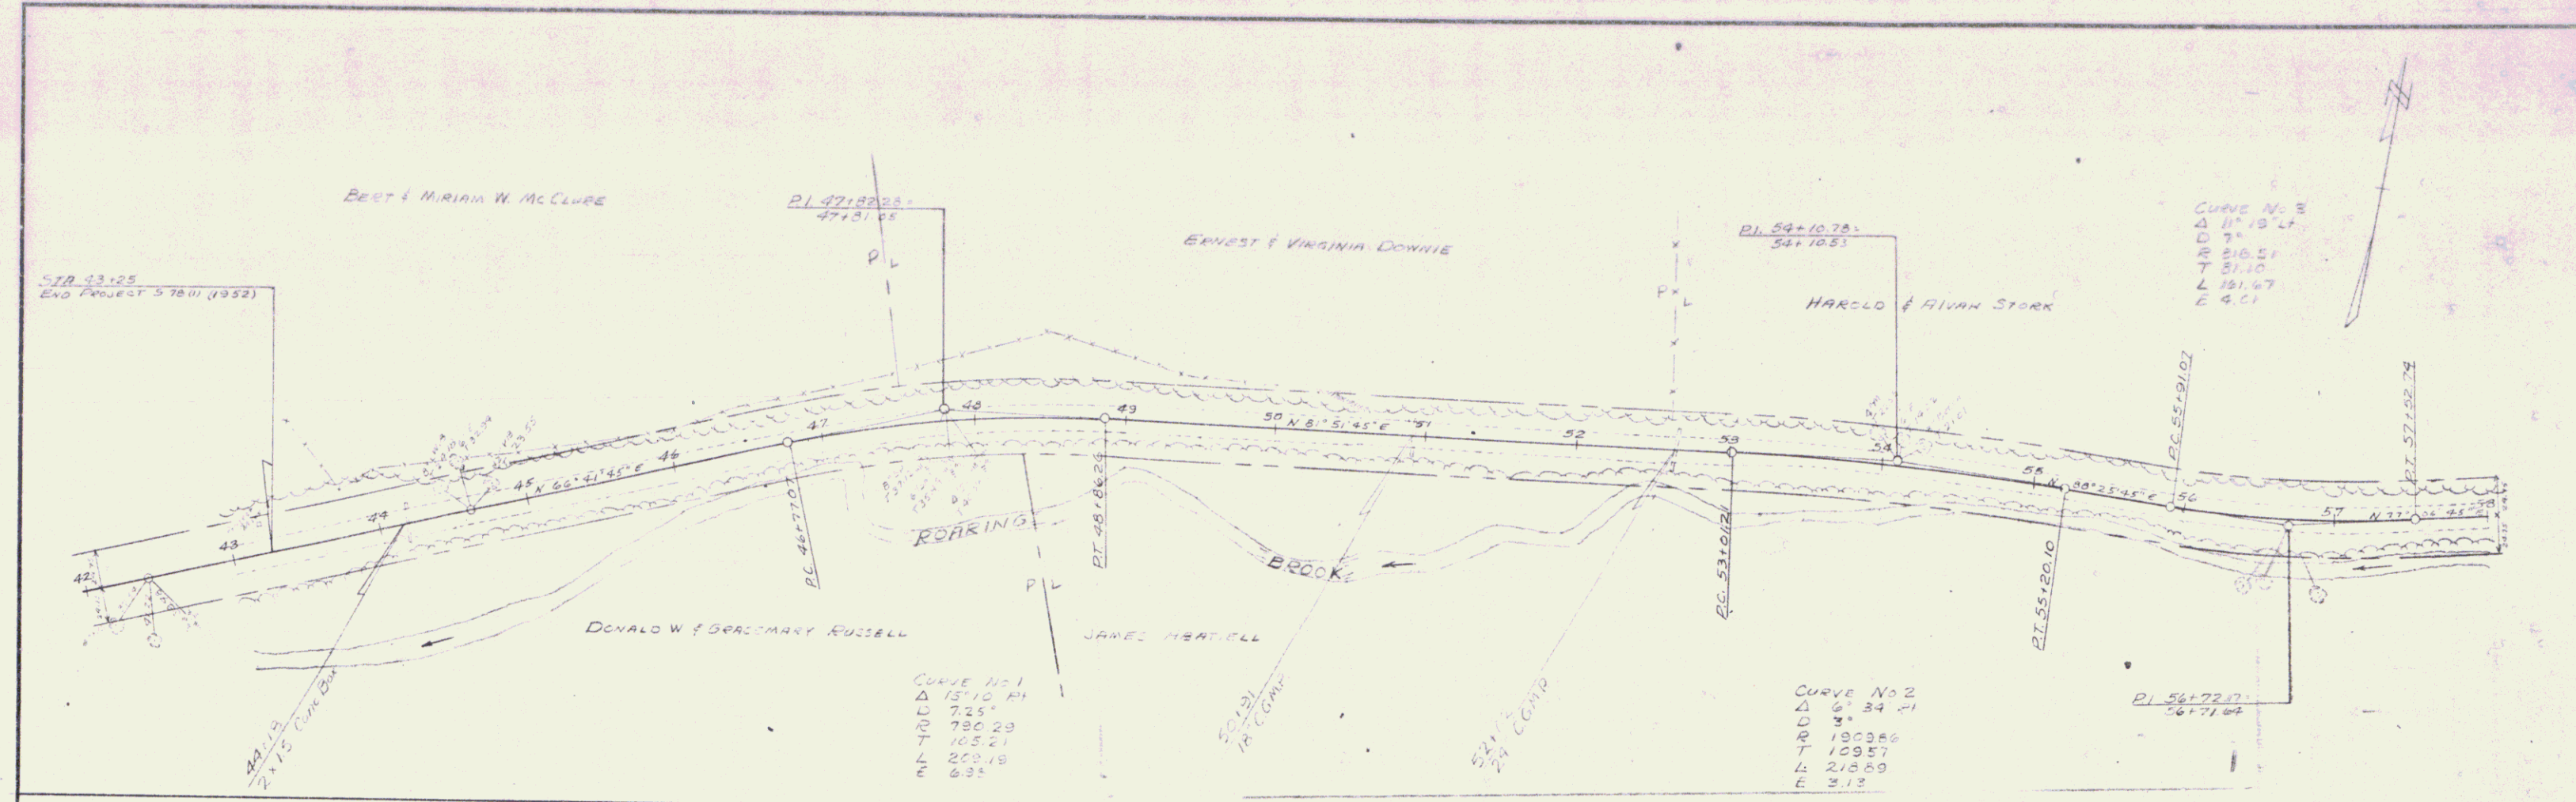

JUL 14 1987

SURVEYED BY *Boone* DATE 3-66
 DRAWN BY *Stifford* DATE 8-66
 TRACED BY *Stifford* DATE 8-66
 WALLINGFORD Vt. P.P. 145
 PROJ. NO.
 SHEET 10 OF 15