
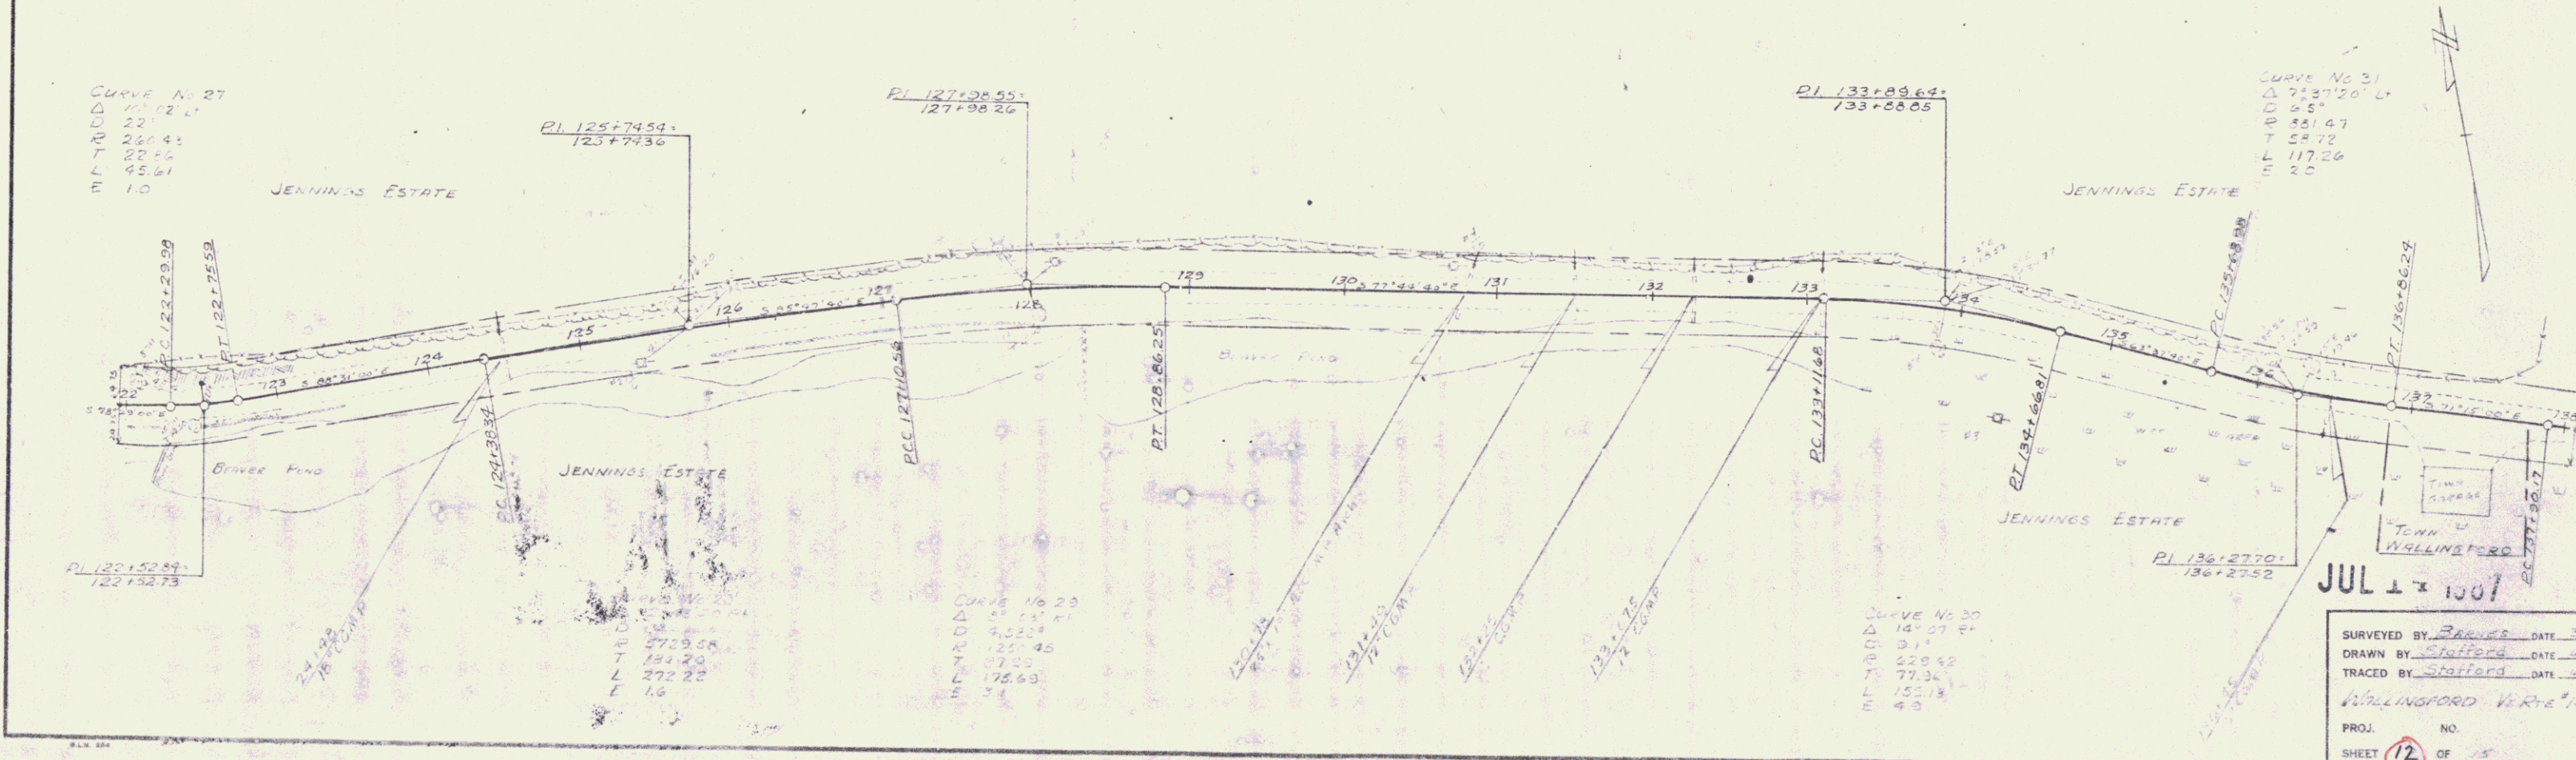


POOR ORIGINAL COPY

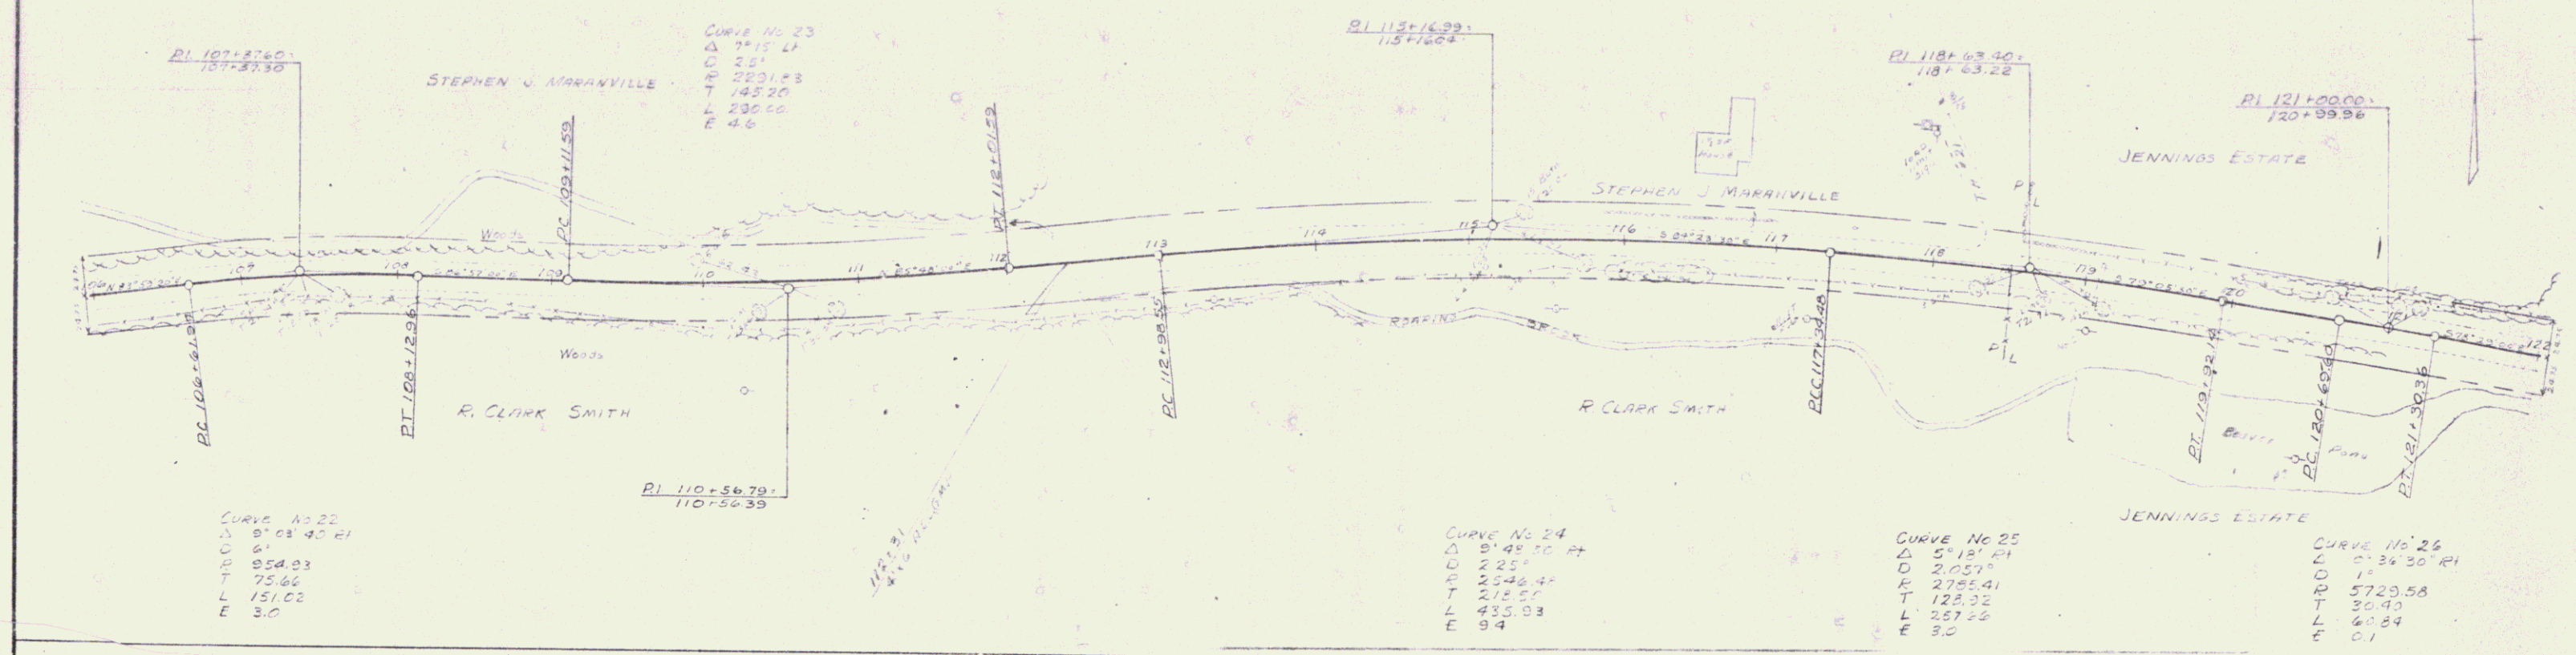

JUL 1 1907

SURVEYED BY BRUCE DATE 3-06
 DRAWN BY STAFFORD DATE 3-06
 TRACED BY STAFFORD DATE 3-06
 WALLINGFORD V. R. 140

PROJ. NO.
 SHEET 12 OF 5