
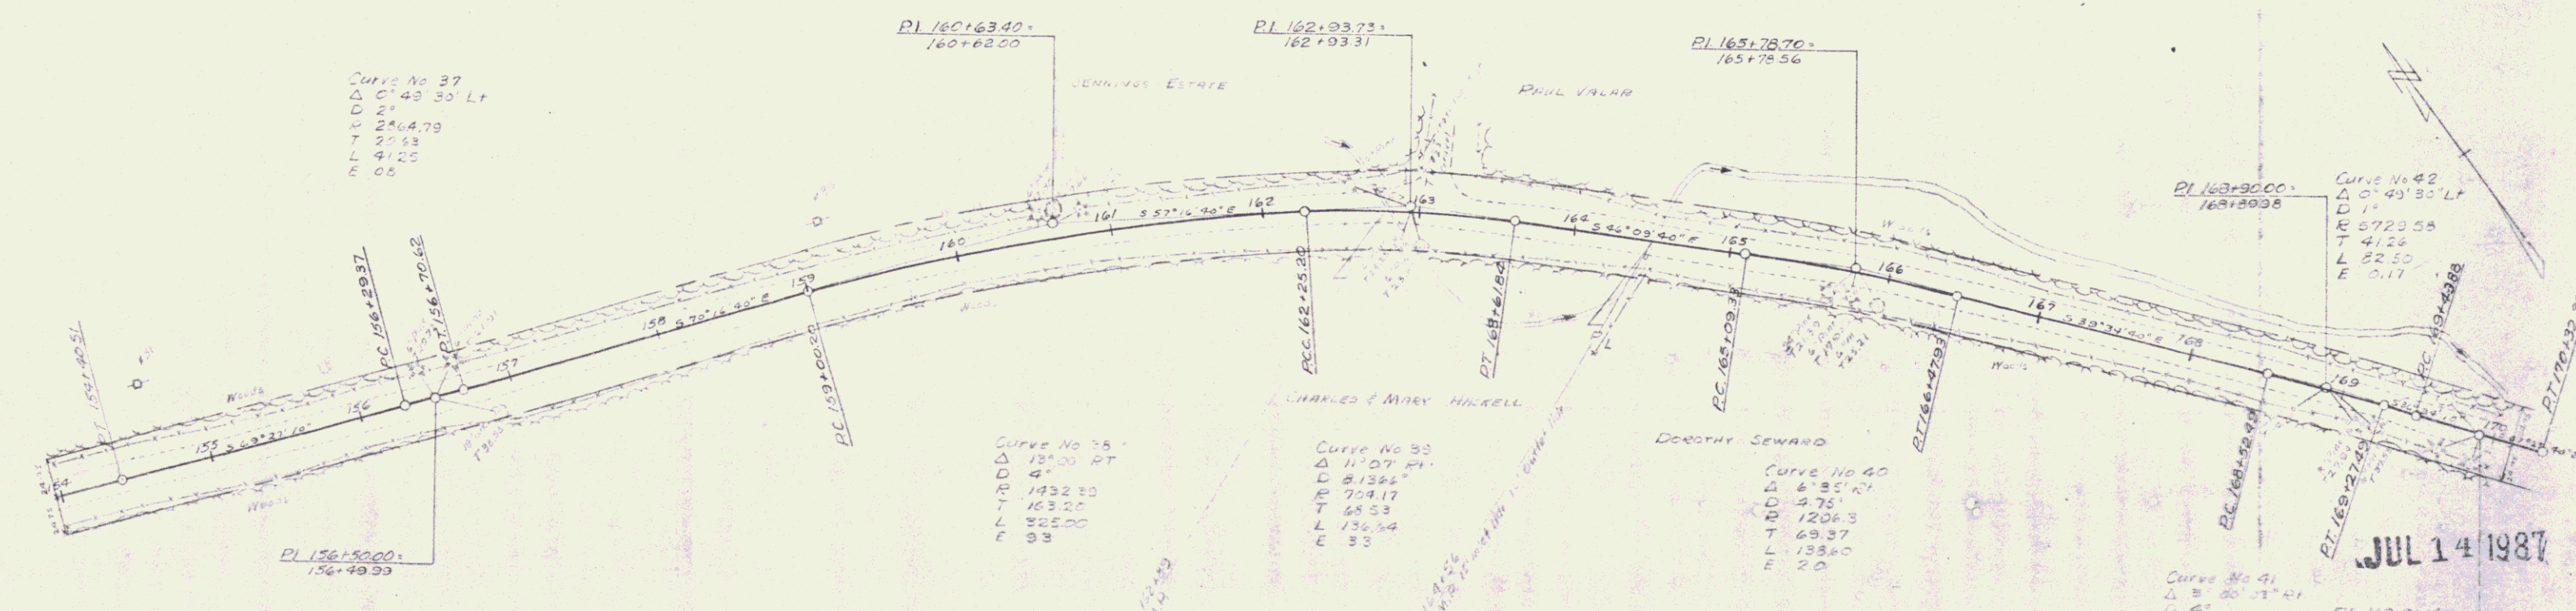


POOR ORIGINAL COPY

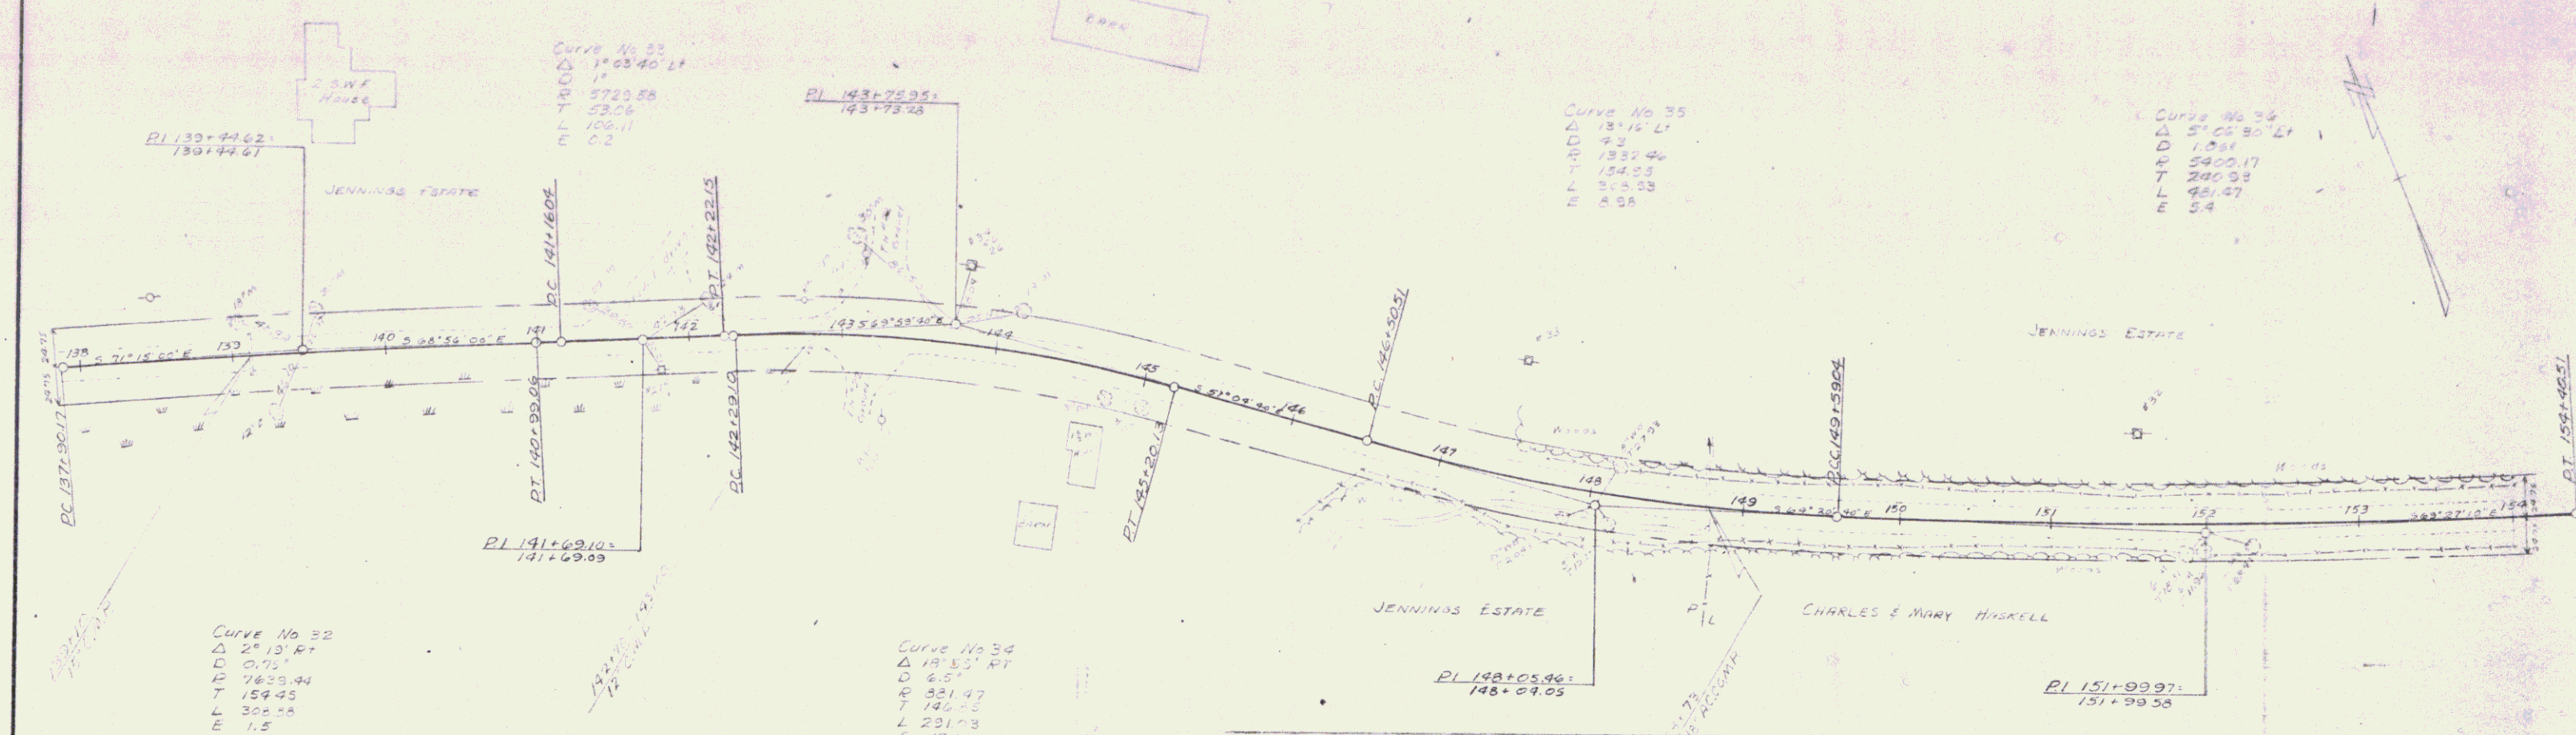

JUL 14 1987

SURVEYED BY James DATE 7-6-87  
 DRAWN BY Stafford DATE 7-2-87  
 TRACED BY Stafford DATE 7-2-87  
 WALLS FORD Vt Rte #10  
 PROJ. NO.  
 SHEET 13 OF 15

13