
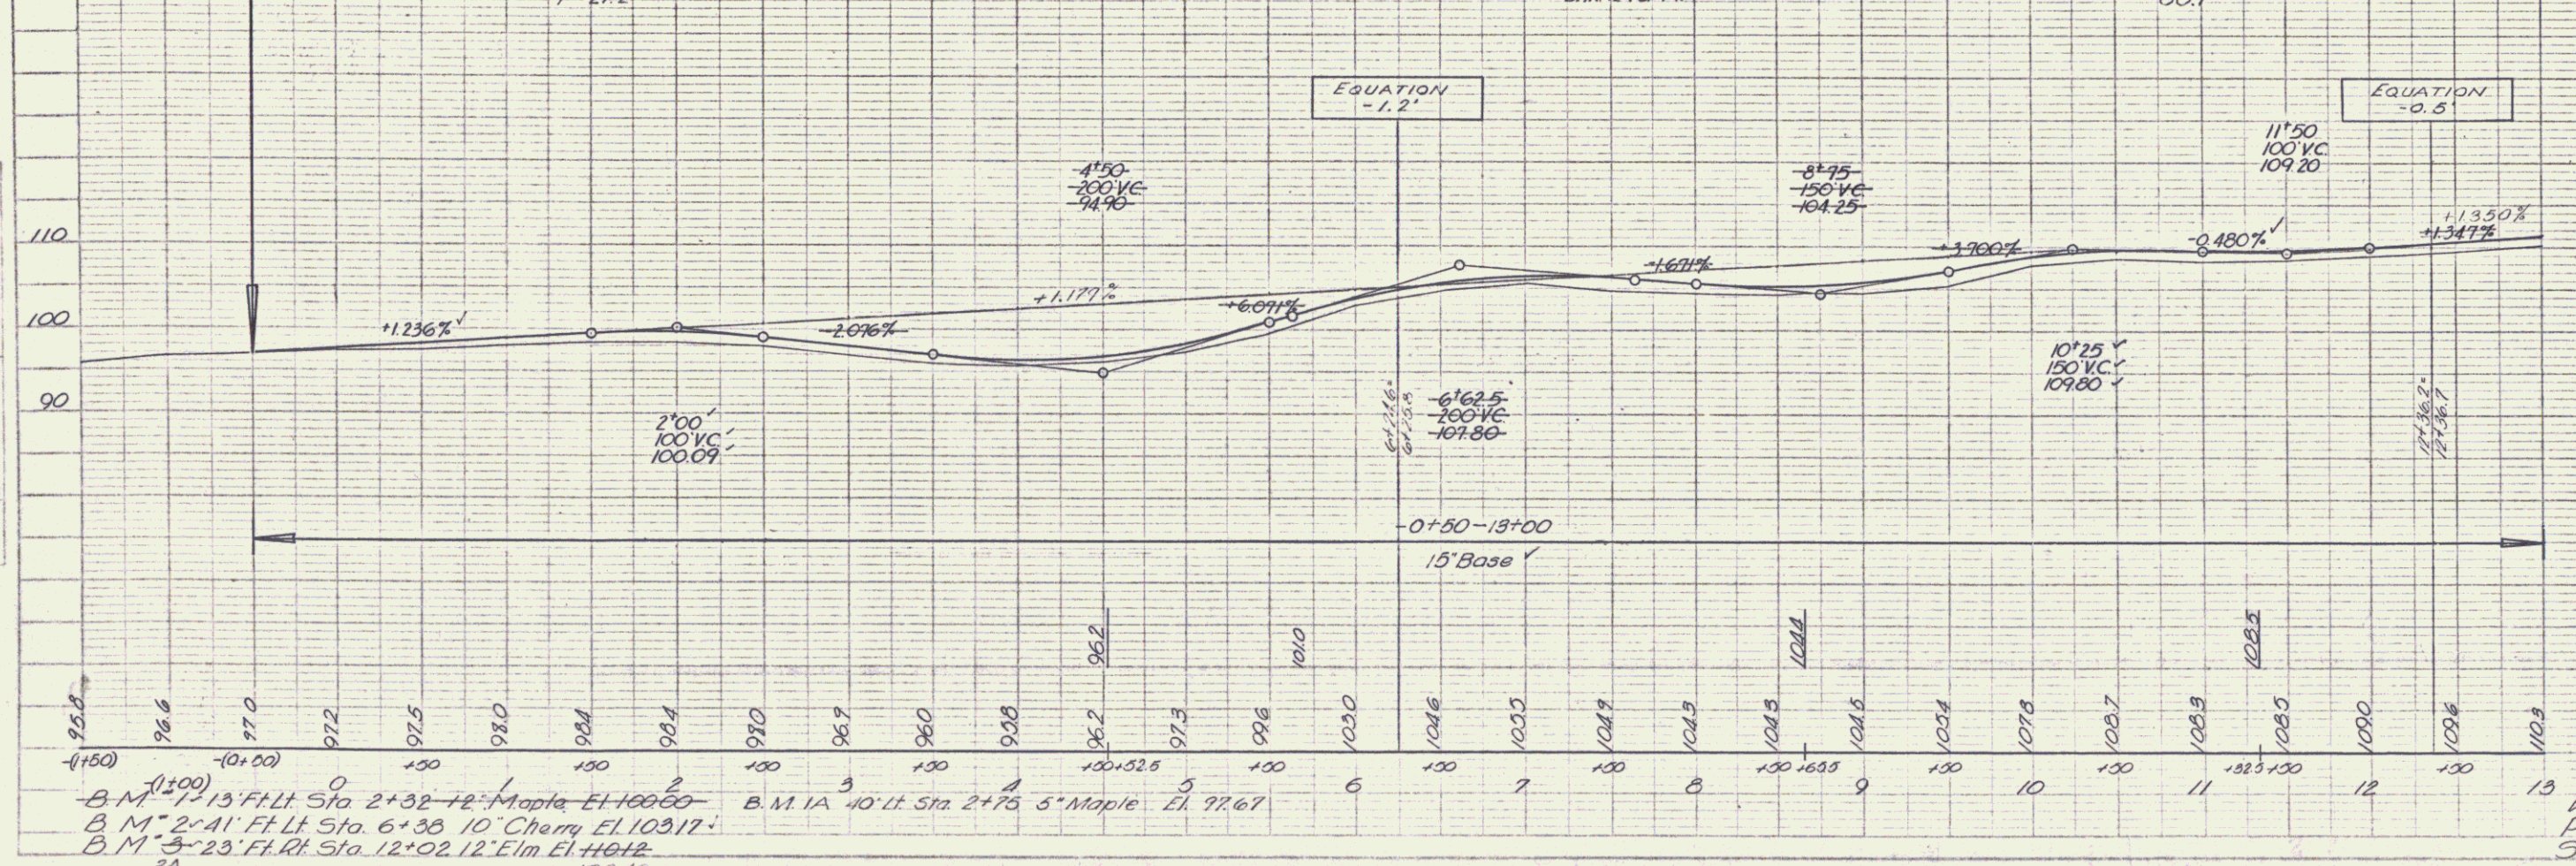


PLAN  
 DRAWN BY: Folger  
 CHECKED BY: Murray  
 DATE: 3-33  
 PROJECT: 5-23  
 SHEET: 11 of 24

PROFILE  
 DRAWN BY: Folger  
 CHECKED BY: Palmer  
 DATE: 3-33  
 PROJECT: 5-23  
 SHEET: 11 of 24

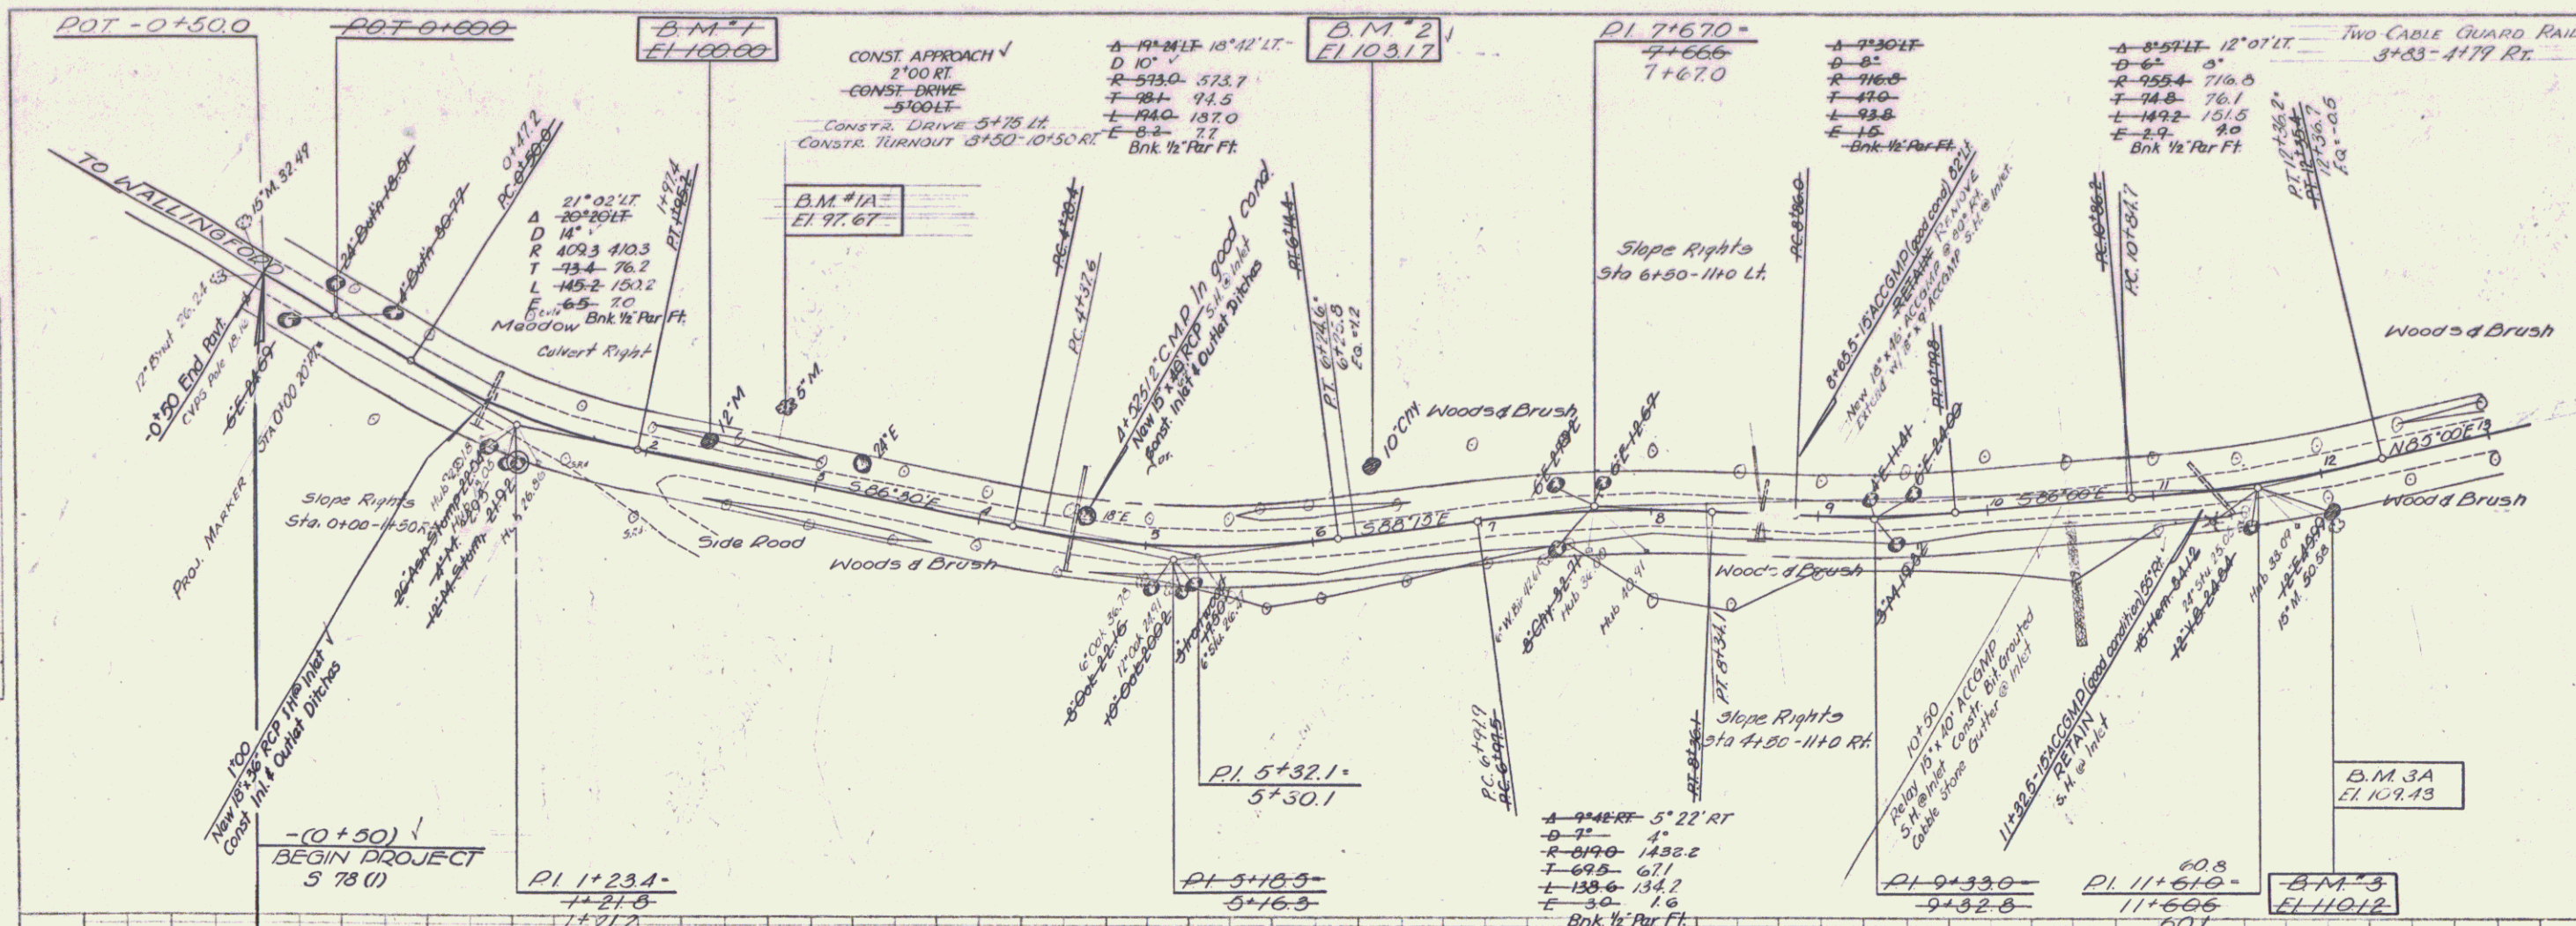

B.M. 1 13' F.H.L. Sta. 2+32.12 Maple El. 100.00  
 B.M. 2 41' F.H.L. Sta. 6+38.10 Cherry El. 103.17  
 B.M. 3 23' F.H.L. Sta. 12+02.12 Elm El. 104.12  
 3A 109.45

WALLINGFORD  
 Project 5 No. 78 (1)  
 Sheet 11 of 24

PLATE 1 - ROAD PROJECT 5-23 & 5-24  
 SCALE: 1" = 40' HORIZ.  
 SCALE: 1" = 10' VERT.