


PLAN
 DRAWN BY: B. Foster
 CHECKED BY: A. Linn
 DATE: 1-31-32
 PROJECT: WALLINGFORD
 SHEET: 13 OF 24

PROFILE
 DRAWN BY: B. Foster
 CHECKED BY: A. Linn
 DATE: 1-31-32
 PROJECT: WALLINGFORD
 SHEET: 13 OF 24

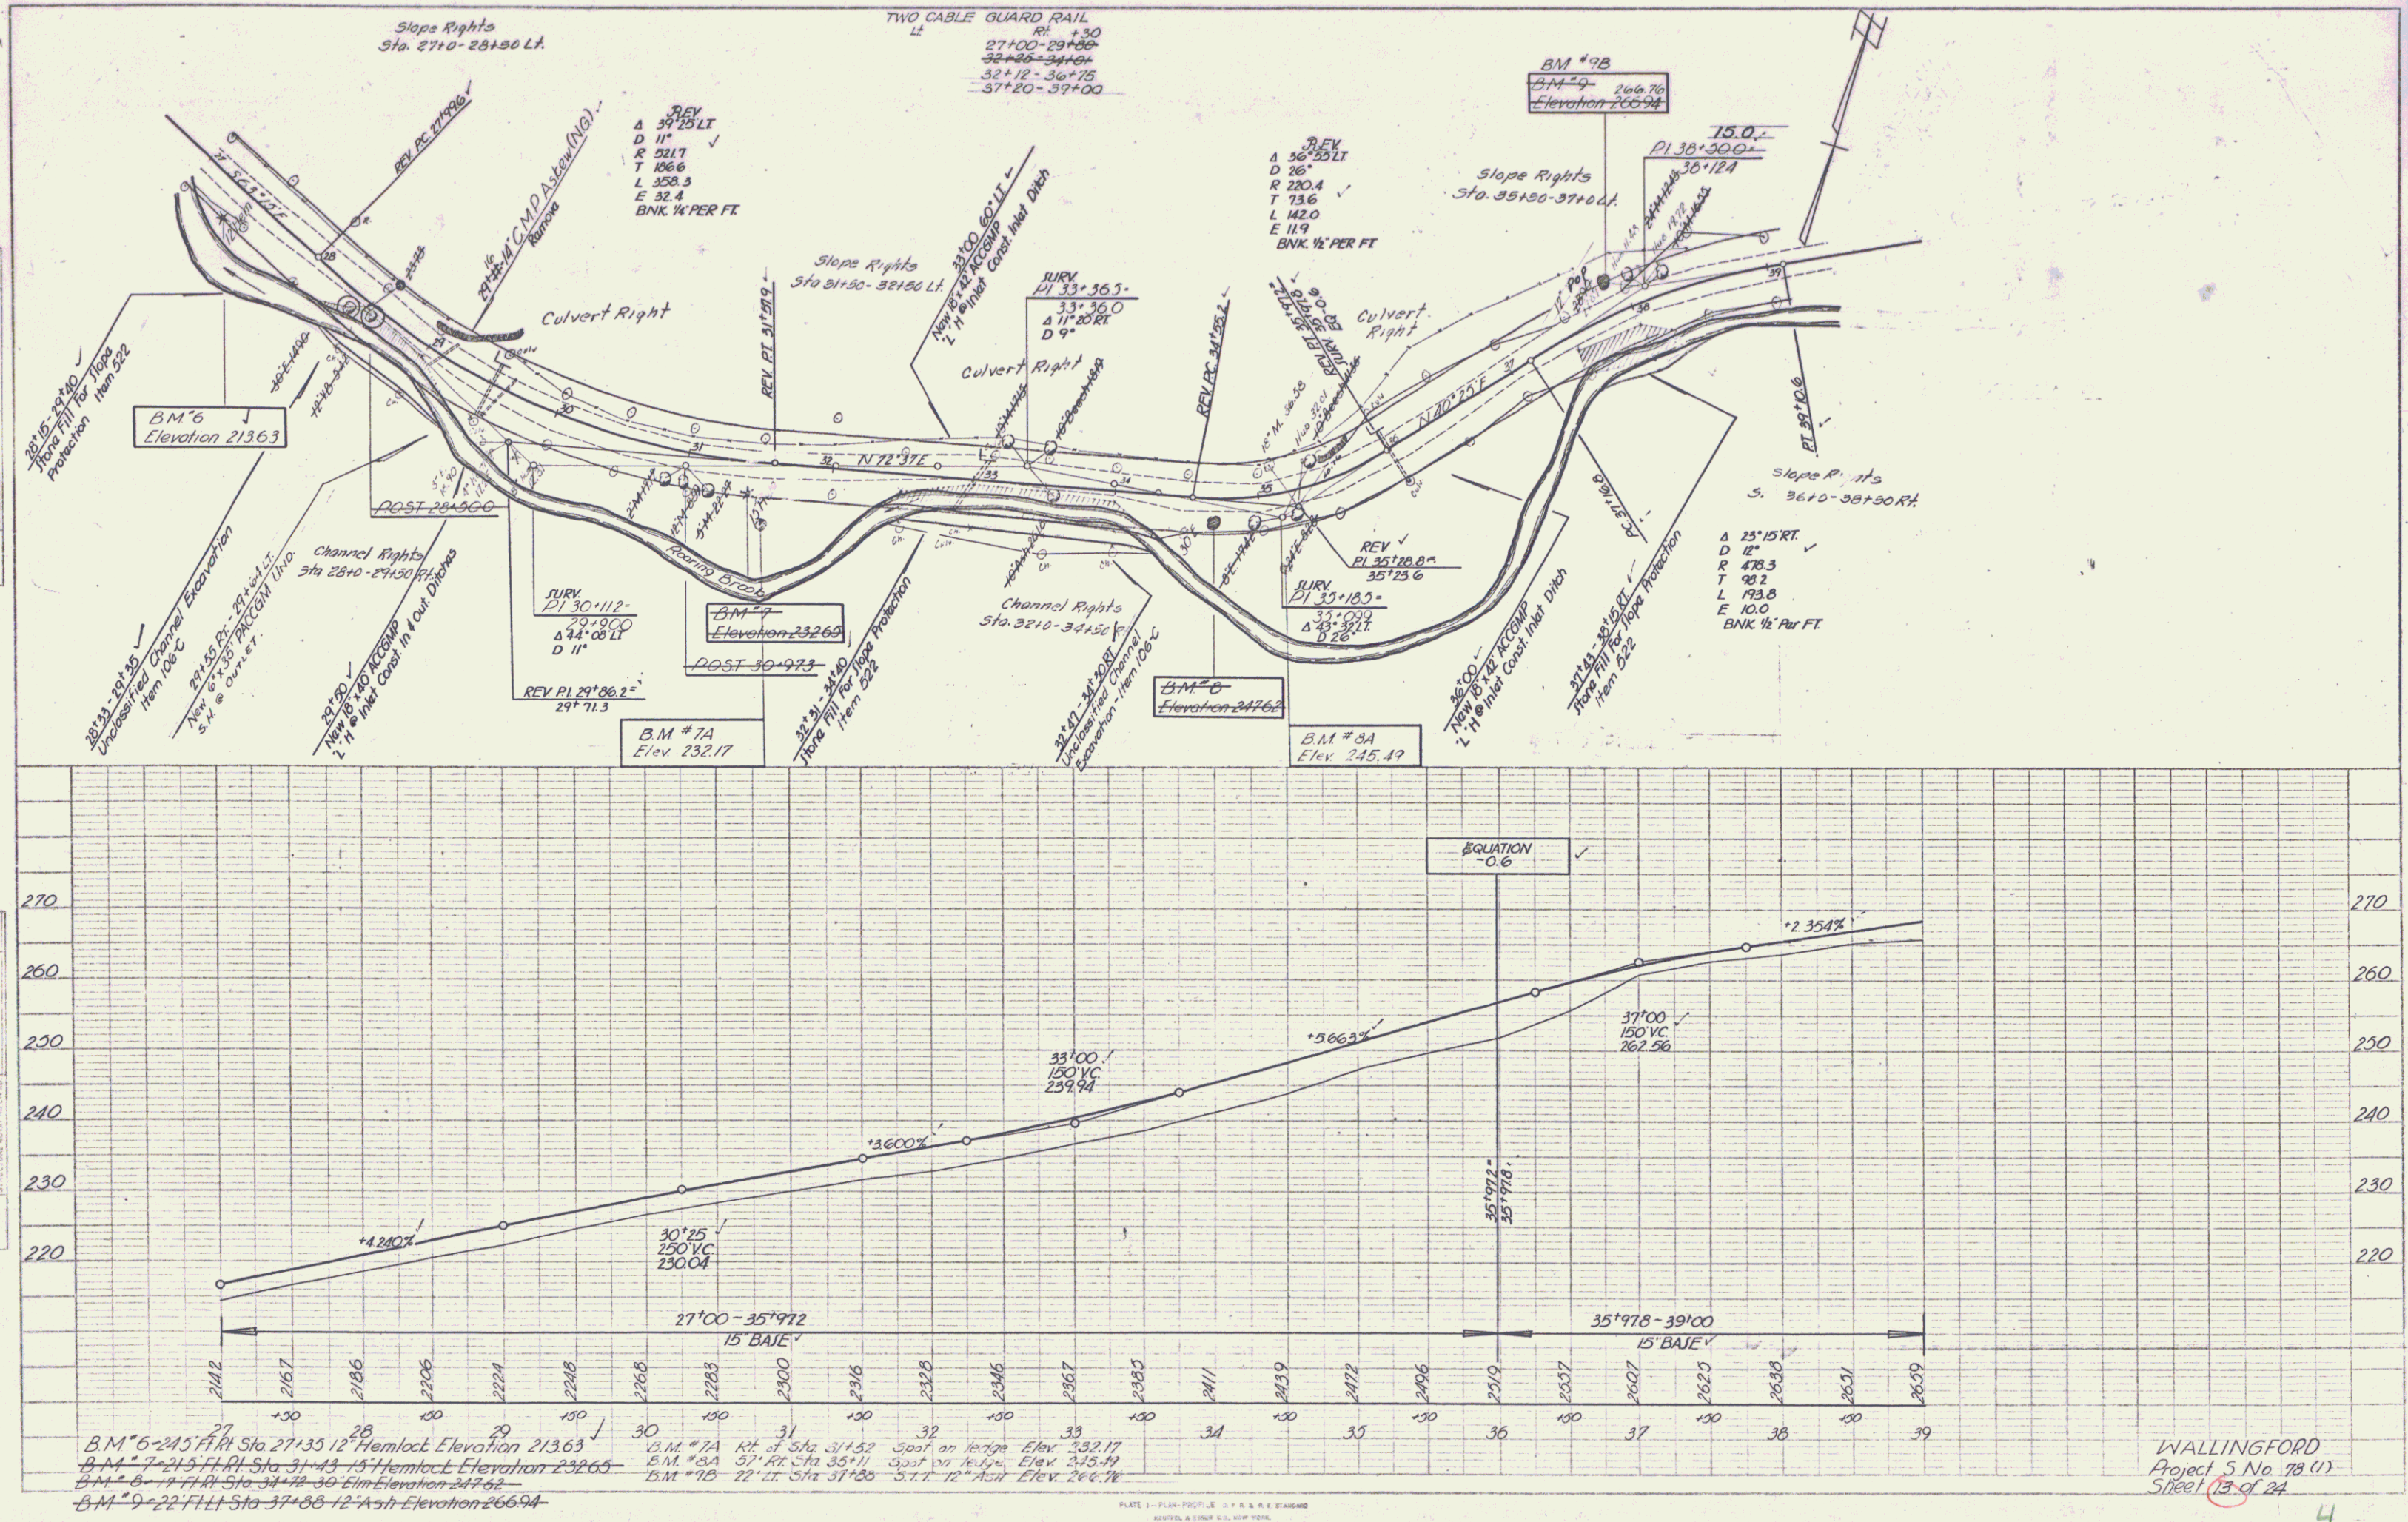

B.M. #6-245 F.R.I. Sta. 27+35.12 Hemlock Elevation 21363
 B.M. #7-215 F.R.I. Sta. 31+43.15 Hemlock Elevation 23265
 B.M. #8-177 F.R.I. Sta. 34+72.36 Elm Elevation 24762
 B.M. #9-22 F.L.I. Sta. 37+88.12 Ash Elevation 26694

B.M. #7A Rt. of Sta. 31+52 Spot on ledge Elev. 23217
 B.M. #8A 37' Rt. Sta. 35+11 Spot on ledge Elev. 24574
 B.M. #9B 22' Rt. Sta. 37+80 S.T.T. 12' Ash Elev. 26674

WALLINGFORD
 Project S No. 78 (1)
 Sheet 13 of 24