



INDEX OF SHEETS

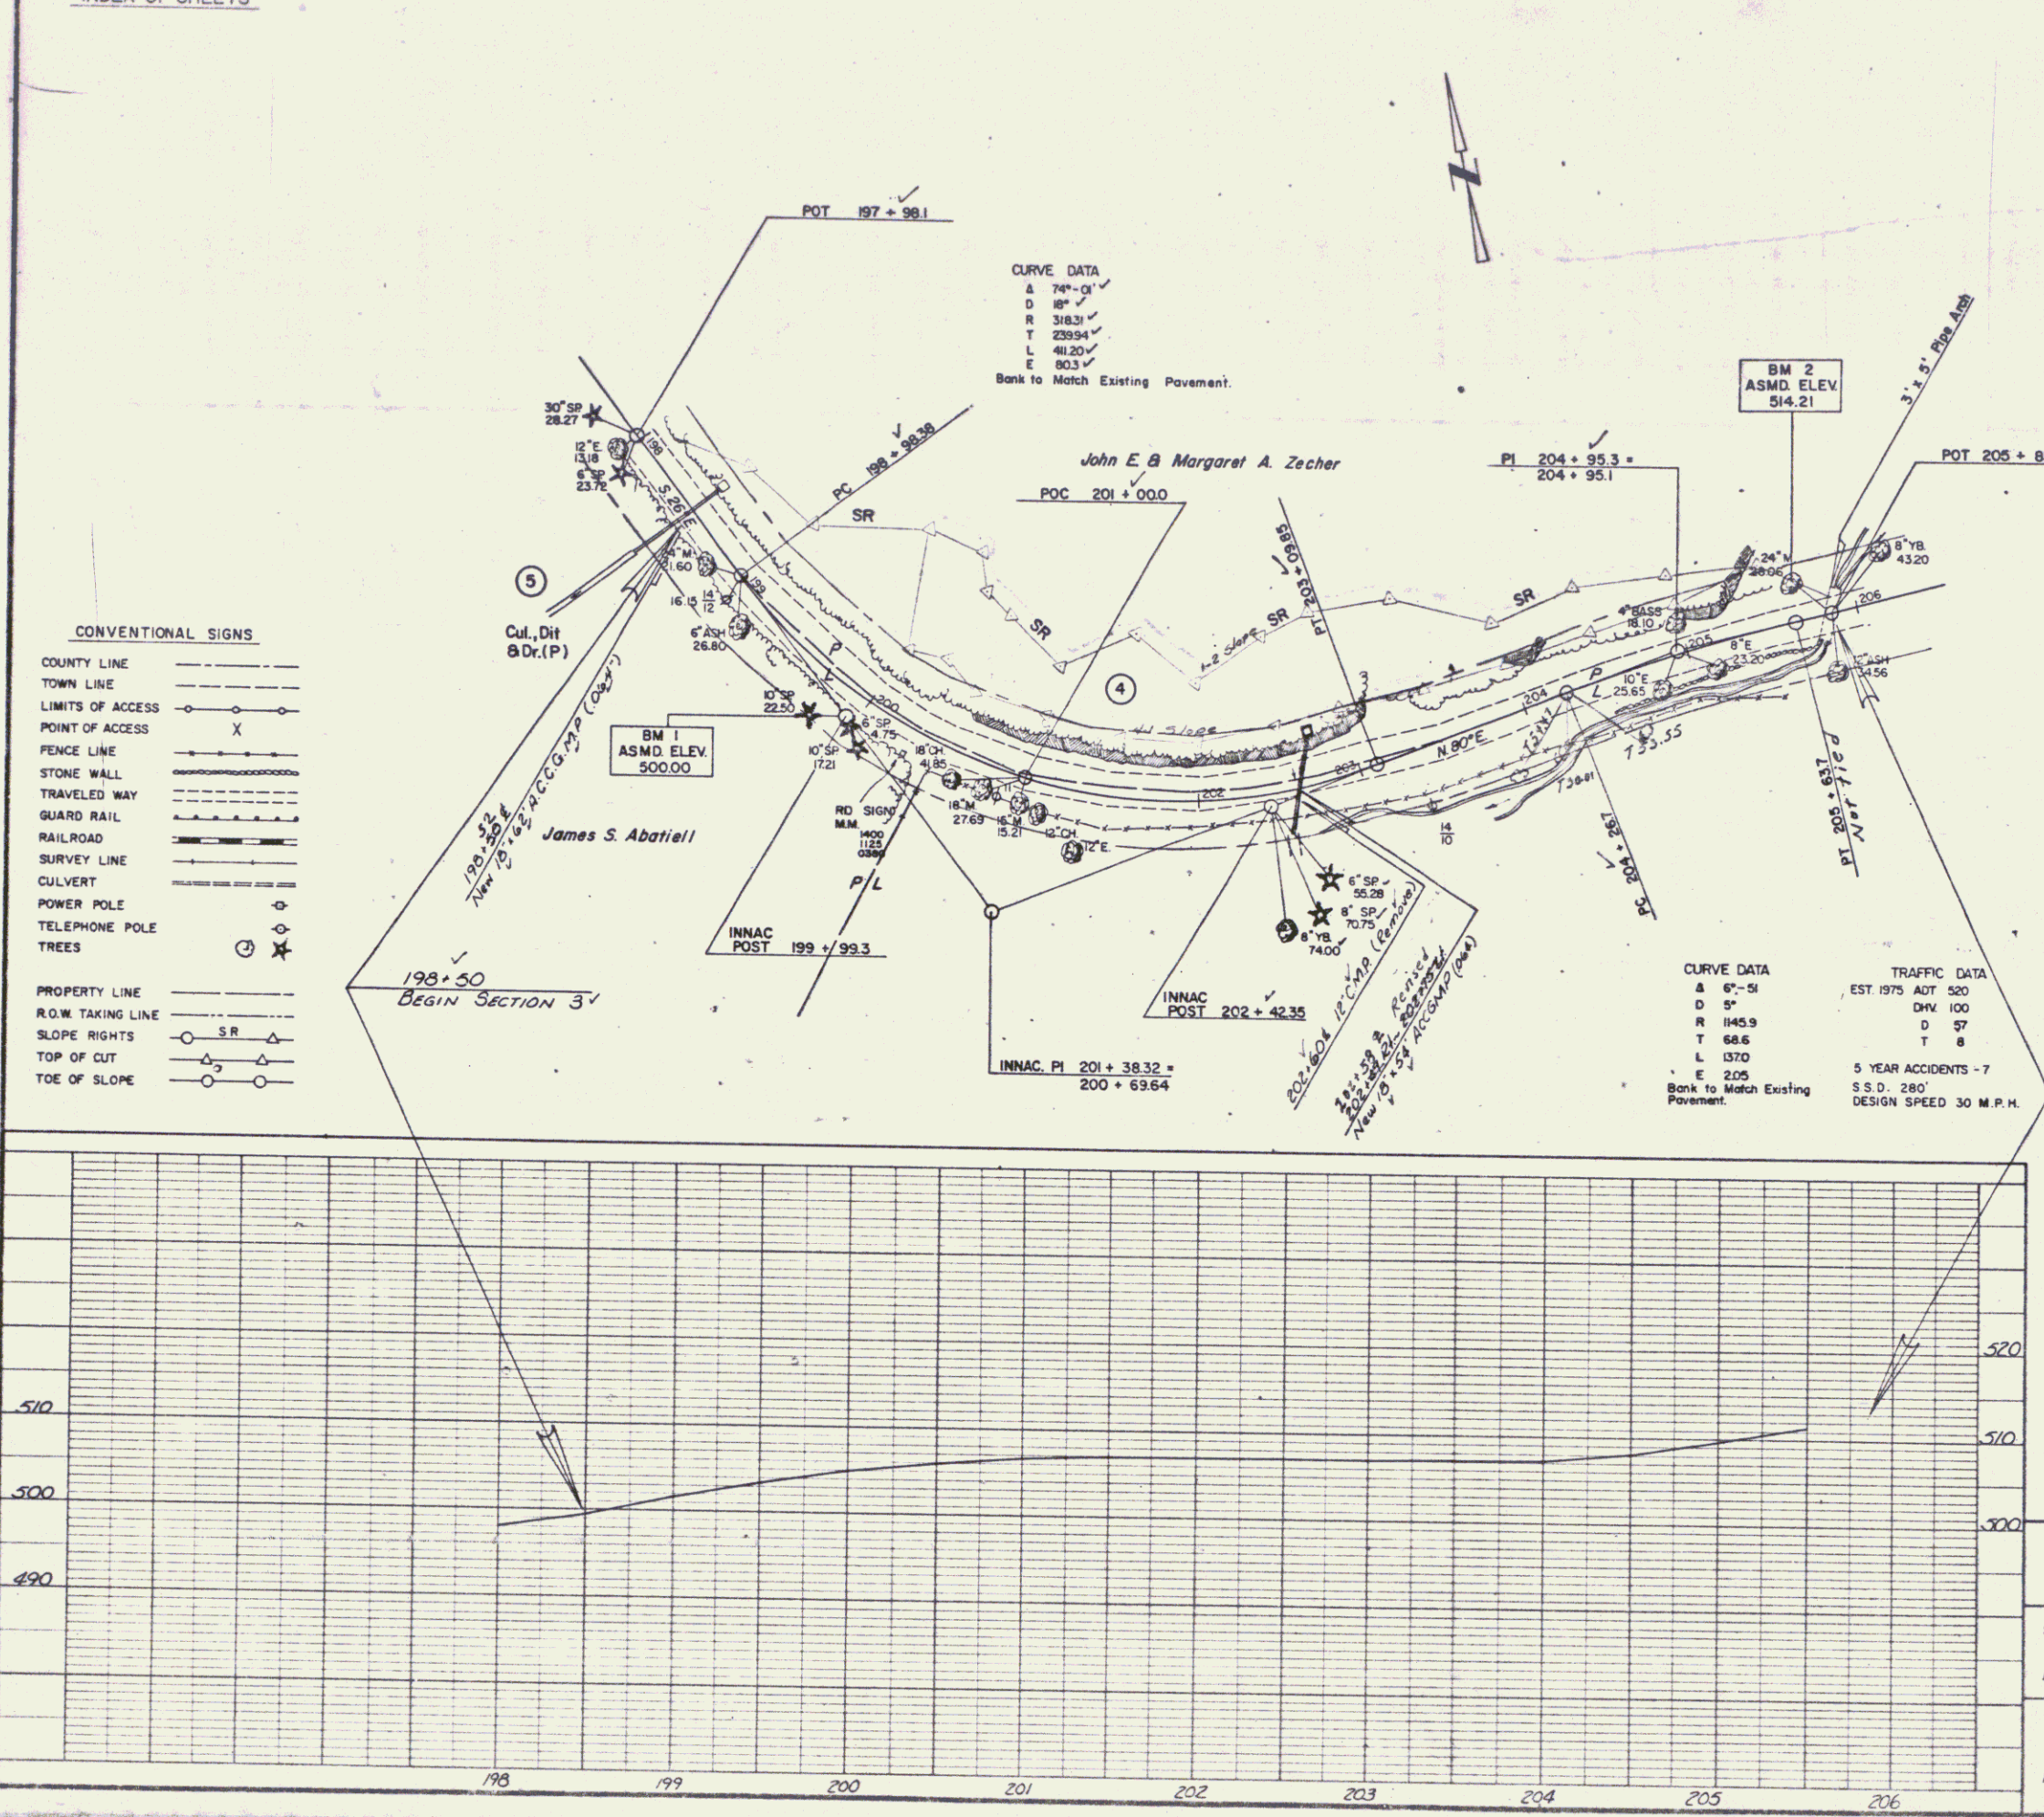


CONVENTIONAL SIGNS

- COUNTY LINE
- TOWN LINE
- LIMITS OF ACCESS
- POINT OF ACCESS
- FENCE LINE
- TRAVELED WAY
- STONE WALL
- RAILROAD
- SURVEY LINE
- CULVERT
- POWER POLE
- TELEPHONE POLE
- TREES
- PROPERTY LINE
- R.O.W. TAKING LINE
- SLOPE RIGHTS
- TOP OF CUT
- TOE OF SLOPE

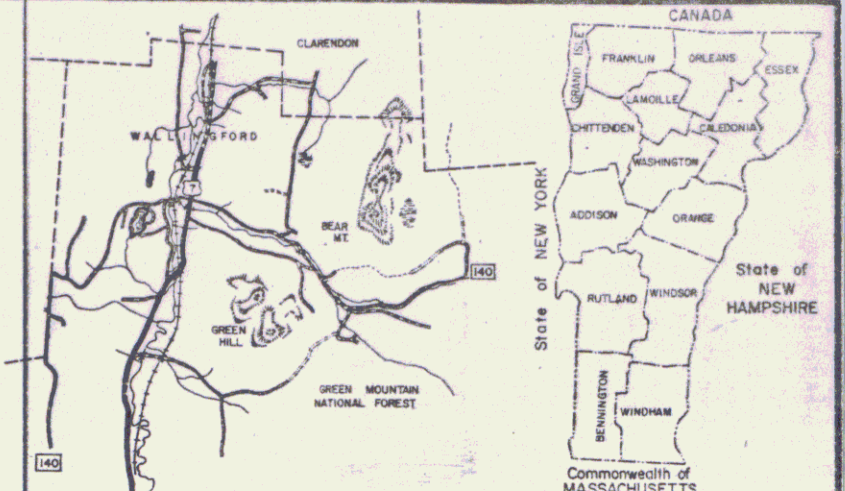

ITEM NO.	ITEM	UNIT	ORIGINAL	RND.	TOTAL	FINAL
20110	Clearing and Grubbing	L.S.	1/2	-	1/2	
20315	Common Excavation	C.Y.	3000		3000	
20316	Solid Rock Excavation	C.Y.	197.3	227	2200	
20420	Trench Excavation of Earth	C.Y.	122	3	125	
20421	Trench Excavation of Rock	C.Y.	15	5	20	
30125	Sub-base of Crushed Gravel (Coarse Graded)	C.Y.	4.08	2	410	
40440	Bituminous Surface Treatment, Type II	cwt	15	-	15	
40625	Bituminous Concrete Pavement	Ton	40.8	0.8	41	
50125	Concrete Class B	C.Y.	4.2	0.8	5	
50715	Reinforcing Steel	lb.	386	4	390	
60109	18" A.C.C.G.M.P. (0.64")	L.F.	116	-	116	
60446	C.I. Grate w/ Frame, Type B	Ea.	2	-	2	
60710	Roadway Patrol Maintenance	Hr.	25	-	25	
60910	Dust Control w/ Water	M/Gal.	100	-	100	
65110	Seed	lb.	30	-	30	
65115	Fertilizer	lb.	250	-	250	
65110	Field Office - Engineers	ea	1/2	-	1/2	
65125	Hay Mulch	Ton	0.5	-	0.5	
20332	Granular Borrow	c/y	500	51	500	

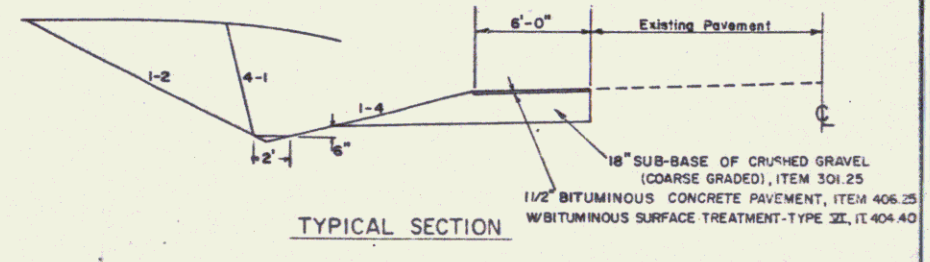

205+85
 END SECTION 3
 END PROJECT ROS 0138(3)

SECTION 3 R.O.W. SHEET 5 of 5

APPROVED *[Signature]* DATE 5-19-75
 R.O.W. DIRECTOR

SUBMITTED BY ORDER OF THE STATE HIGHWAY BOARD

APPROVED _____ DATE _____
 CHIEF ENGINEER

DESIGNED BY _____ DATE _____
 DRAWN BY SHANGRAW DATE 3/75
 CHECKED BY _____ DATE _____
 Design Supervisor

APPROVED _____ DATE _____
 DIVISION ENGINEER

TOWN OF WALLINGFORD RTE NO. 140
 BRIDGE NO. _____
 LOG STA. _____
 SURV STA. _____

PROJECT ROS PROJ NO 0138 (3)
 SHEET 9 of 23