


**BRIDGE DATA**

Type	1 Beam
Clear Roadway	20' 0"
Clear Height	5' 9"
Clear Span	45' 0"
Length Overall	43.9'
Waterway	124"

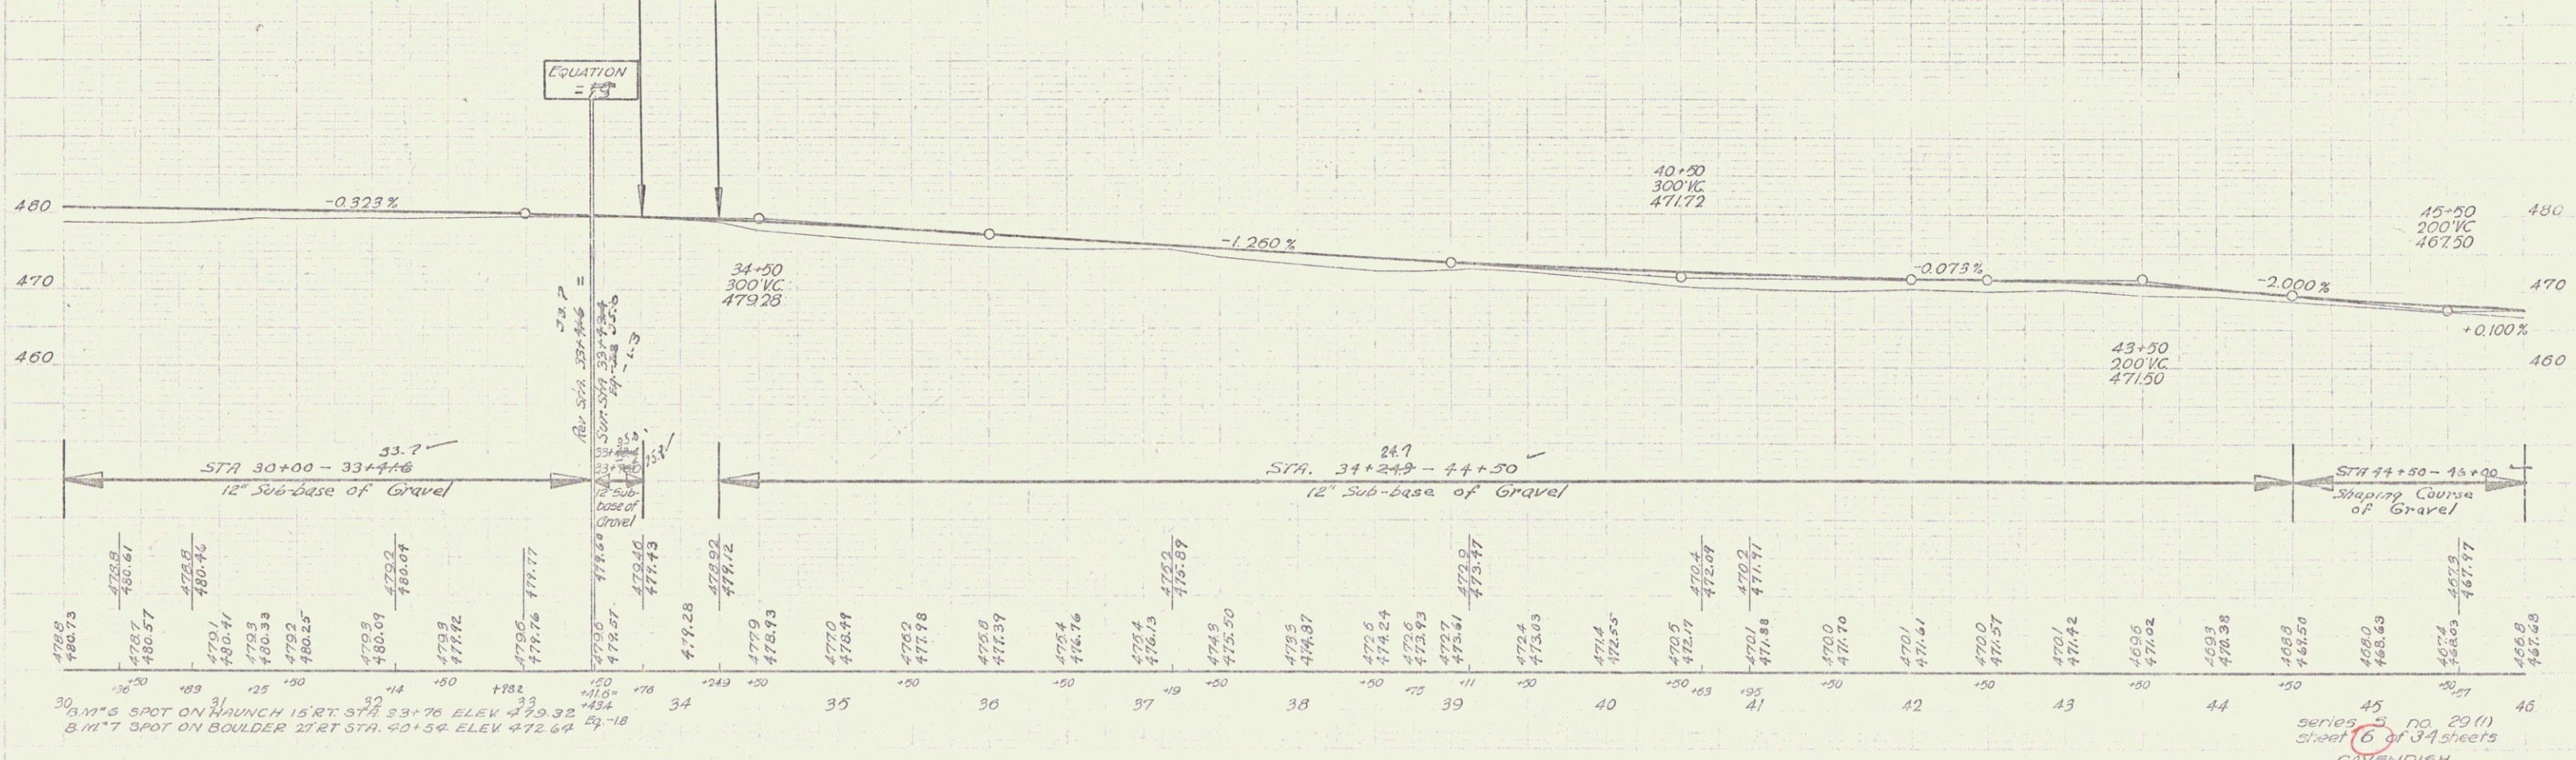

Logline  
7-46  
2-45

Logline  
7-46  
2-45

30+00 B.M. 6 SPOT ON HAUNCH 15' RT. STA. 33+76 ELEV. 479.32  
 B.M. 7 SPOT ON BOULDER 27' RT. STA. 40+54 ELEV. 472.64

series 3 no. 29(1)  
 sheet 6 of 34 sheets  
 CAVENDISH