
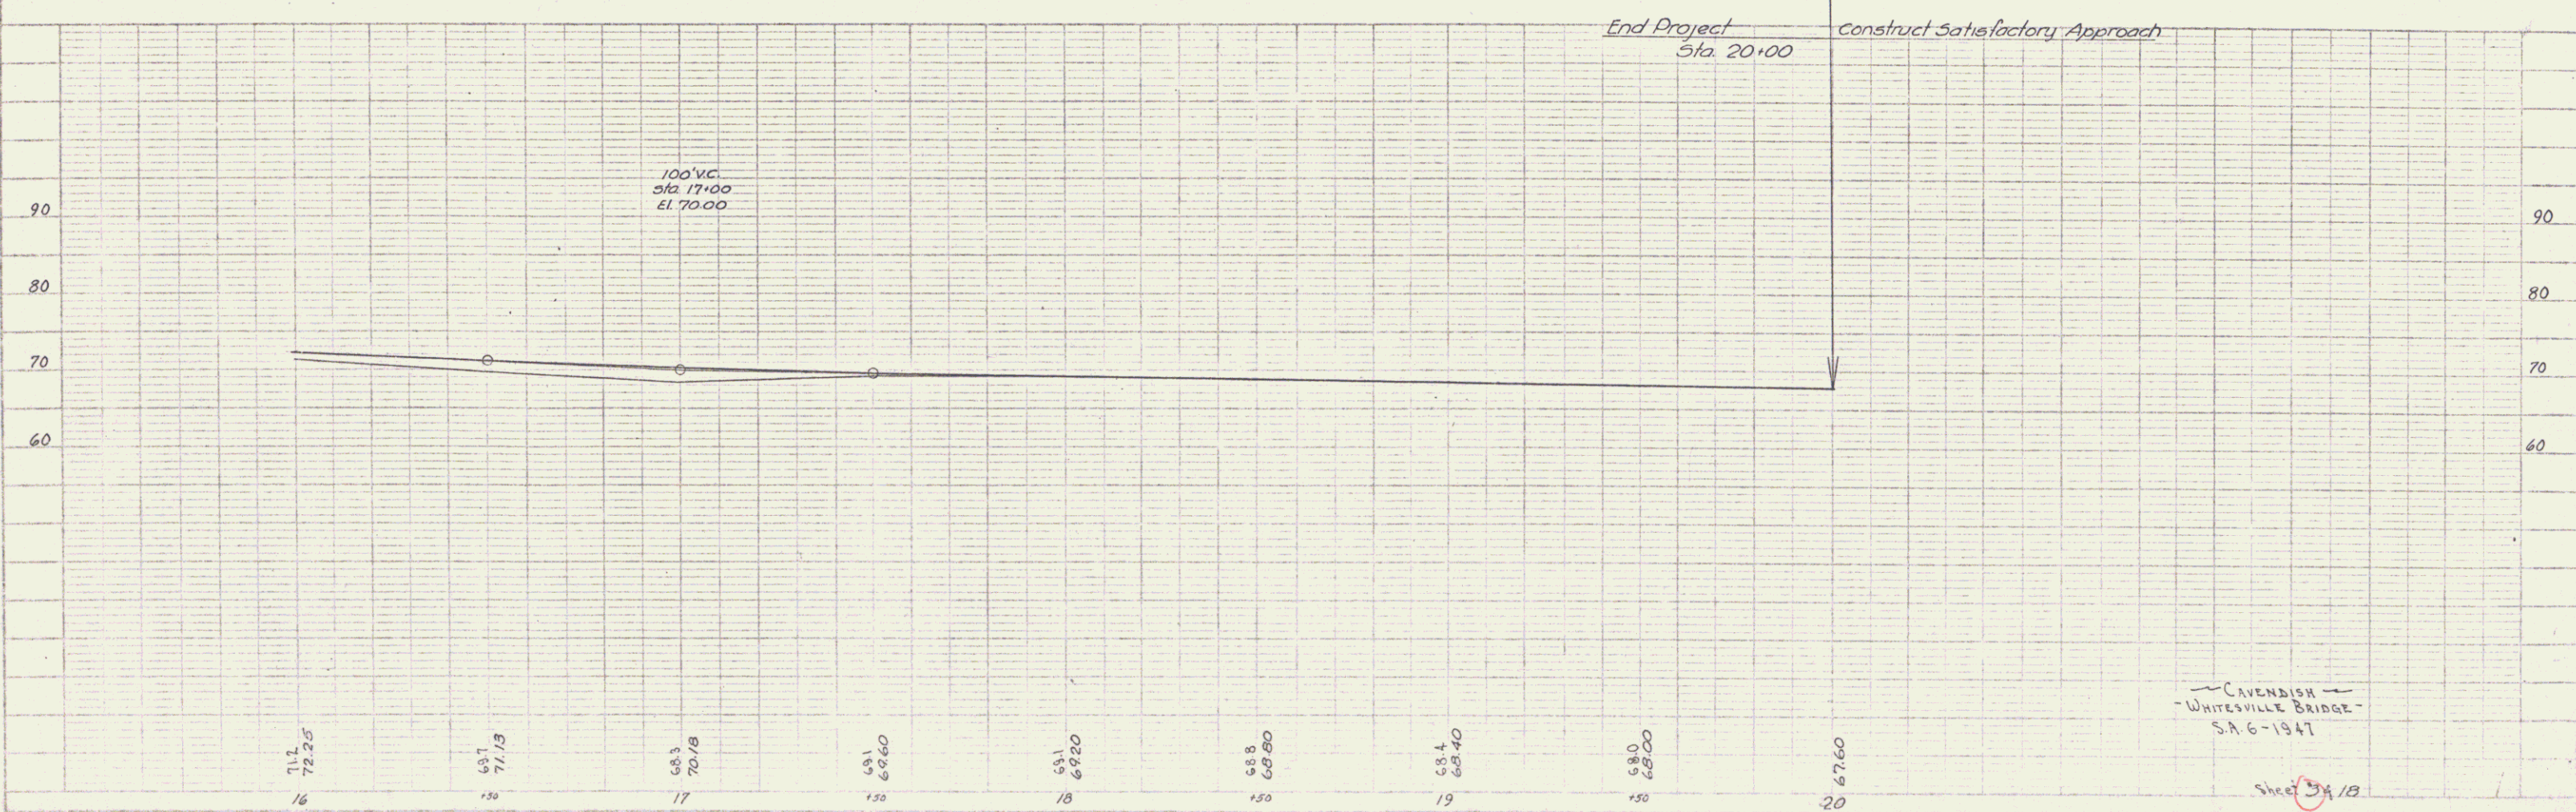


PLAN  
 DATE: 10/1/54  
 DRAWN BY: A. E. WOOD  
 CHECKED BY: A. E. WOOD  
 NO. 1074 800  
 FOR WHAT ENGINEER:

PROFILE  
 DATE: 10/1/54  
 DRAWN BY: A. E. WOOD  
 CHECKED BY: A. E. WOOD  
 NO. 1074 800  
 FOR WHAT ENGINEER:

Curve Data  
 $\Delta$  6°-30' Lt.  
 D 2°-45'  
 R 2083.7  
 T 118.3  
 L 236.4  
 E 3.4

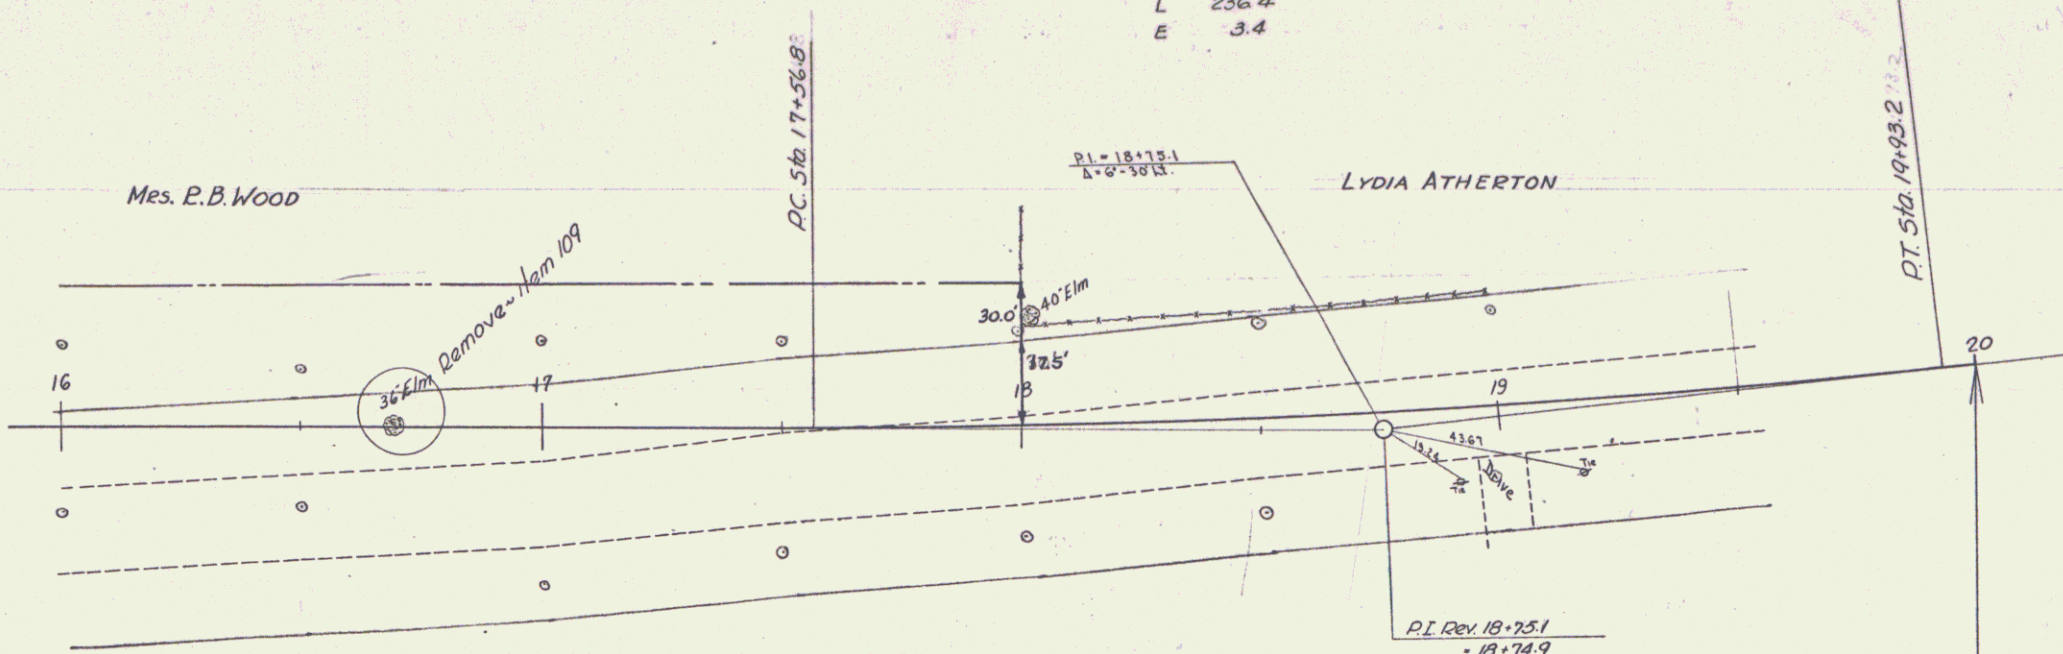

CAVENISH  
 - WHITESVILLE BRIDGE -  
 S.A. 6-1847

Sheet 18