

INDEX OF SHEETS

SHEET NO. 1	TITLE PAGE
2	TYPICAL CROSS-SECTION OF IMPROVEMENT DOUBLE TACK COAT OF REPAVED TAP WITH SAND-GRAVEL, 100L, ITEM 514-A
3	BANKING AND WIDENING TABLES
4	QUANTITY SHEET ITEMS AND DRAINAGE
5-6	EARTHWORK SHEETS
7	CONSTRUCTION DETAILS (DRAINAGE AND MARKERS)
8	CONSTRUCTION DETAILS CD-1 (DITCHES)
9-12	PLAN AND PROFILE SHEETS
13	STANDARD STRUCTURE SHEET S-40 (BARRICADES, SIGNS & LIGHTS)
14-20	CROSS-SECTIONS

STANDARD STRUCTURE SHEET APPROVED BY THE CHIEF ENGINEER, VERMONT STATE DEPARTMENT OF HIGHWAYS
S-40 JUNE 10, 1950

DIV. NO.	STATE	FED. AID PROJ. NO.	FISCAL YEAR	SHEET NO.	TOTAL SHEETS
1	Vt.	S 89(13)	1950	1	20


STATE OF VERMONT
STATE HIGHWAY DEPARTMENT

PLAN AND PROFILE OF PROPOSED
STATE HIGHWAY

SECONDARY PROJECT

TOWN OF CAVENDISH
COUNTY OF WINDSOR
VERMONT ROUTE 131
WEATHERSFIELD-CAVENDISH ROAD

Pin# 99R642

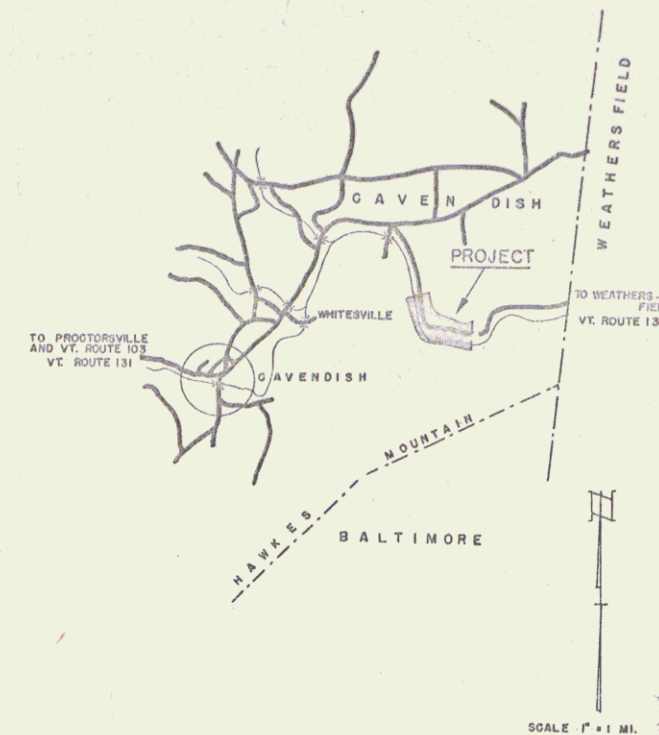

BEGINNING AT A POINT APPROXIMATELY 2.23 MILES WEST OF THE WEATHERSFIELD-CAVENDISH TOWN LINE AND EXTENDING EASTERLY 4,450.5 FT.
LENGTH OF PROJECT 4,450.5 FEET = 0.843 MILE



RIGHT-OF-WAY DIVISION
TOWN FILE
PERPETUAL
Town of UT 131
(To Be Returned To R.O.W. Division)

APPROVED: Nov 21 1950
H.E. Saugens
CHIEF ENGINEER
SUBMITTED BY ORDER OF THE STATE HIGHWAY BOARD

NOTE: ANY FURTHER INFORMATION CONCERNING FINAL QUANTITIES, AMOUNTS OR OTHER DETAILS RELATIVE TO THIS PROJECT MAY BE FOUND IN EITHER THE FIELD BOOKS OR THE ESTIMATE FILE.

DEPARTMENT OF COMMERCE
BUREAU OF PUBLIC ROADS

RECOMMENDED FOR APPROVAL

DISTRICT ENGINEER DATE

APPROVED:

DIVISION ENGINEER DATE

APPROVED: Nov 29 1950 Nov 21 1950 Nov 21 1950 Nov 23 1950
CONSTRUCTION ENGINEER SECONDARY ENGINEER ROAD ENGINEER DISTRICT ENGINEER
SHEET 1 OF 20

STEARNS R. JENKINS

UT 131

PROJECT NAME & NUMBER CAVENDISH S 29(13)	PAVEMENT AREA 10000 S.Y.
RECORD PLANS	TYPE DOUBLE TACK WITH SAND-GRAVEL
MATERIALS	STONE STATE PIT, PERKINSVILLE R.C.P. GLENS FALLS BLDG. & SUPPLY CO., GLENS FALLS, N.Y.
CONTRACTOR - M. J. BARRINGTON, JR.	CONTRACT DATED 8/24/50 CONTRACT STARTED 8/24/50 CONTRACT COMPLETED 7/8/53
INSPECTOR - R. J. WOODGARD	
RECORD PLANS - S.V. CLIFFORD	
CONTRACTOR - M. J. BARRINGTON, JR.	
INSPECTOR - R. J. WOODGARD	
RECORD PLANS - S.V. CLIFFORD	

CONTRACTOR: M. J. Barrington, Jr.
LOCATION: See title sheet

GROUND ELEVATION - DATUM _____ LINE _____
GRADE ELEVATION - DATUM _____ LINE _____

CURVE DATA
DEFLECTION ANGLE Δ
DEGREE OF CURVE D
RADIUS OF CURVE R
TANGENT DISTANCE T
LENGTH OF CURVE L
EXTERNAL DISTANCE E
POINT OF INTERSECTION P. I.
POINT OF CURVE P. C.
POINT OF TANGENT P. T.
POINT ON TANGENT P. O. T.

SCALES
TITLE 1" = 300'
TYPICAL 1" = 2'
PLAN 1" = 50'
PROFILE HORIZONTAL 1" = 50'
PROFILE VERTICAL 1" = 10'
CROSS SECTIONS 1" = 5'

THESE PLANS ARE SUBJECT TO SUCH REVISIONS AS MAY BE REQUIRED BY THE BUREAU OF PUBLIC ROADS OR THE COMMISSIONER OF HIGHWAYS.
CONSTRUCTION IS TO BE CARRIED ON IN ACCORDANCE WITH THE PLANS AND THE STANDARD ROAD AND BRIDGE SPECIFICATIONS OF 1936, AS APPROVED JULY 25 1949 BY THE BUREAU OF PUBLIC ROADS INCLUDING ALL SUBSEQUENT APPROVED REVISIONS AND SUCH REVISED SPECIFICATIONS AND SPECIAL PROVISIONS AS ARE SUBMITTED WITH THE PLANS.