
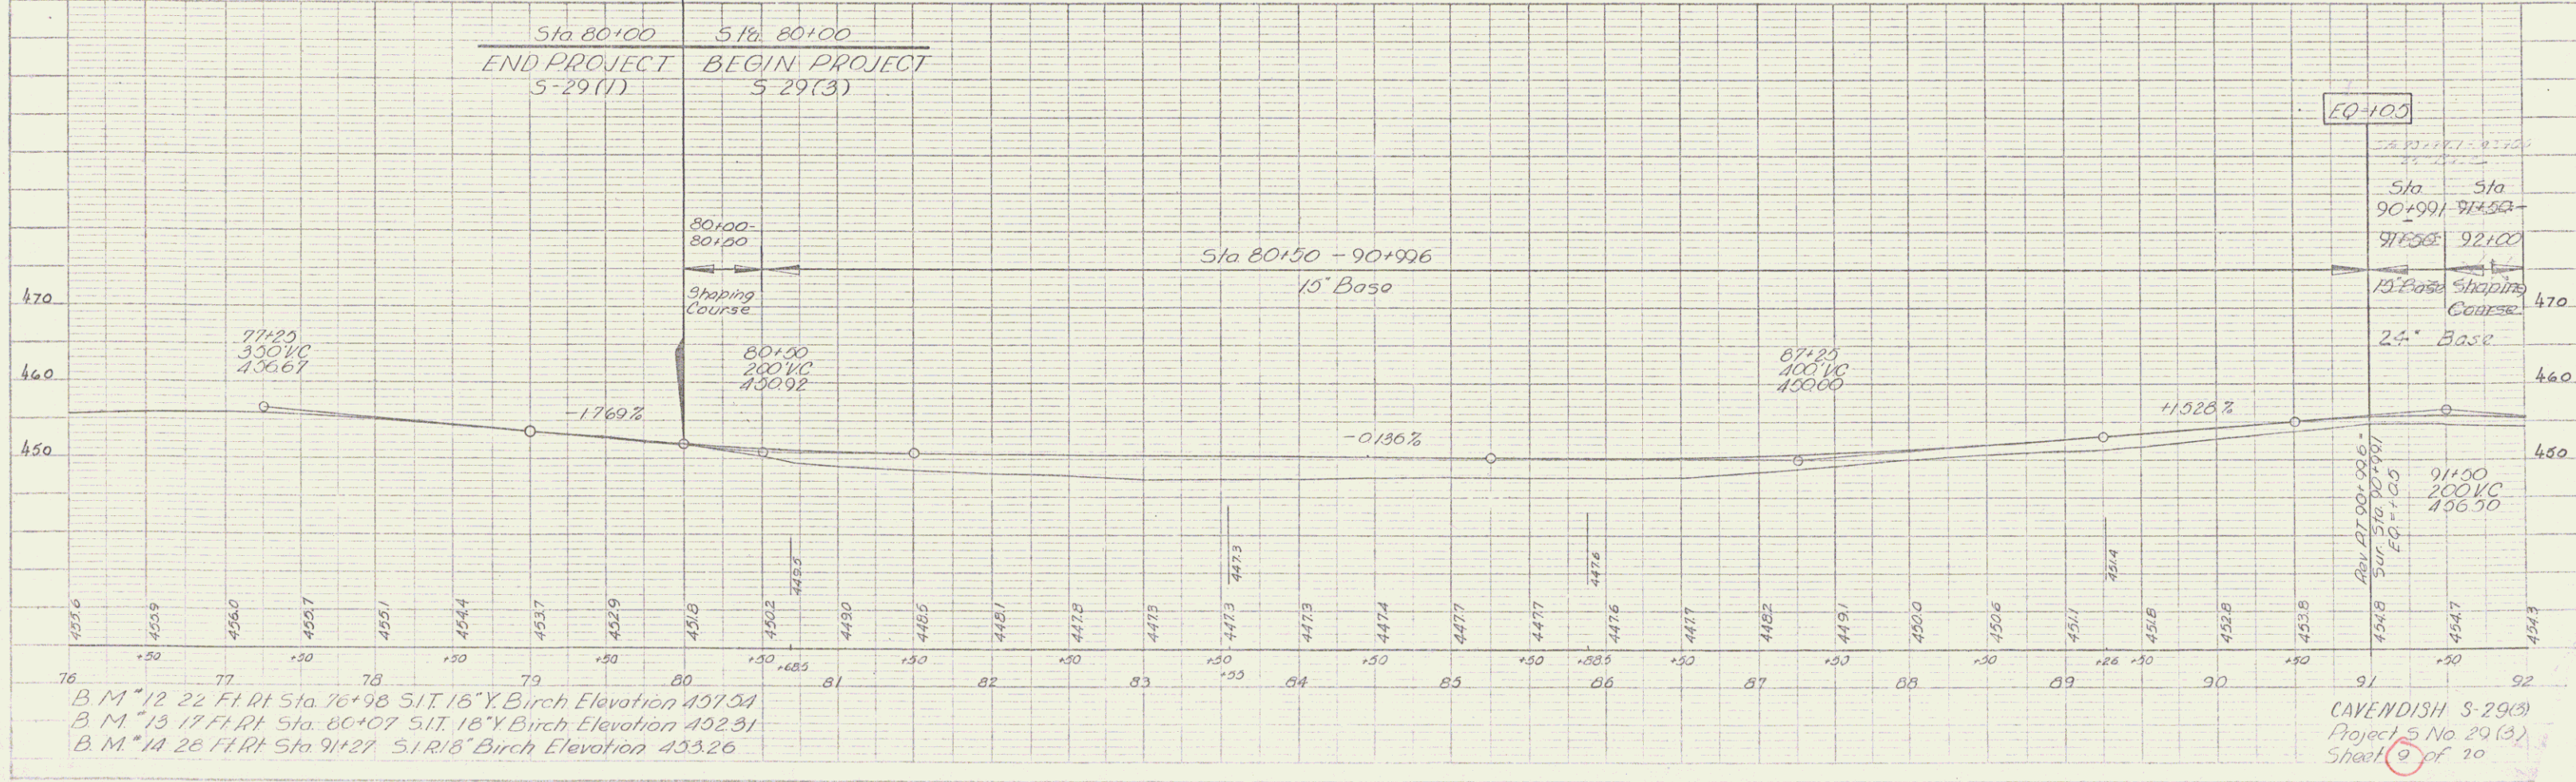


PLAN	DATE	SCALE
REVISION	BY	DATE
1
2
3
4
5
6
7
8
9
10

NO.	DESCRIPTION
1	...
2	...
3	...
4	...
5	...
6	...
7	...
8	...
9	...
10	...

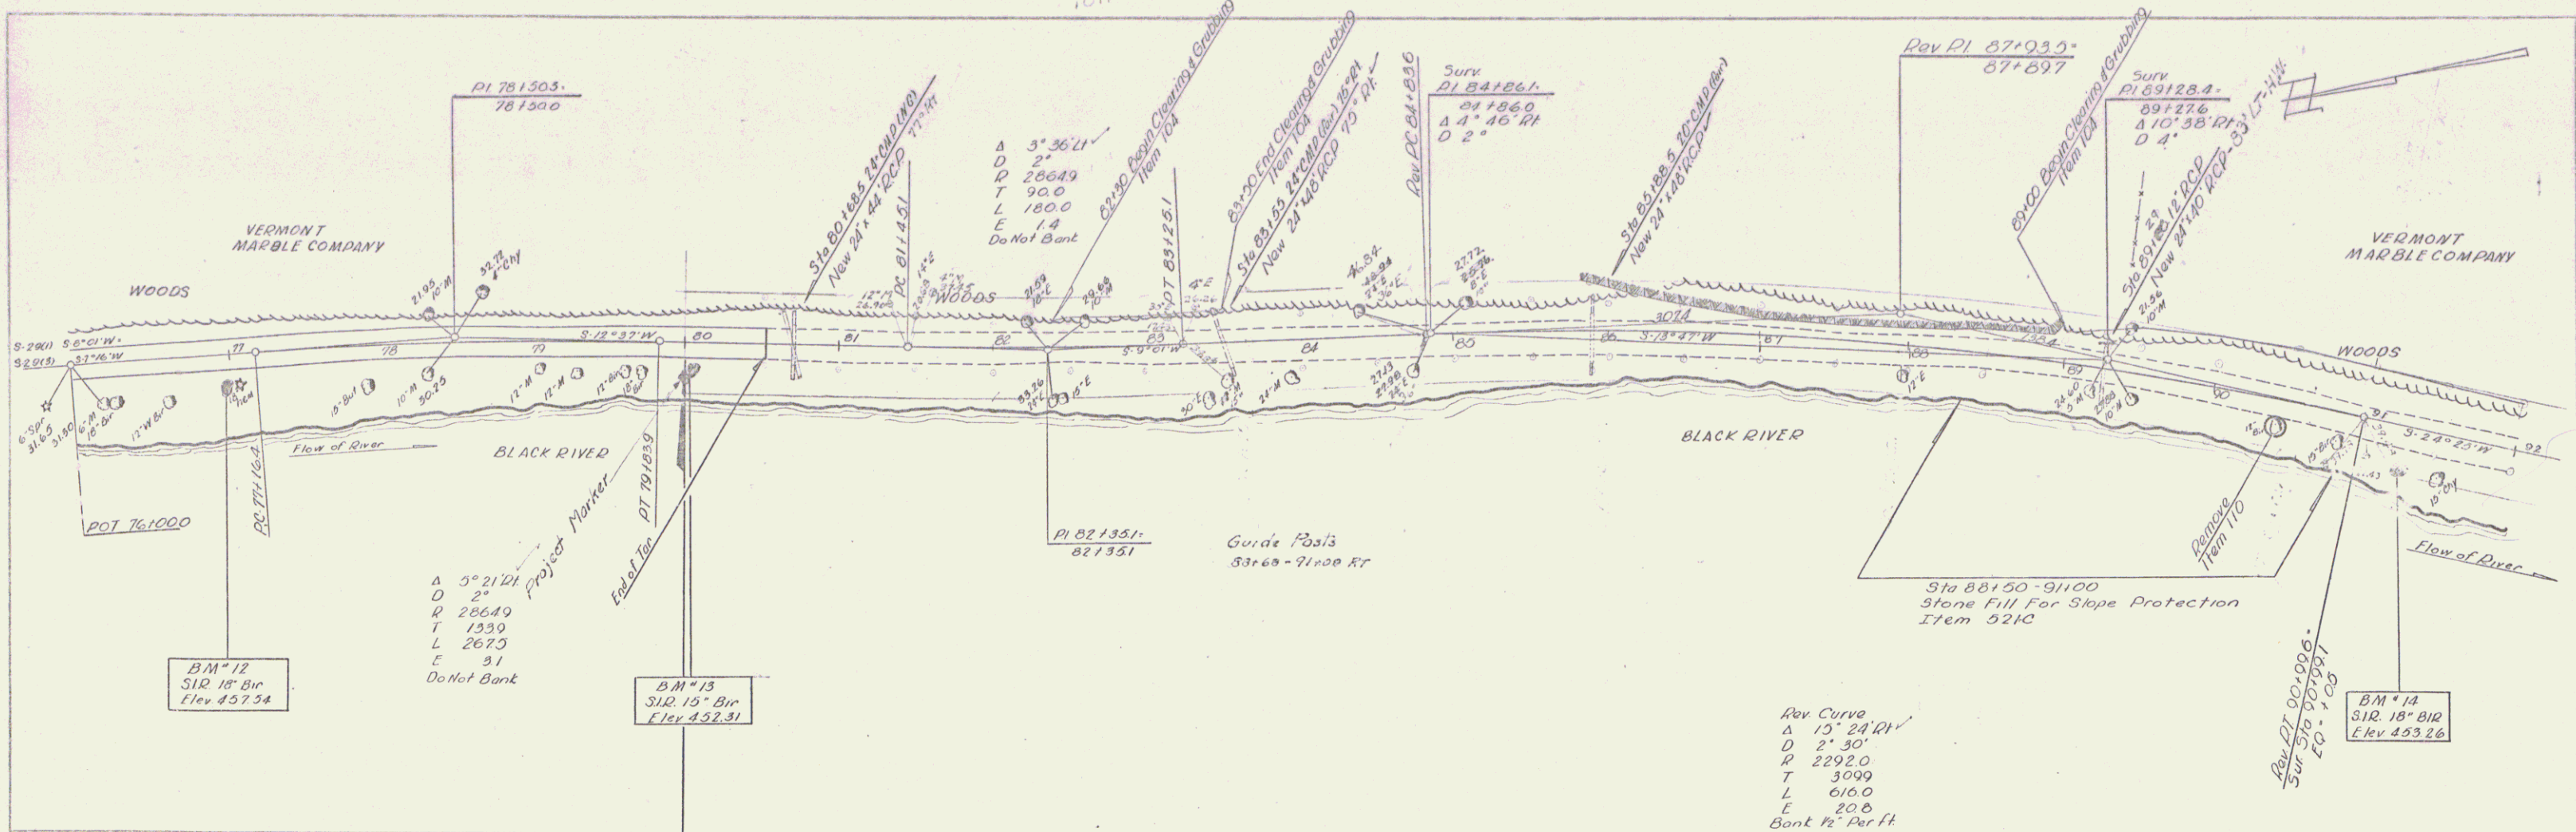

B.M. 12 22 FT RT Sta 76+98 5 1/2" Y. Birch Elevation 457.54
 B.M. 13 17 FT RT Sta 80+07 5 1/2" Y. Birch Elevation 452.31
 B.M. 14 28 FT RT Sta 91+21 5 1/2" Y. Birch Elevation 453.26

CAVENDISH S-29(B)
 Project 5 No 29 (3)
 Sheet 9 of 10