


PLAN
 DATE: 1/16/82
 DRAWN BY: J. H. [unclear]
 CHECKED BY: [unclear]
 PROJECT: [unclear]


PROFILE
 DATE: 1/16/82
 DRAWN BY: J. H. [unclear]
 CHECKED BY: [unclear]
 PROJECT: [unclear]

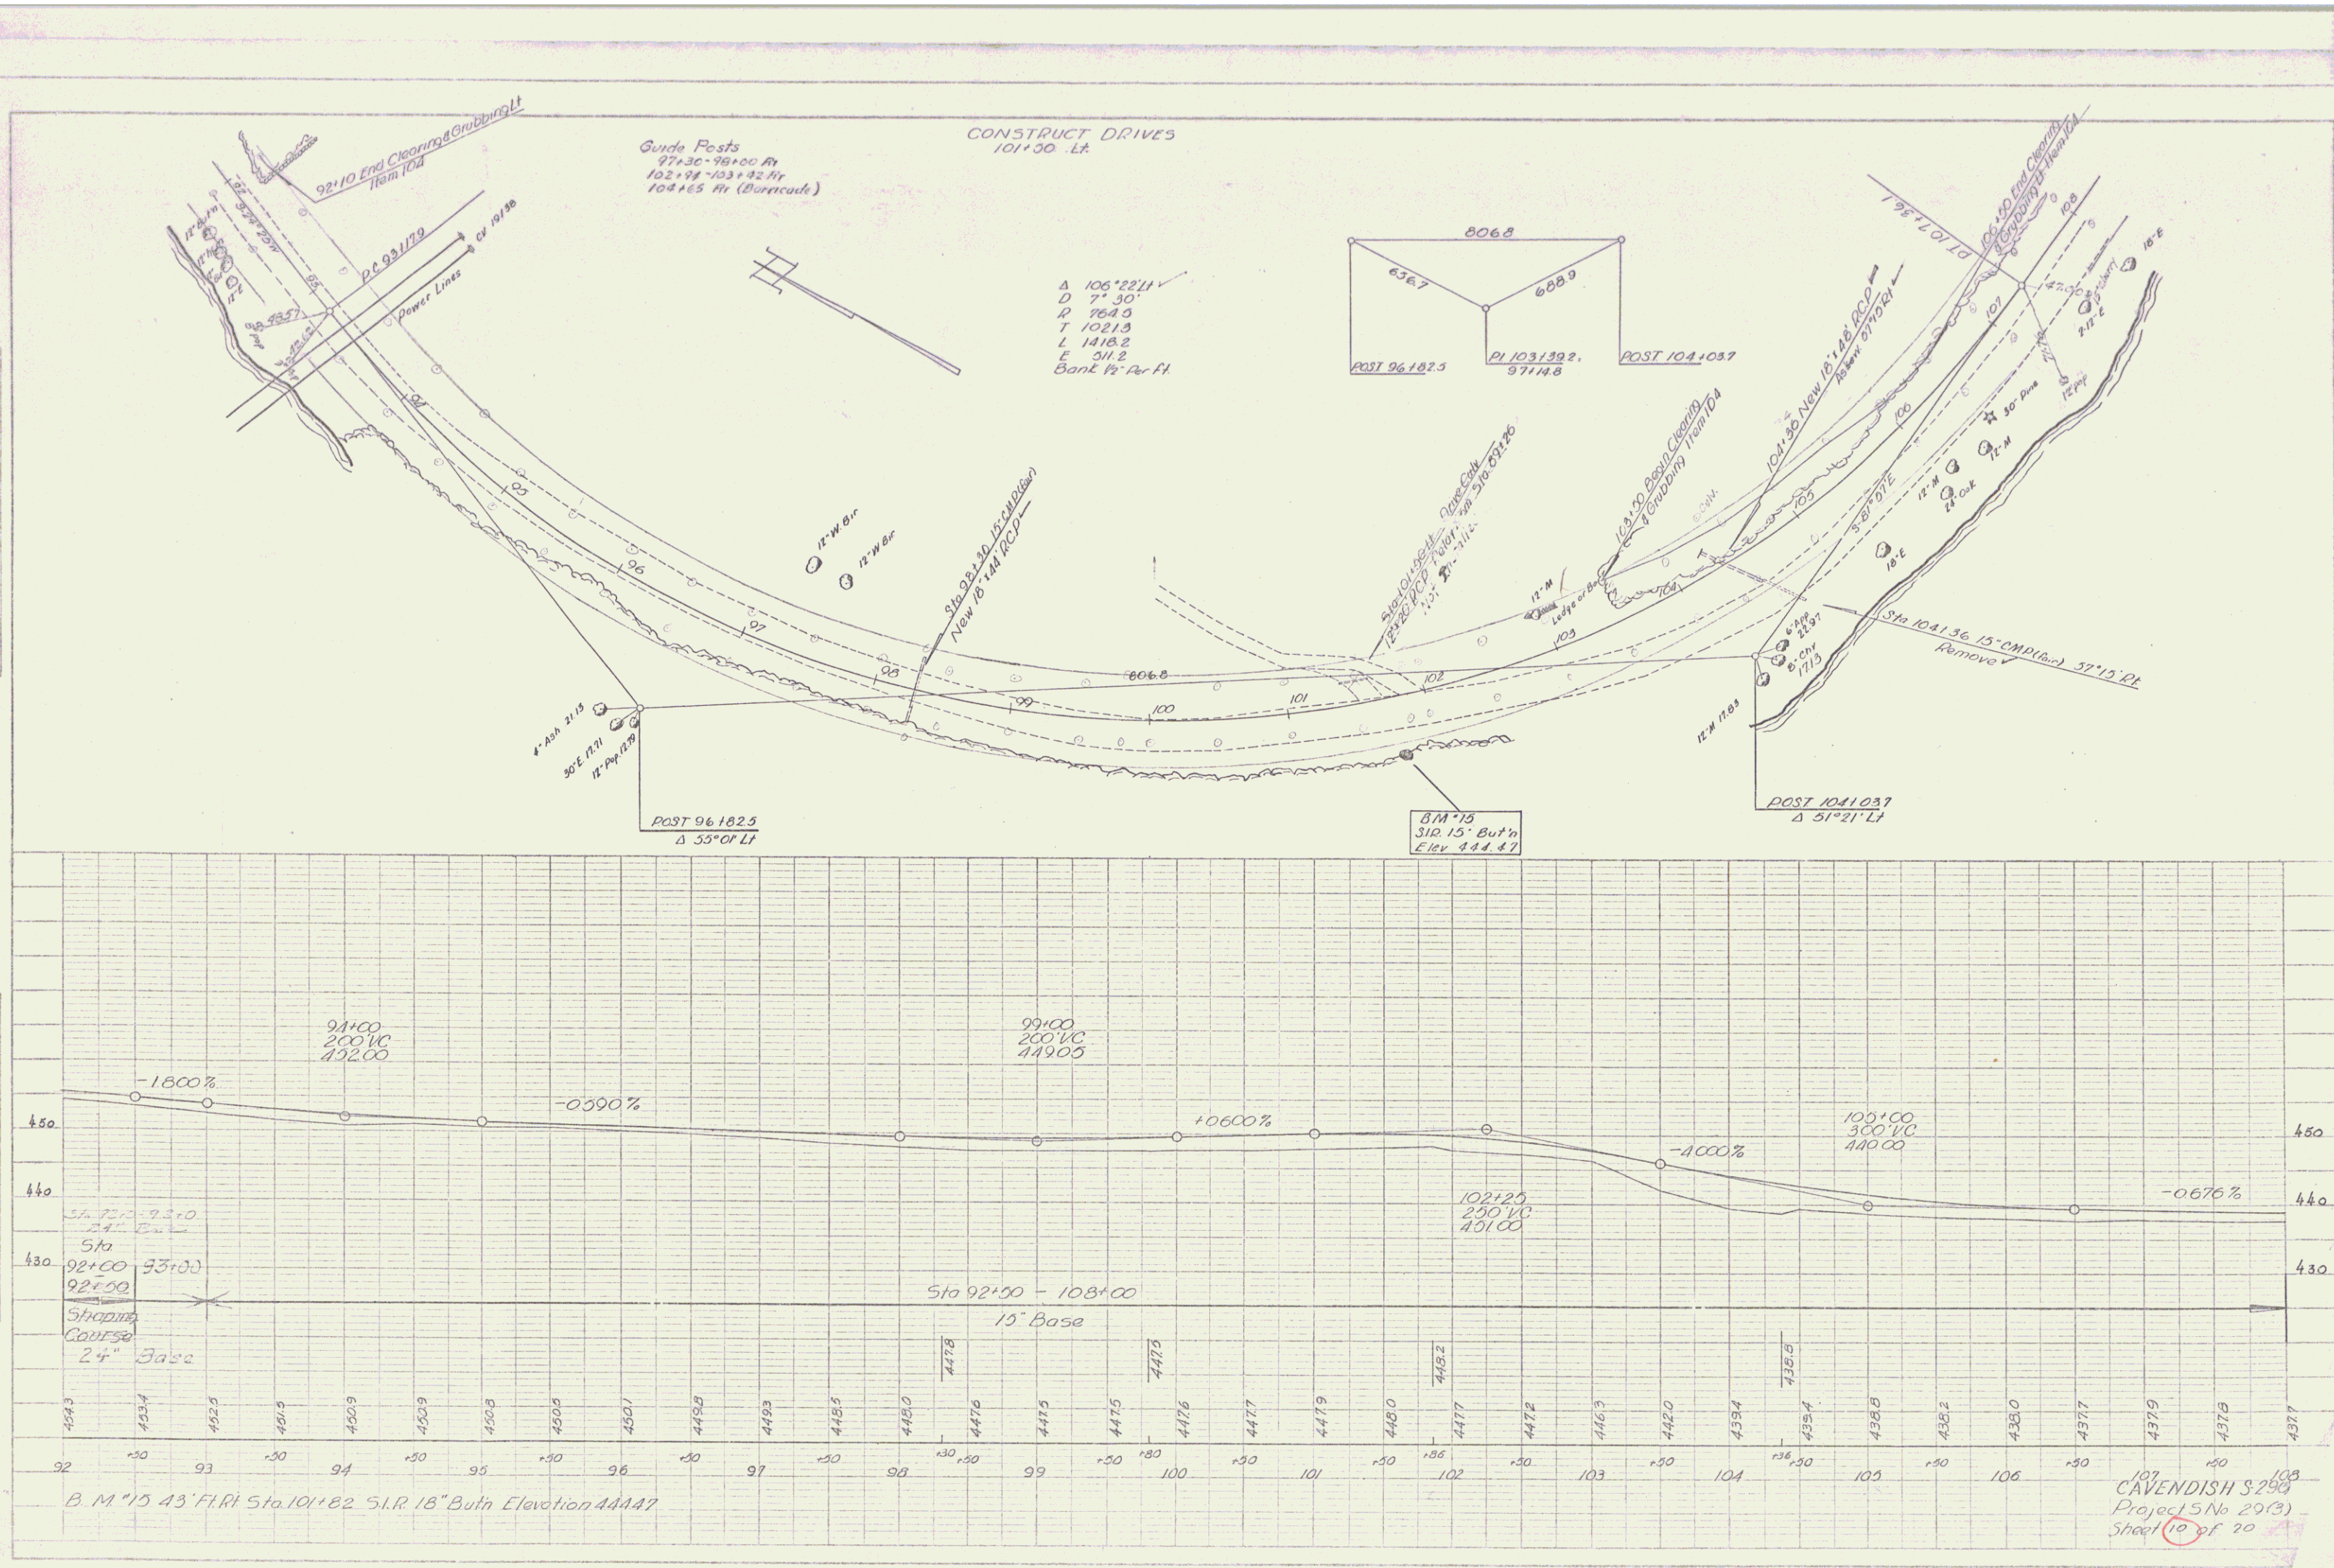

Guide Posts
 97+30 - 99+00 R/L
 102+94 - 103+42 R/L
 104+65 R/L (Barricade)

CONSTRUCT DRIVES
 101+30 L/R

A 106°22'11\"/>
 D 7'30\"/>
 P 764.5
 T 1021.3
 L 1418.2
 E 511.2
 Bank Pt Per Fl.

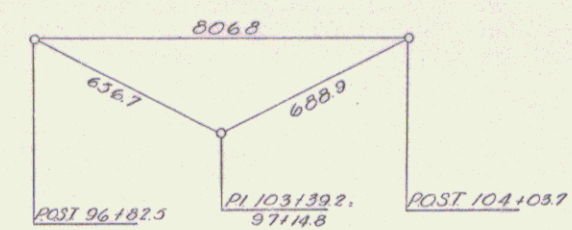

POST 96+182.5
 Δ 55°01'17\"/>
 17' W 8' R

B.M. 15
 S.I.R. 15' Butt'n
 Elev. 444.47

POST 104+037
 Δ 51°21'17\"/>
 12' W 17' R

B.M. 15 43' F.I.R. Sta. 101+82 S.I.R. 18' Butt'n Elevation 444.47

107
 CAVENDISH S-290
 Project 5 No. 29(3)
 Sheet 10 of 20