
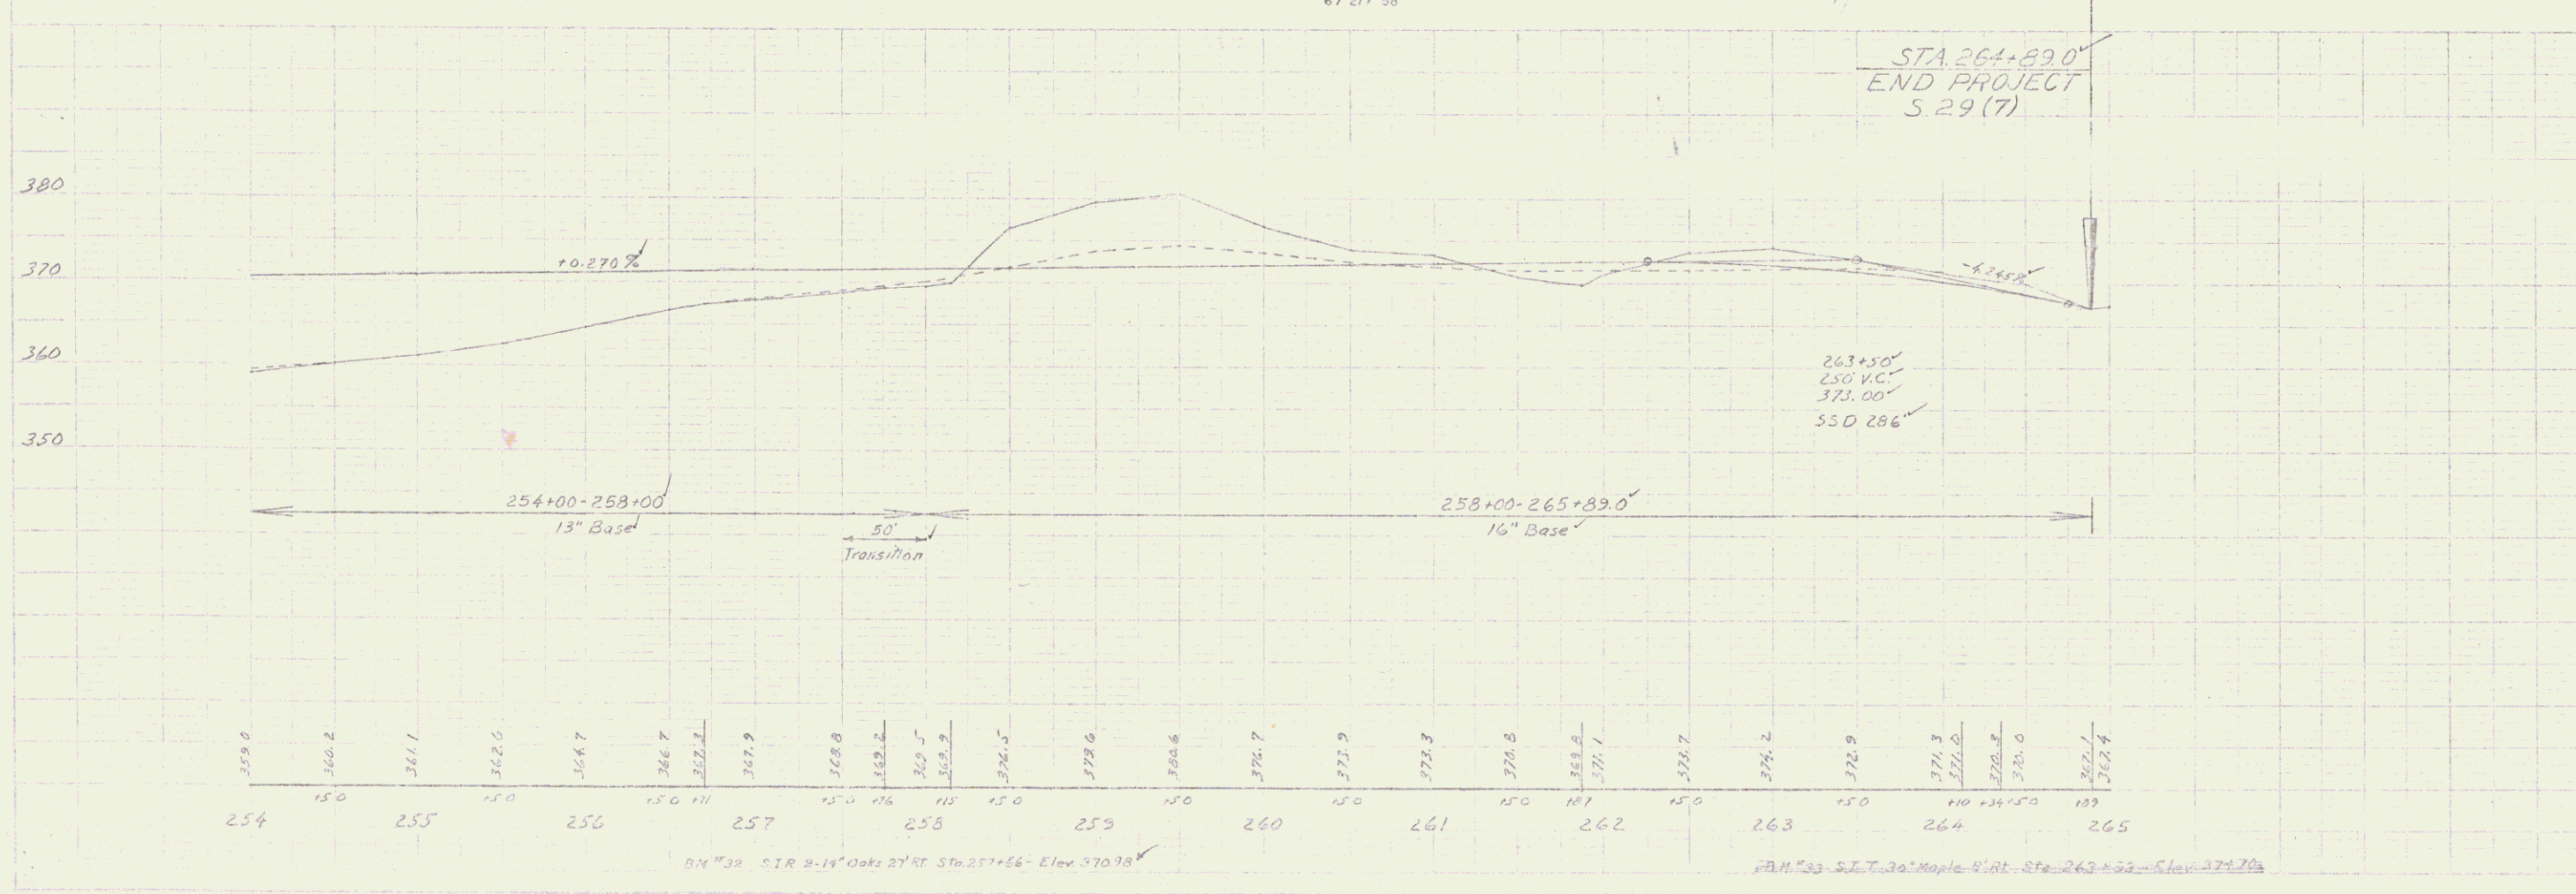


254
 255
 256
 257
 258
 259
 260
 261
 262
 263
 264
 265

254
 255
 256
 257
 258
 259
 260
 261
 262
 263
 264
 265

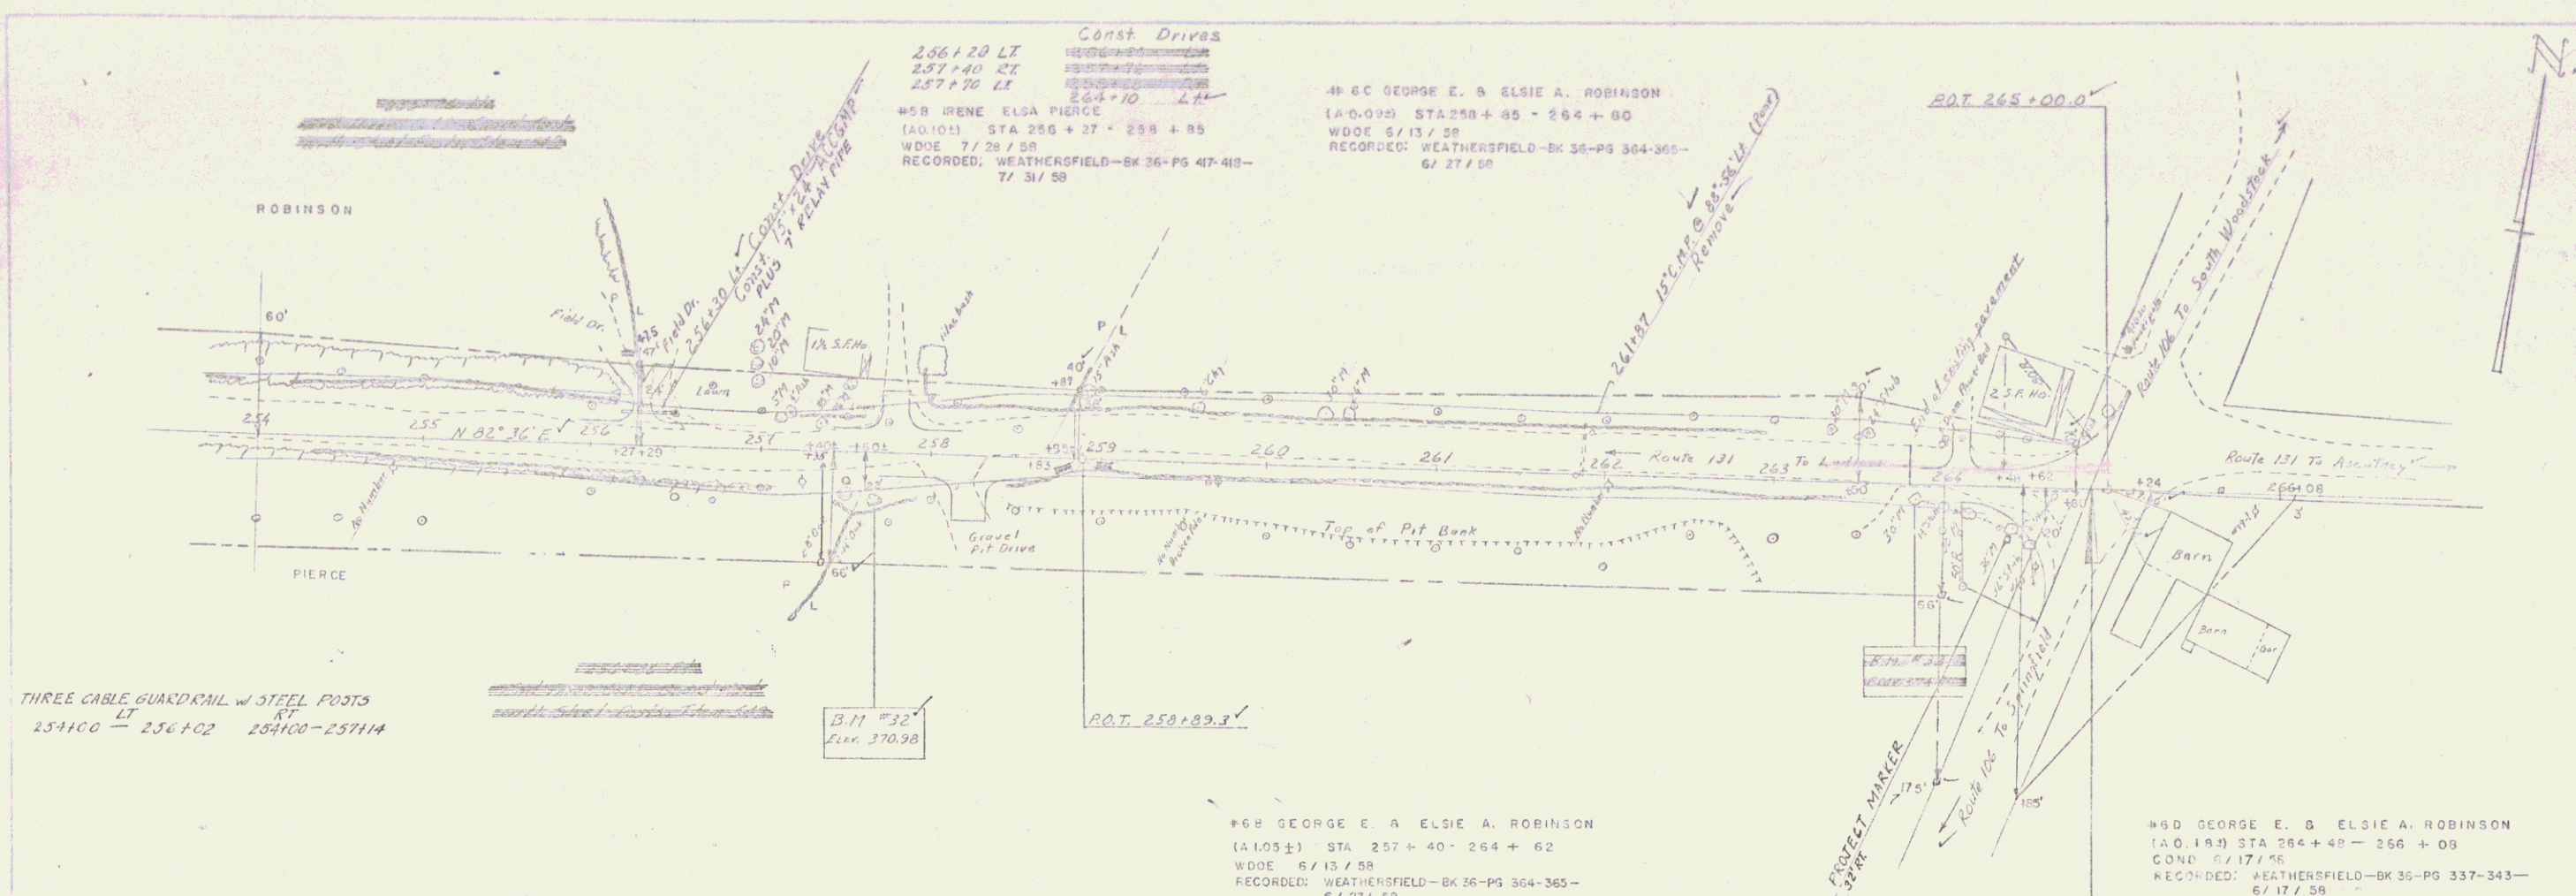

WEATHERFIELD
 Wayne D. N. G. 100 (2)
 Sheet 11 of 63 sheets
 63