


1/10/08
 12/28
 H. Hurley
 4 Tr.
 12/15/08
 2/04

12/15/08
 2/04
 4 Tr.
 12/15/08
 2/04

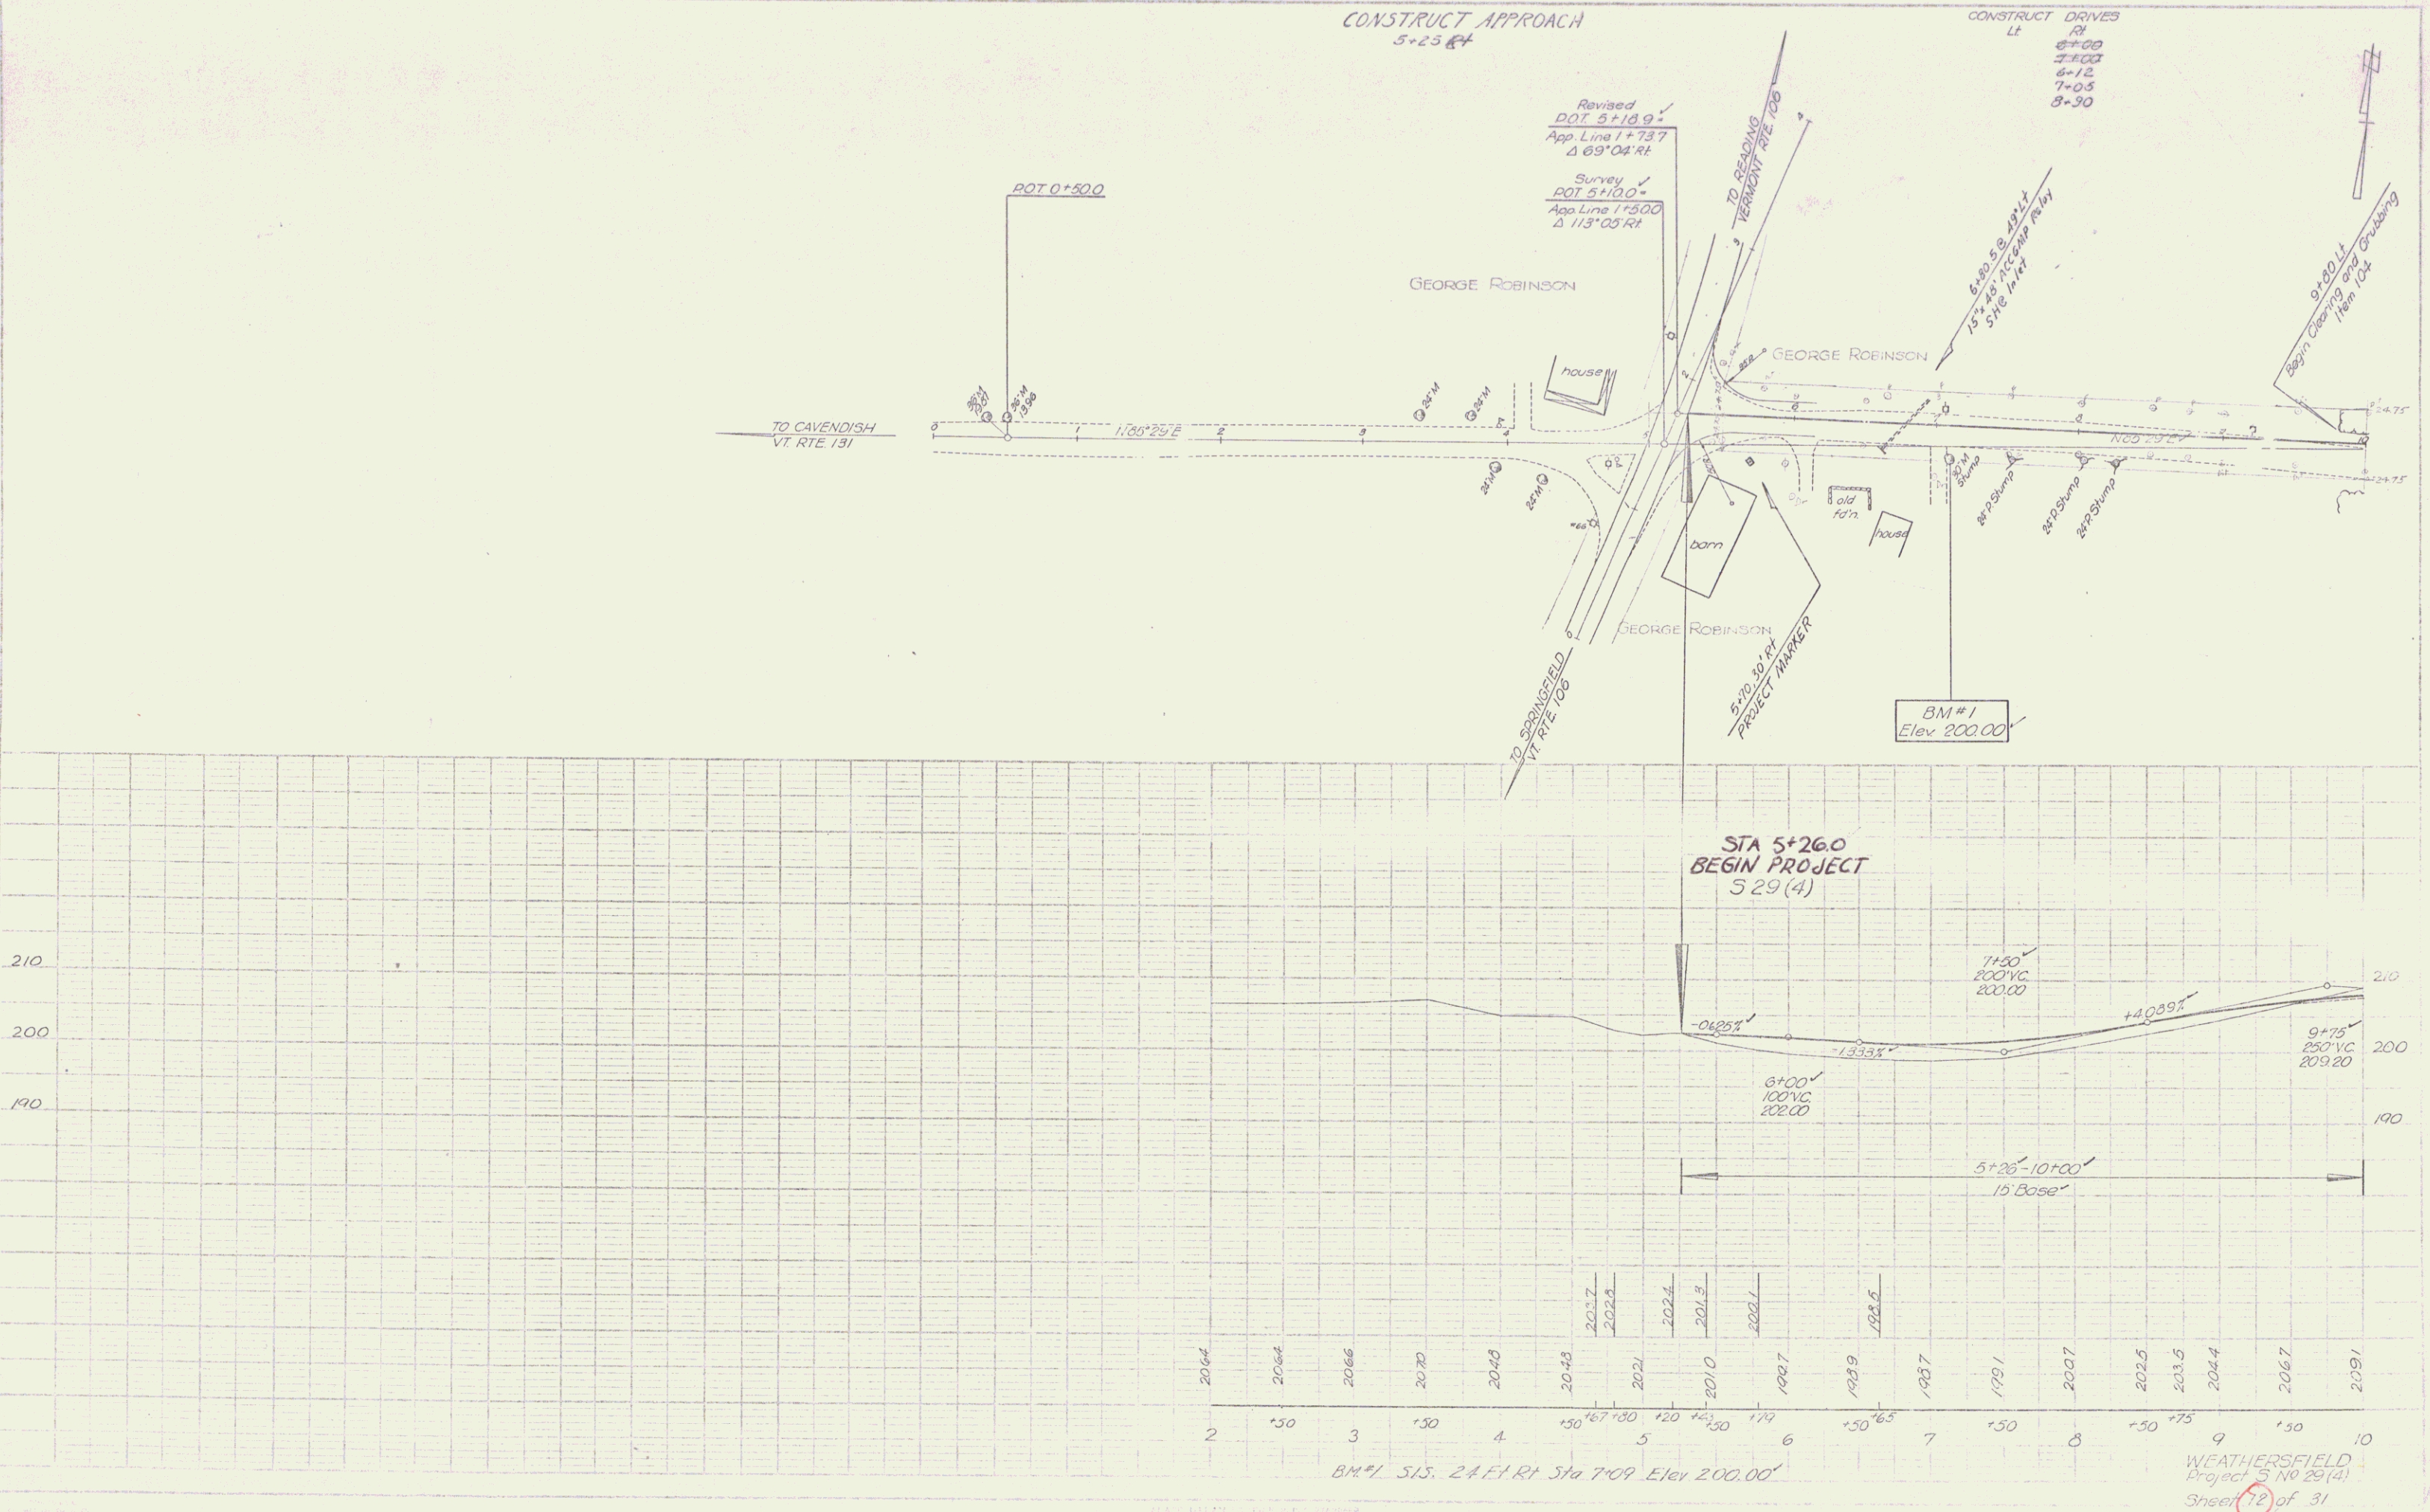

BM #1 SLS. 2+41 RT Sta 7+09 Elev 200.00

WEATHERSFIELD
 Project 5 No 28(4)
 Sheet 12 of 31