


DATE: 11/23/1933
 DRAWN BY: HURLEY
 CHECKED BY: [Signature]
 PROJECT: WEATHERSFIELD
 SHEET: 15 OF 31

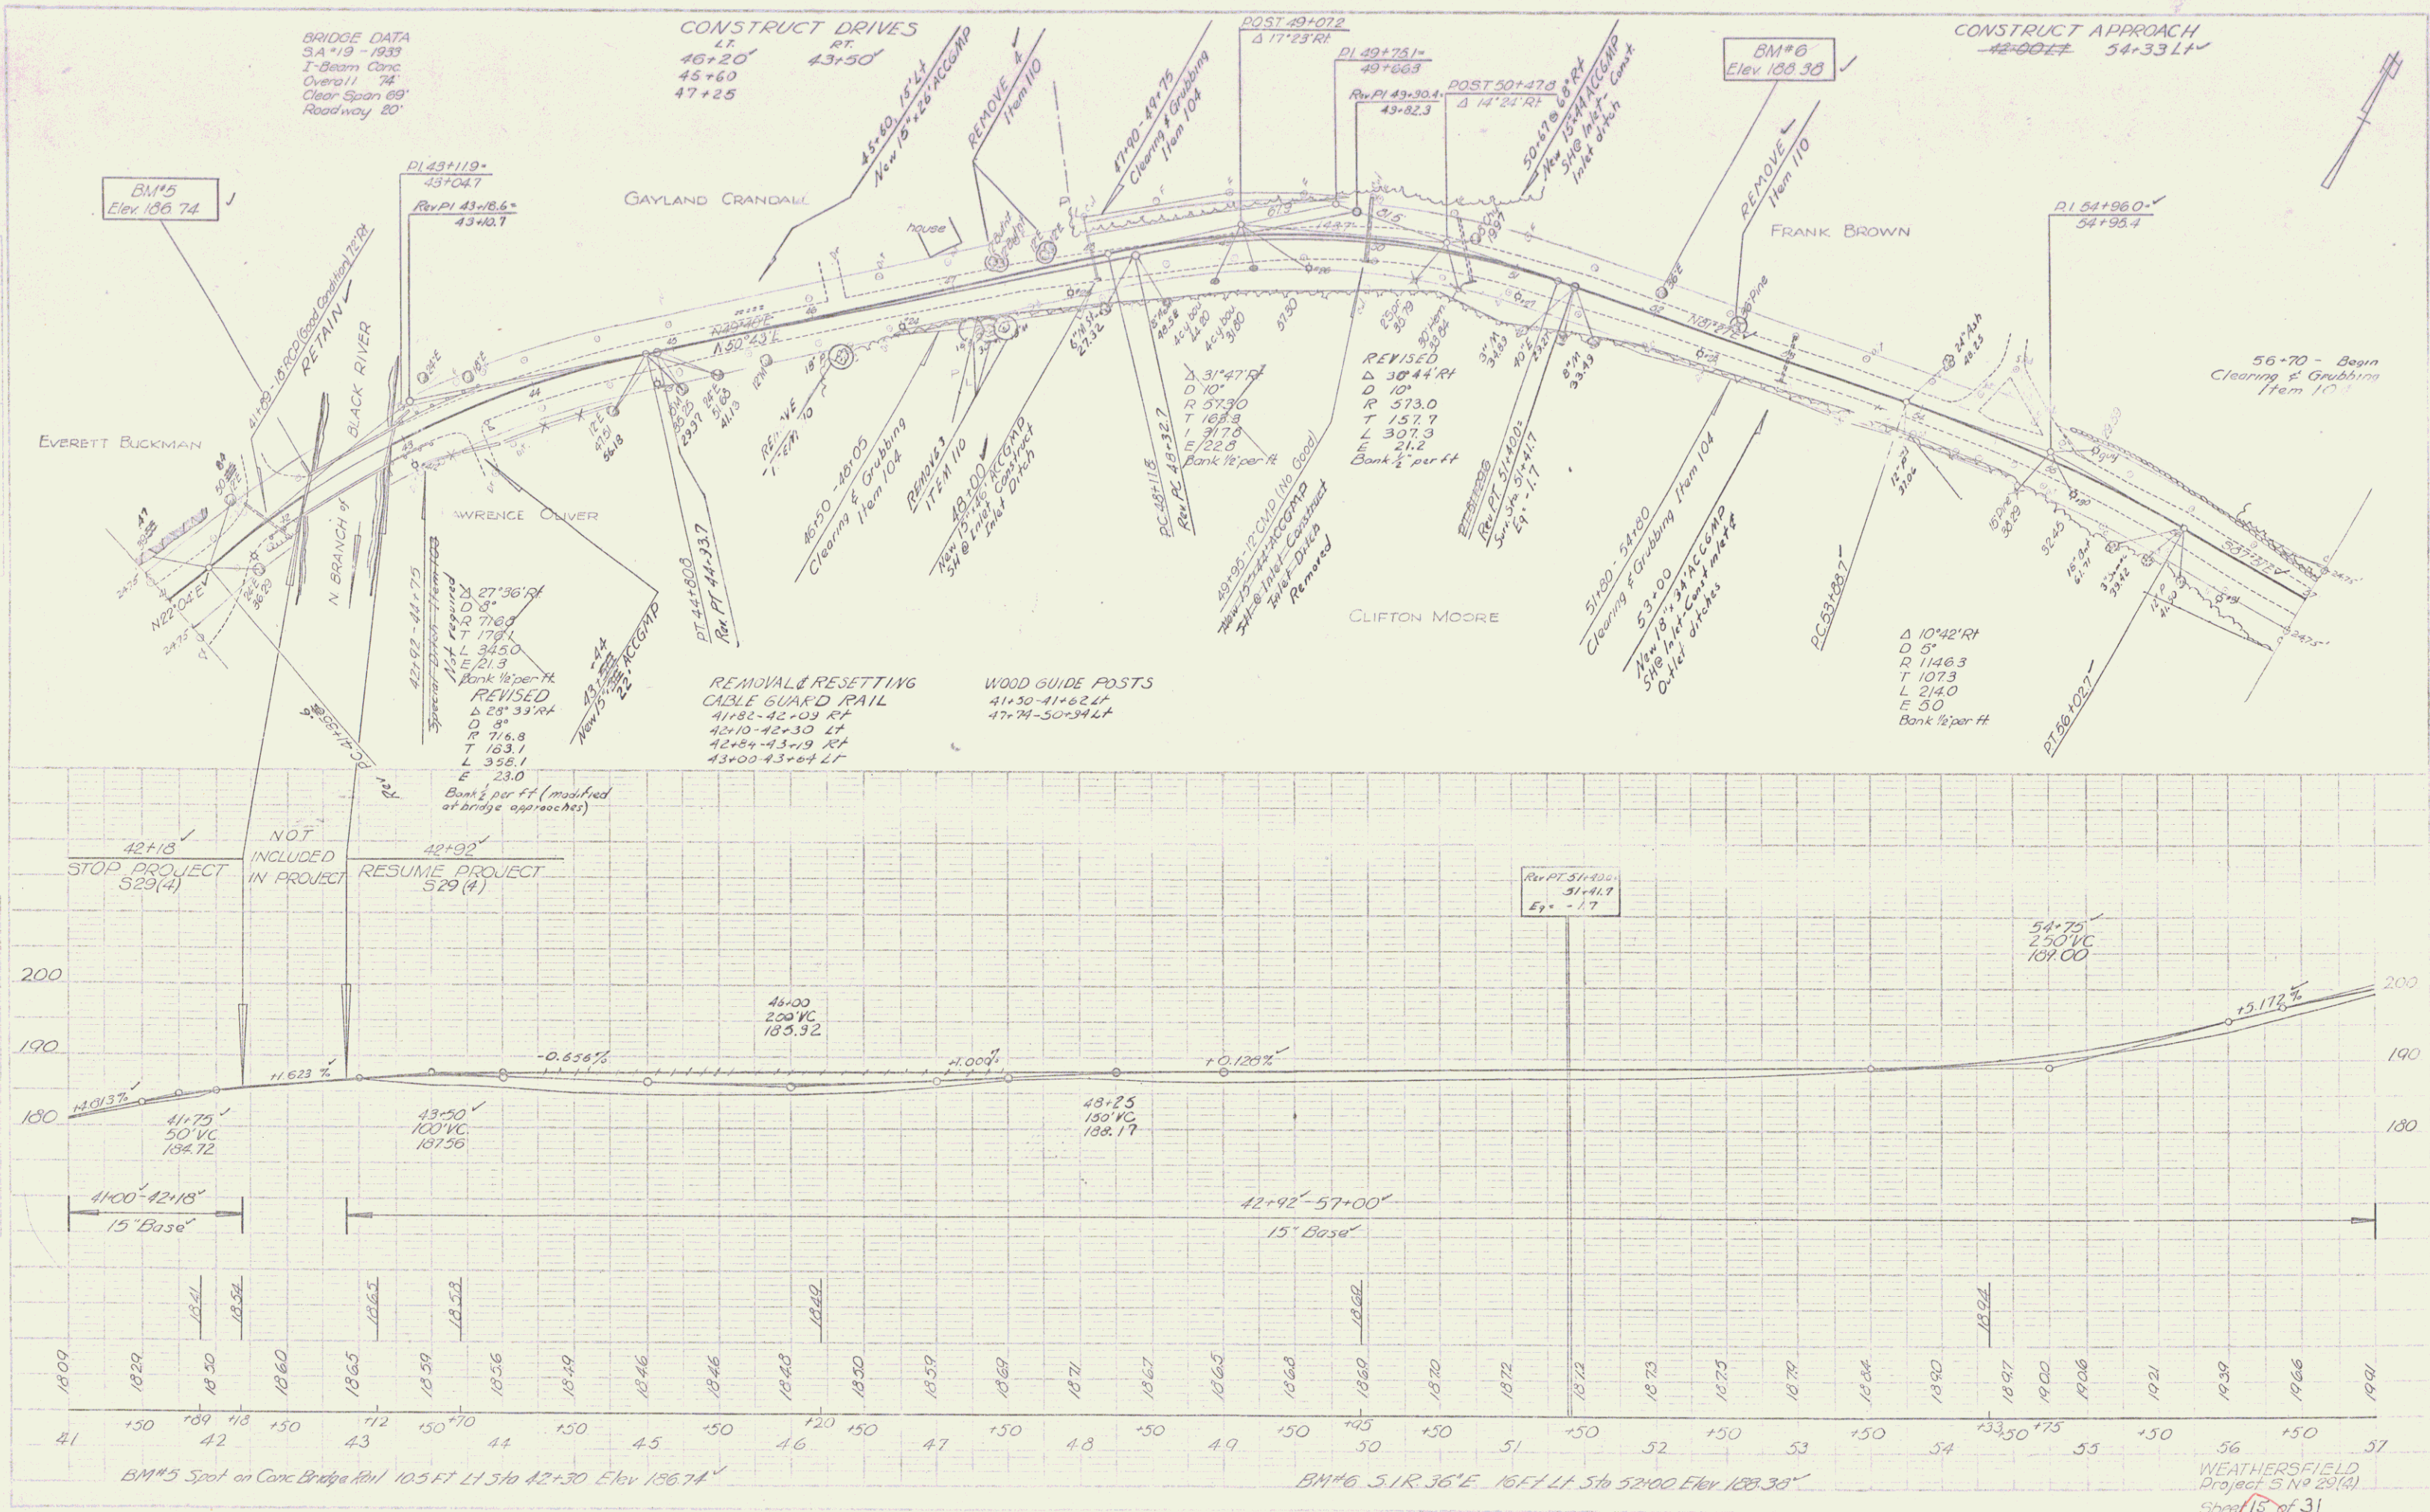

BRIDGE DATA
 3A*19 - 1933
 T-Beam Conc
 Over 11' 7"
 Clear Span 89'
 Roadway 20'

CONSTRUCT DRIVES
 LT RT
 46+20 43+50
 45+60
 47+25

CONSTRUCT APPROACH
 42+00E 54+33L

BM#5
 Elev 186.74

BM#6
 Elev 188.38

EVERETT BUCKMAN

WRENCE OLIVER

GAYLAND CRANDALL

CLIFTON MOORE

FRANK BROWN

56+70 - Begin
 Clearing & Grubbing
 Item 10

42+13
 STOP PROJECT
 S29(4)

NOT
 INCLUDED
 IN PROJECT

42+00
 RESUME PROJECT
 S29(4)

REMOVAL & RESETTLED
 CABLE GUARD RAIL
 41+82-42+03 RT
 42+10-42+30 LT
 42+84-43+09 RT
 43+00-43+24 LT

WOOD GUIDE POSTS
 41+50-41+62 LT
 47+74-50+34 LT

BM#5 Spot on Conc Bridge Abut 105 FT L1 S to 42+30 Elev 186.74

BM#6 S.I.R. 36'E 16 FT L1 S to 52+00 Elev 188.38

WEATHERSFIELD
 Project S N 29(4)
 Sheet 15 of 31