

#6C
ALEXANDER O. & CHRISTINE BERNIER
STA 131+65 - 133+80 LT
0.12 ACRES
WOOD 9/4/58
RECORDED: WEATHERSFIELD-BK 36-PG 421-449
8/1/58

CONST Drives
133+35 RT
134+50-20 RT
139+42 LT
141+25 LT
137+50 RT
144+25 RT



CONST Approach
144+25 RT

Revised Curve
Δ 25°-47' Lt
D 6°
R 955.4 V
T 218.7 V
L 429.7 V
E 2.4 V
Bank 1/2 part V

#7
CLAYTON H. & OLIVE M. LAGROW
STA 135+44-140+55
1.08 ACRES
WOOD 9/4/58
RECORDED: WEATHERSFIELD-BK 36-PG 450, 491
8/1/58

#9
ERNEST E. & BERNICE A. FONTAINE
STA 140+44-149+65
0.28 ACRES
COND 8/1/58
RECORDED: WEATHERSFIELD-BK 36-PG 421-449
8/1/58

#8A
GEORGE L. & LENA E. JARVIS
STA 138+15-144+07 E
0.17 ACRES
COND 8/1/58
RECORDED: WEATHERSFIELD-BK 36-PG 421-449-8/1/58

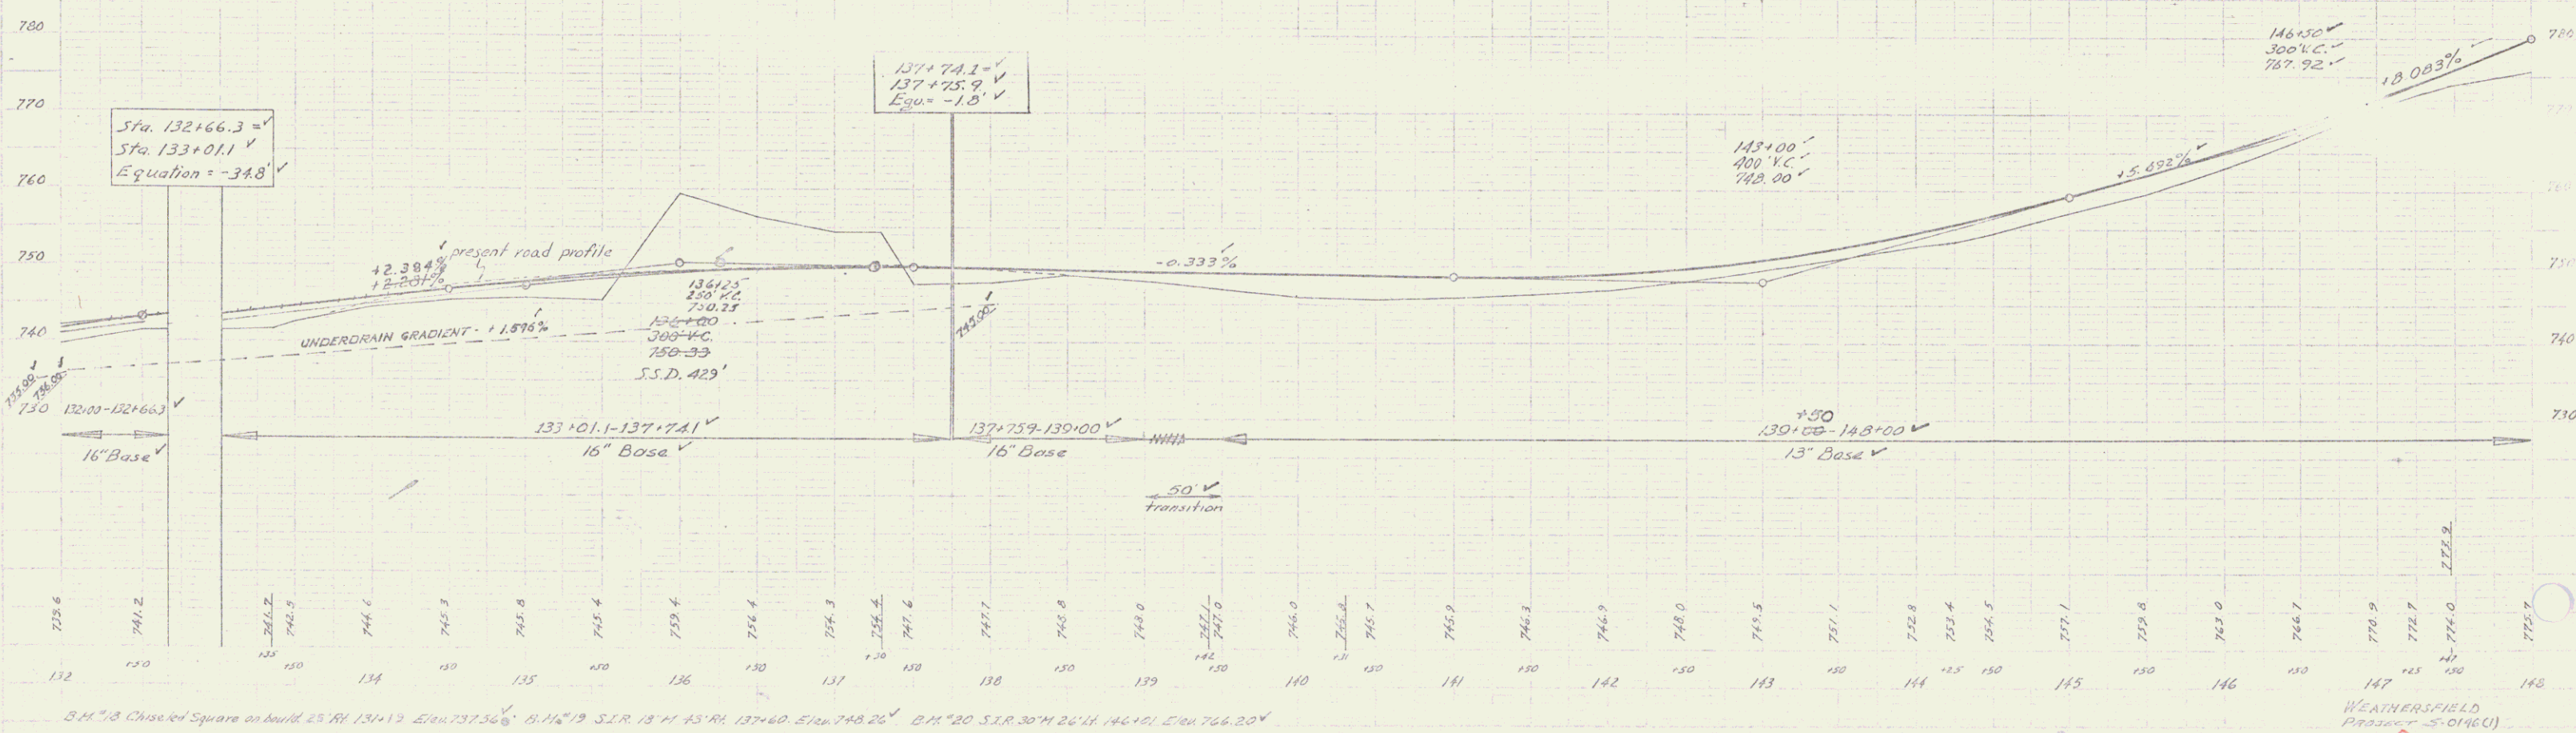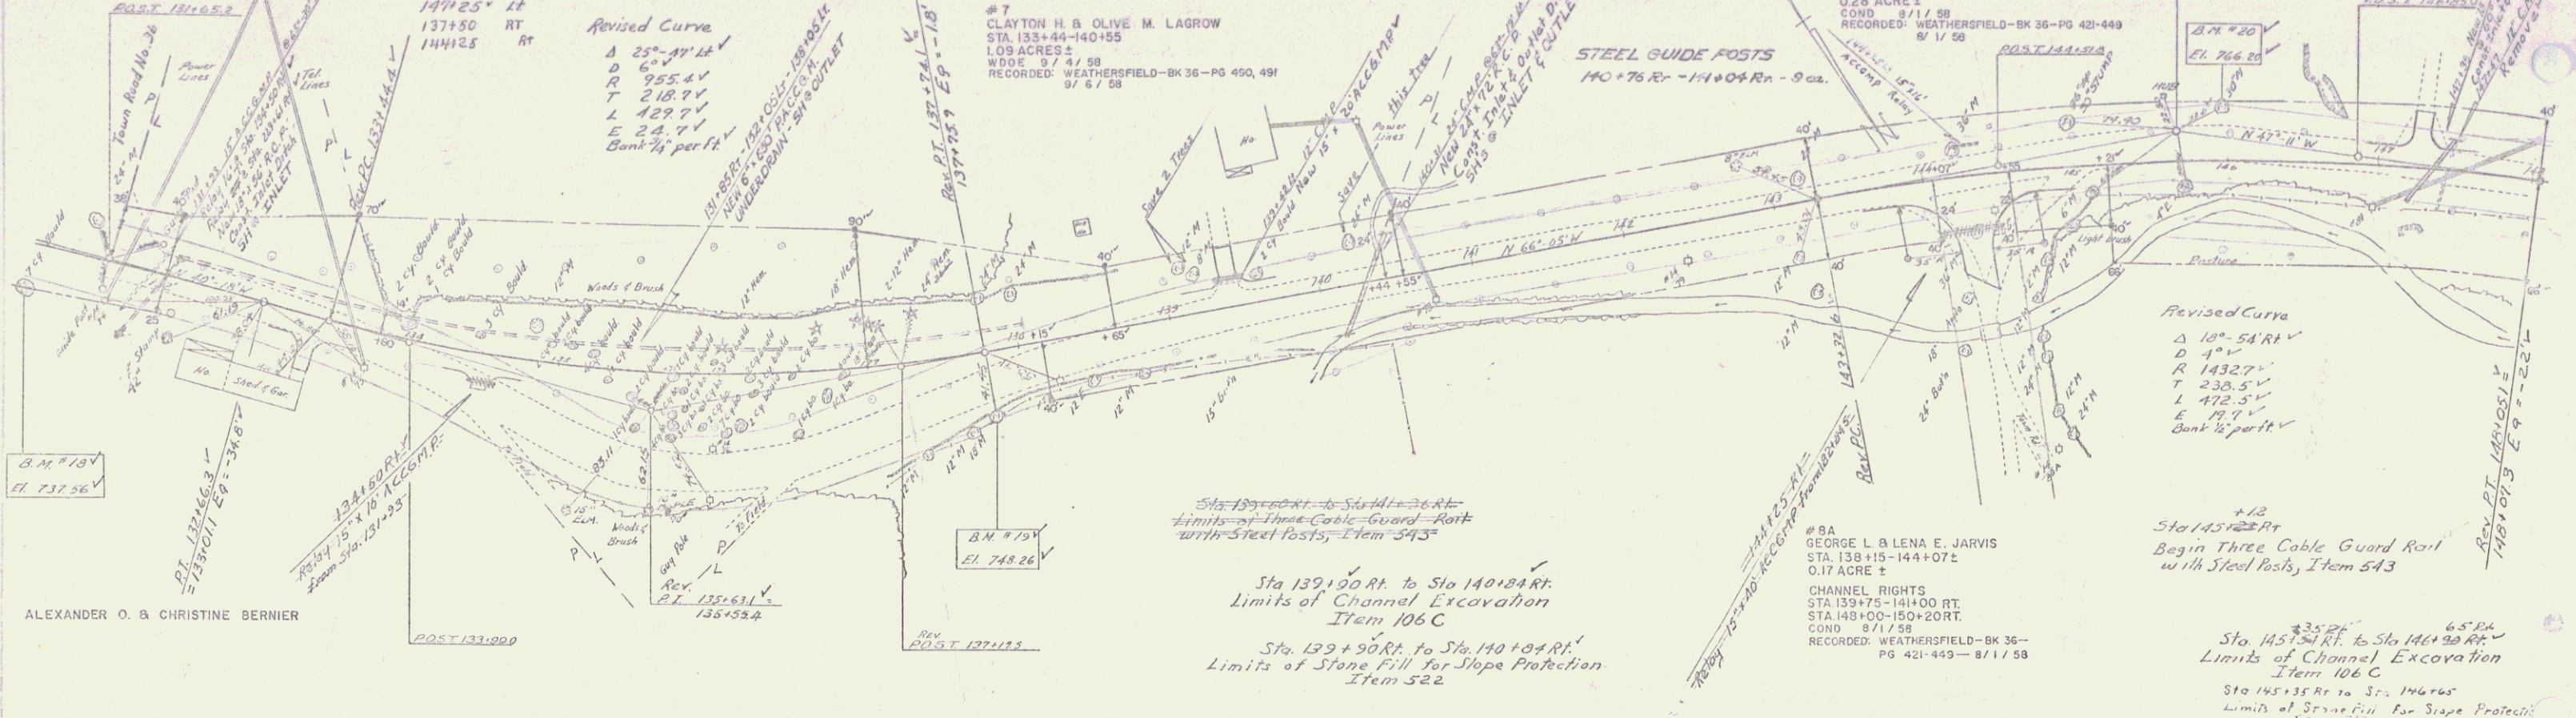

B.M. 18 Chiswell Square on build. 25' RH 134+19 Elev. 737.36' B.M. 19 S.I.R. 13' H 45' RH 137+60 Elev. 748.26' B.M. 20 S.I.R. 30' H 26' H 140+01 Elev. 766.20'

WEATHERSFIELD
PRODUCTION 50146(C)
SHEETS 10 OF 110 SHEETS