
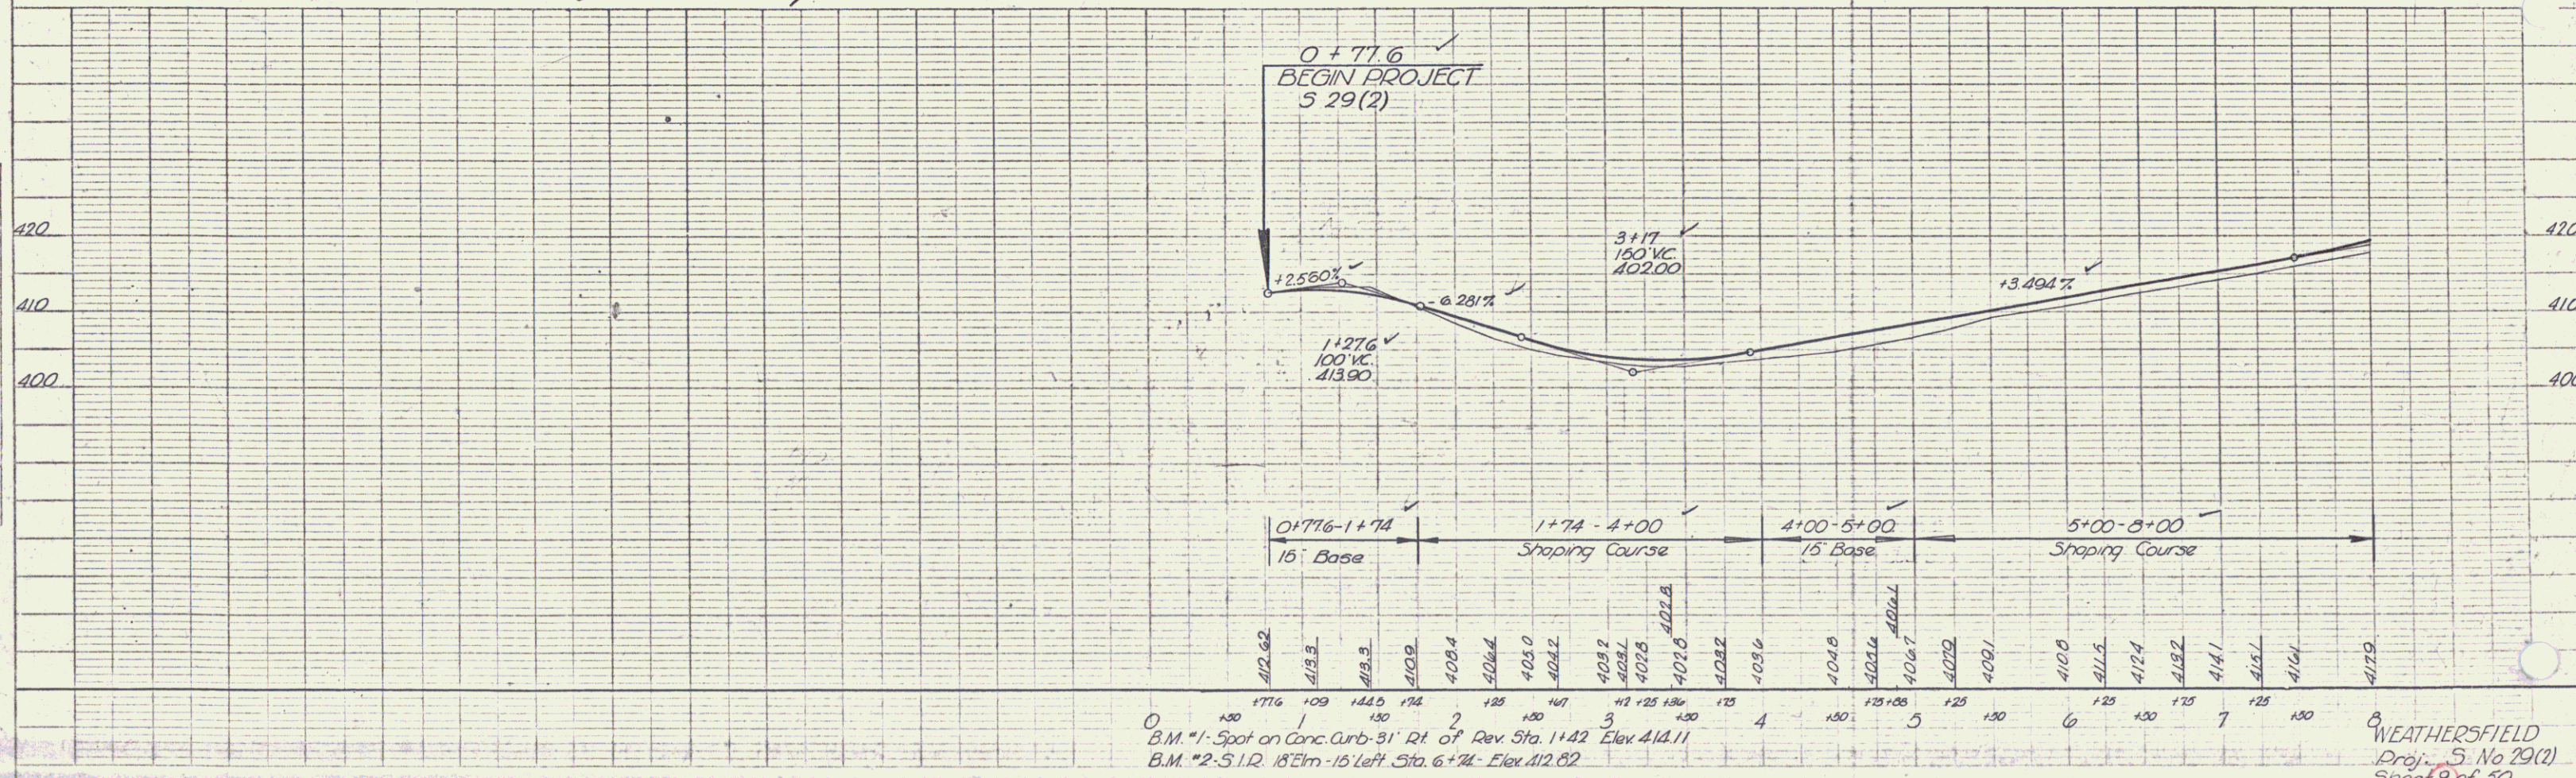
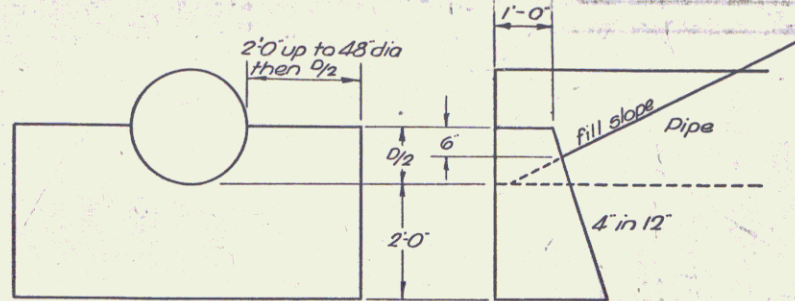


PLAN	DATE
REVISIONS	
NO.	
BY	
CHECKED	
DATE	

PROFILE	DATE
REVISIONS	
NO.	
BY	
CHECKED	
DATE	

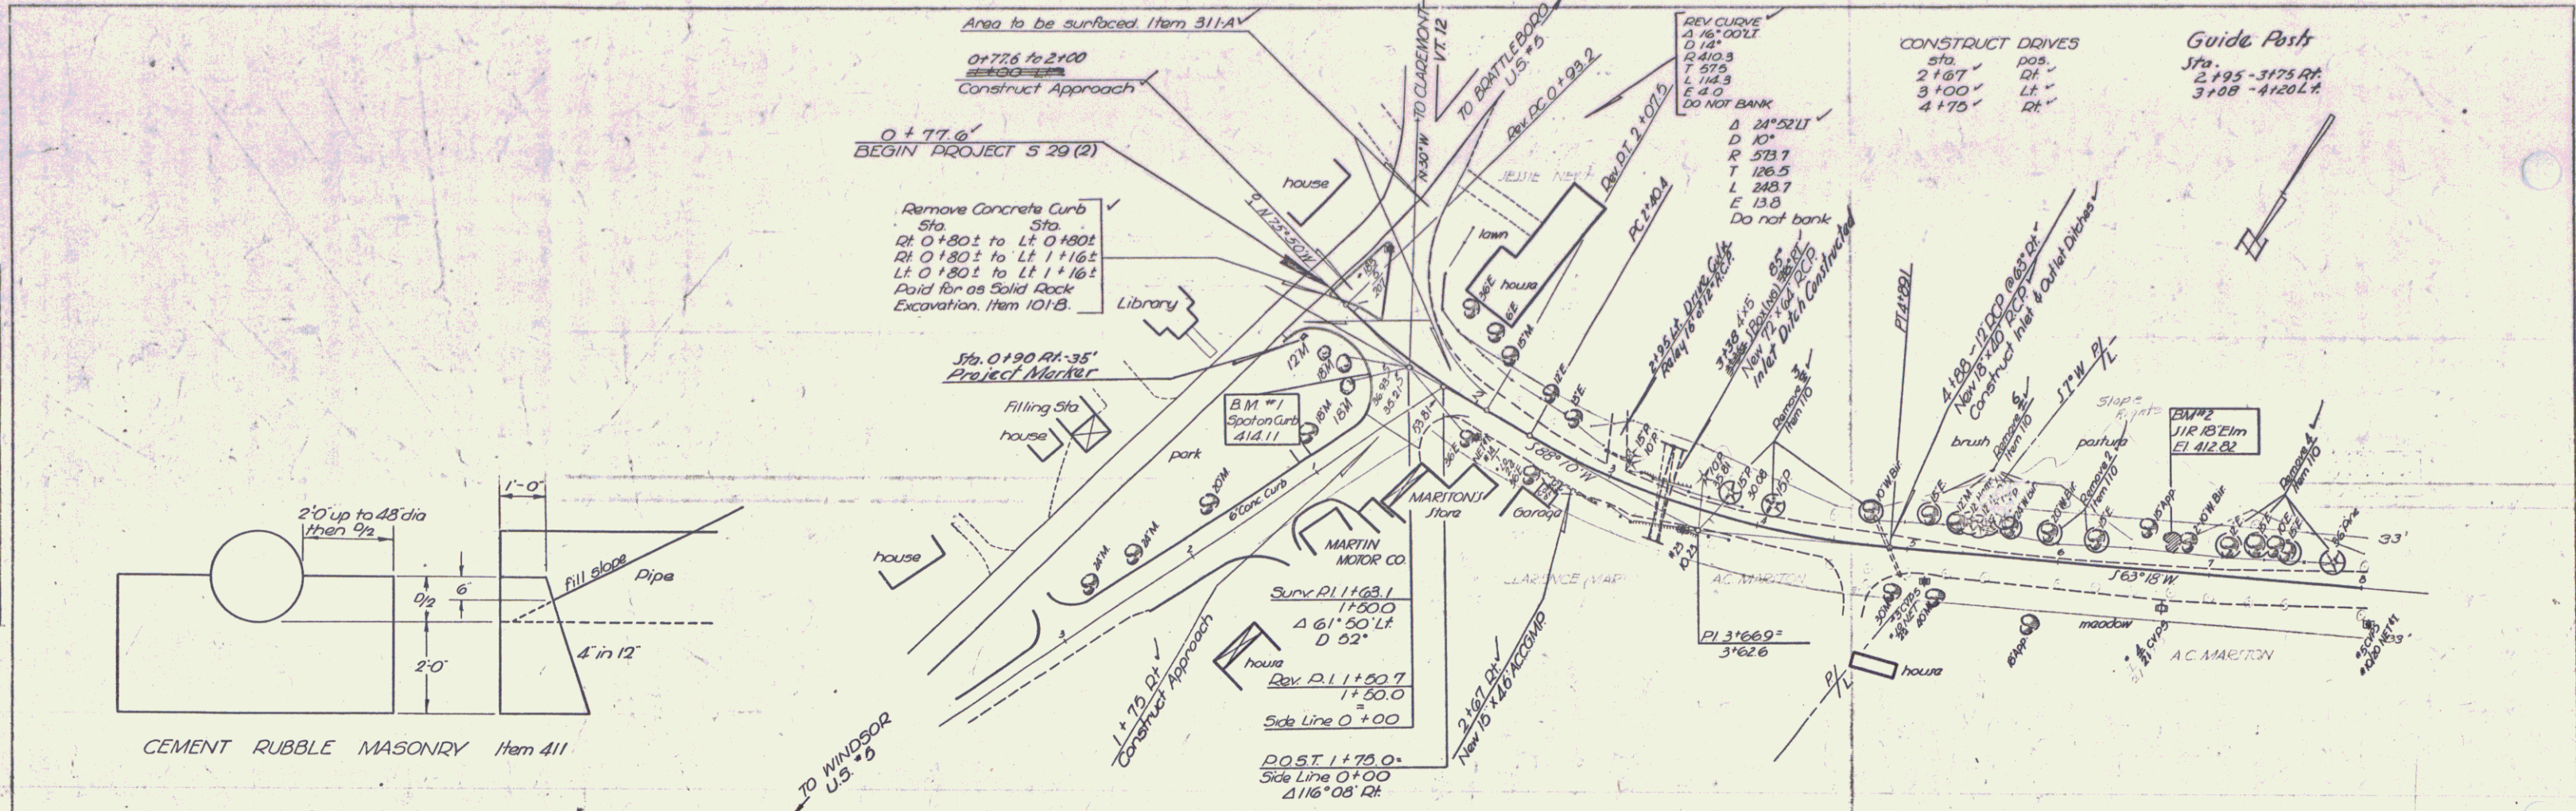

B.M. #1 - Spot on Conc. Curb - 31' Rt. of Rev. Sta. 1+42 Elev. 414.11
 B.M. #2 - S.I.R. 18' Elm - 15' Left Sta. 6+74 Elev. 412.62

WEATHERSFIELD
 Proj. S. No. 29(2)
 Sheet 9 of 50