
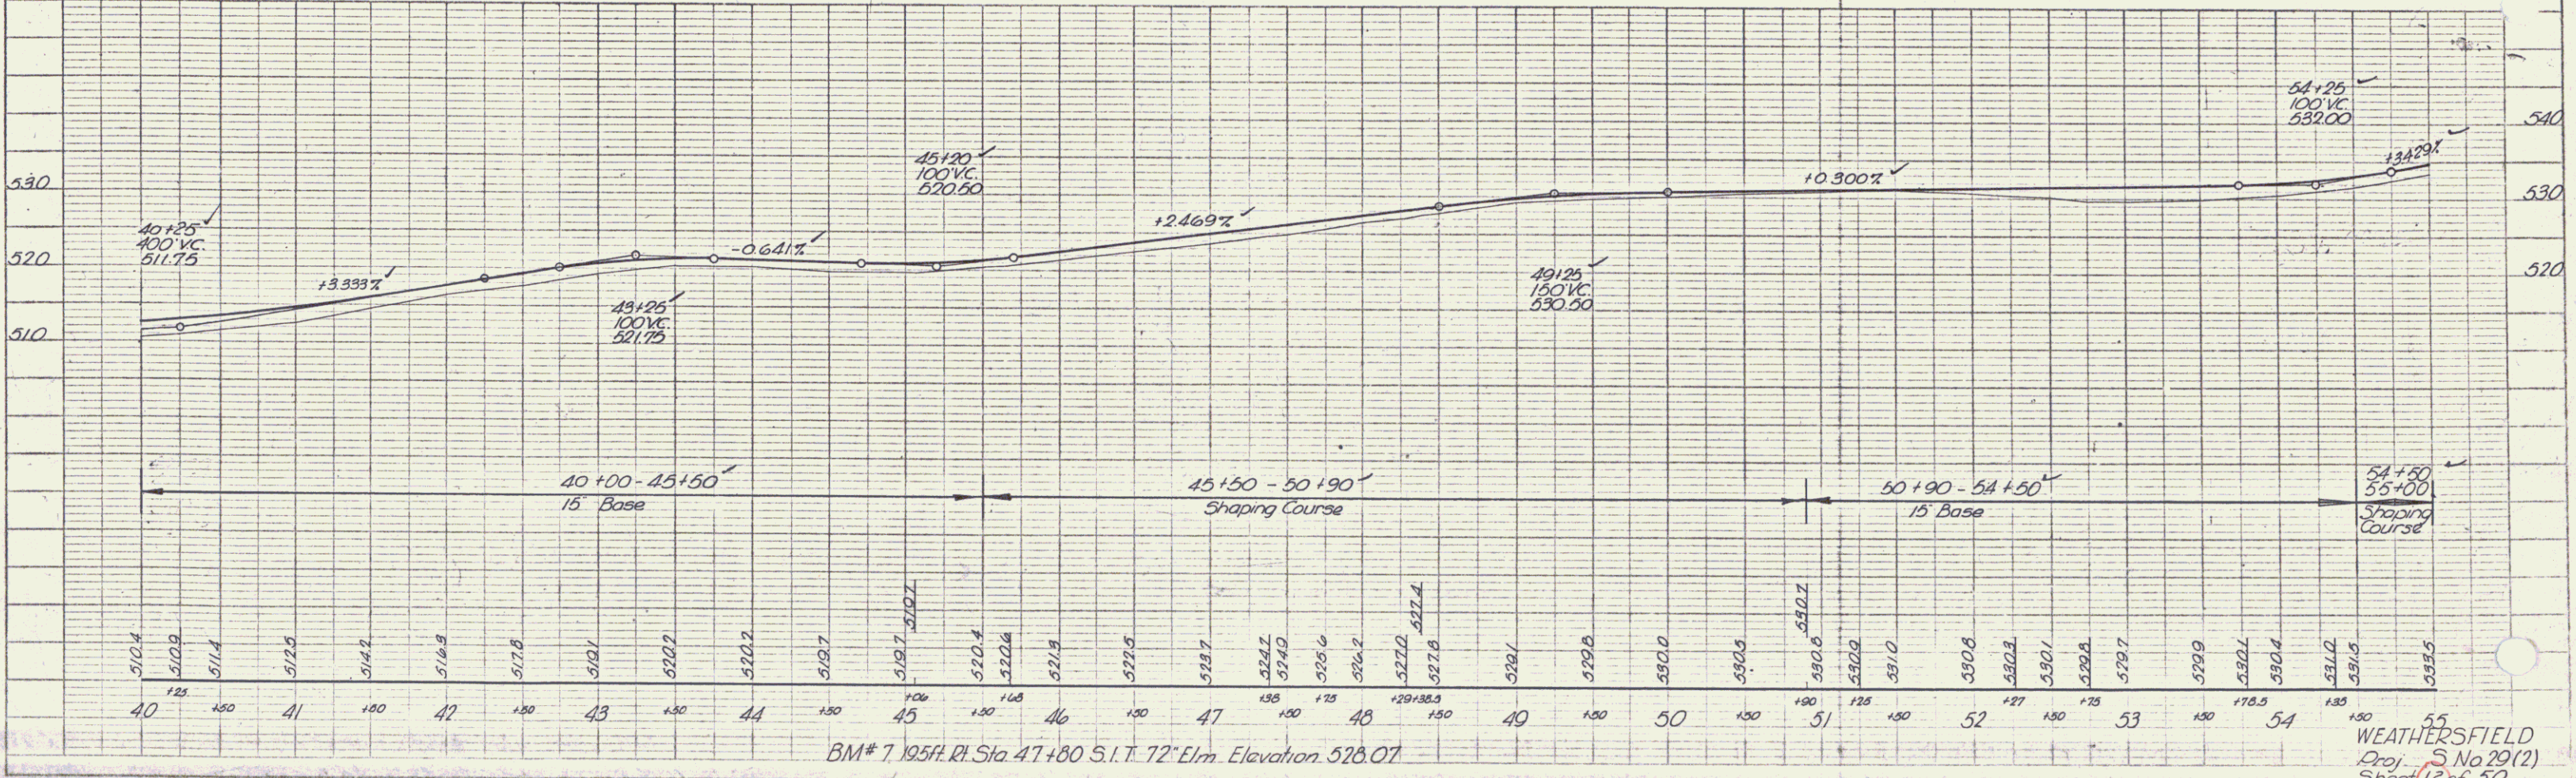


PLAN
 DRAWN BY: HURLEY
 CHECKED BY: HURLEY
 DATE: 11/10/00
 PROJECT: HWY 100

PROFILE
 DRAWN BY: HURLEY
 CHECKED BY: HURLEY
 DATE: 11/10/00
 PROJECT: HWY 100

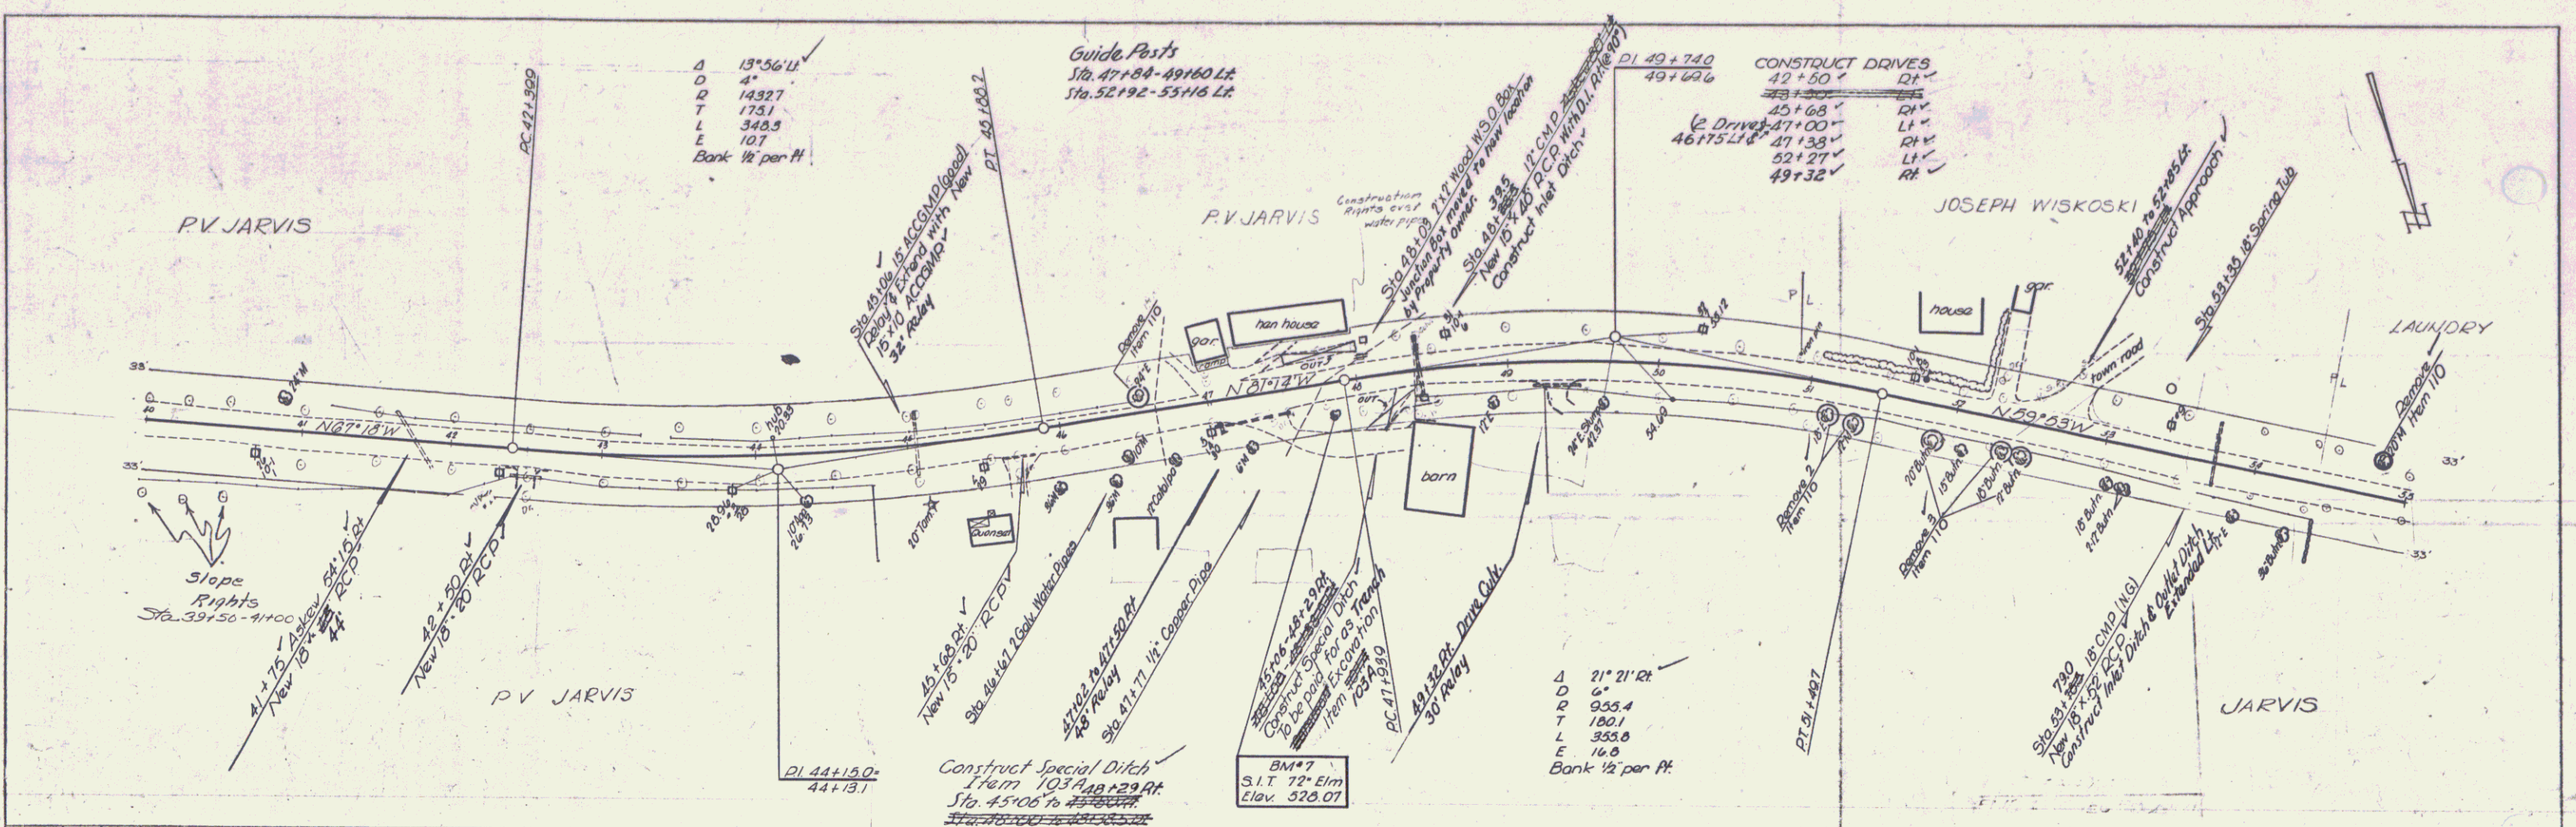

WEATHERSFIELD
 Proj. S No 29(2)
 Sheet 12 of 50