



PLAN
 DATE: 1/20/50
 DRAWN BY: [Signature]
 CHECKED BY: [Signature]
 PROJECT: [Project Name]

PROFILE
 DATE: 1/20/50
 DRAWN BY: [Signature]
 CHECKED BY: [Signature]
 PROJECT: [Project Name]

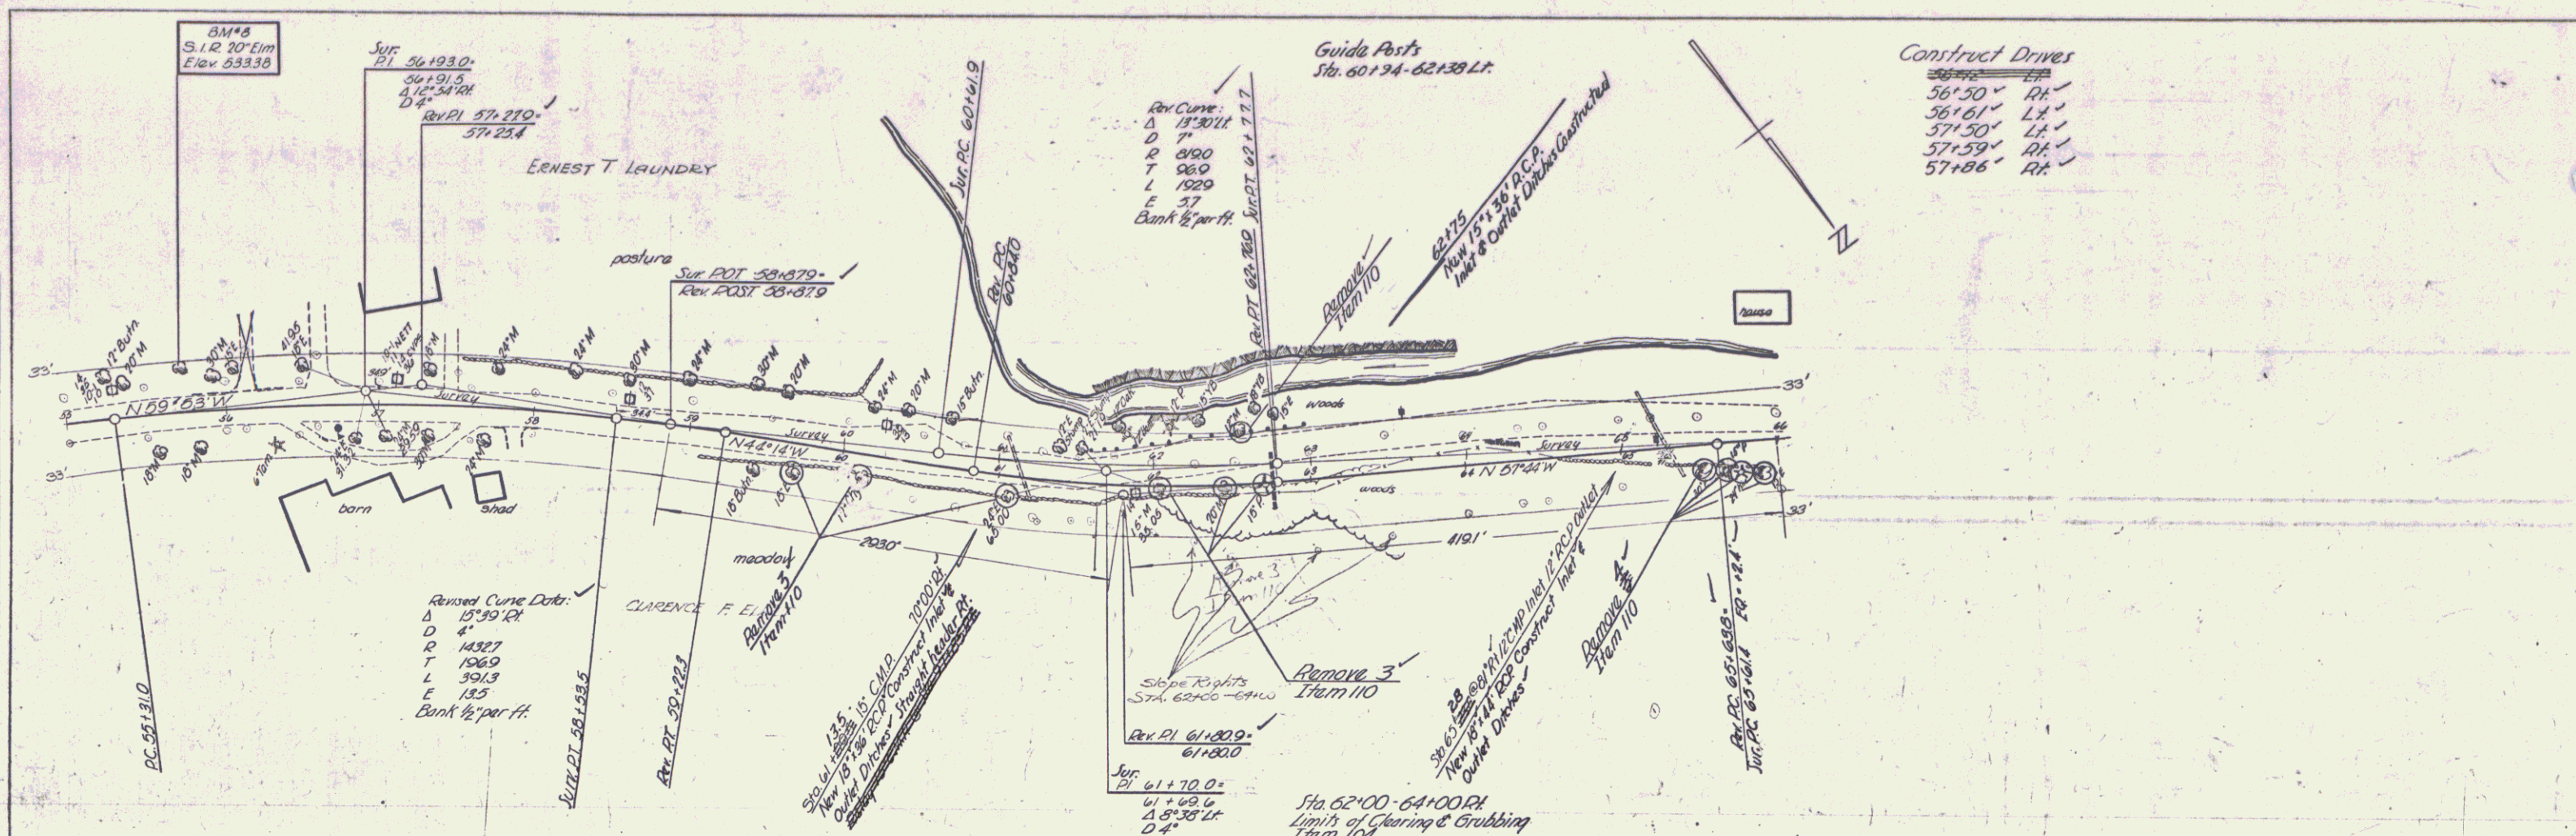

Construct Drives

56+30	RT
56+61	LT
57+59	RT
57+86	RT

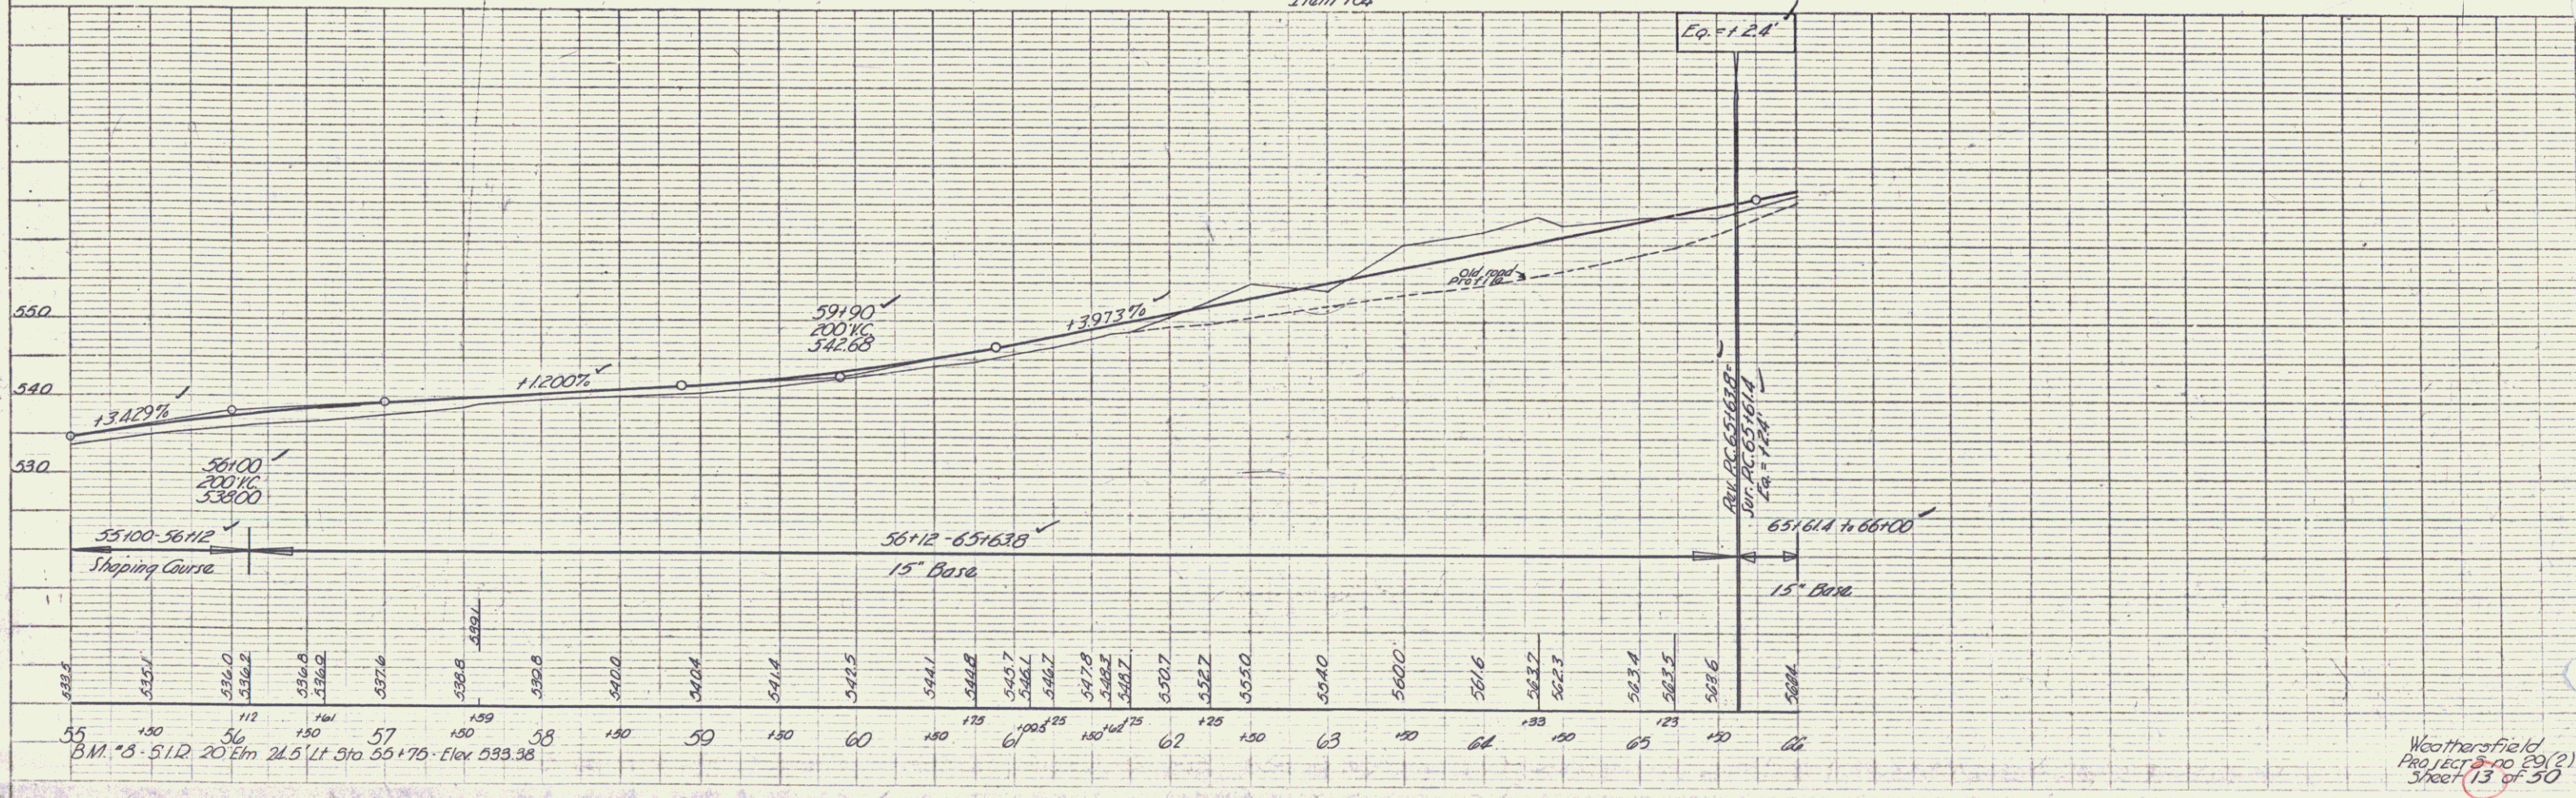

Weatherfield
 Project No. 29(2)
 Sheet 13 of 50