
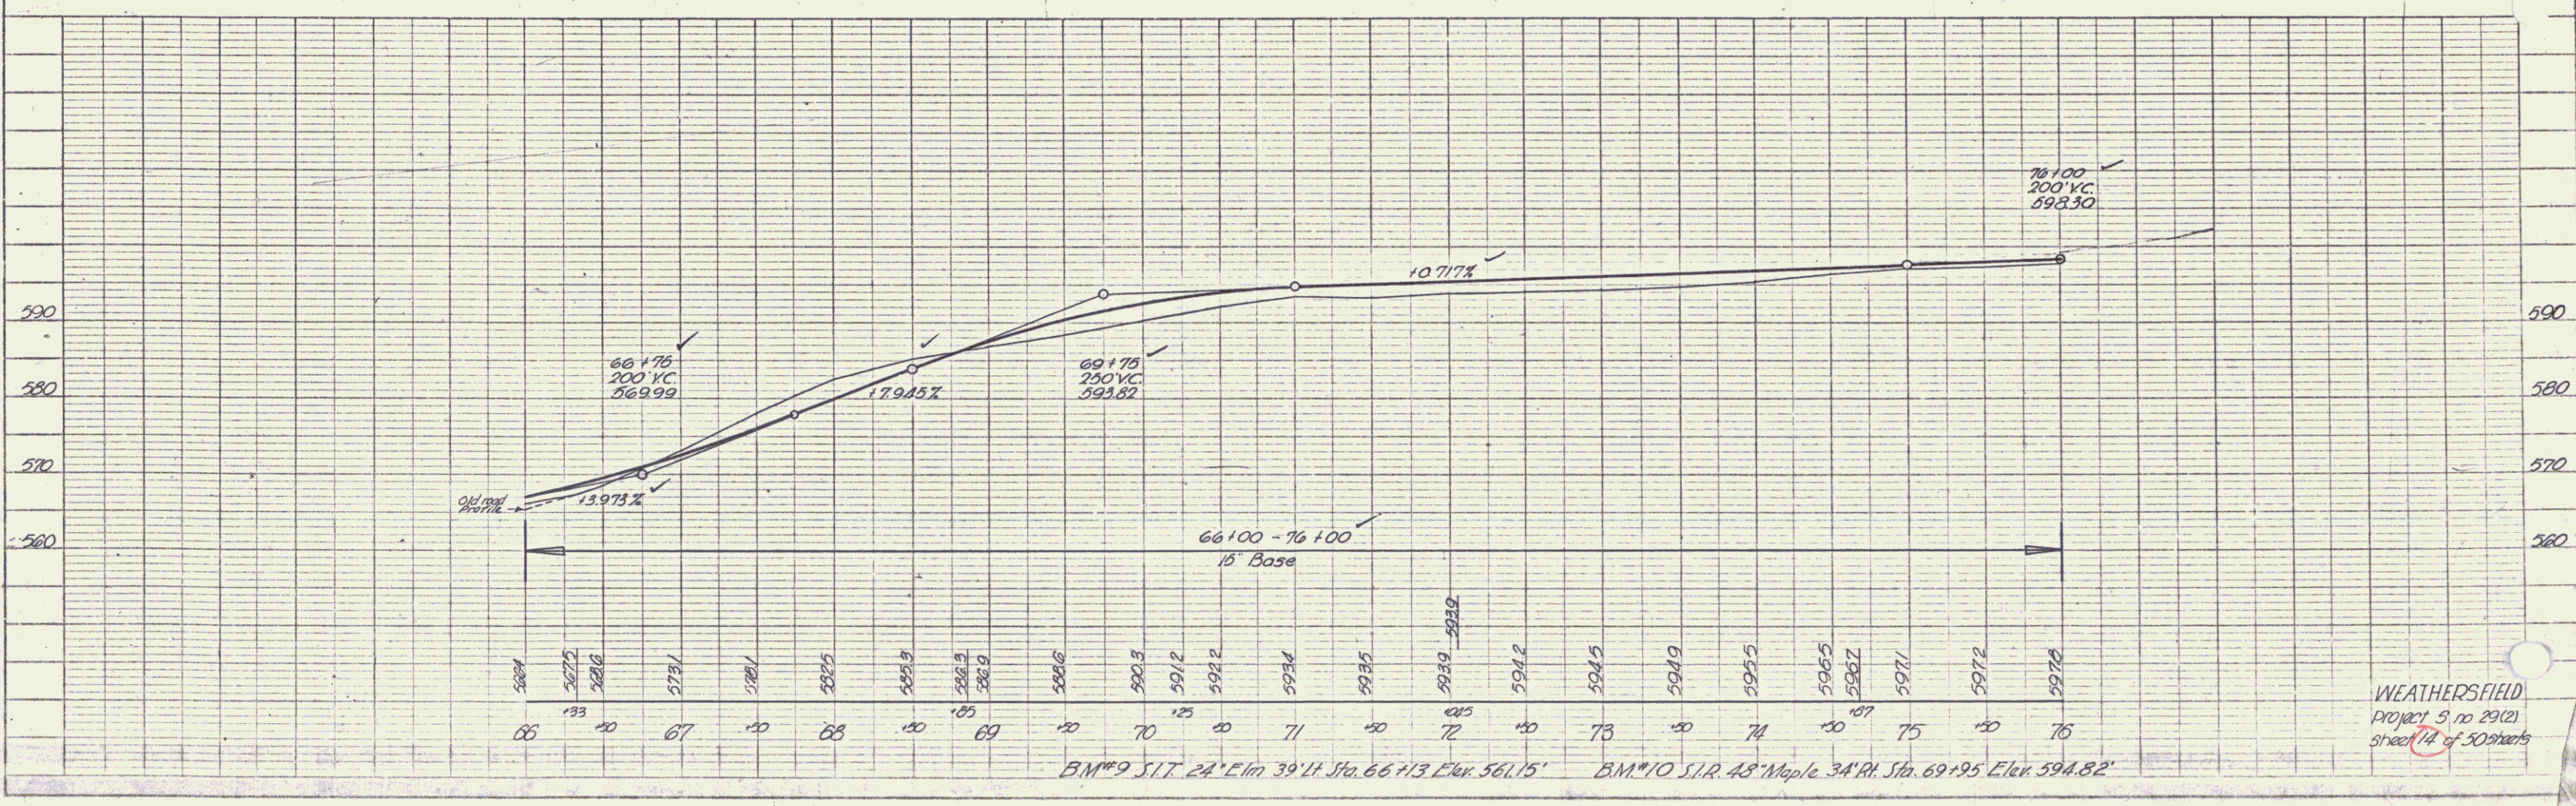


PLAN	DATE	BY
PLOTTED	1/27/21	W. J. ...
CHECKED		
DATE		
BY		
CHECKED		
DATE		
BY		

PROFILE	DATE	BY
PLOTTED	1/27/21	W. J. ...
CHECKED		
DATE		
BY		
CHECKED		
DATE		
BY		

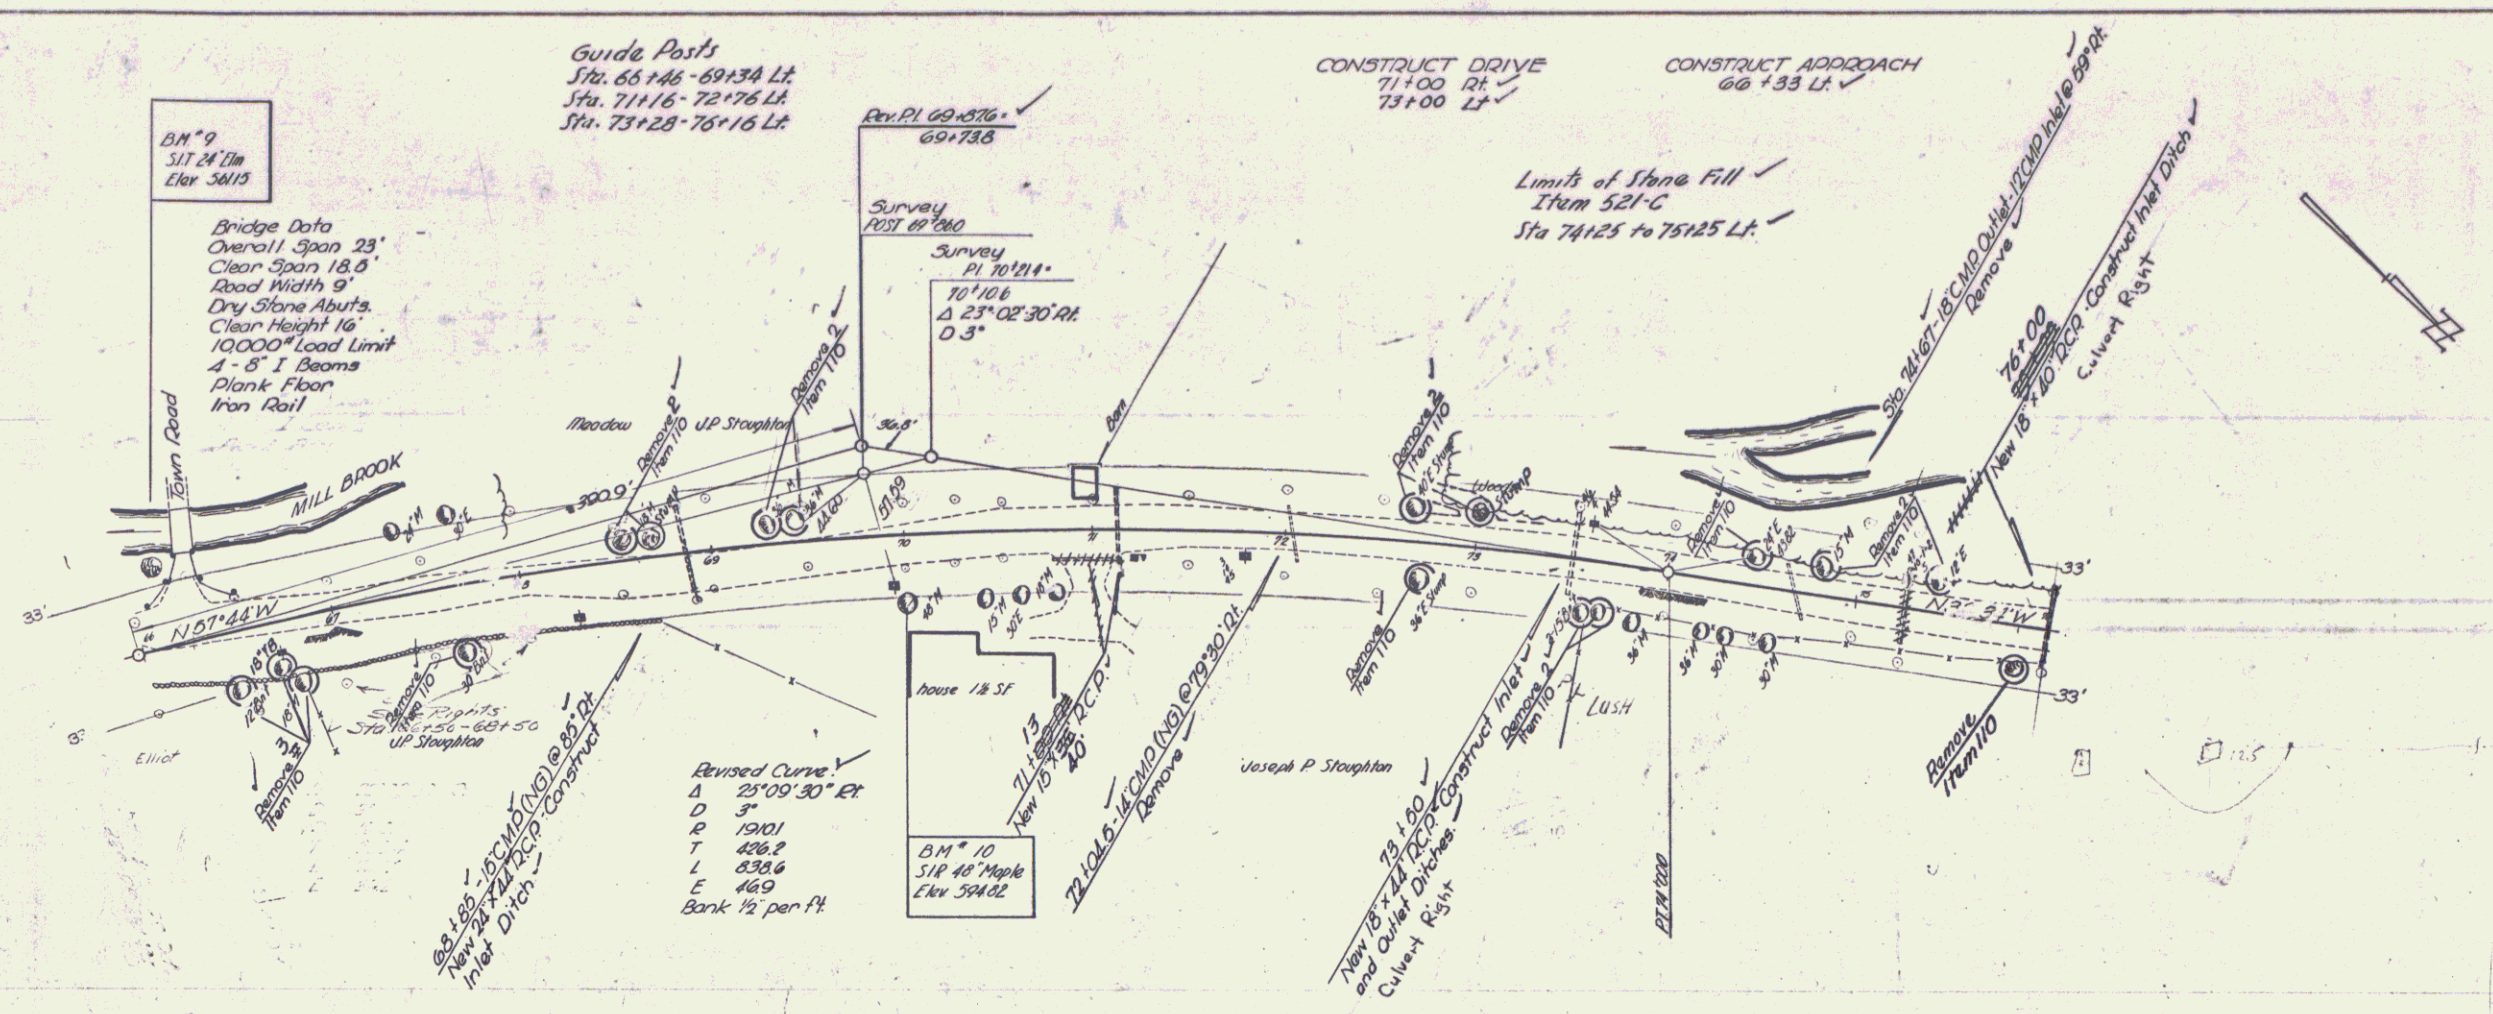

WEATHERSFIELD
Project 5, no 29(2)
Sheet 14 of 50 sheets