
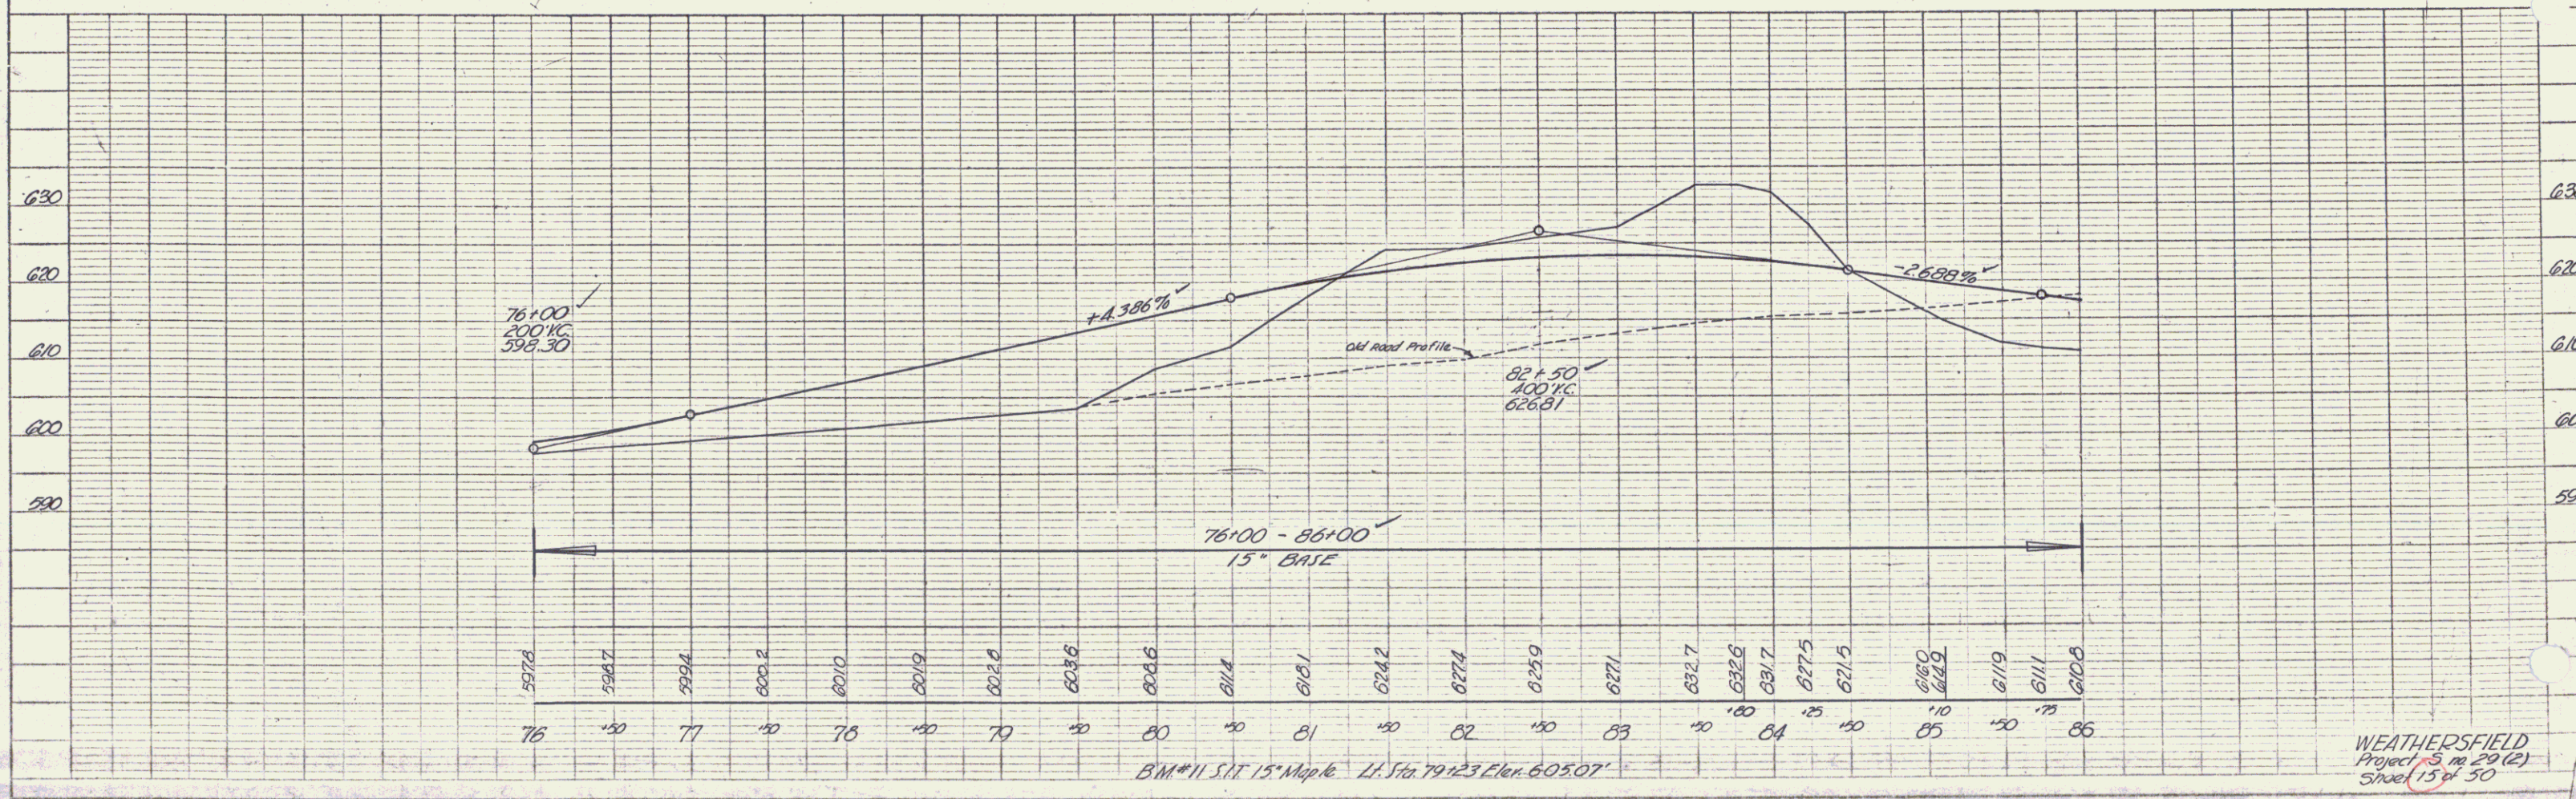


PLAN	DATE
REVISIONS	
NOTED	
NOTE BOOK	
ALL OF WHAT CHECKED	
BY	

PROFILE	DATE
REVISIONS	
NOTED	
NOTE BOOK	
ALL OF WHAT CHECKED	
BY	

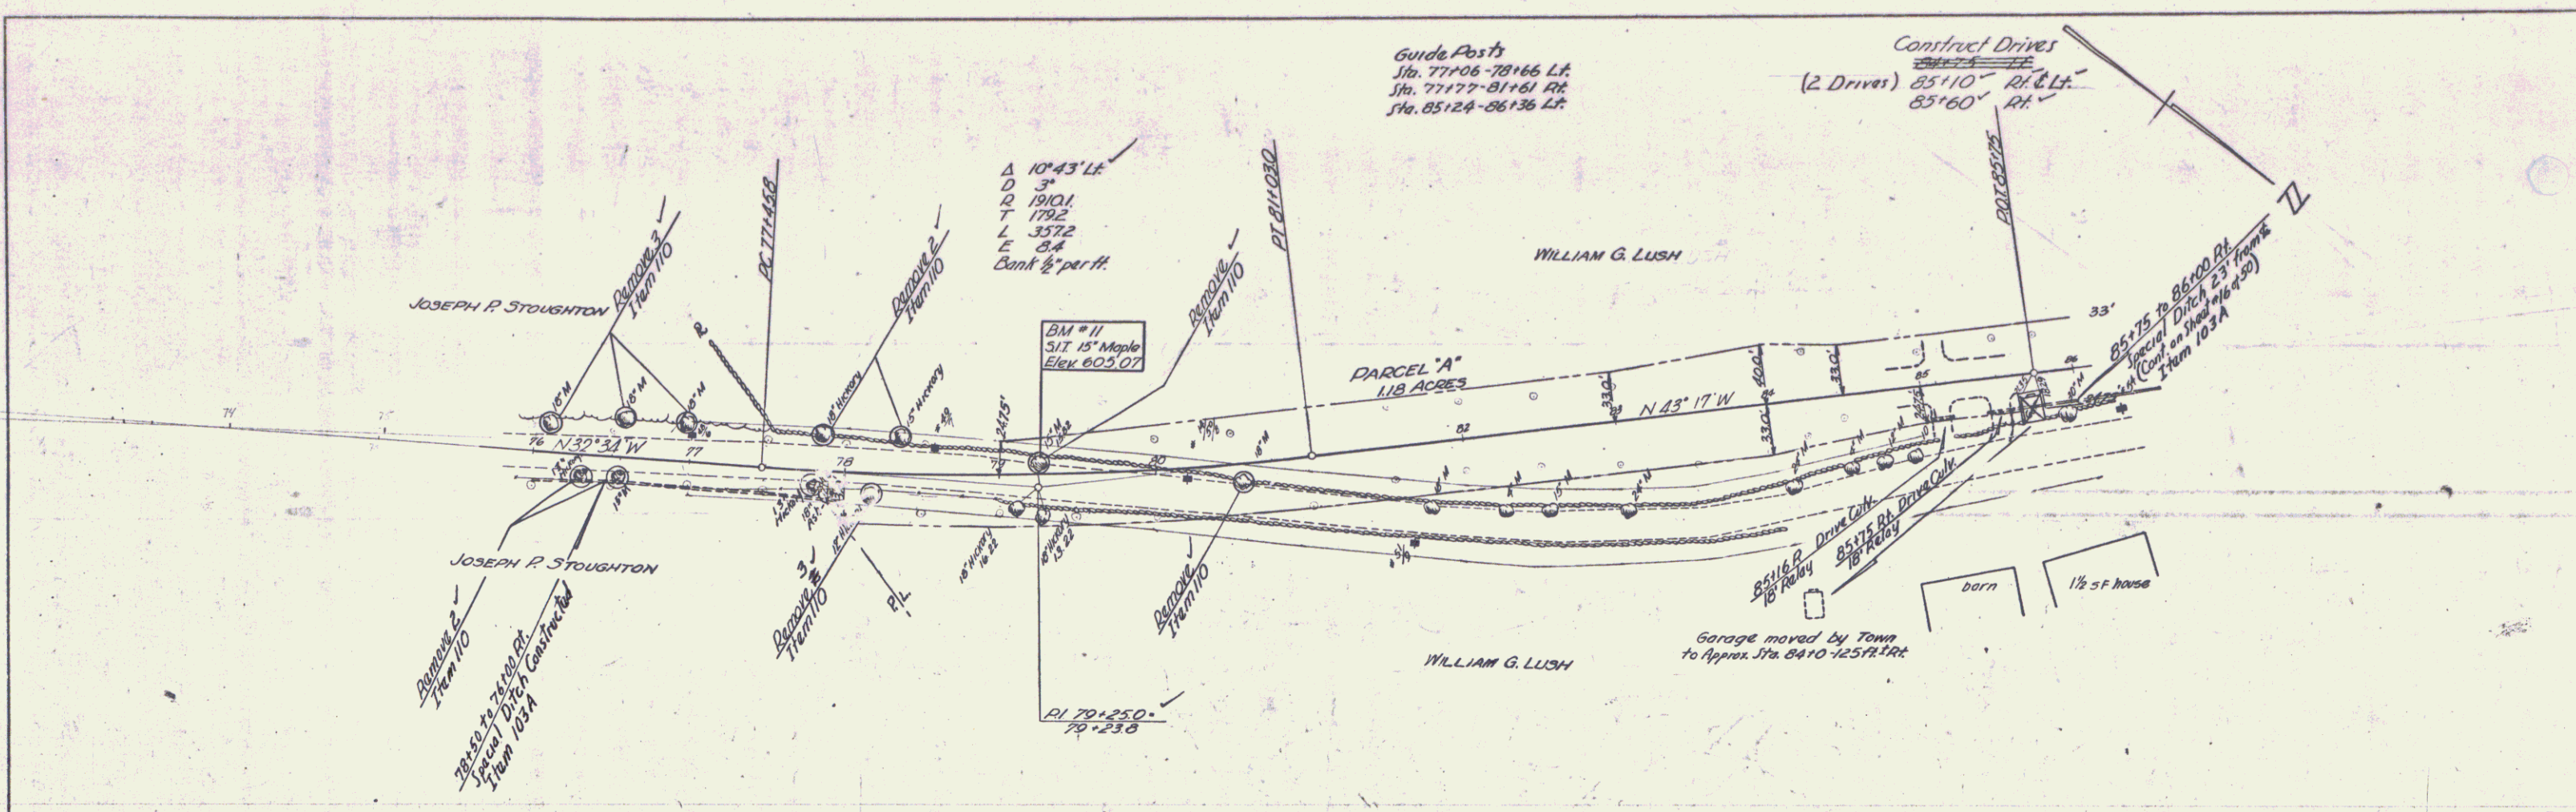

WEATHERSFIELD  
Project 3, pg 29 (2)  
Sheet 15 of 30

PLATE 11 - PLAN/PROFILE - PLEASANTVILLE  
SCALE: 1" = 40' HORIZ. 1" = 10' VERT.  
K&E CIVIL ENGINEERS  
K&E CIVIL ENGINEERS