
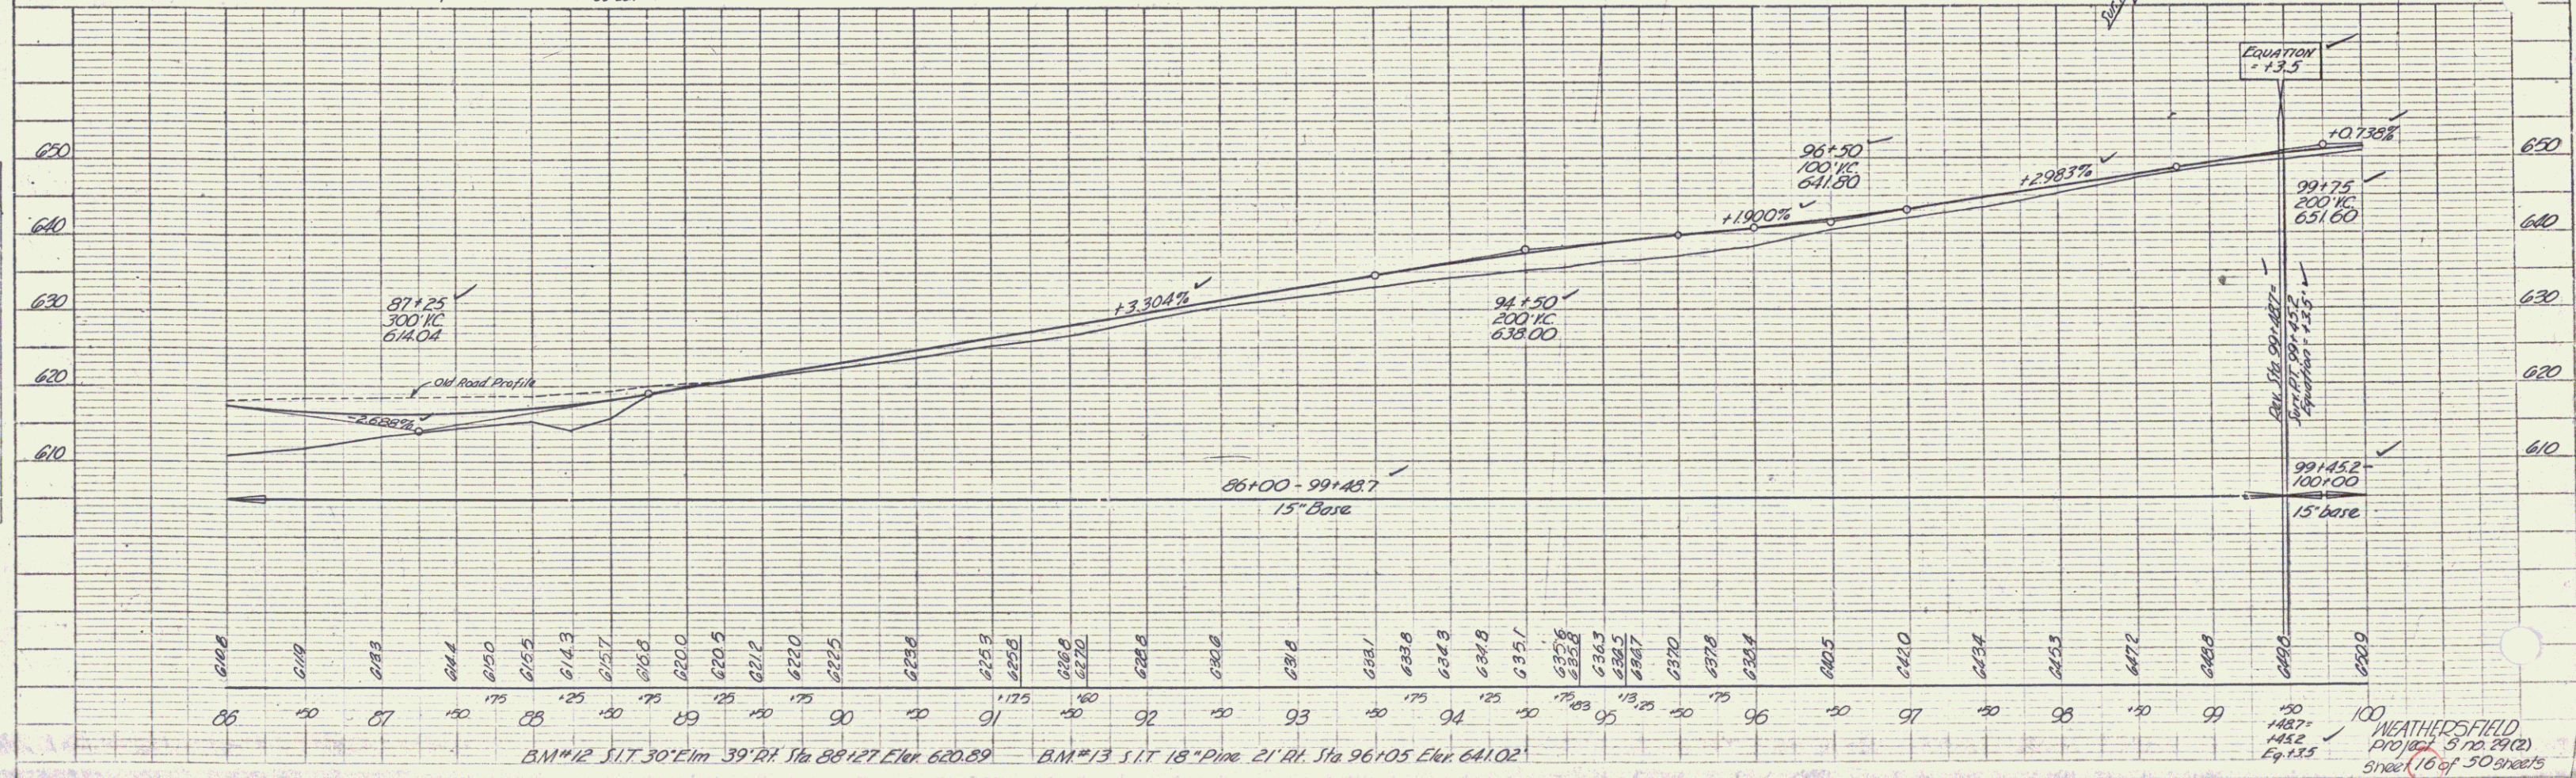


PLAN
 DATE: 1/28/50
 DRAWN BY: J. Palmer
 CHECKED BY: J. Palmer
 NOTE BOOK: 100
 PROJECT: WEATHERS FIELD
 SHEET: 12 OF 50

PROFILE
 DATE: 1/28/50
 DRAWN BY: J. Palmer
 CHECKED BY: J. Palmer
 NOTE BOOK: 100
 PROJECT: WEATHERS FIELD
 SHEET: 12 OF 50

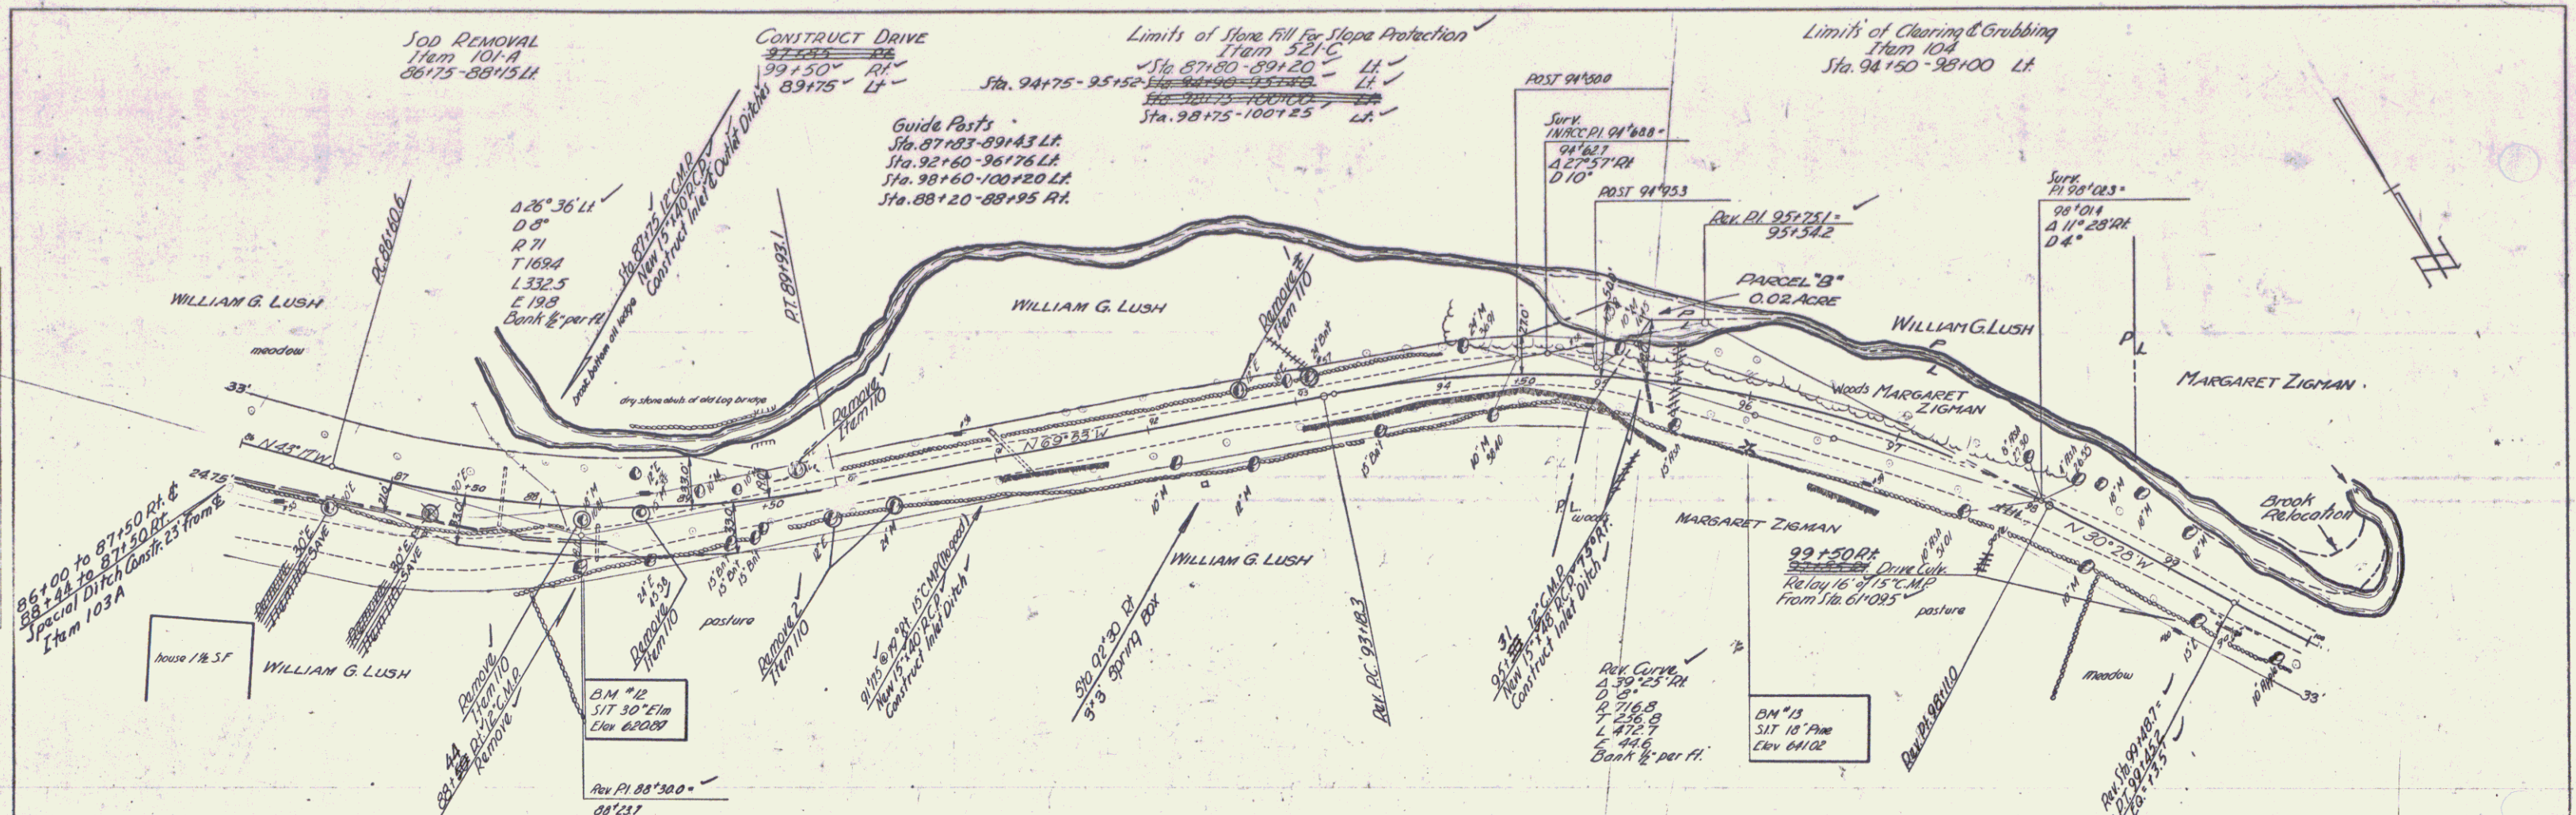

WEATHERS FIELD
 PROJECT 5 no. 29(2)
 SHEET 12 OF 50 SHEETS